INDEX TO DRAWINGS	
SHEET NO.	DESCRIPTION
l	TITLE SHEET
2 - 4	PLAN
5	DRAINAGE DETAIL
6-8	STANDARD DETAIL
	•
	· · ·
,	



STATE OF HAWAII

## DEPARTMENT OF TRANSPORTATION LAND TRANSPORTATION FACILITIES DIVISION

HONOLULU, HAWAII


"AS-BUILT"

PLANS FOR

## KALANIANAOLE HIGHWAY DRAINAGE IMPROVEMENTS FROM LUNALILO HOME RD. TO NAWILIWILI ST.

PROJ. NO. 7400A-01-78

DISTRICT OF HONOLULU ISLAND OF OAHU

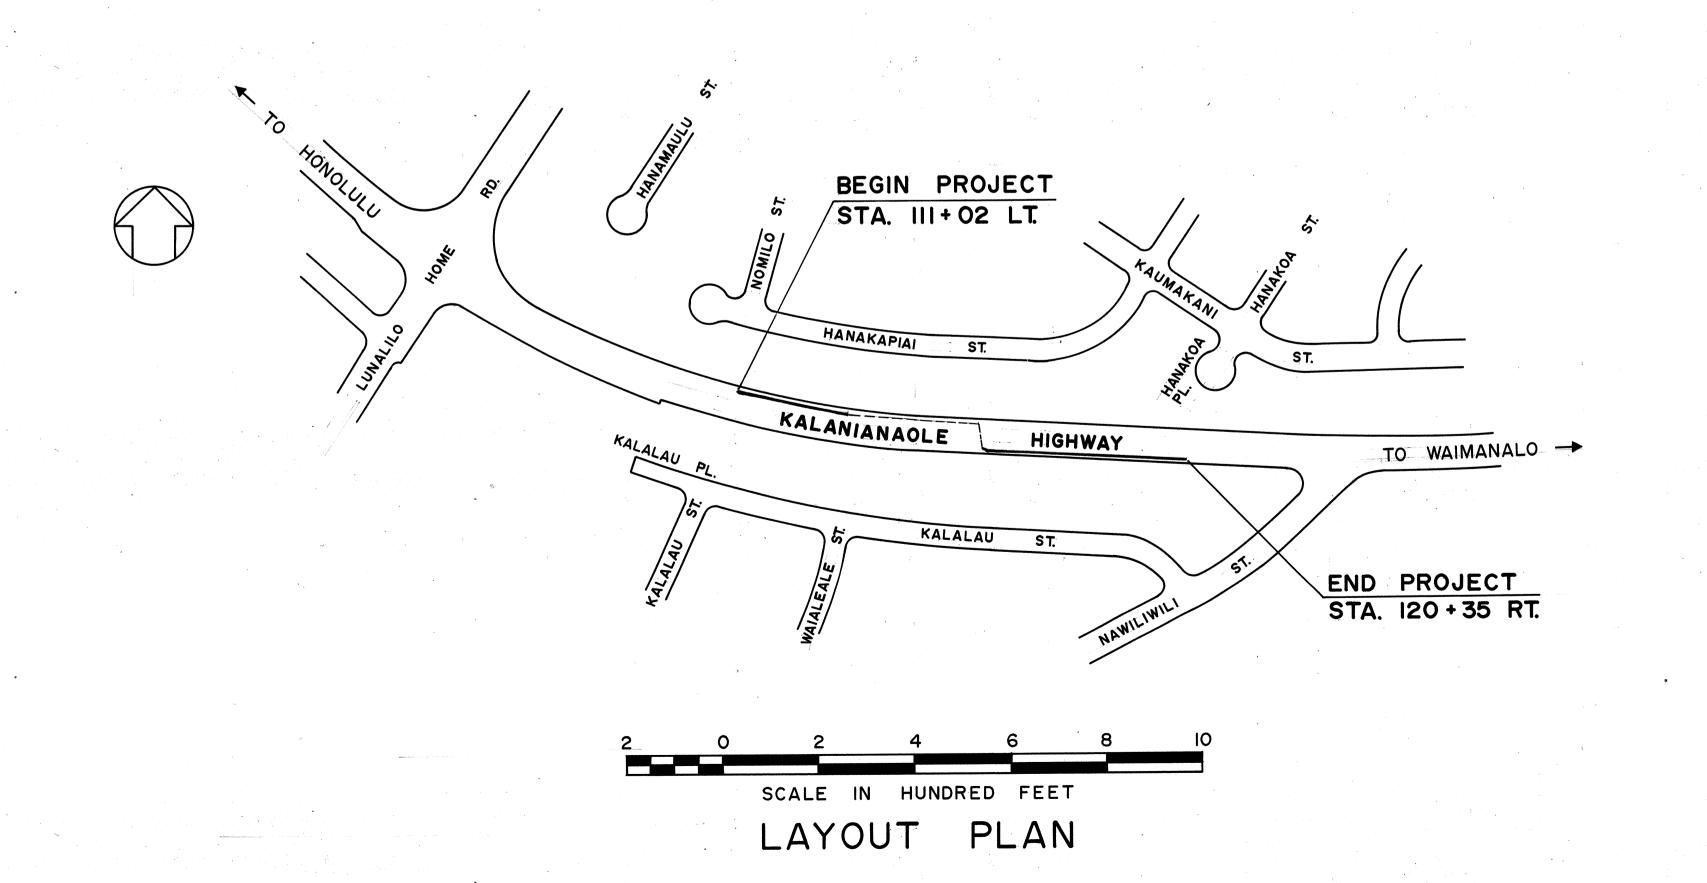

Waianae

Waianae

Waianae

Waianae

Wainahu

Waianae

Wainahu

Wainahu

Wainahu

Wainahu

Awa

Wainahu

Wainahu

Awa

Wainahu

Awa

Wainahu

Awa

Wainahu

Awa

Wainahu

Wainahu

Awa

Wainahu

Awa

Wainahu

Wainahu

Wainahu

Awa

Wainahu

Wainahu

Awa

Wainahu

Wainahu

Wainahu

Awa

Wainahu

Wainahu

Wainahu

Wainahu

Awa

Wainahu

W

BEEN INCORPORATED ON THESE PLANS IN RED EXCEPT CHANGES IN THE ORIGINAL THEORETICAL QUANTITIES. FOR ACTUAL QUANTITIES, REFER TO PROJECT LEDGER AND/OR COMPUTATION BOOK.

RESIDENT ENGINEER

DATE

<u>LOCATION OF PROJ.</u>
NO. 7400A - 0I - 78

FISCAL SHEET TOTAL YEAR NO. SHEETS

PROJ. NO.

DEPARTMENT OF TRANSPORTATION
STATE OF HAWAII

APPROVED: James R. Carras

5/15/19

DIR. OF TRANSPORTATION DATE