,	
	INDEX TO DRAWINGS
SHEET NO.	DESCRIPTION
	TITLE SHEET
2	TYPICAL SECTIONS
3	PLAN
4	PAVEMENT MARKINGS
5-7	STANDARD DETAILS
•	
· .	



STATE OF HAWAII



DEPARTMENT OF TRANSPORTATION HIGHWAYS DIVISION

HONOLULU, HAWAII

"AS BUILT"


PLANS FOR


KALANIANAOLE HIGHWAY RESURFACING

VICINITY OF PORTLOCK RD. TO LUNALILO HOME RD.

PROJECT NO. 7400A-01-81M

DISTRICT OF HONOLULU
ISLAND OF OAHU

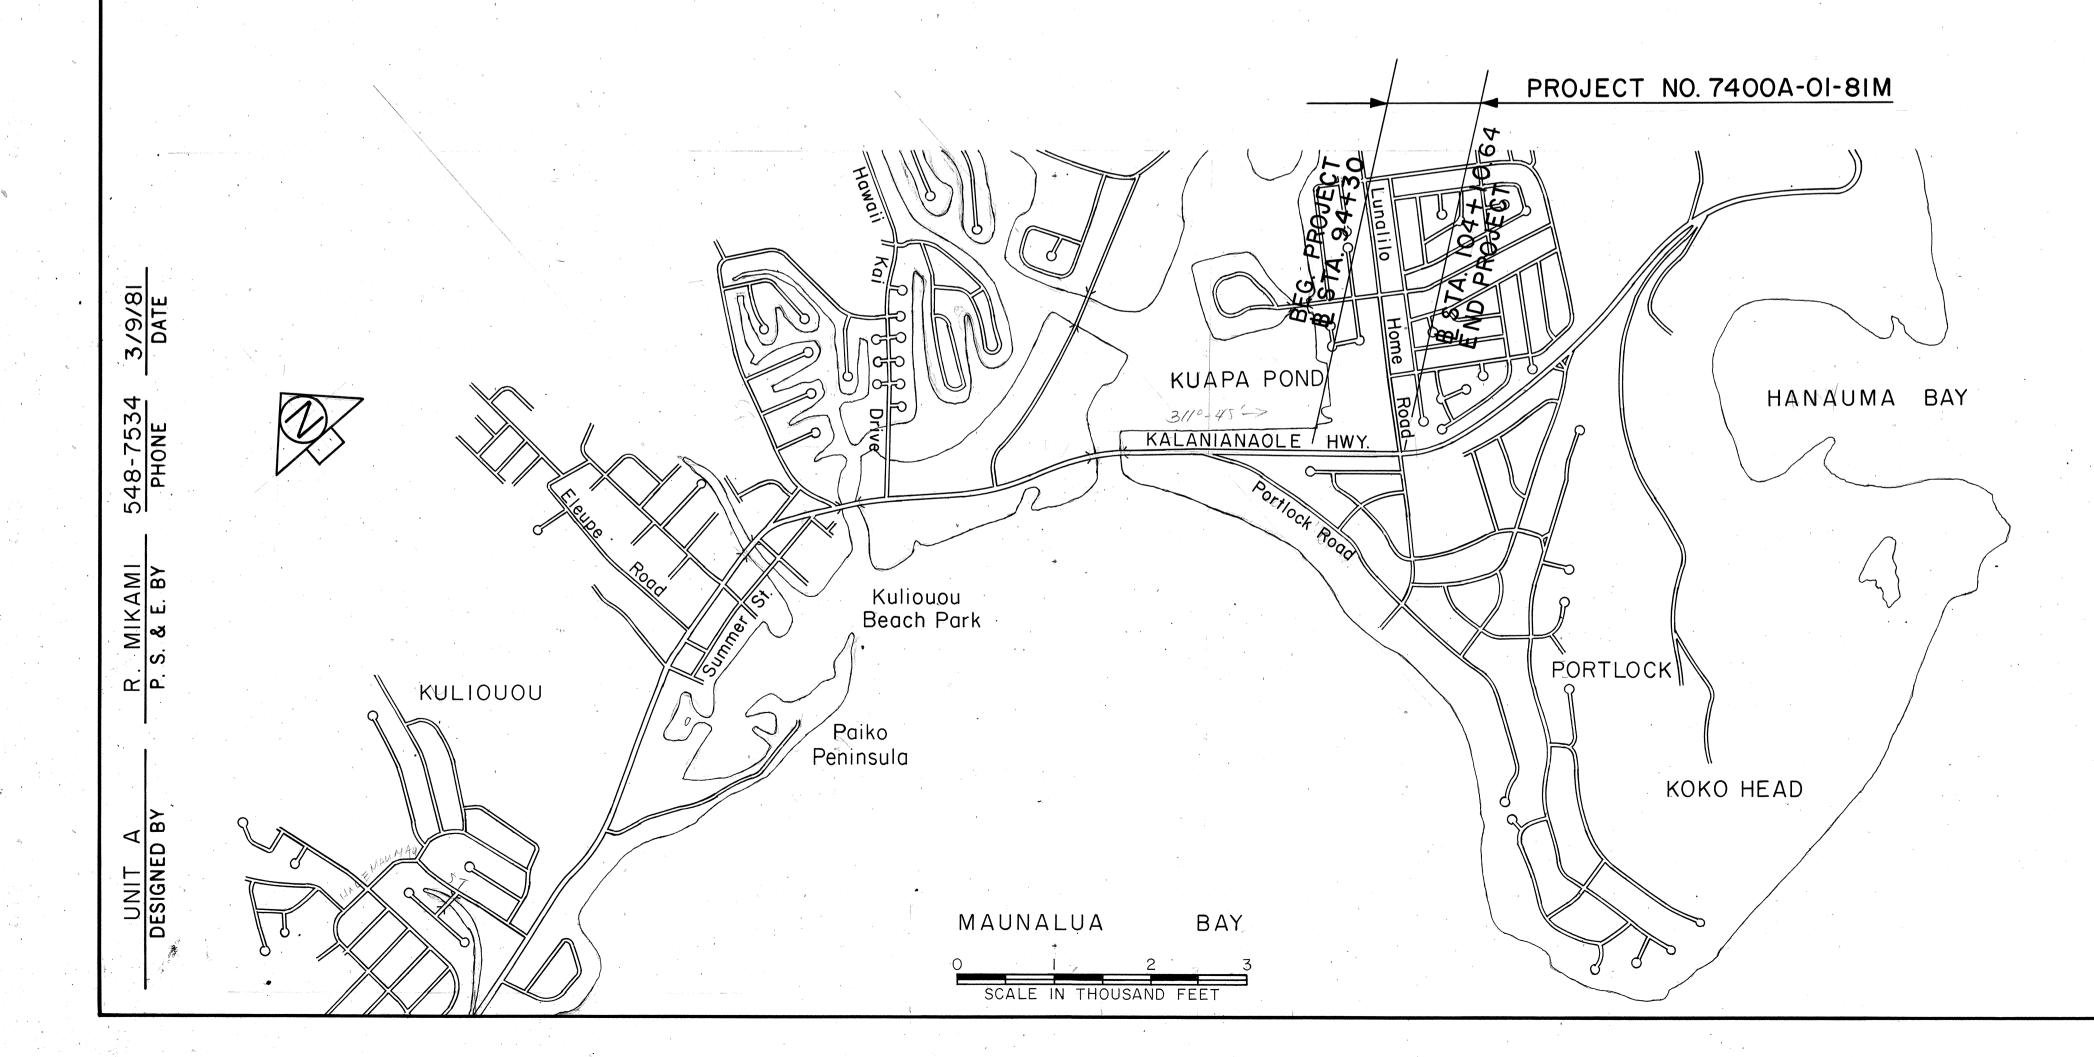

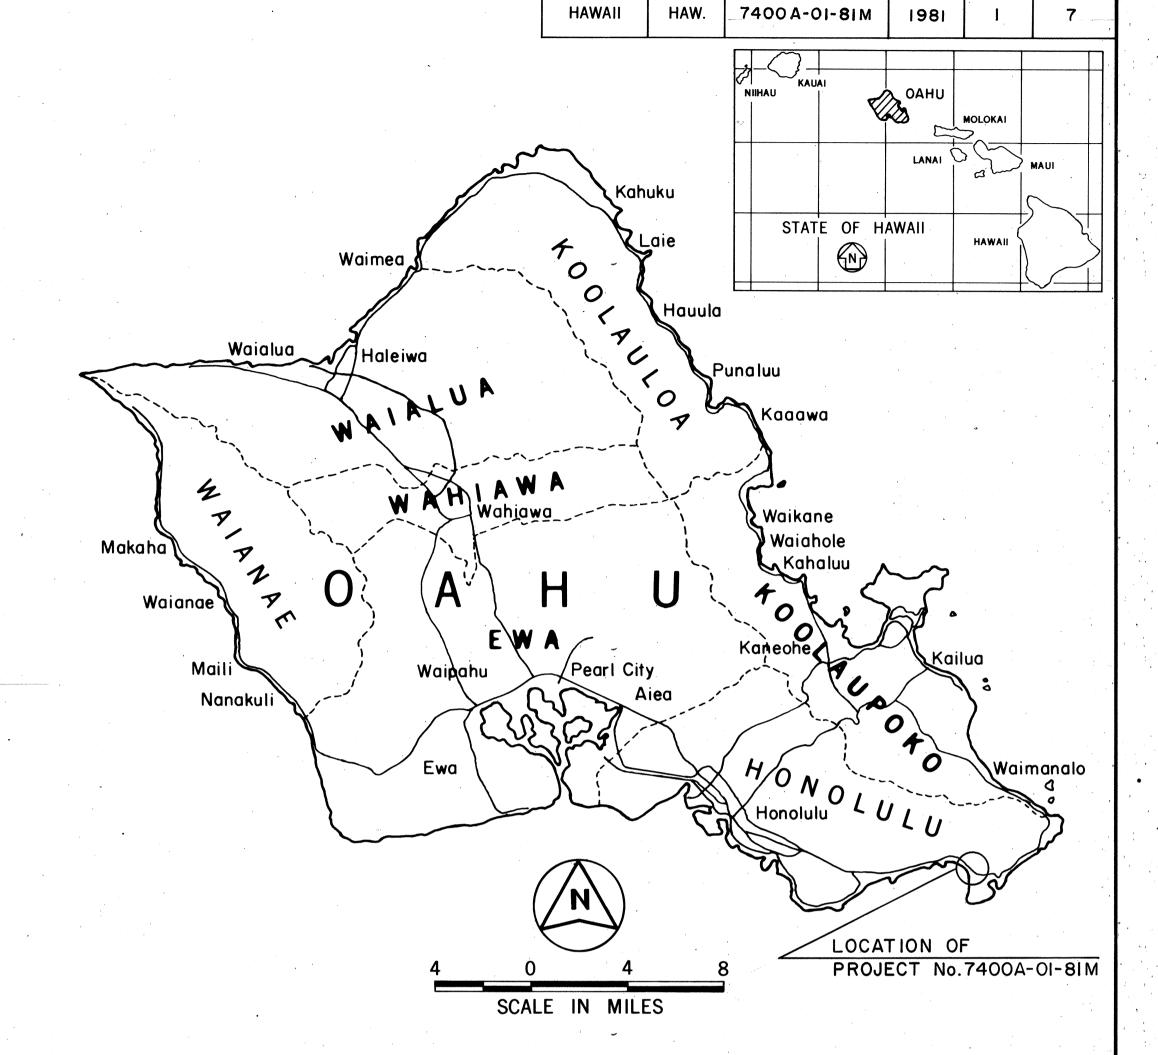

FED. ROAD DIST. NO.

STATE

PROJ. NO.

FISCAL SHEET YEAR NO.

NO CHANGES WERE MADE DURING CONSTRUCTION ON THESE PLANS EXCEPT CHANGES IN THE ORIGINAL THEORETICAL QUANTITIES. FOR QUANTITIES, REFER TO PROJECT LEDGER AND/OR COMPUTATION BOOK.

RESIDENT ENGINEER

13 Nov. 1981

DATE

	DEPARTMENT OF TRANSPORTATION
	STATE OF HAWAII
	APPROVED:
(James R. Carras 3/9/81
	ADIR. OF TRANSPORTATION DATE