

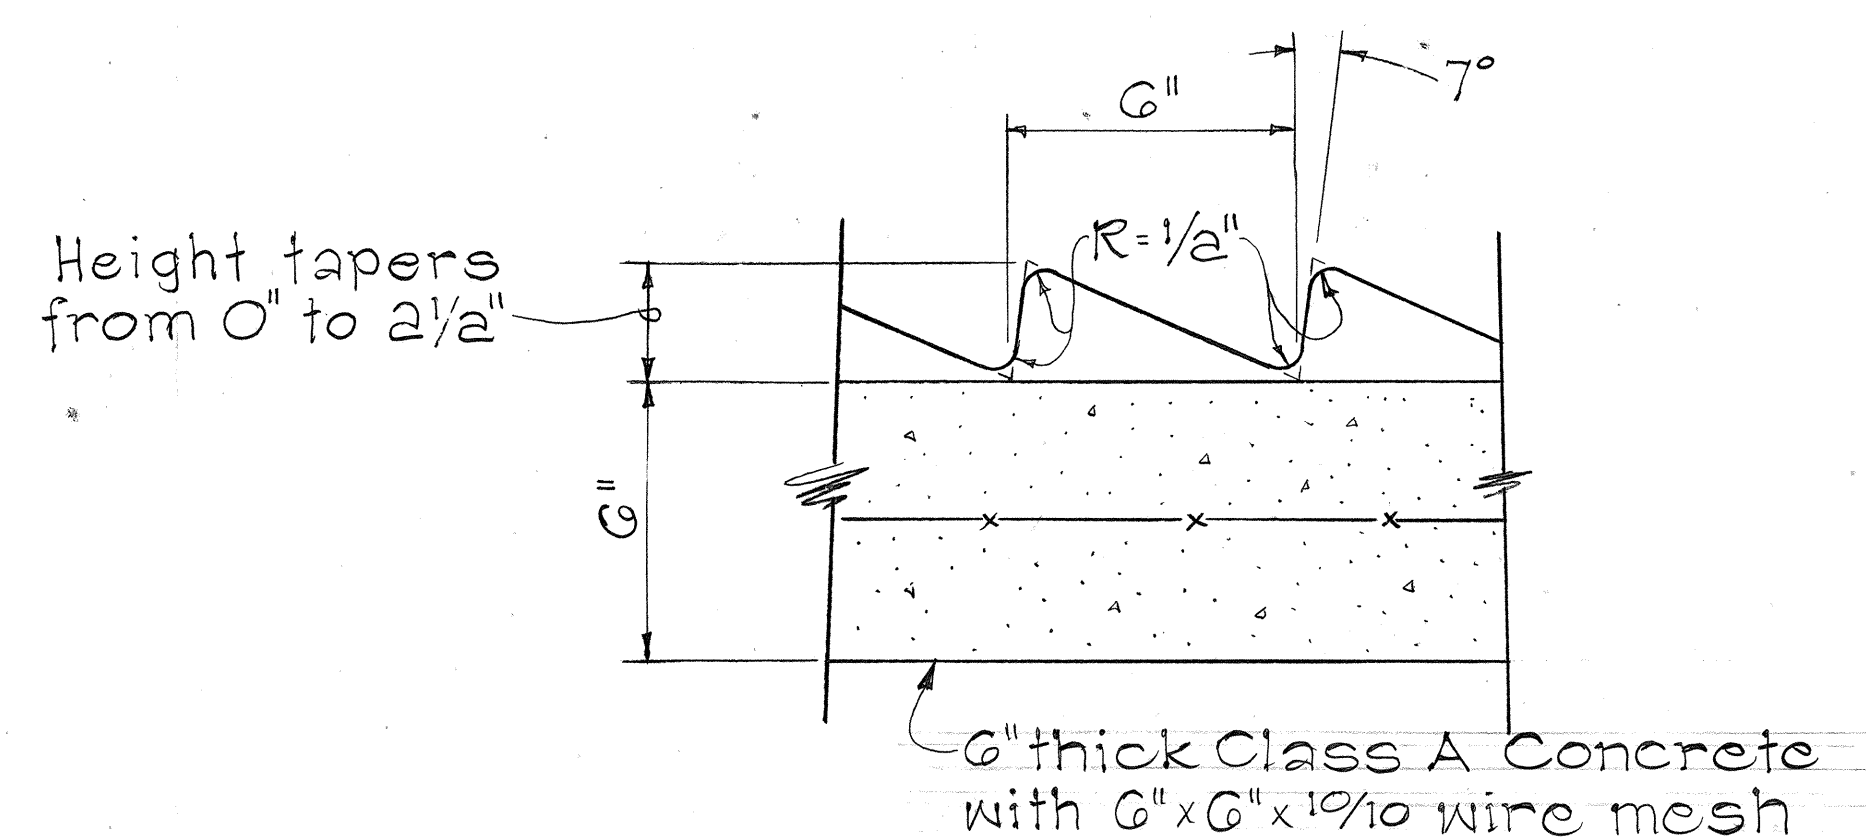
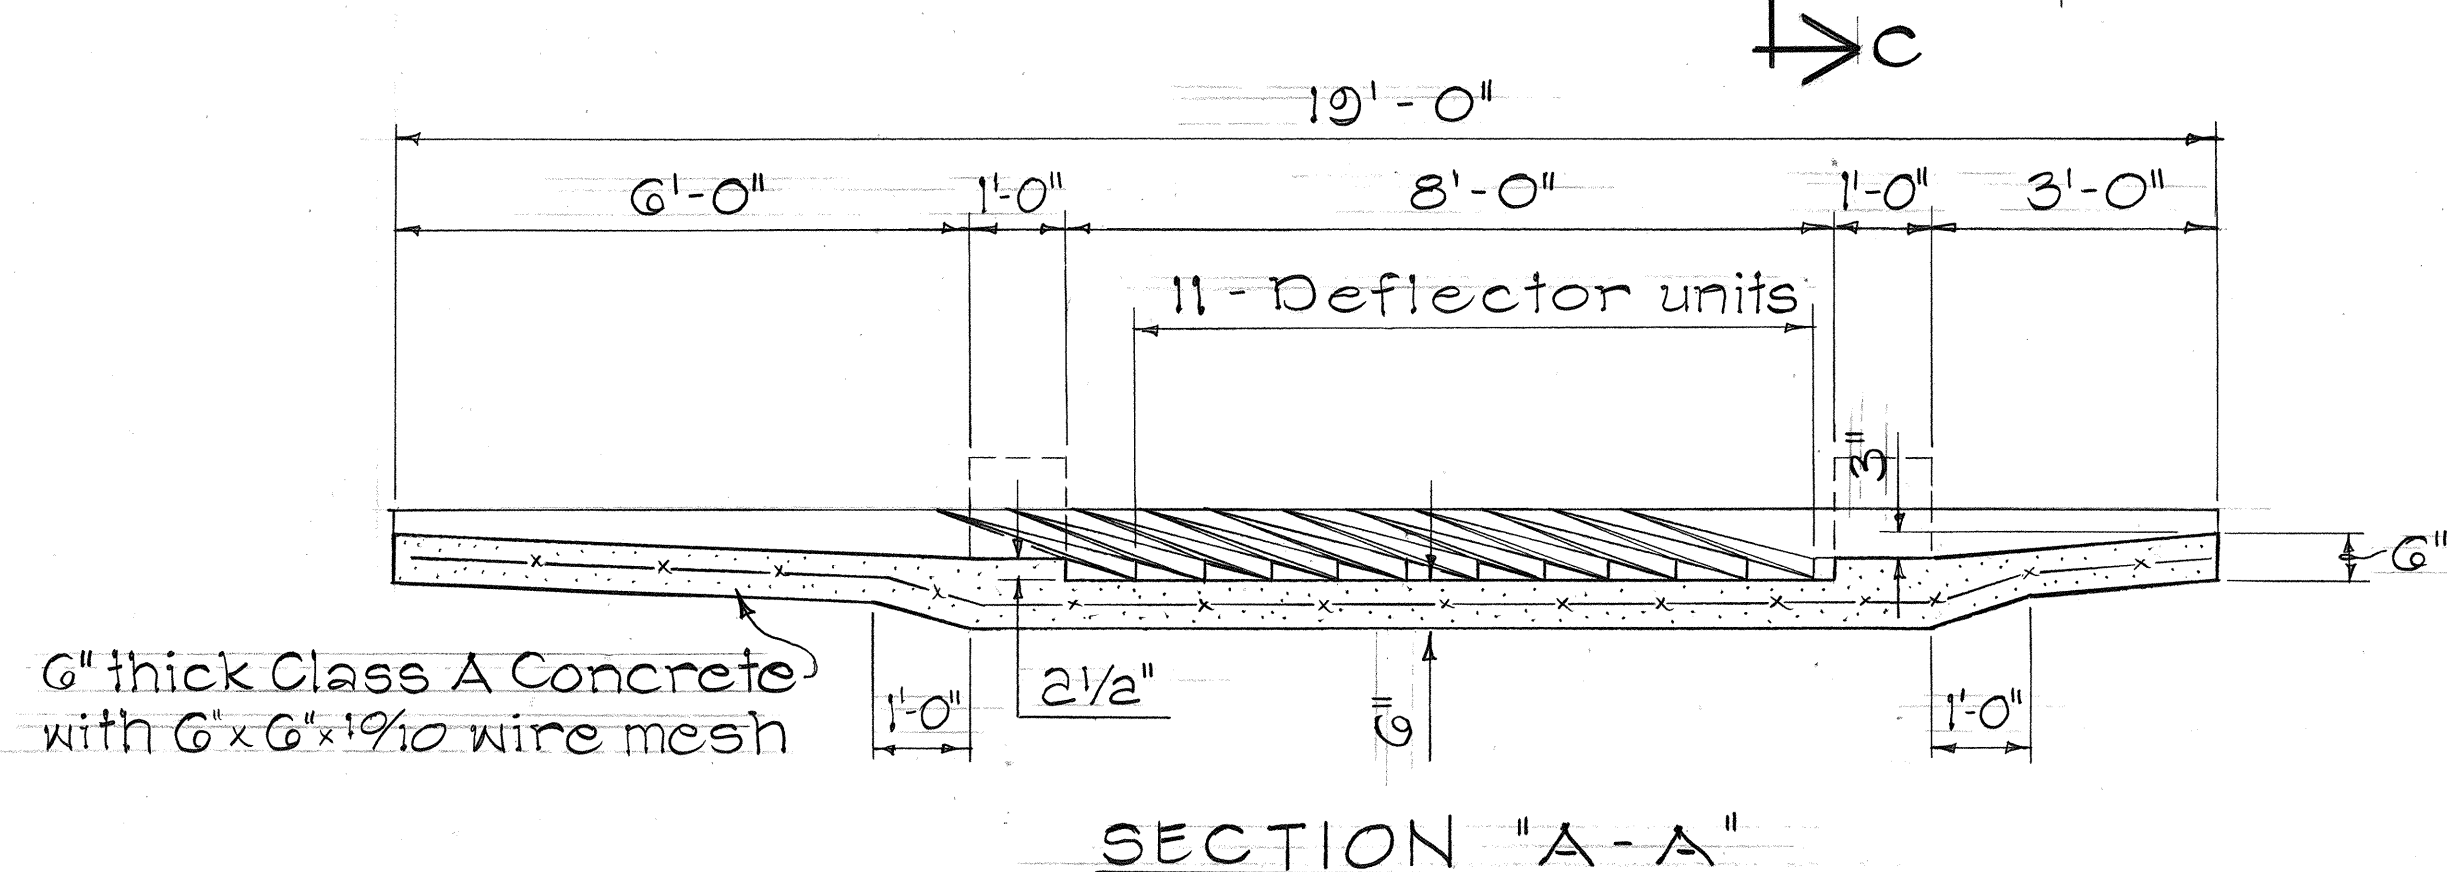
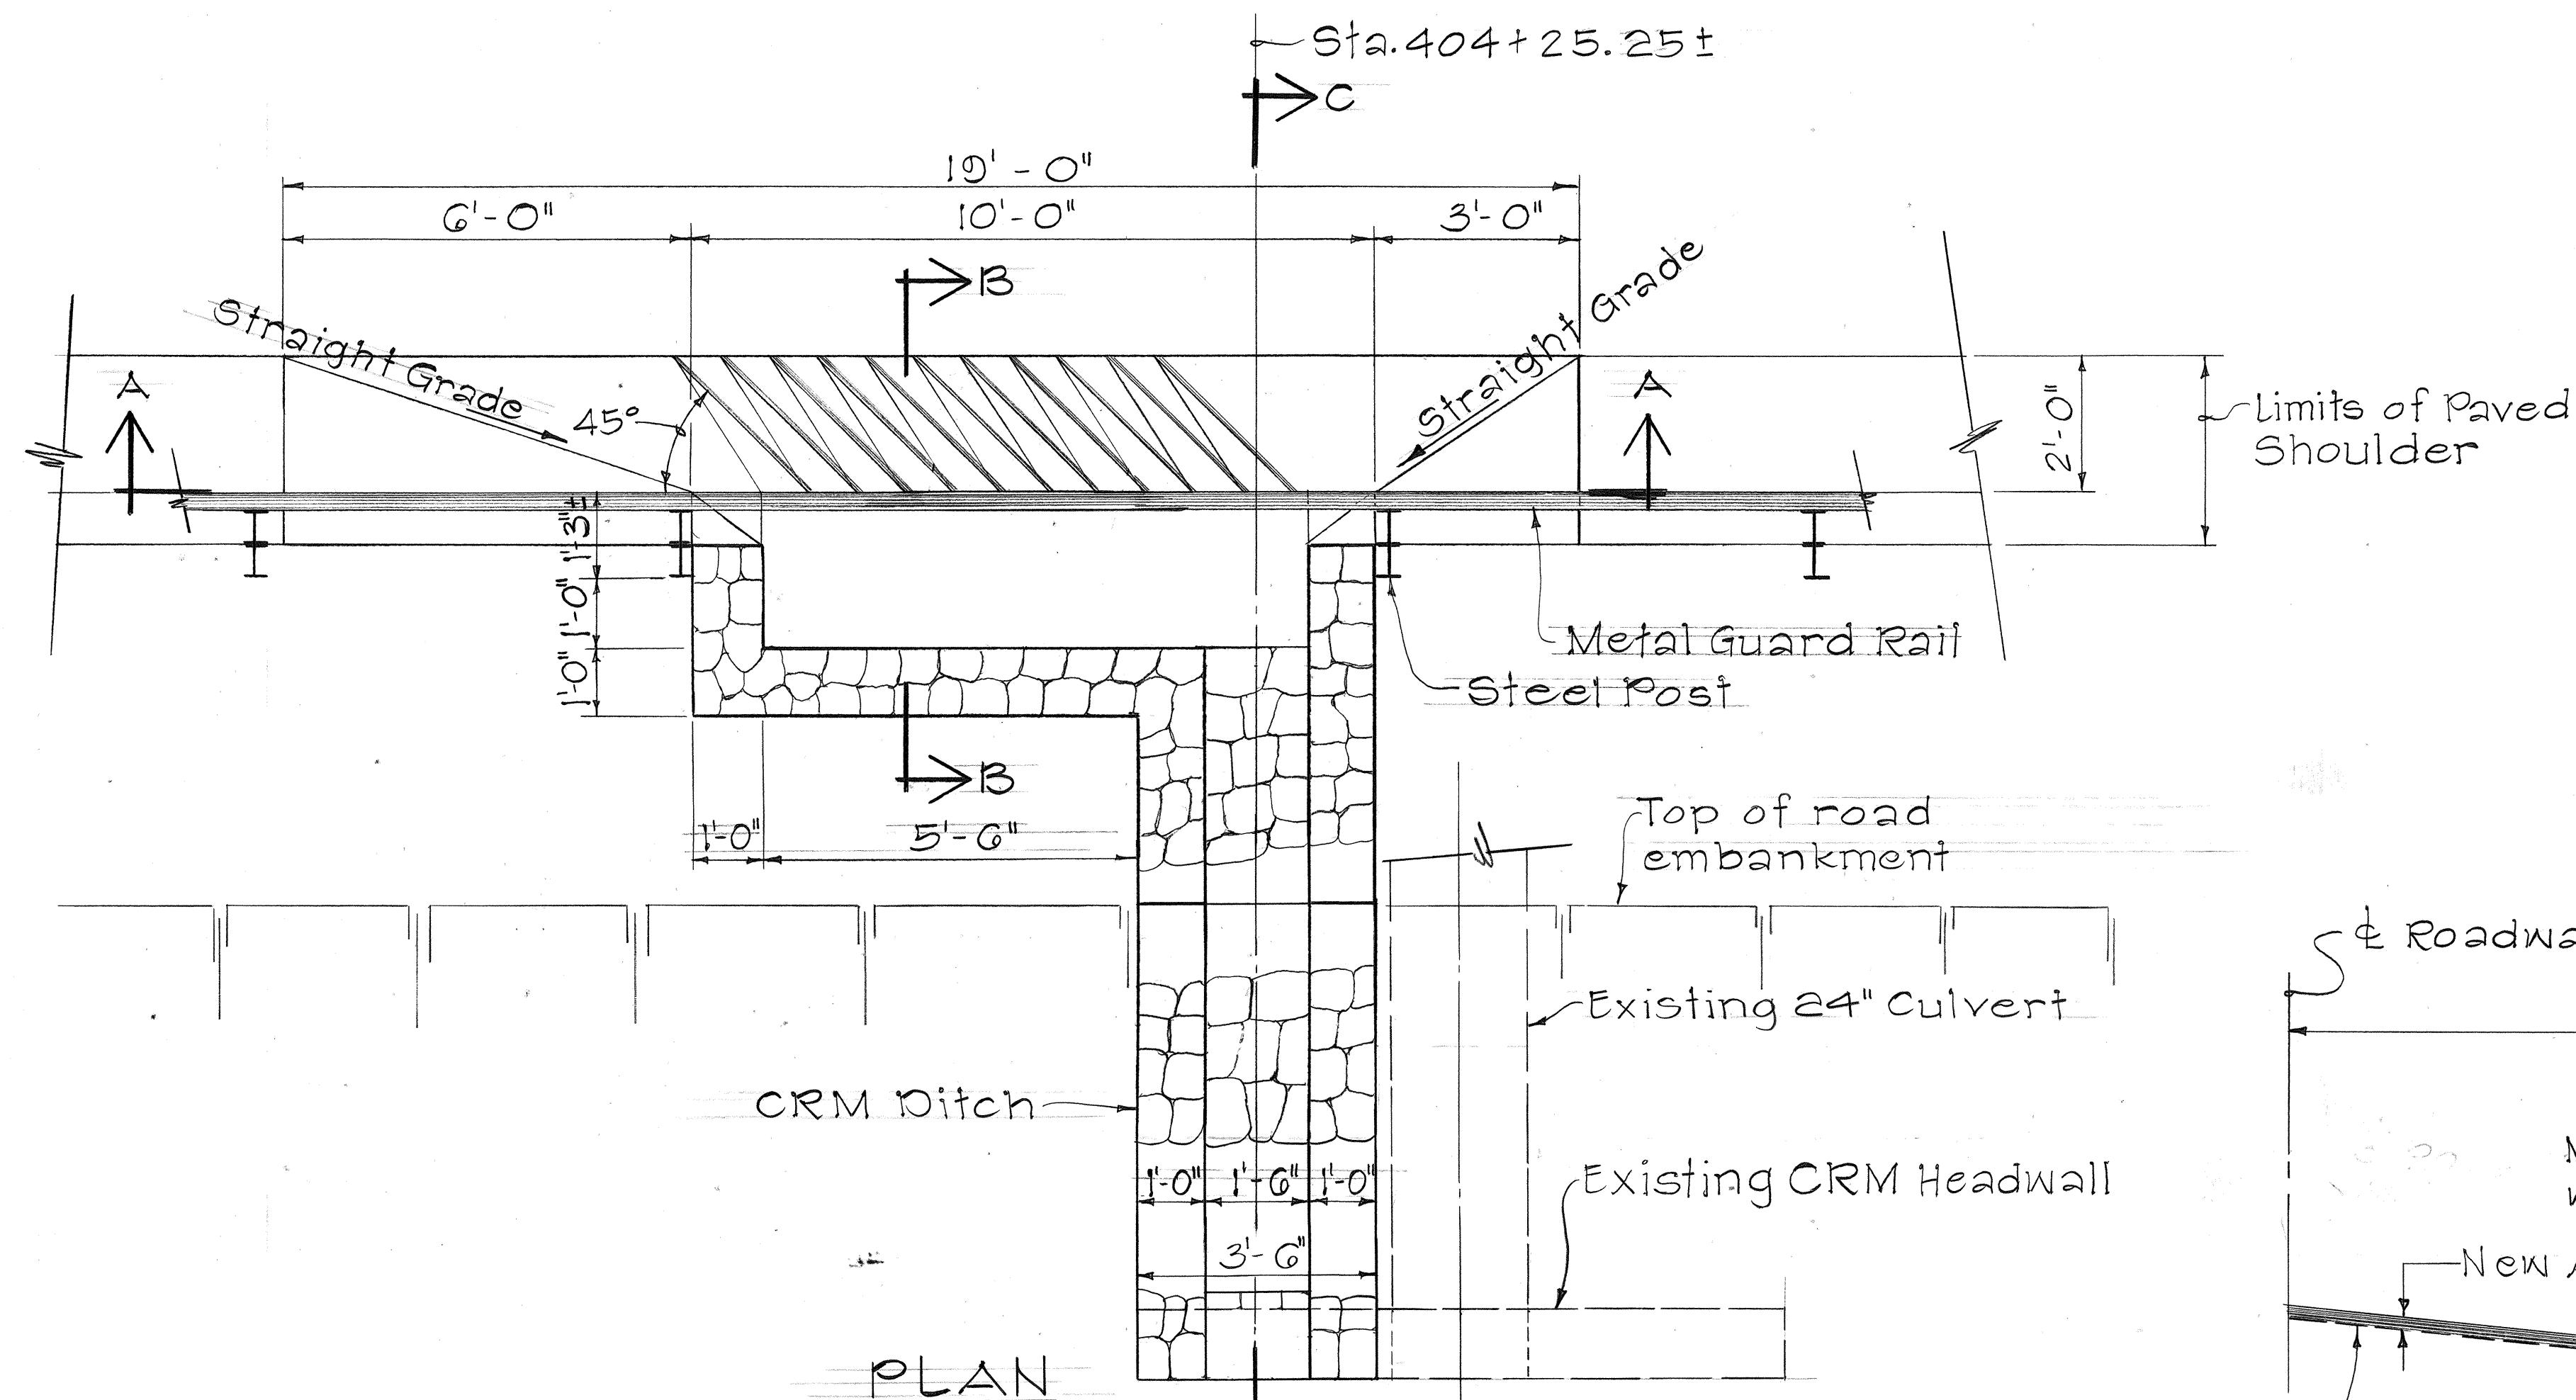
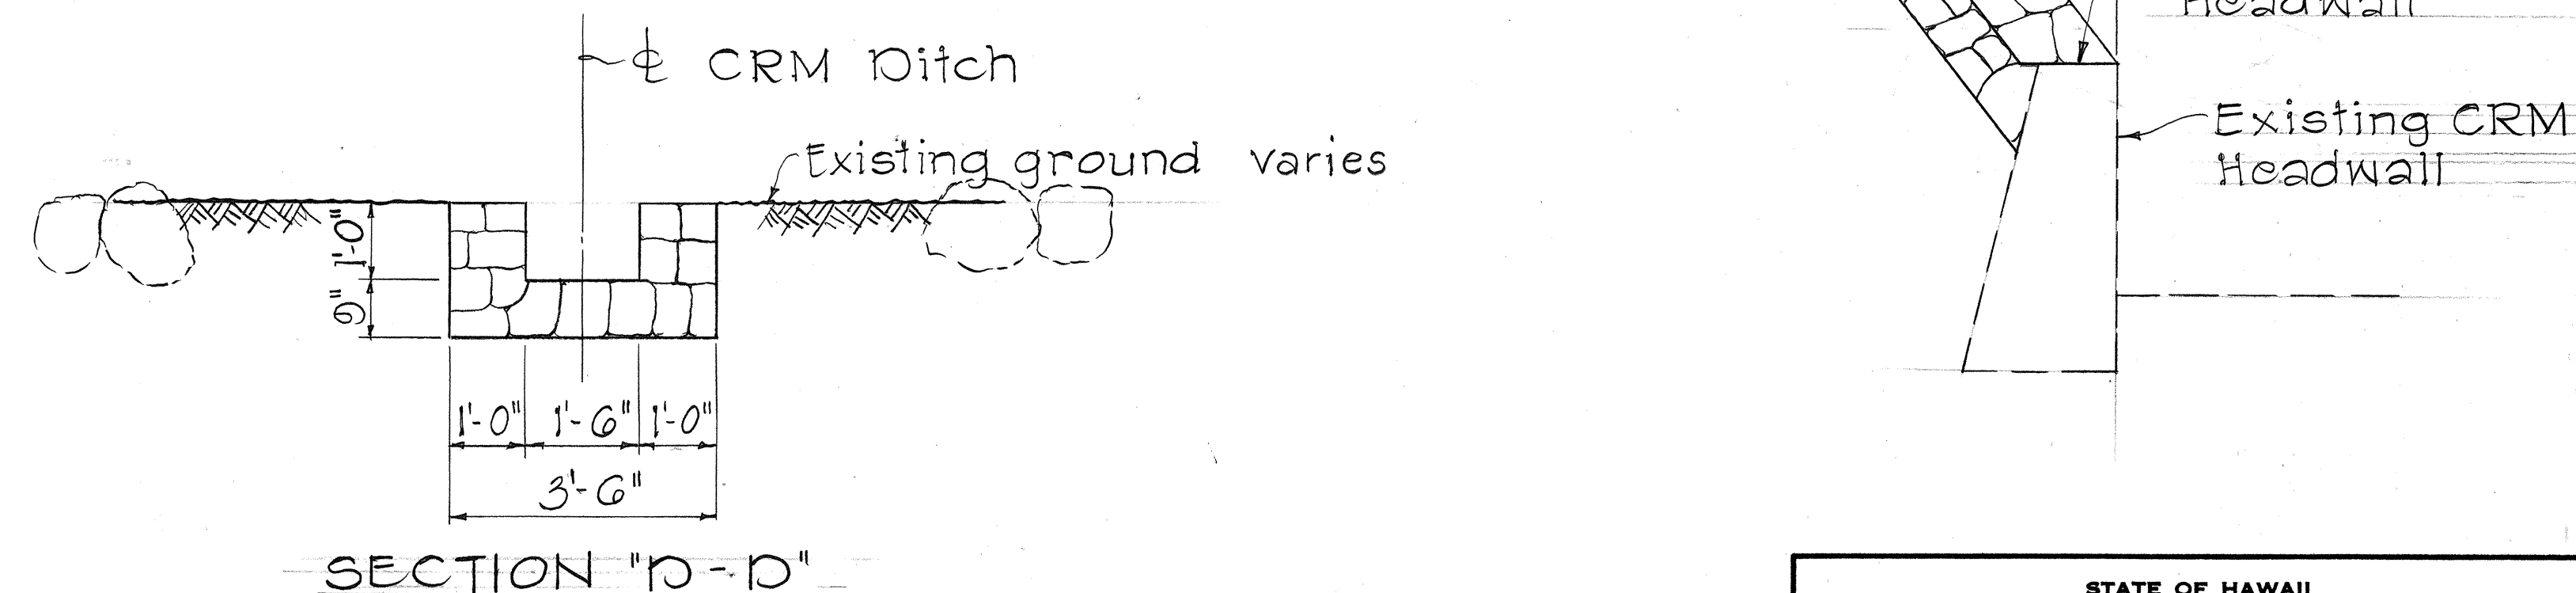


| FED. ROAD DIST. NO. | STATE | PROJ. NO.                   | FISCAL YEAR | SHEET NO. | TOTAL SHEETS |
|---------------------|-------|-----------------------------|-------------|-----------|--------------|
| HAWAII              | HAW.  | 7400A-01-82M<br>7400A-02-82 | 1982        | 9         | 30           |

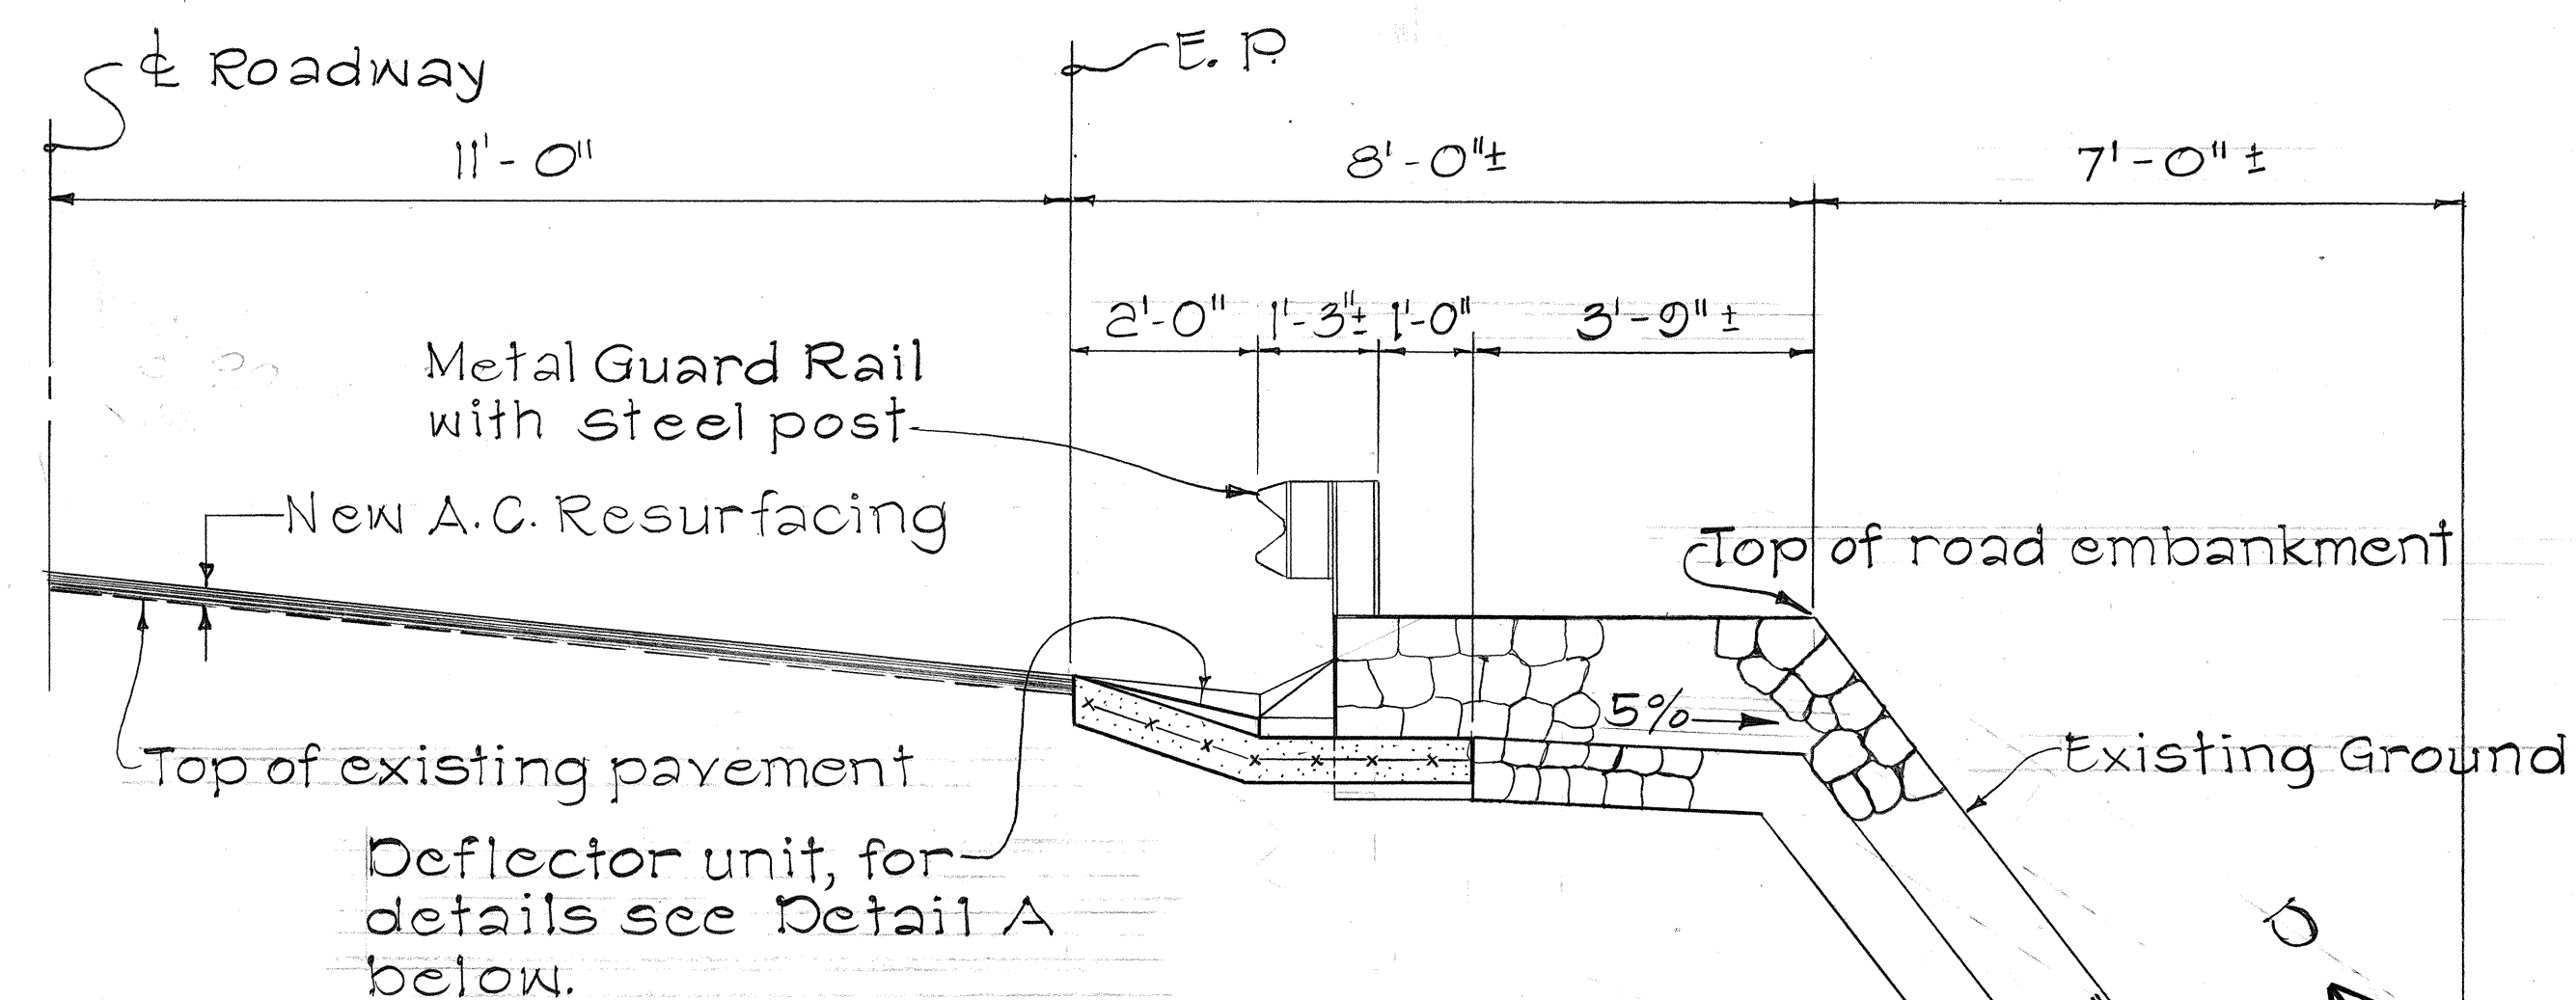

DETAIL "A"  
Scale: 3" = 1'-0"

DETAIL OF SPILLWAY AT STA. 404+25.25± RT.

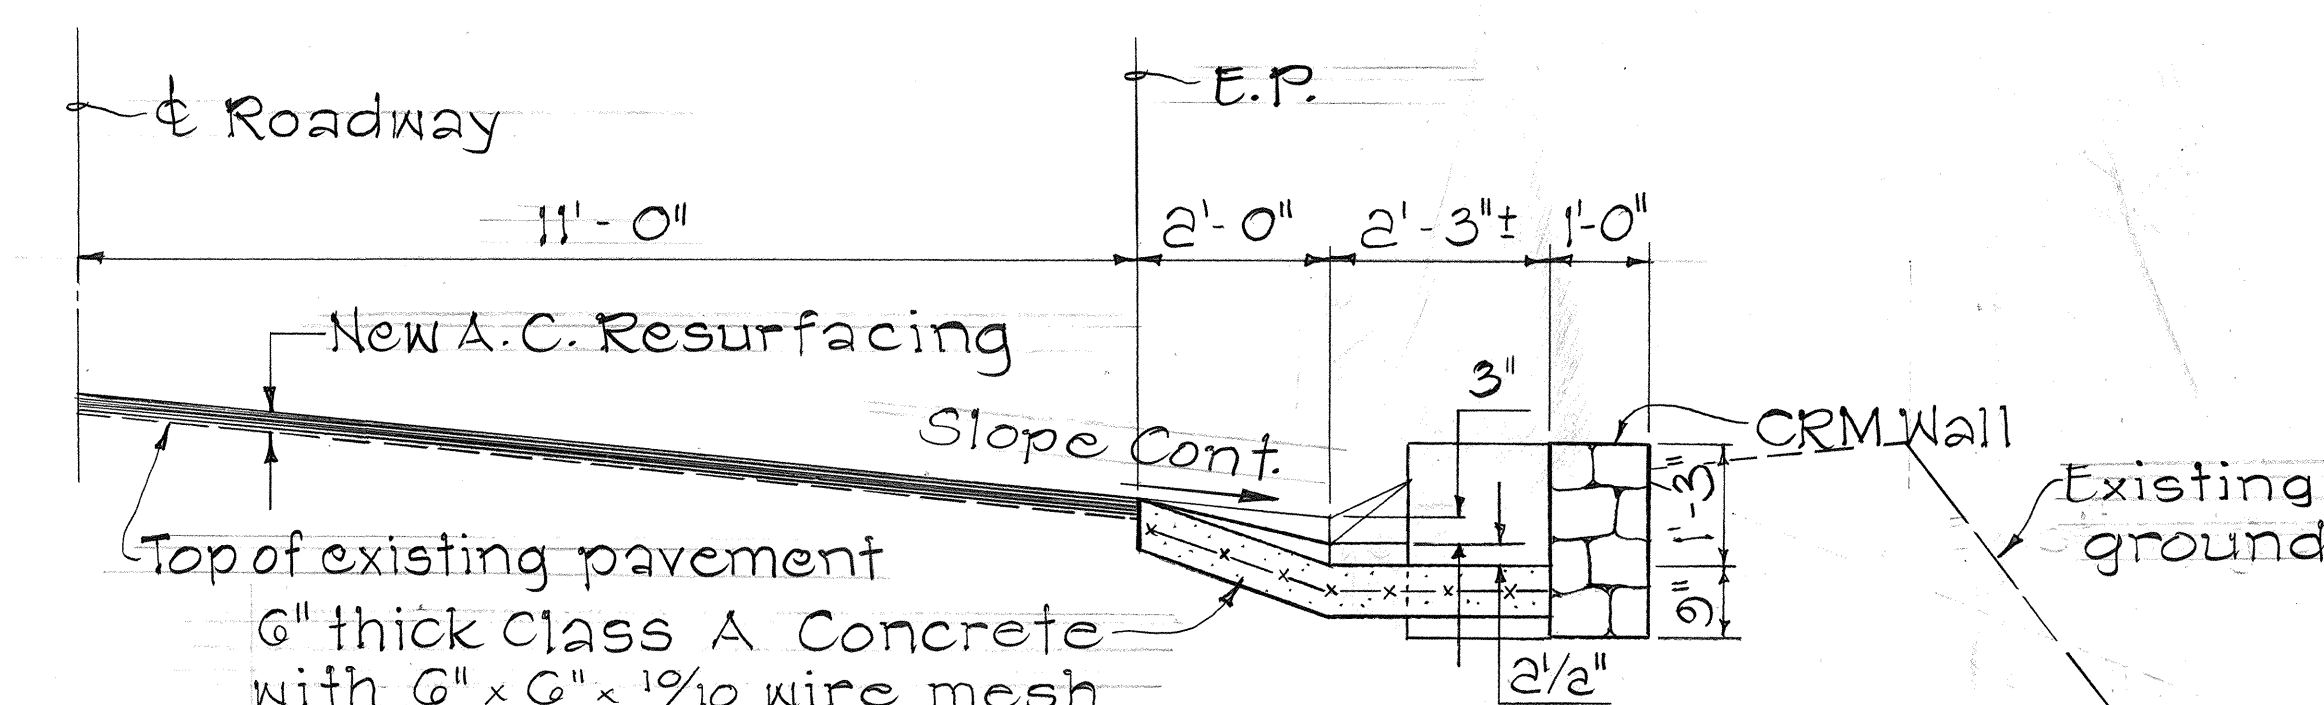

STATE OF HAWAII  
DEPARTMENT OF TRANSPORTATION  
LAND TRANSPORTATION FACILITIES DIVISION  
DRAINAGE DETAILS  
KALANIANAOLE HIGHWAY

PROJ. NO. 7400A-01-82M  
PROJ. NO. 7400A-02-82

Scale: 1/2" = 1'-0" Date: June, 1981  
SHEET NO. / OF / SHEETS