


FED. ROAD DIST. NO.	STATE	PROJ. NO.	FISCAL YEAR	SHEET NO.	TOTAL SHEETS
HAWAII	HAW.	7400A-01-82M 7400A-02-82	1982	7	30

ORIGINAL PLAN	SURVEY PLOTTED BY	DATE
DESIGNED BY	DRAWN BY	
CHECKED BY	NOTED BY	
NO.		

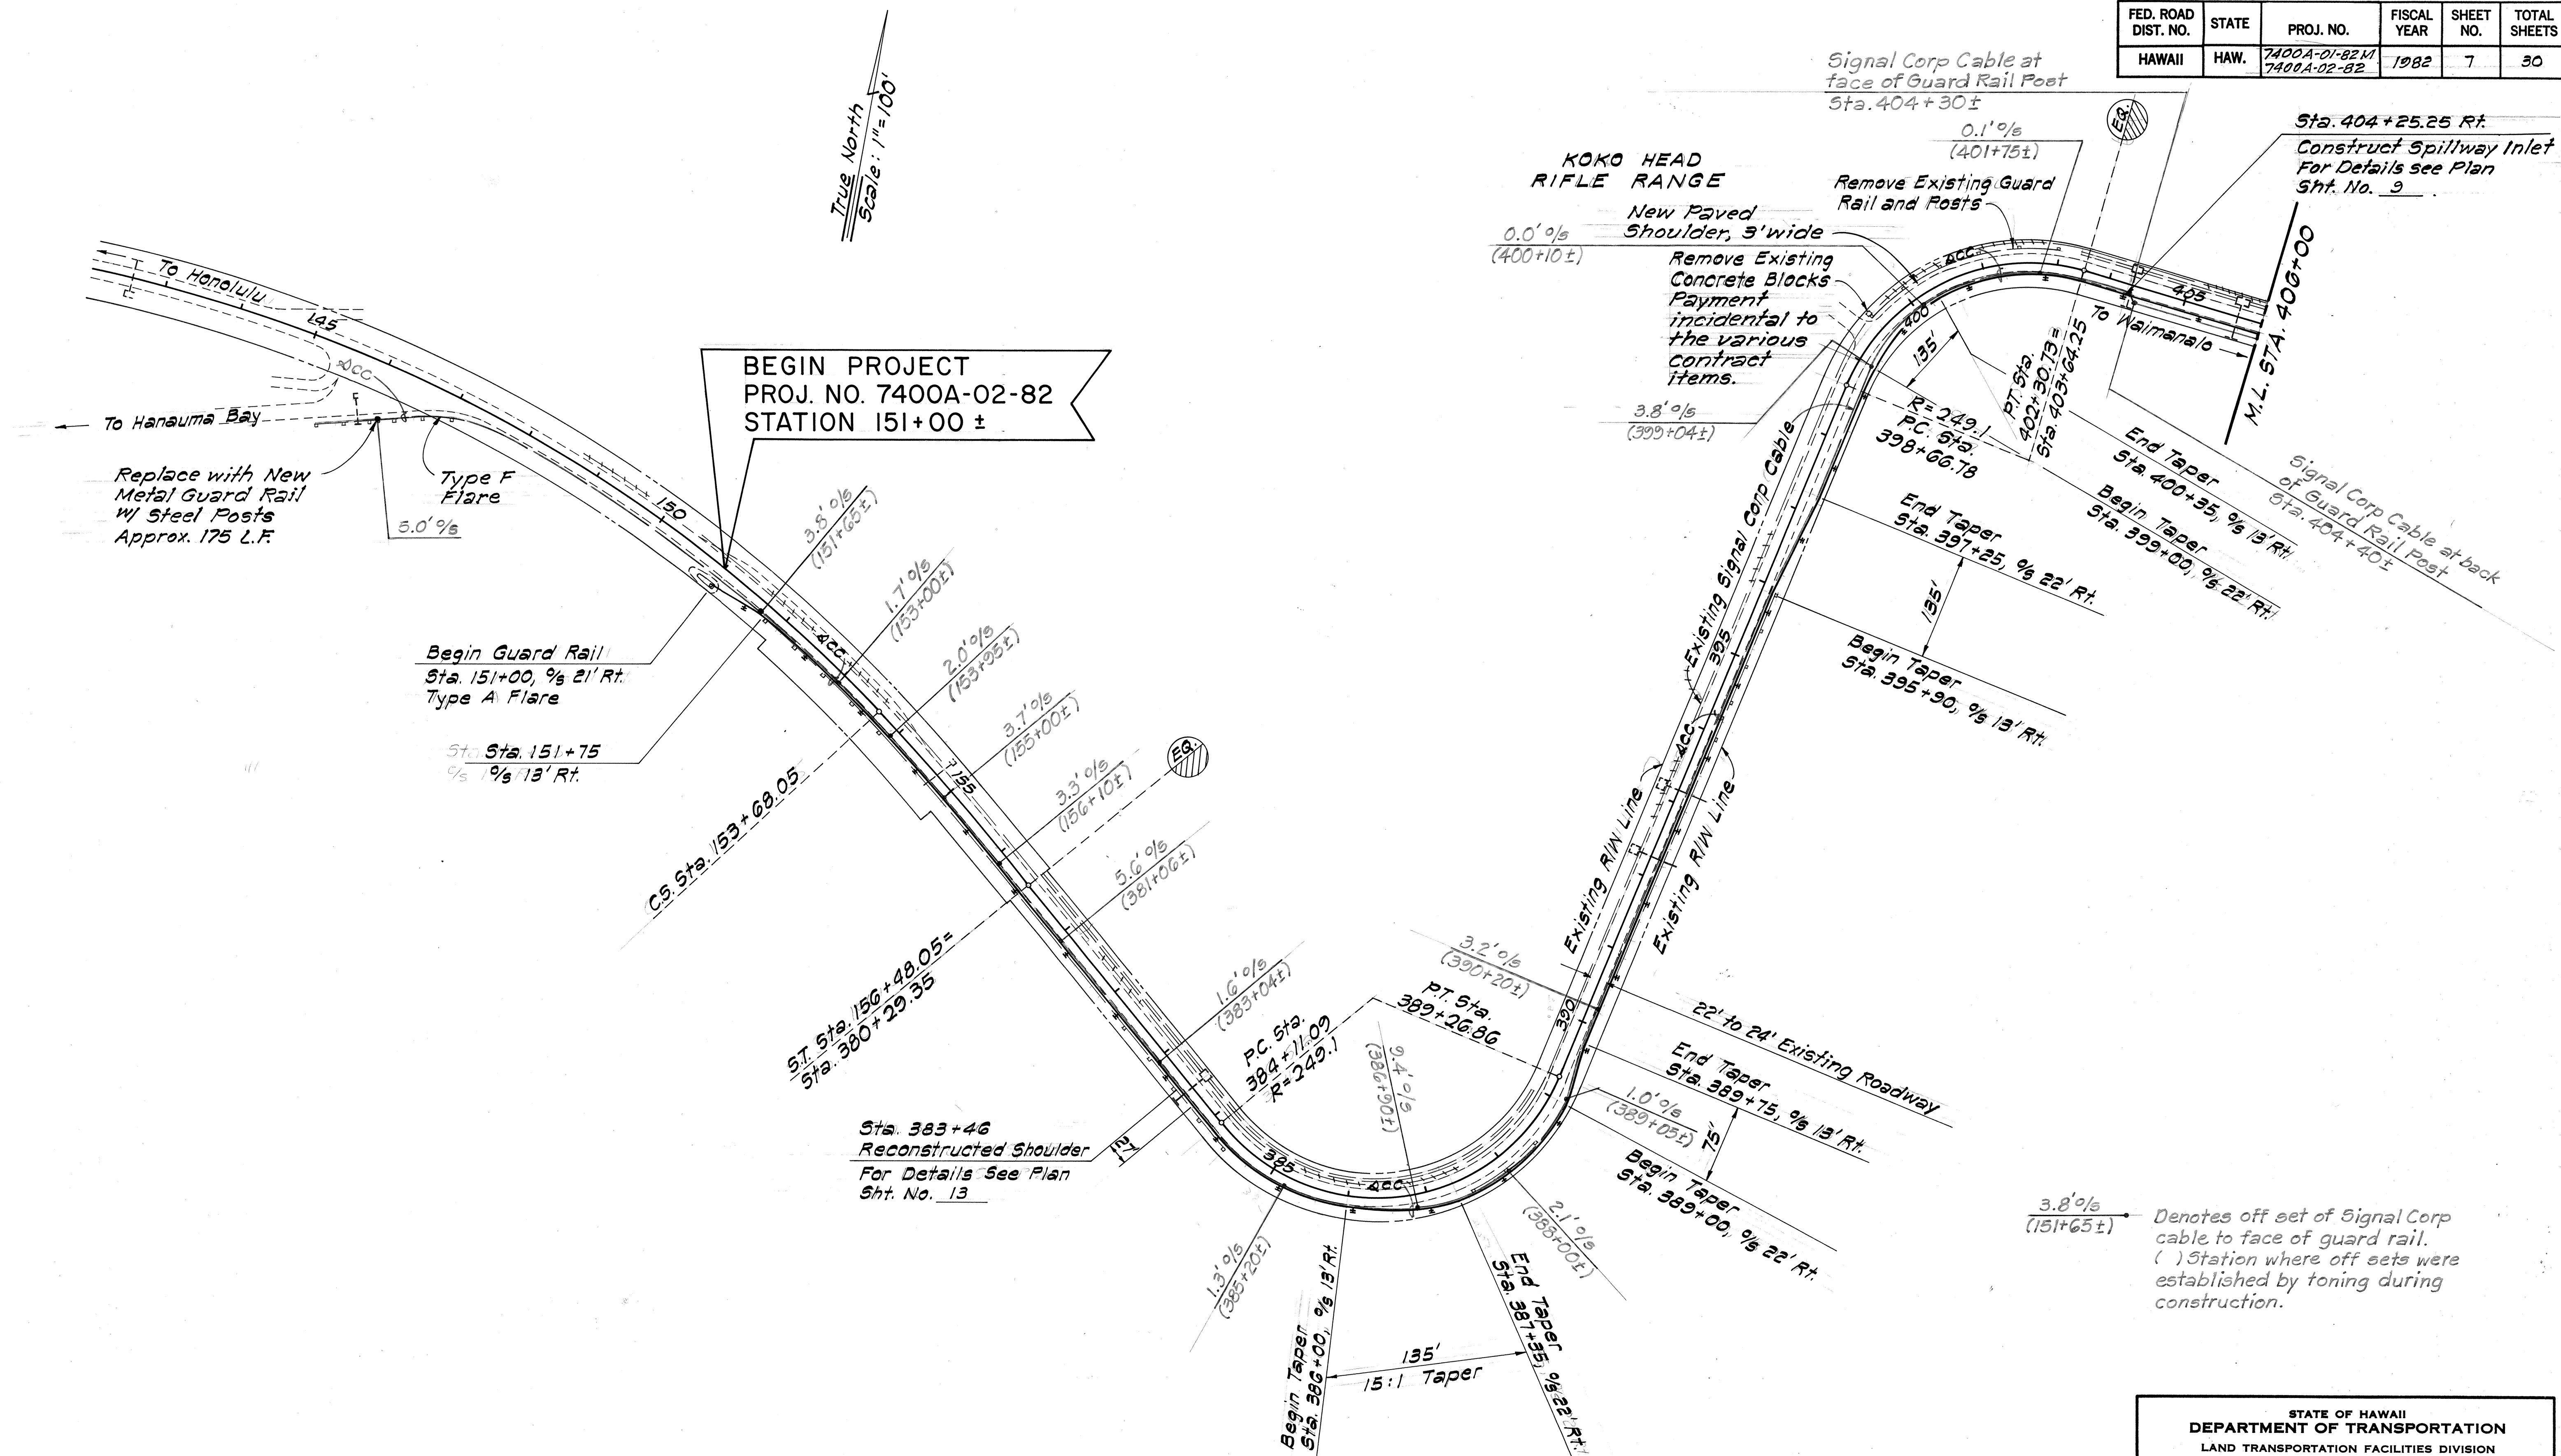


STATE OF HAWAII
DEPARTMENT OF TRANSPORTATION
LAND TRANSPORTATION FACILITIES DIVISION

GUARD RAIL & SHOULDER PLANS

KALANIANAʻOLE HIGHWAY
PROJ. NO. 7400A-01-82M
PROJ. NO. 7400A-02-82

Scale: 1"=100' Date: June, 1981
SHEET NO. 7 OF 2 SHEETS

FED. ROAD DIST. NO.	STATE	PROJ. NO.	FISCAL YEAR	SHEET NO.	TOTAL SHEETS
HAWAII	HAW.	7400A-01-82M 7400A-02-82	1982	8	30

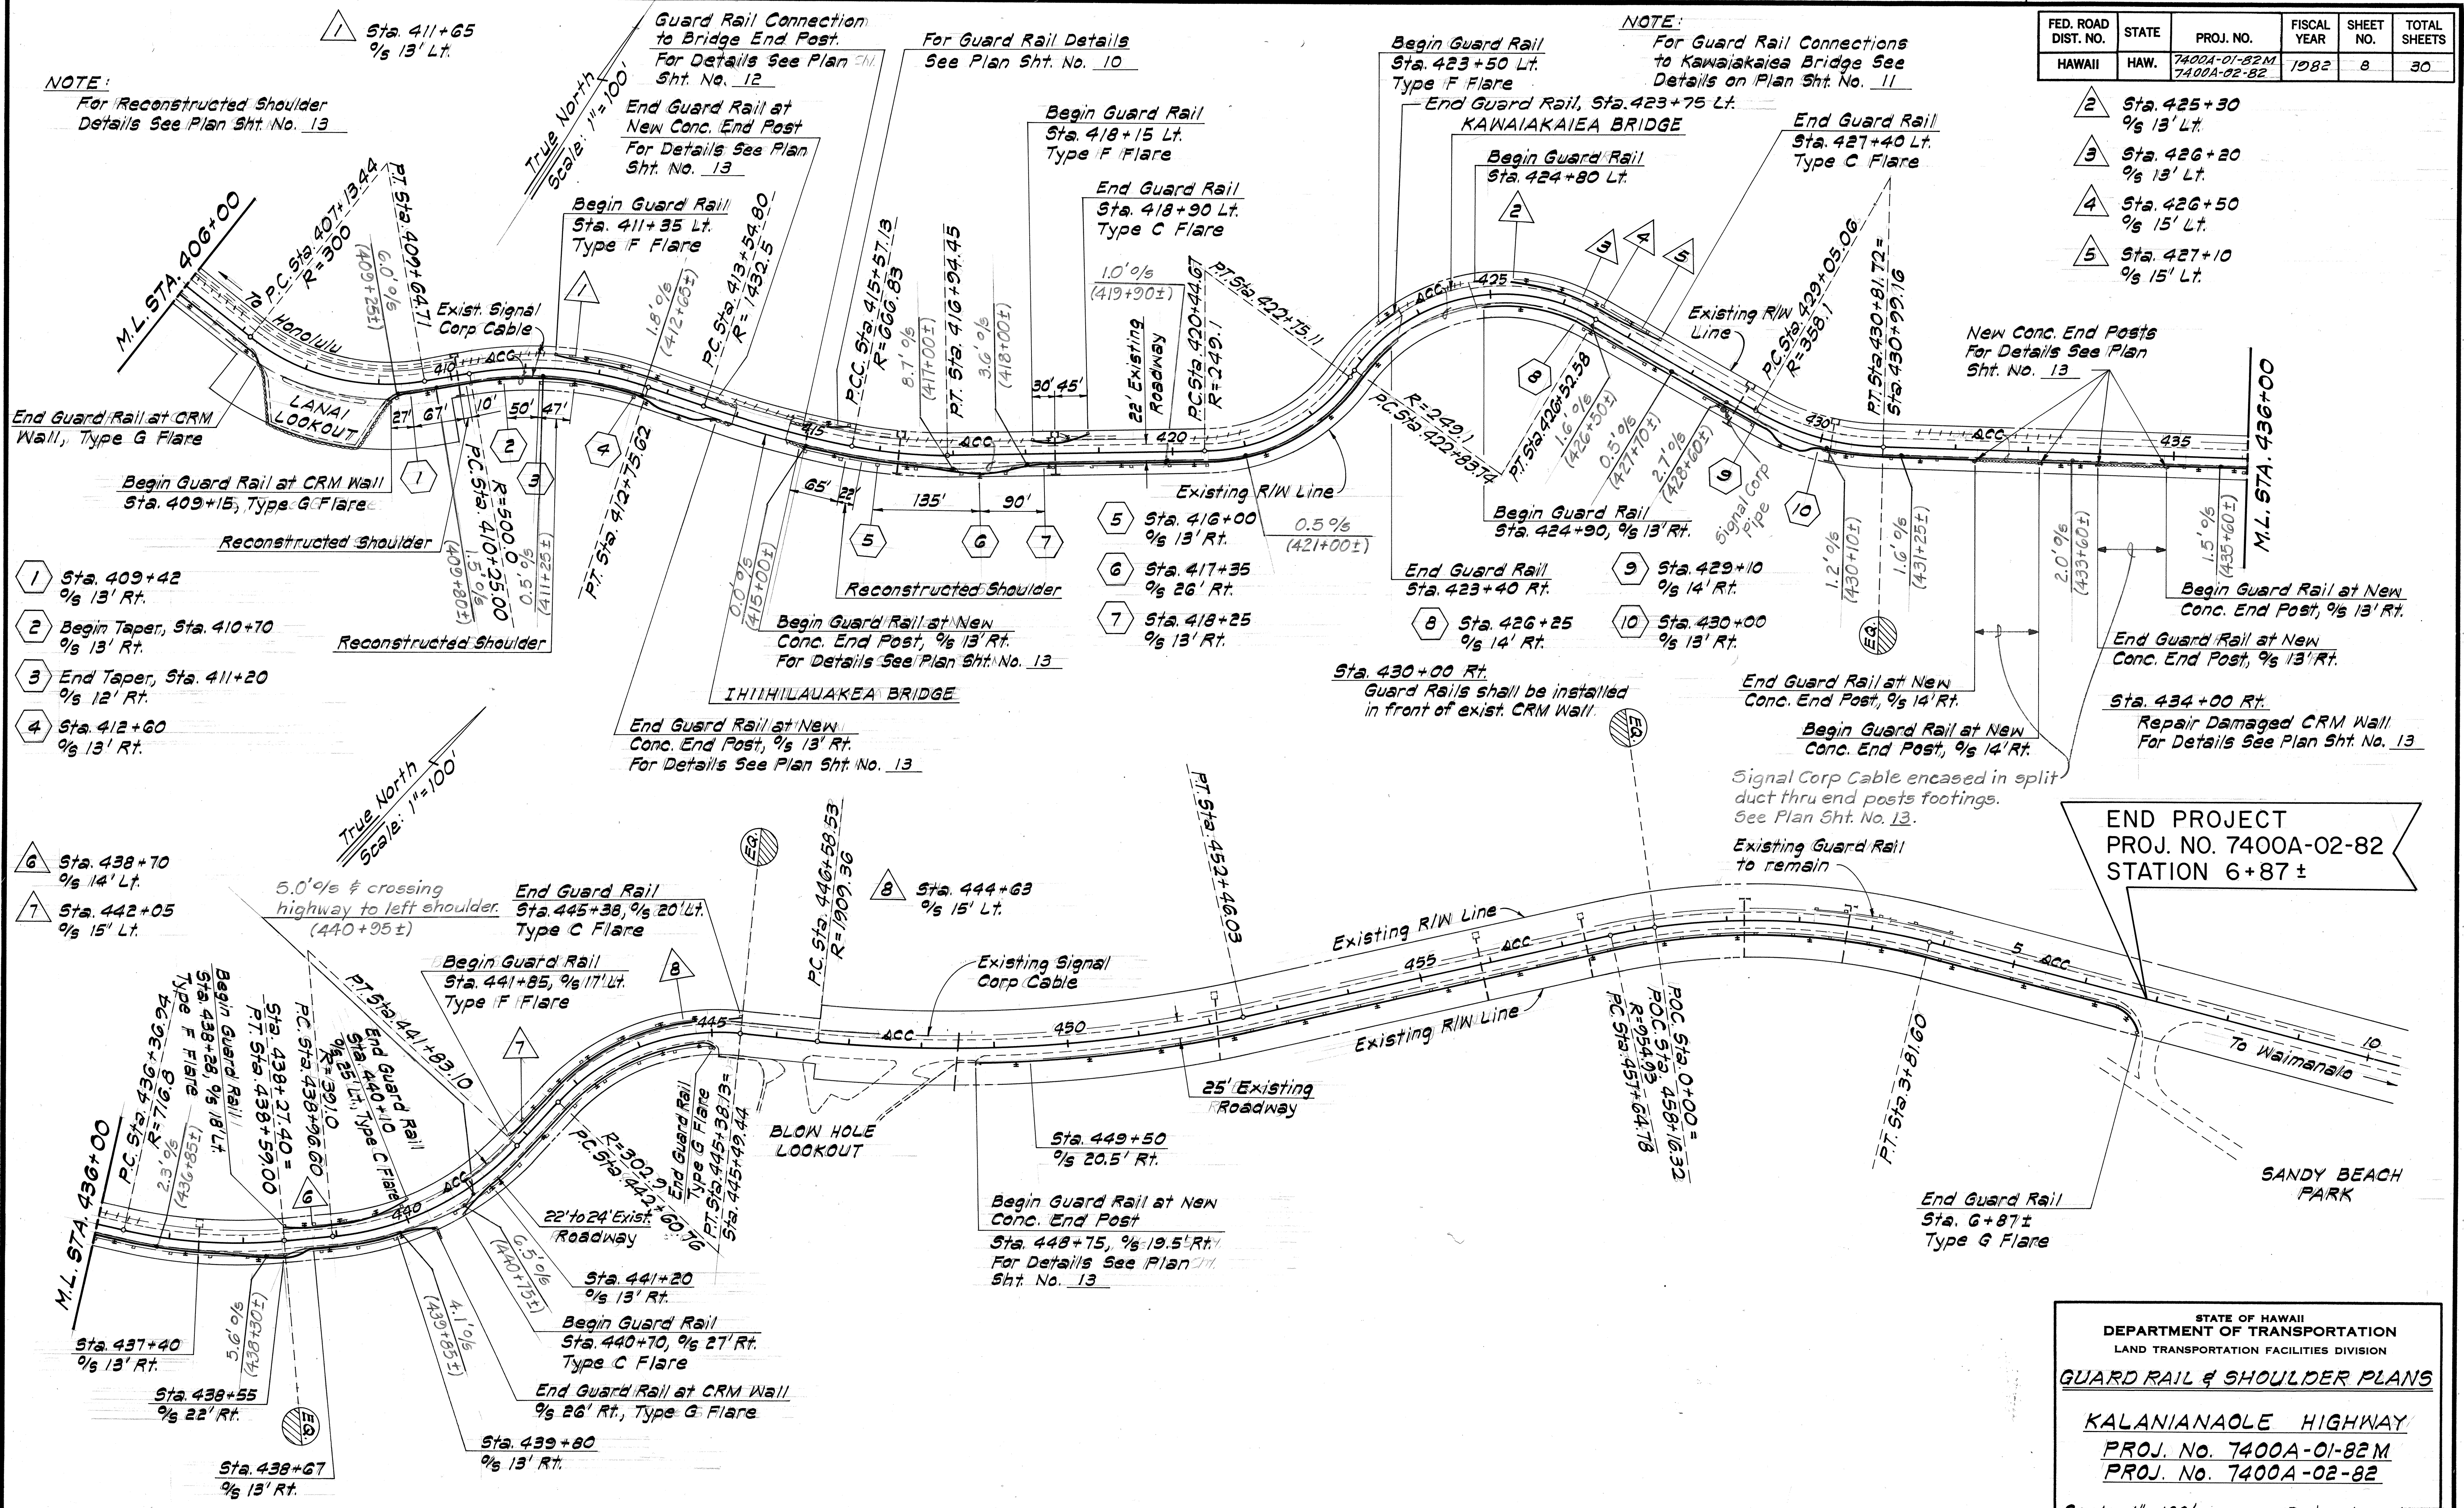

NOTE:
For Reconstructed Shoulder
Details See Plan Sht. No. 13

NOTE:
For Guard Rail Connections
to Kawaiikaiea Bridge See
Details on Plan Sht. No. 11

- 2 Sta. 425+30
% 13' Lt.
- 3 Sta. 426+20
% 13' Lt.
- 4 Sta. 426+50
% 15' Lt.
- 5 Sta. 427+10
% 15' Lt.

New Conc. End Posts
For Details See Plan
Sht. No. 13

END PROJECT
PROJ. NO. 7400A-02-82
STATION 6+87 ±

STATE OF HAWAII
DEPARTMENT OF TRANSPORTATION
LAND TRANSPORTATION FACILITIES DIVISION

GUARD RAIL & SHOULDER PLANS

KALANIANA'OLE HIGHWAY
PROJ. No. 7400A-01-82M
PROJ. No. 7400A-02-82

Scale: 1"=100' Date: June, 1981
SHEET No. 2 OF 2 SHEETS

ORIGINAL PLAN	DATE
DRAWN BY	
DESIGNED BY	
QUANTITIES BY	
CHECKED BY	
NO.	