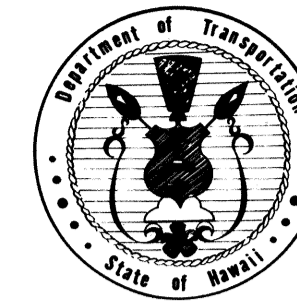


[illegible]

STATE OF HAWAII

DEPARTMENT OF TRANSPORTATION  
HIGHWAYS DIVISION


"AS - BUILT" PLANS FOR

KALANIANA'OLE HIGHWAY RESURFACING  
NAWILIWILI STREET TO BLOW HOLE LOOKOUT  
PROJECT NO. 7400A-01-82M



AND

KALANIANA'OLE HIGHWAY  
GUARD RAIL AND SHOULDER IMPROVEMENTS  
HANAUMA BAY TO SANDY BEACH  
PROJECT NO. 7400A-02-82

DISTRICT OF HONOLULU  
ISLAND OF OAHU

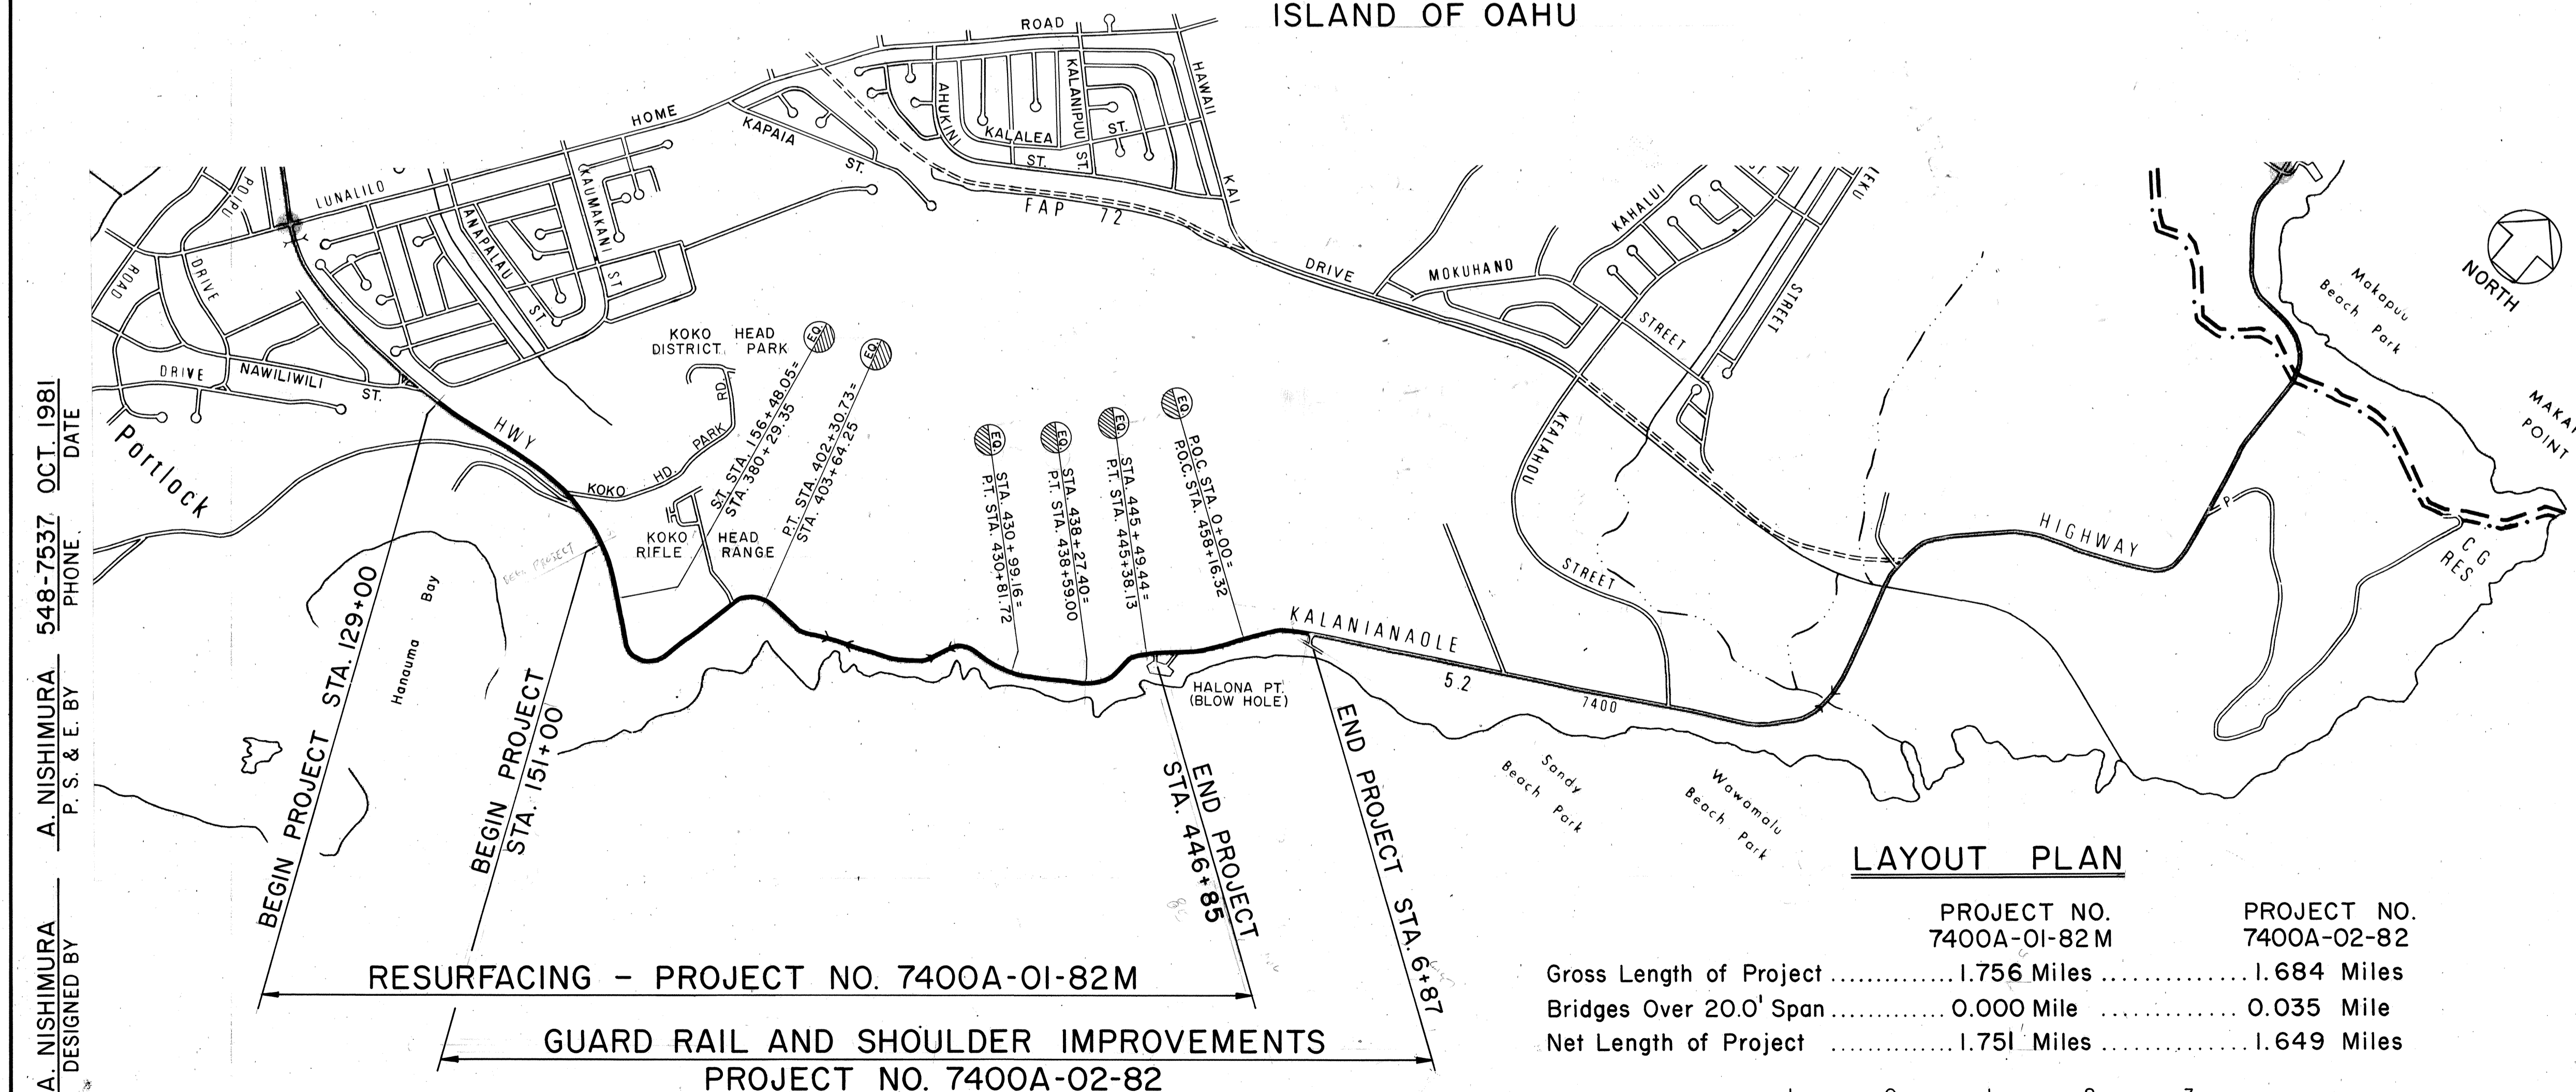

FED. ROAD DIST. NO.	STATE	PROJ. NO.	FISCAL YEAR	SHEET NO.	TOTAL SHEETS
HAWAII	HAW.	7400A-01-82M 7400A-02-82	1982	1	30

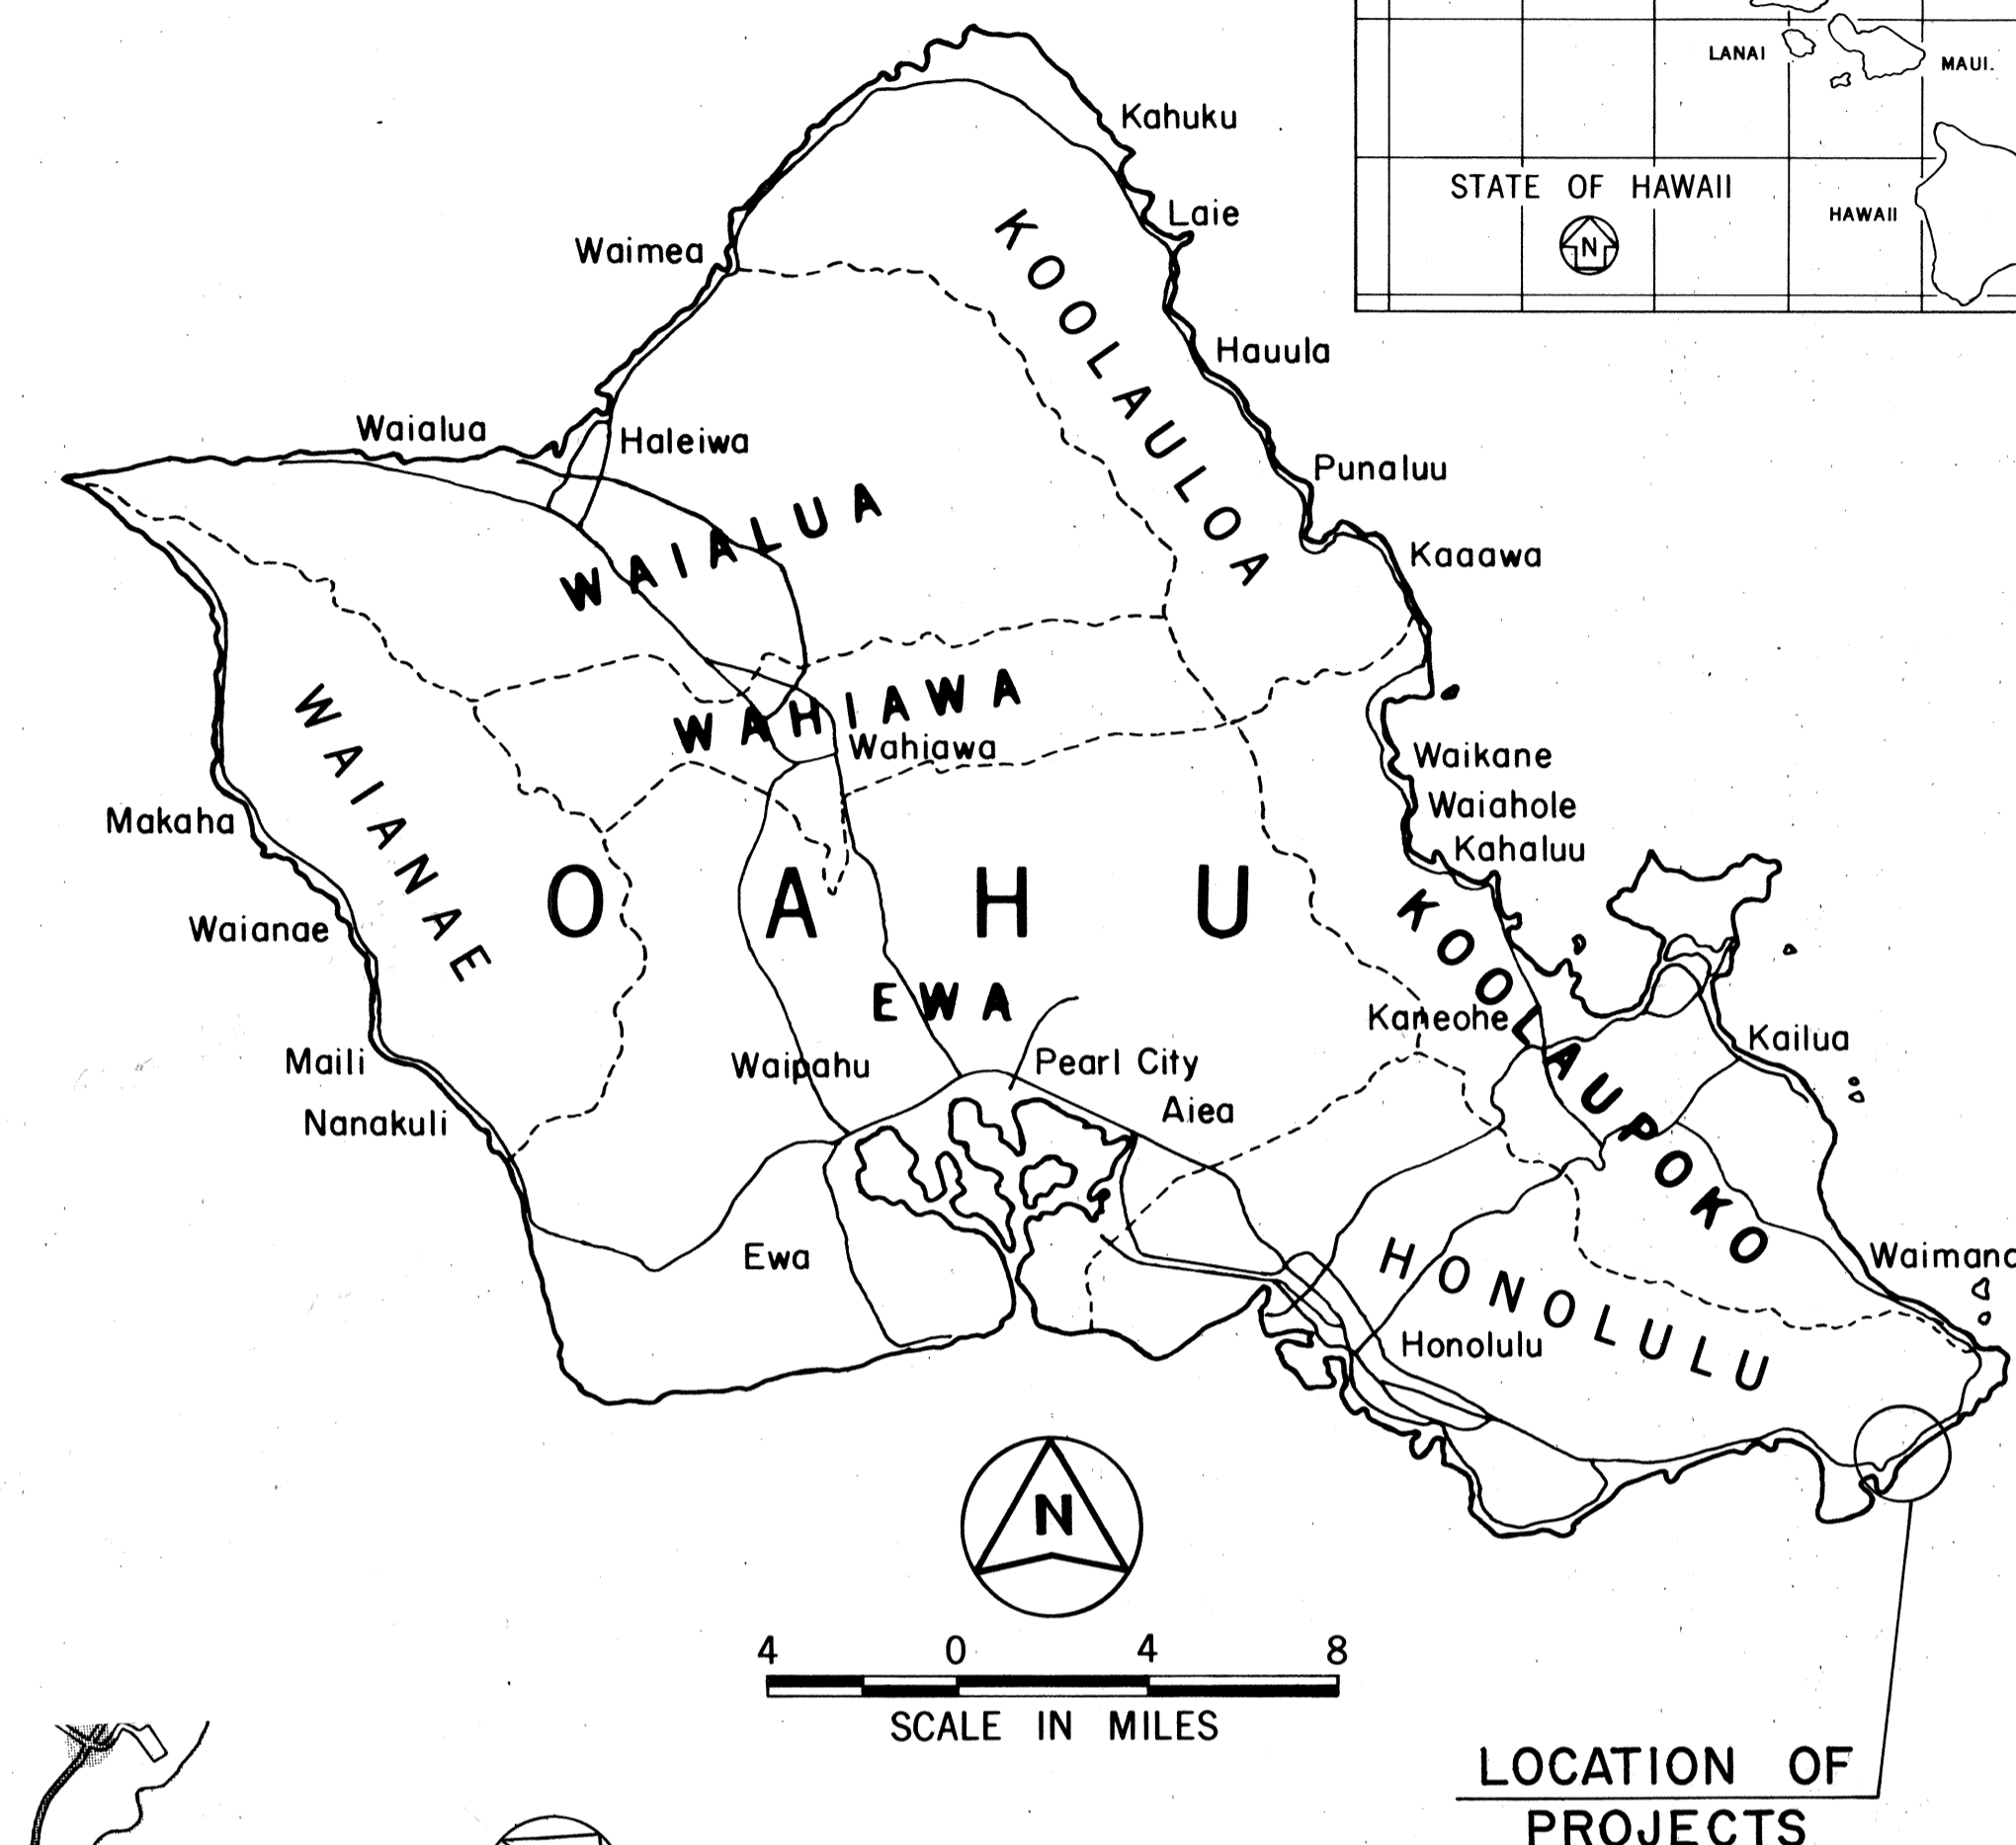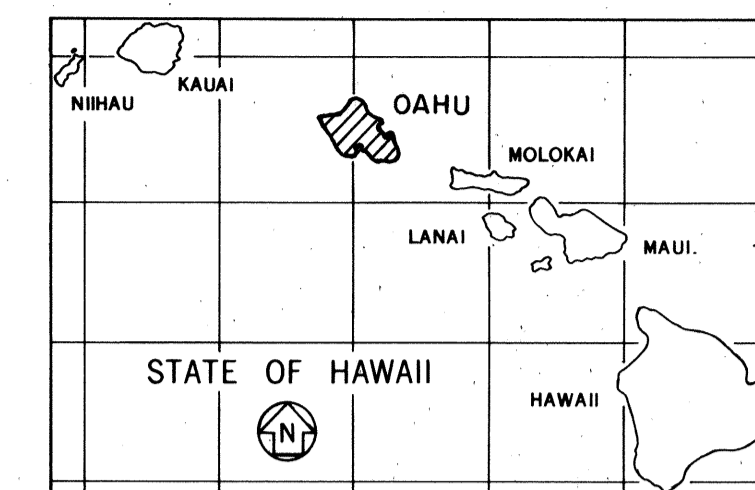

CHANGES MADE DURING CONSTRUCTION HAVE  
BEEN INCORPORATED ON THESE PLANS EXCEPT  
CHANGES IN THE ORIGINAL THEORETICAL  
QUANTITIES. FOR ACTUAL QUANTITIES, REFER TO  
PROJECT LEDGER AND/OR COMPUTATION BOOK.

Wanan Miyashiro  
RESIDENT ENGINEER

10-2-84  
DATE

DEPARTMENT OF TRANSPORTATION  
STATE OF HAWAII

APPROVED:

*James R Carras* 10/22/2010

DIR OF TRANSPORTATION