* ;	
	INDEX TO DRAWINGS
SHEET NO.	DESCRIPTION
1	TITLE SHEET
2	GENERAL NOTES AND DETAILS OF MONUMENT ADJUSTMENTS
3	TYPICAL SECTIONS AND MISC. BRIDGE DETAILS
4 - 9	PLAN
10 = 15	PAVEMENT MARKING & SIGNING PLAN
16	MISCELLANEOUS DETAILS
17-23	STANDARD DETAILS
•	




STATE OF HAWAII



DEPARTMENT OF TRANSPORTATION HIGHWAYS DIVISION "AS - BUILT" PLANS FOR

KALANIANAOLE HIGHWAY, RESURFACING KIRKWOOD STREET TOWARDS PORTLOCK ROAD PROJECT NO. HWY-0-01-83M

> DISTRICT OF HONOLULU ISLAND OF OAHU

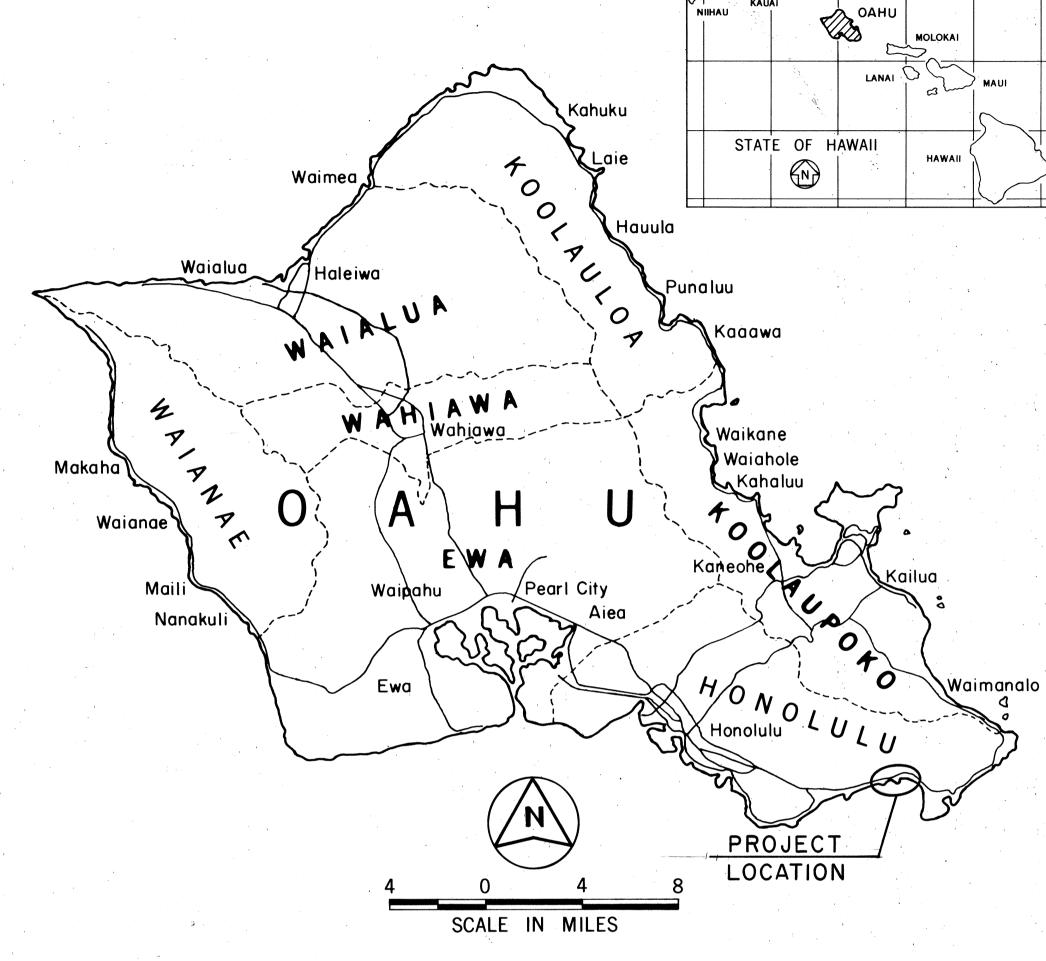


FED. ROAD DIST. NO.

PROJ. NO.

HWY-0-01-83M 1983

YEAR

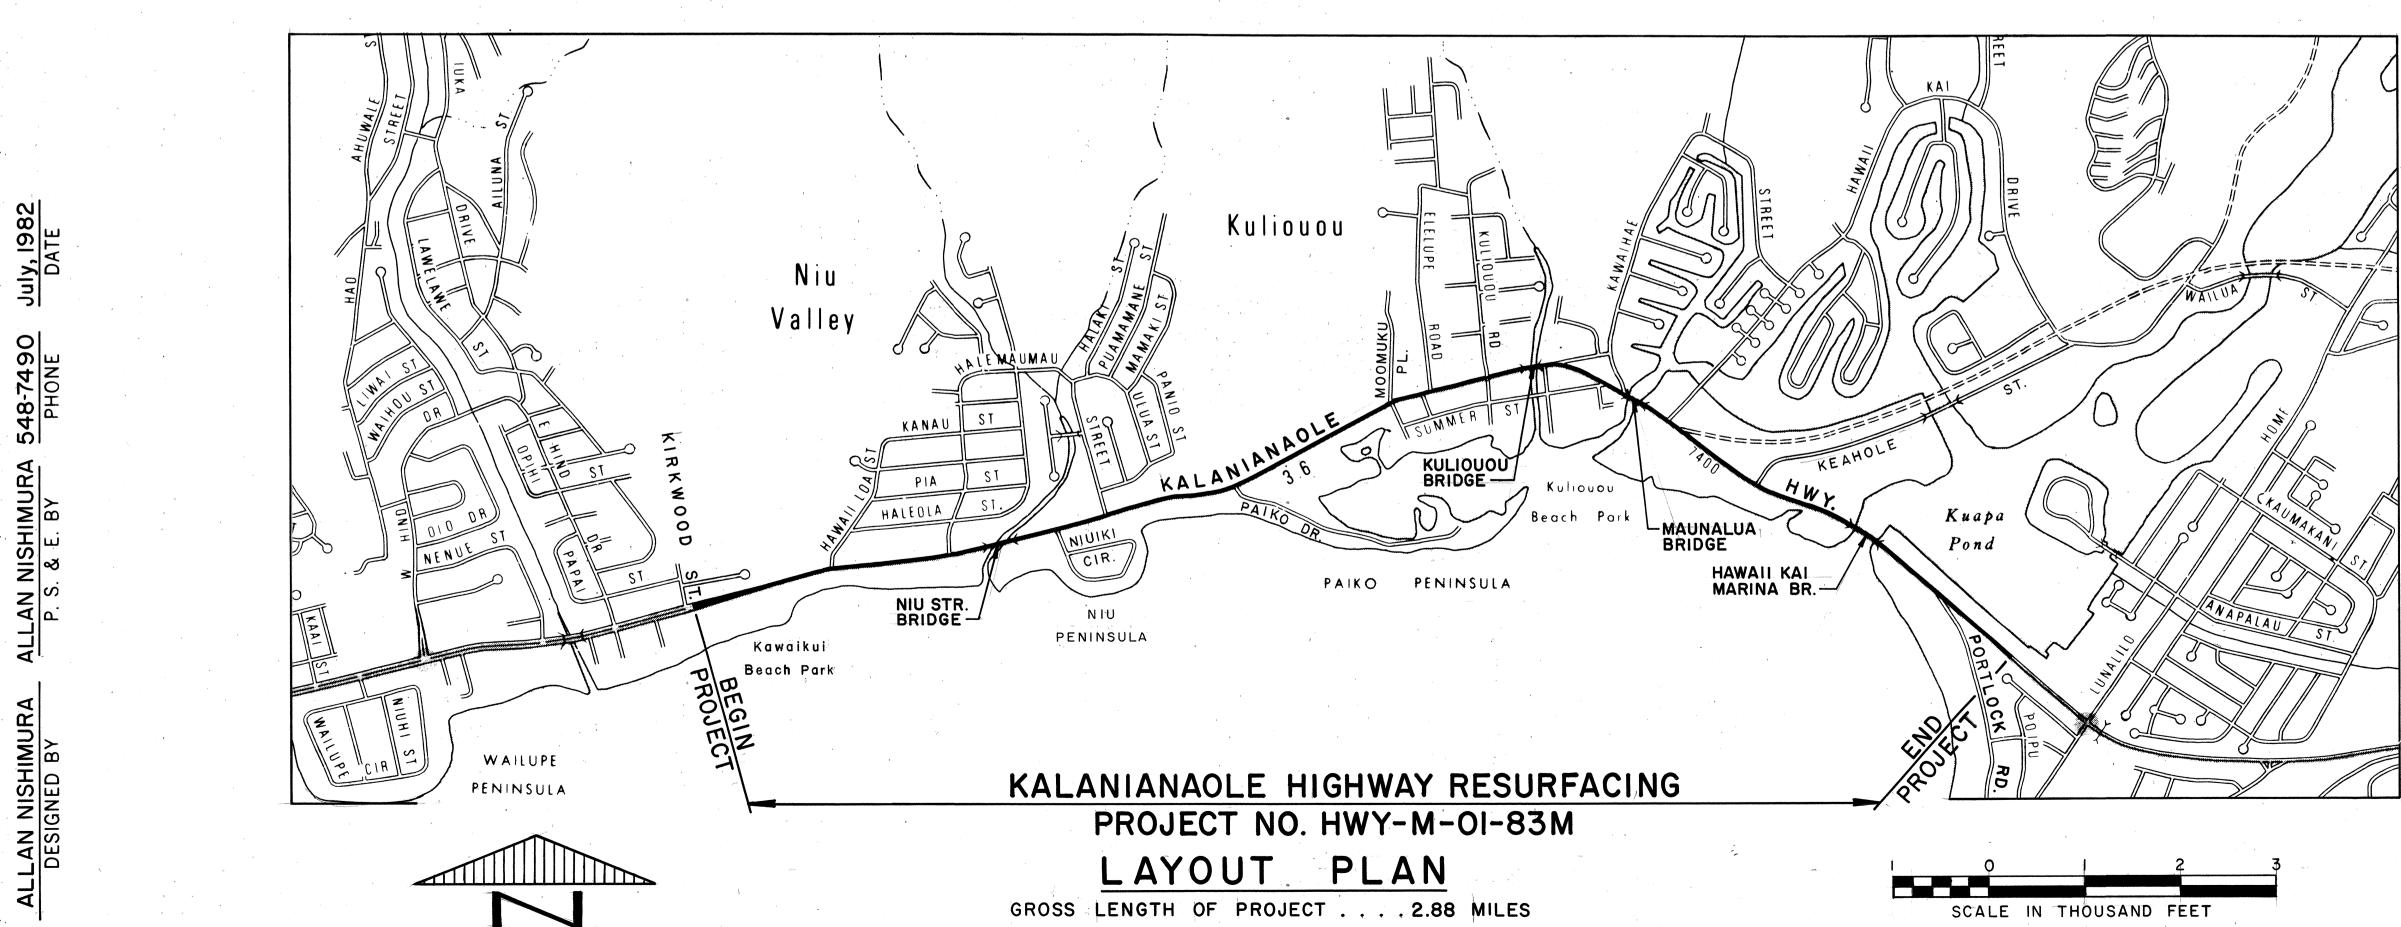

CHANGES MADE DURING CONSTRUCTION HAVE BEEN INCORPORATED ON THESE PLANS EXCEPT CHANGES IN THE ORIGINAL THEORETICAL QUANTITIES. FOR ACTUAL QUANTITIES, REFER TO PROJECT LEDGER AND/OR COMPUTATION BOOK.

RESIDENT ENGINEER

DEPARTMENT OF TRANSPORTATION STATE OF HAWAII

8-17-83

DATE

548-7490 PHONE ALLAN NISHIMURA P. S. & E. BY