

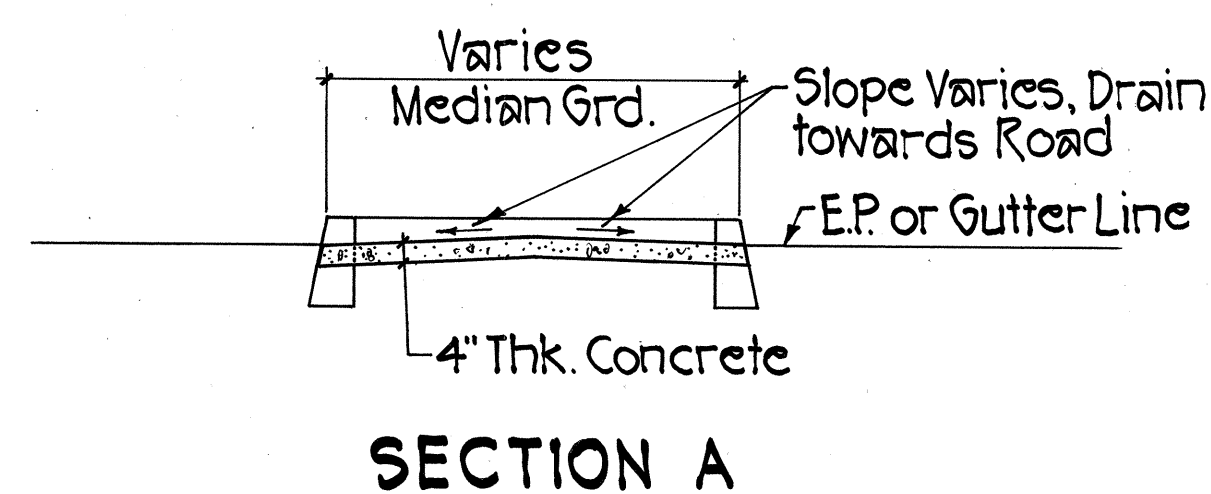
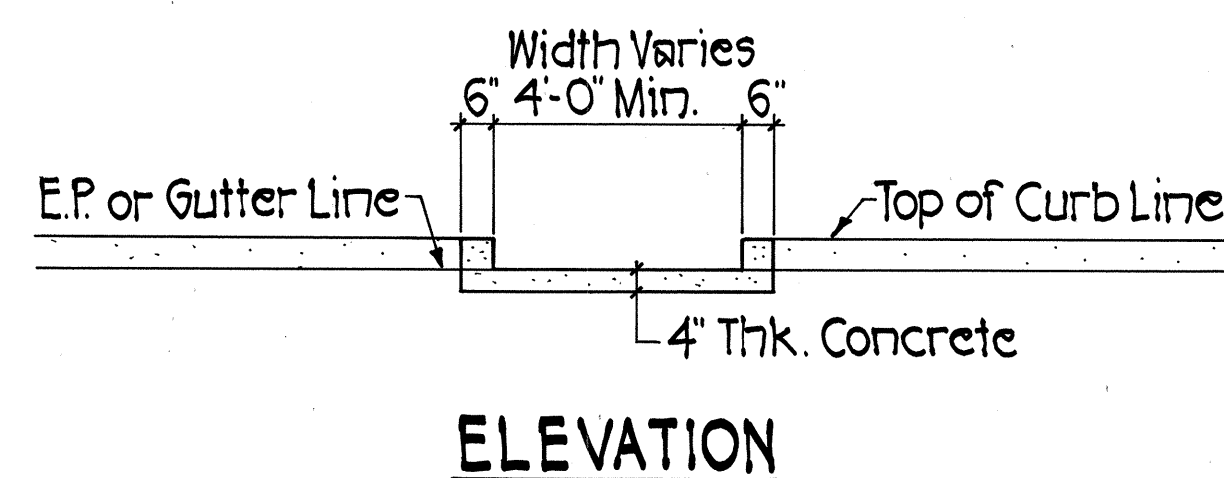
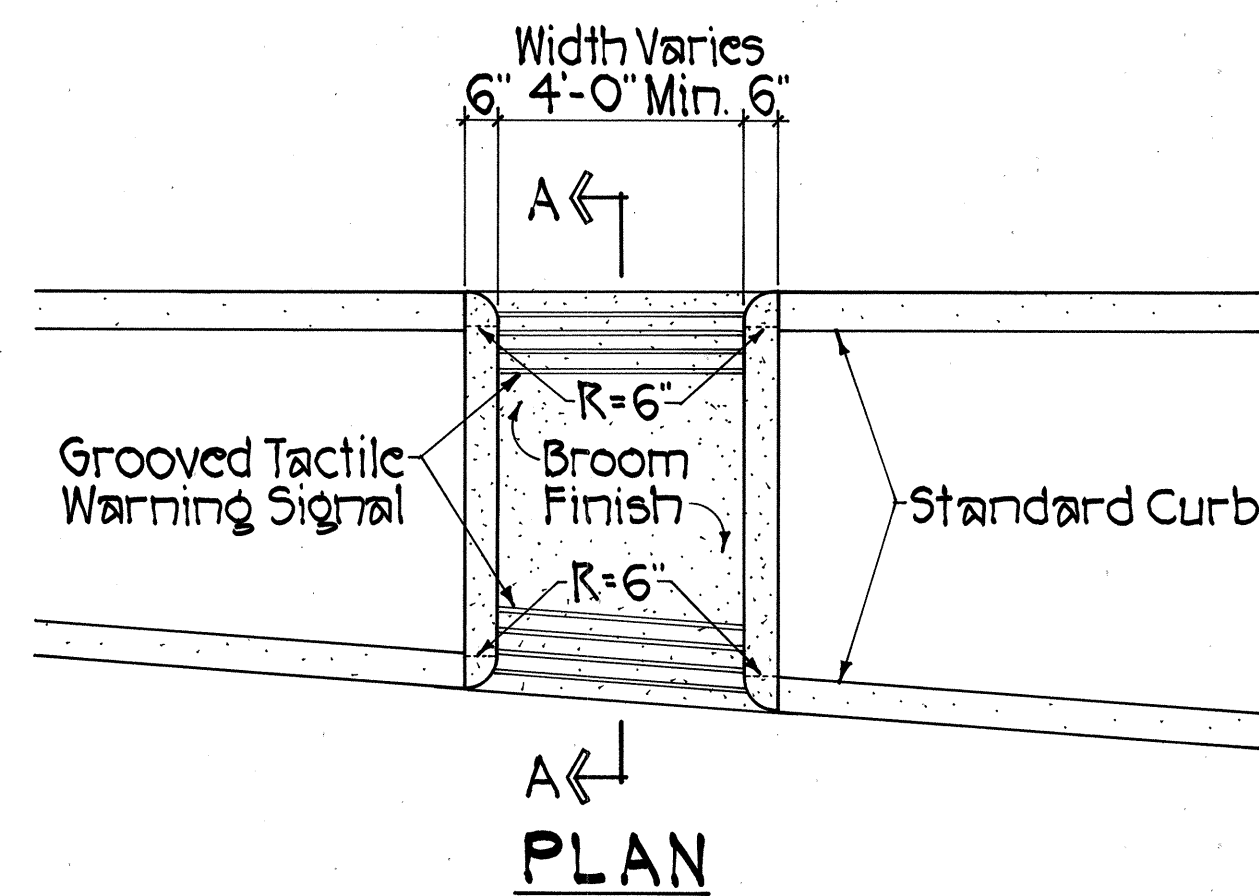



FED. ROAD DIST. NO.	STATE	PROJ. NO.	FISCAL YEAR	SHEET NO.	TOTAL SHEETS
HAWAII	HAW.	72C-01-84	1984	6	18

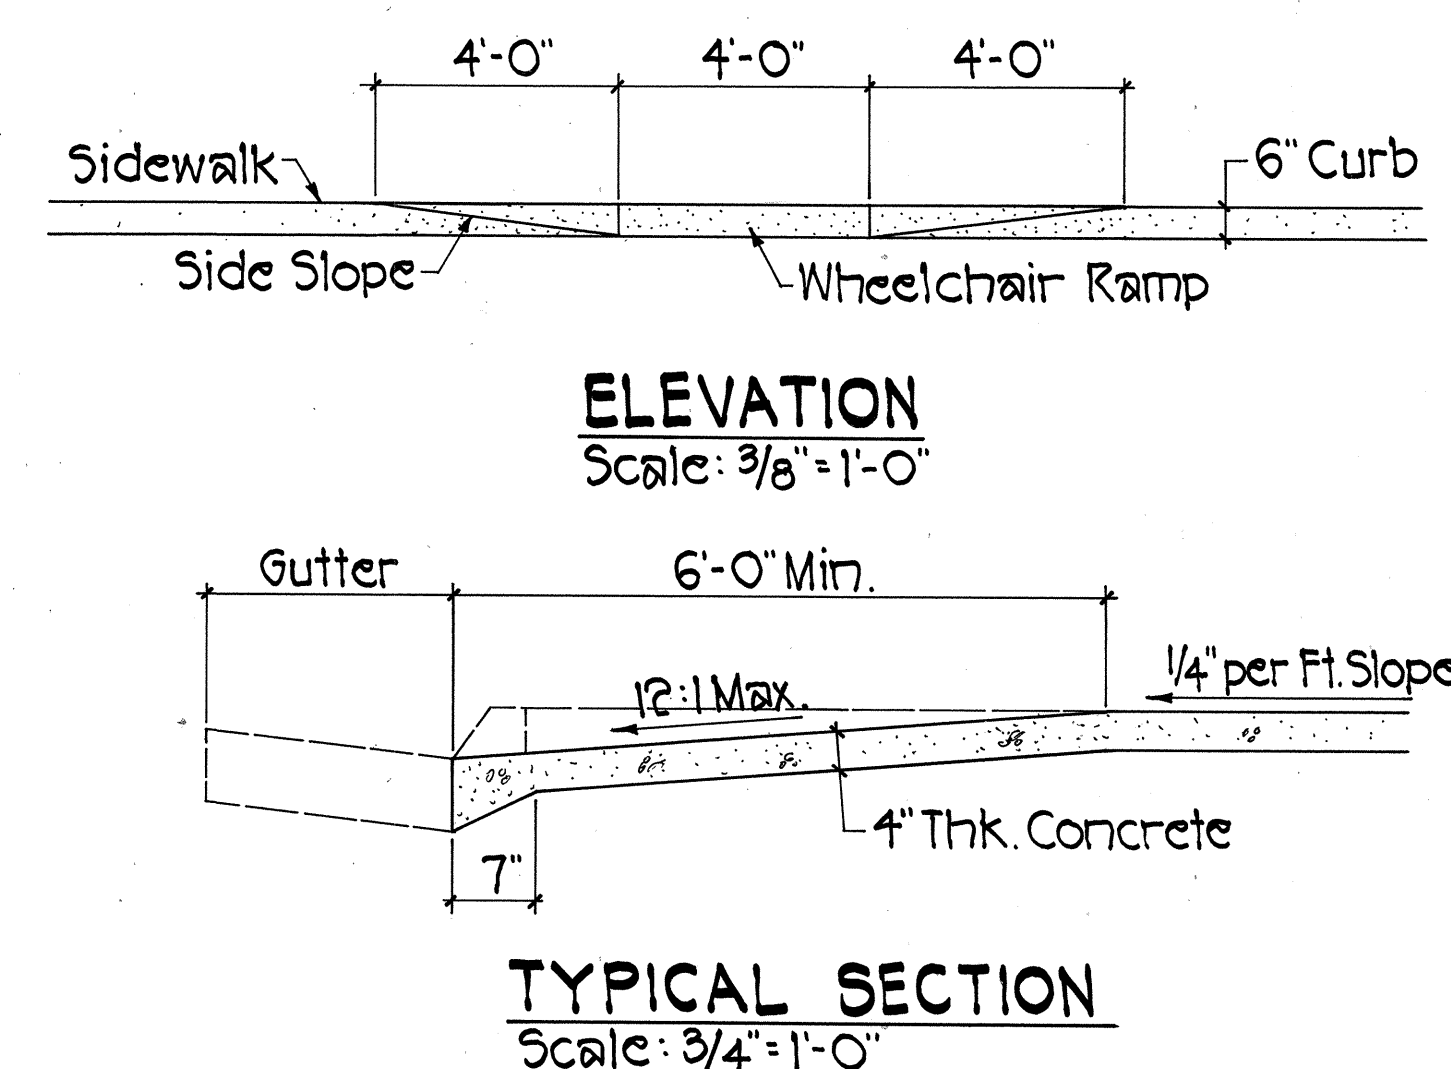





WHEELCHAIR RAMP~TYPE "C"
Not To Scale

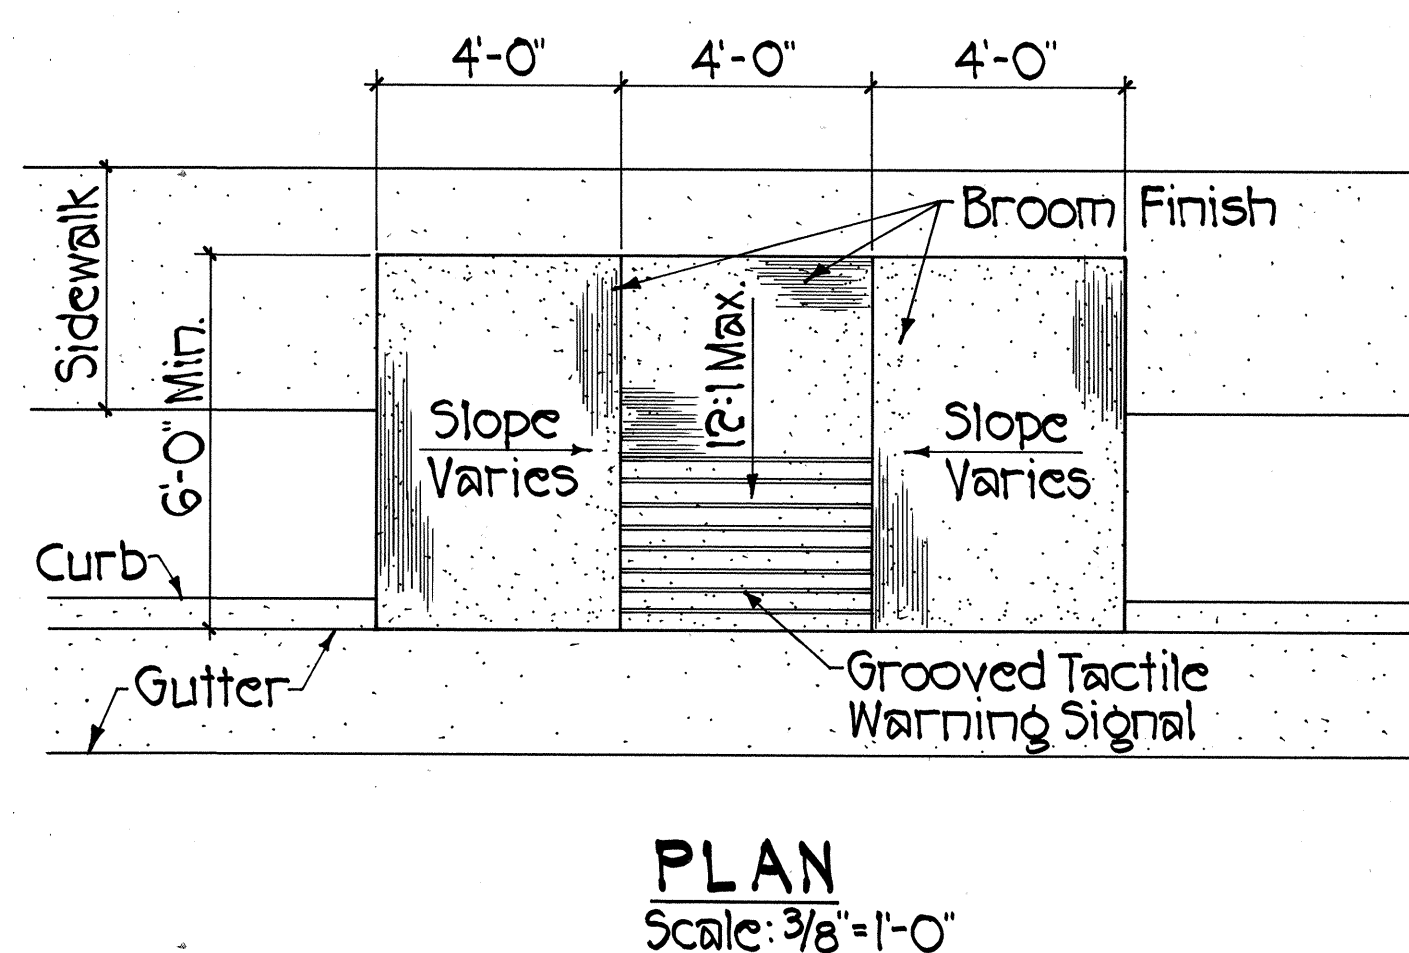

WHEELCHAIR RAMP~TYPE "D"
Scale: 3/4"=1'-0"

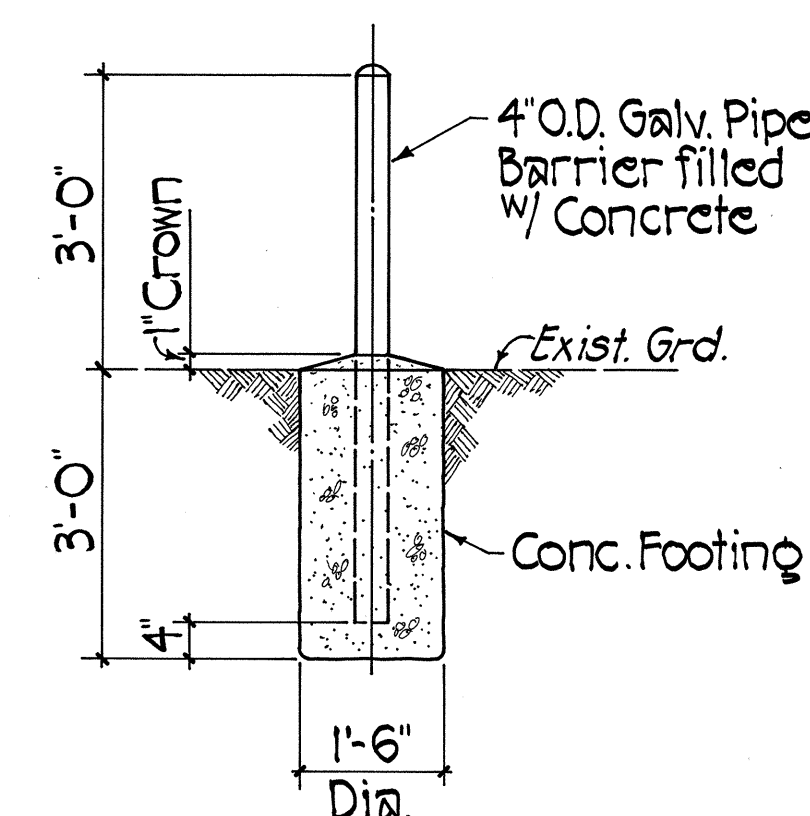

CONTROLLER BARRIER
Scale: 1/2"=1'-0"

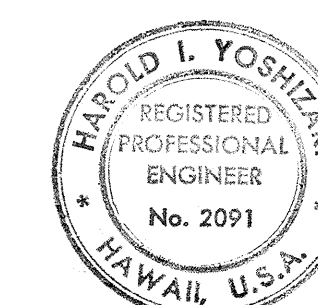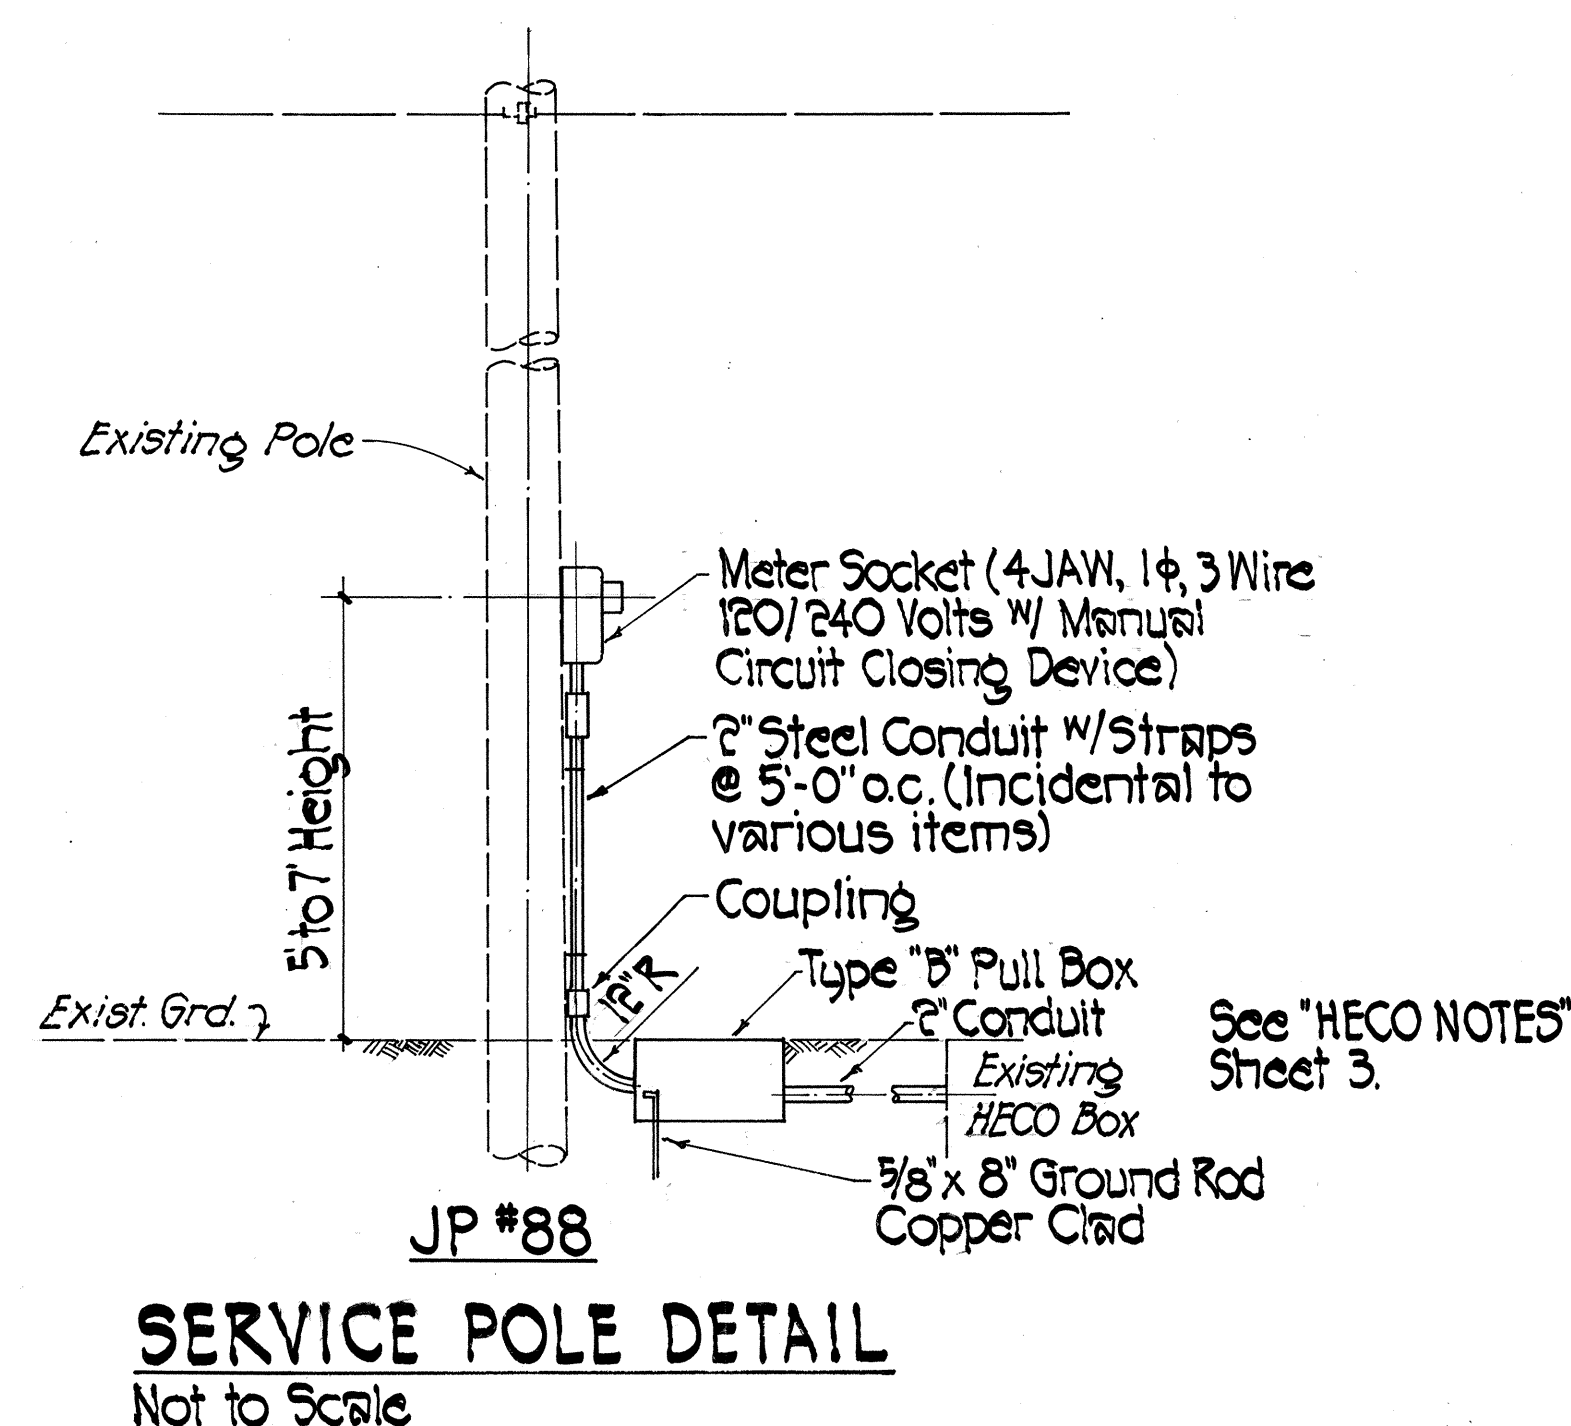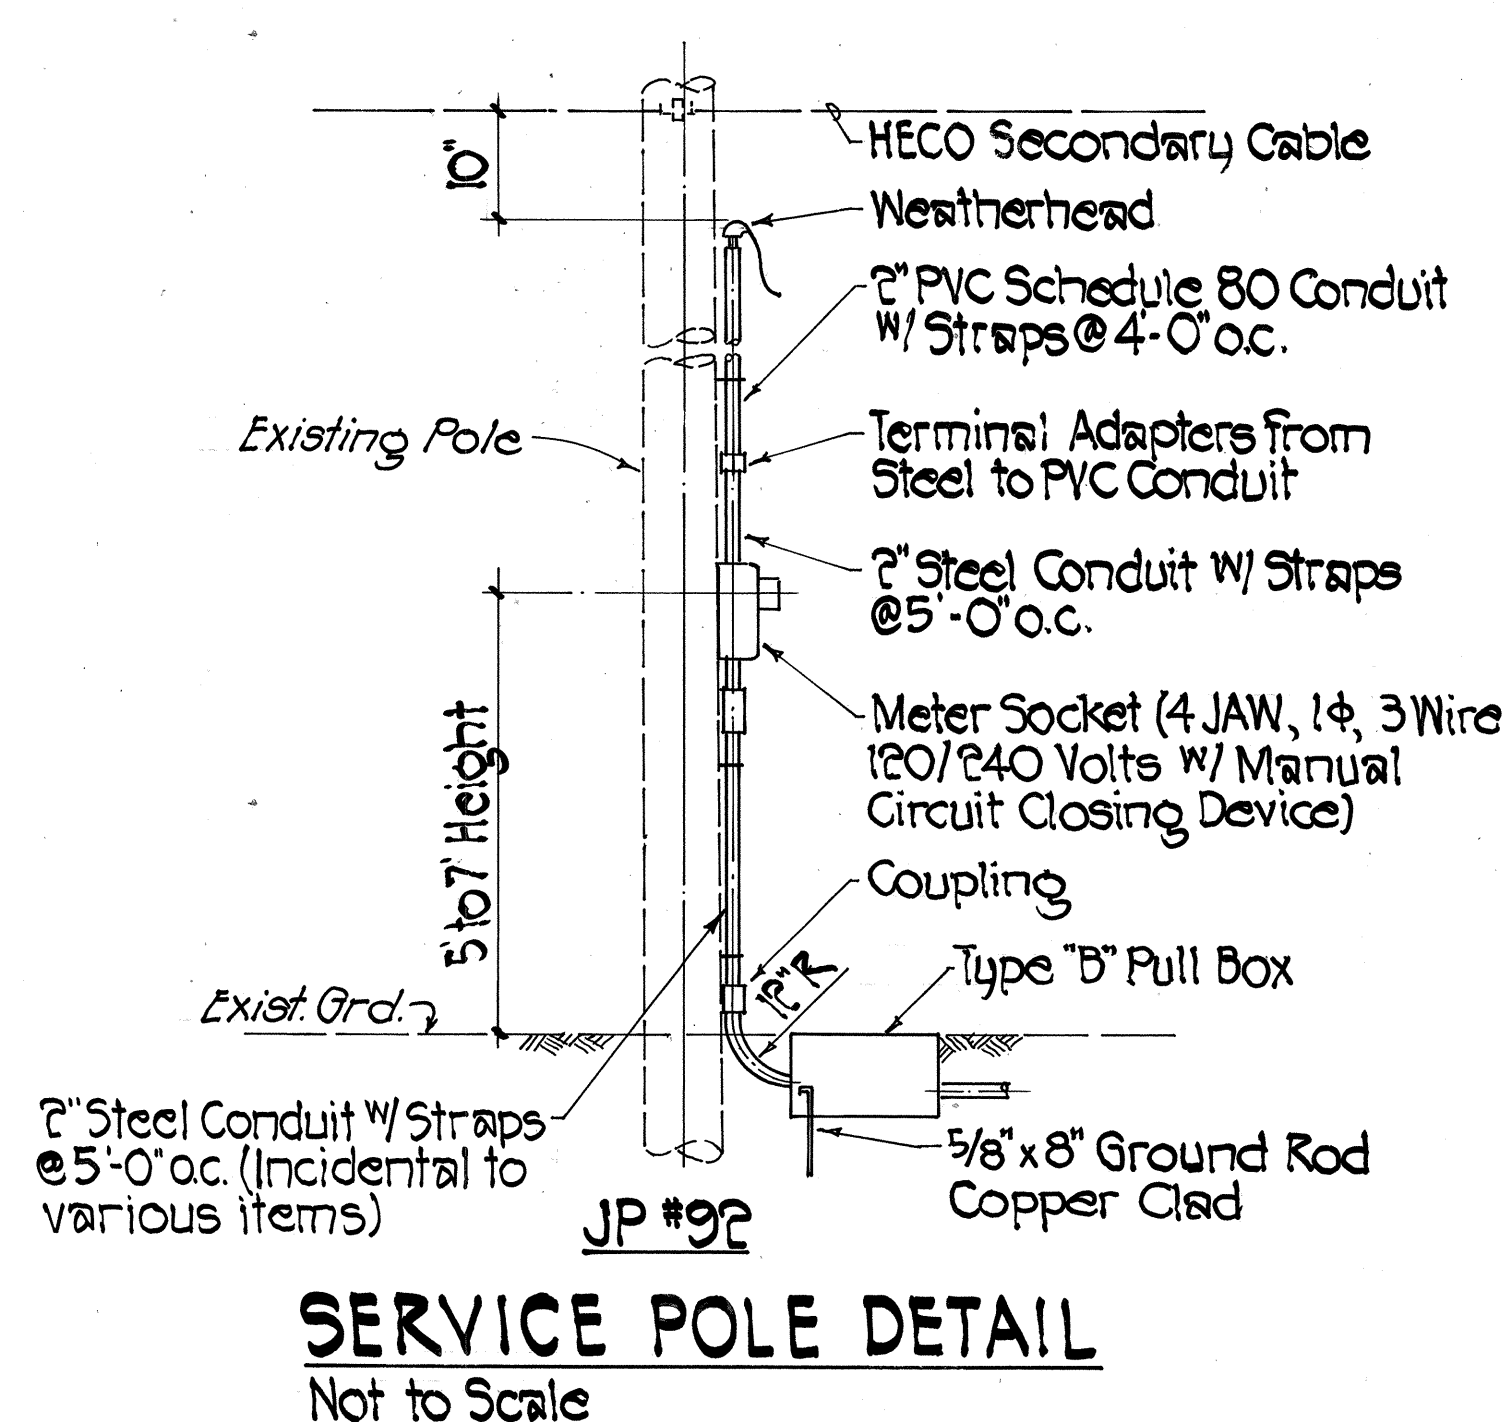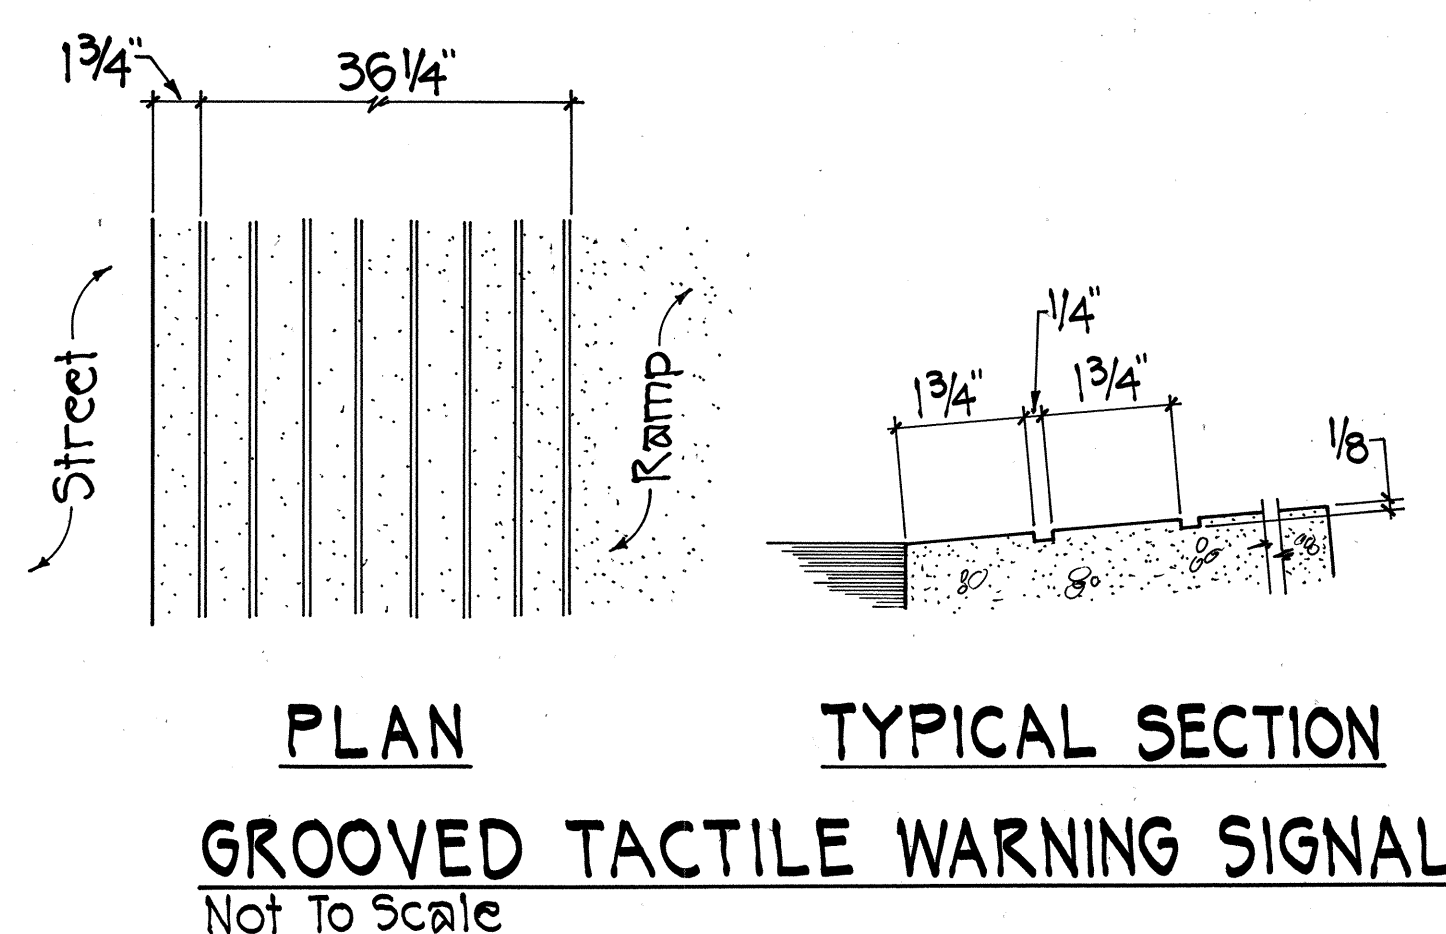

THIS WORK WAS PREPARED BY
ME OR UNDER MY SUPERVISION,
Harold I. Yoshizaki

STATE OF HAWAII DEPARTMENT OF TRANSPORTATION HIGHWAYS DIVISION					
MISCELLANEOUS DETAILS					
KALANIANA'OLE HIGHWAY TRAFFIC SIGNALS AT WAILUPE CIRCLE					
PROJECT NO. 72C-01-84					
SCALE: AS SHOWN DATE: DEC. 28, 1983					
SHEET NO. 1 OF 1 SHEETS					