
	INDEX TO DRAWINGS
SHEET NO.	DESCRIPTION
	TITLE SHEET
2	NOTES & LEGEND
3	TRAFFIC SIGNAL SYSTEM
4	TRAFFIC SIGNAL SYSTEM & DETAILS
5	SIGNS, PAVEMENT MARKINGS &
	WHEELCHAIR RAMPS
6	MISCELLANEOUS DETAILS
7-18	STANDARD DETAILS

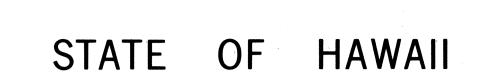



DEPARTMENT OF TRANSPORTATION HIGHWAYS DIVISION


HONOLULU, HAWAII


"AS-BUILT"

PLANS FOR

KALANIANAOLE HIGHWAY TRAFFIC SIGNALS AT WAILUPE CIRCLE PROJECT NO. 72C-01-84

DISTRICT OF HONOLULU ISLAND OF OAHU

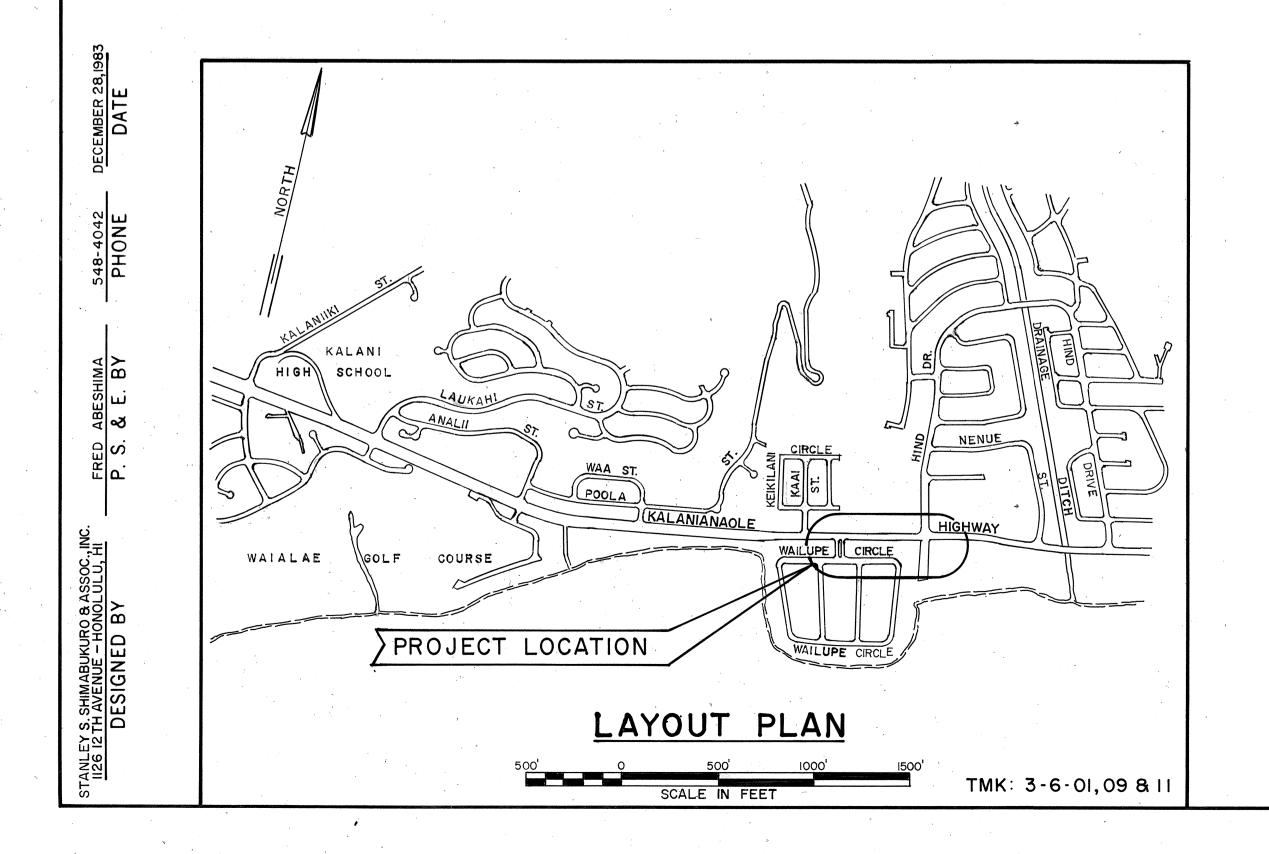

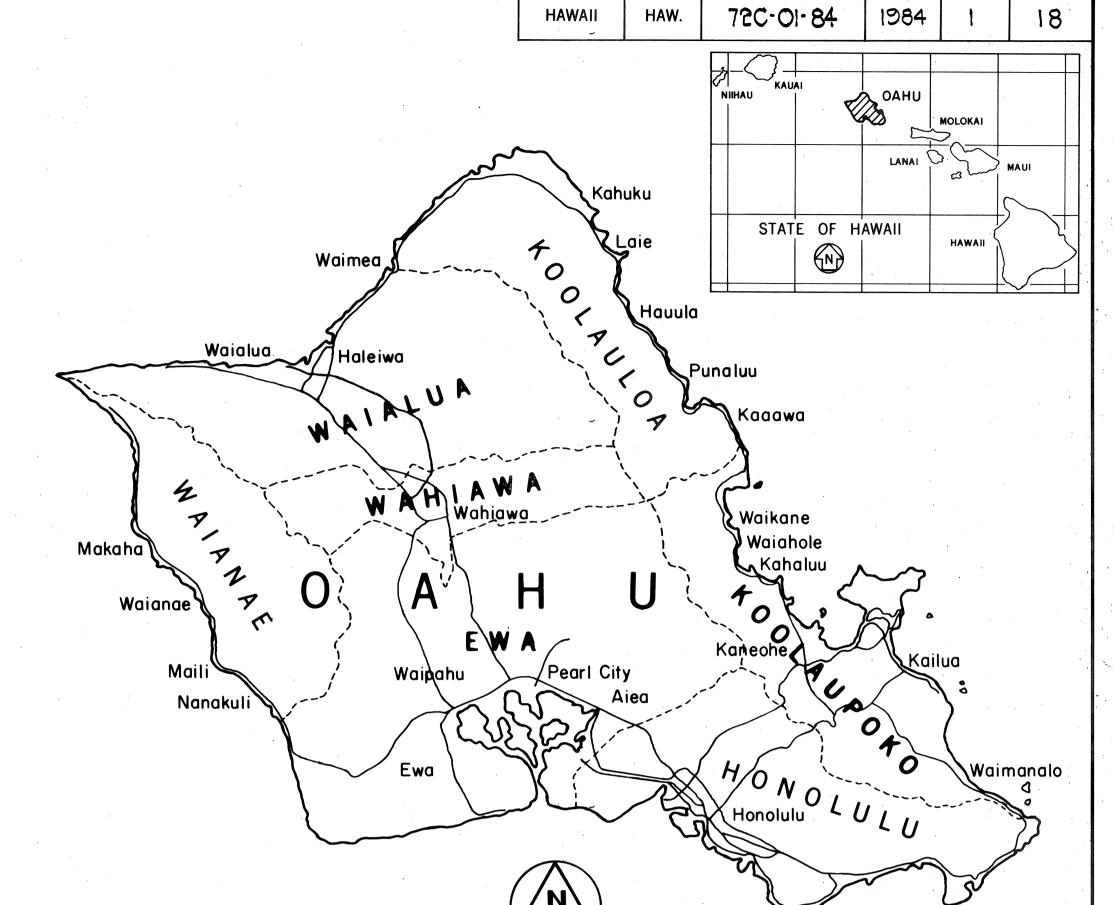

FED. ROAD DIST. NO.

STATE

PROJ. NO.

CHANGES MADE DURING CONSTRUCTION HAVE BEEN NOTED ON THESE PLANS AND CHECKED BY:

RESIDENT ENGINEER

11/14/85 DATE FISCAL SHEET TOTAL YEAR NO. SHEETS

DEPARTMENT OF TRANSPORTATION STATE OF HAWAII		
APPROVED:		
Hay Damasaki	1/5/84	
DIR. TRANSPORTATION	DATE	