
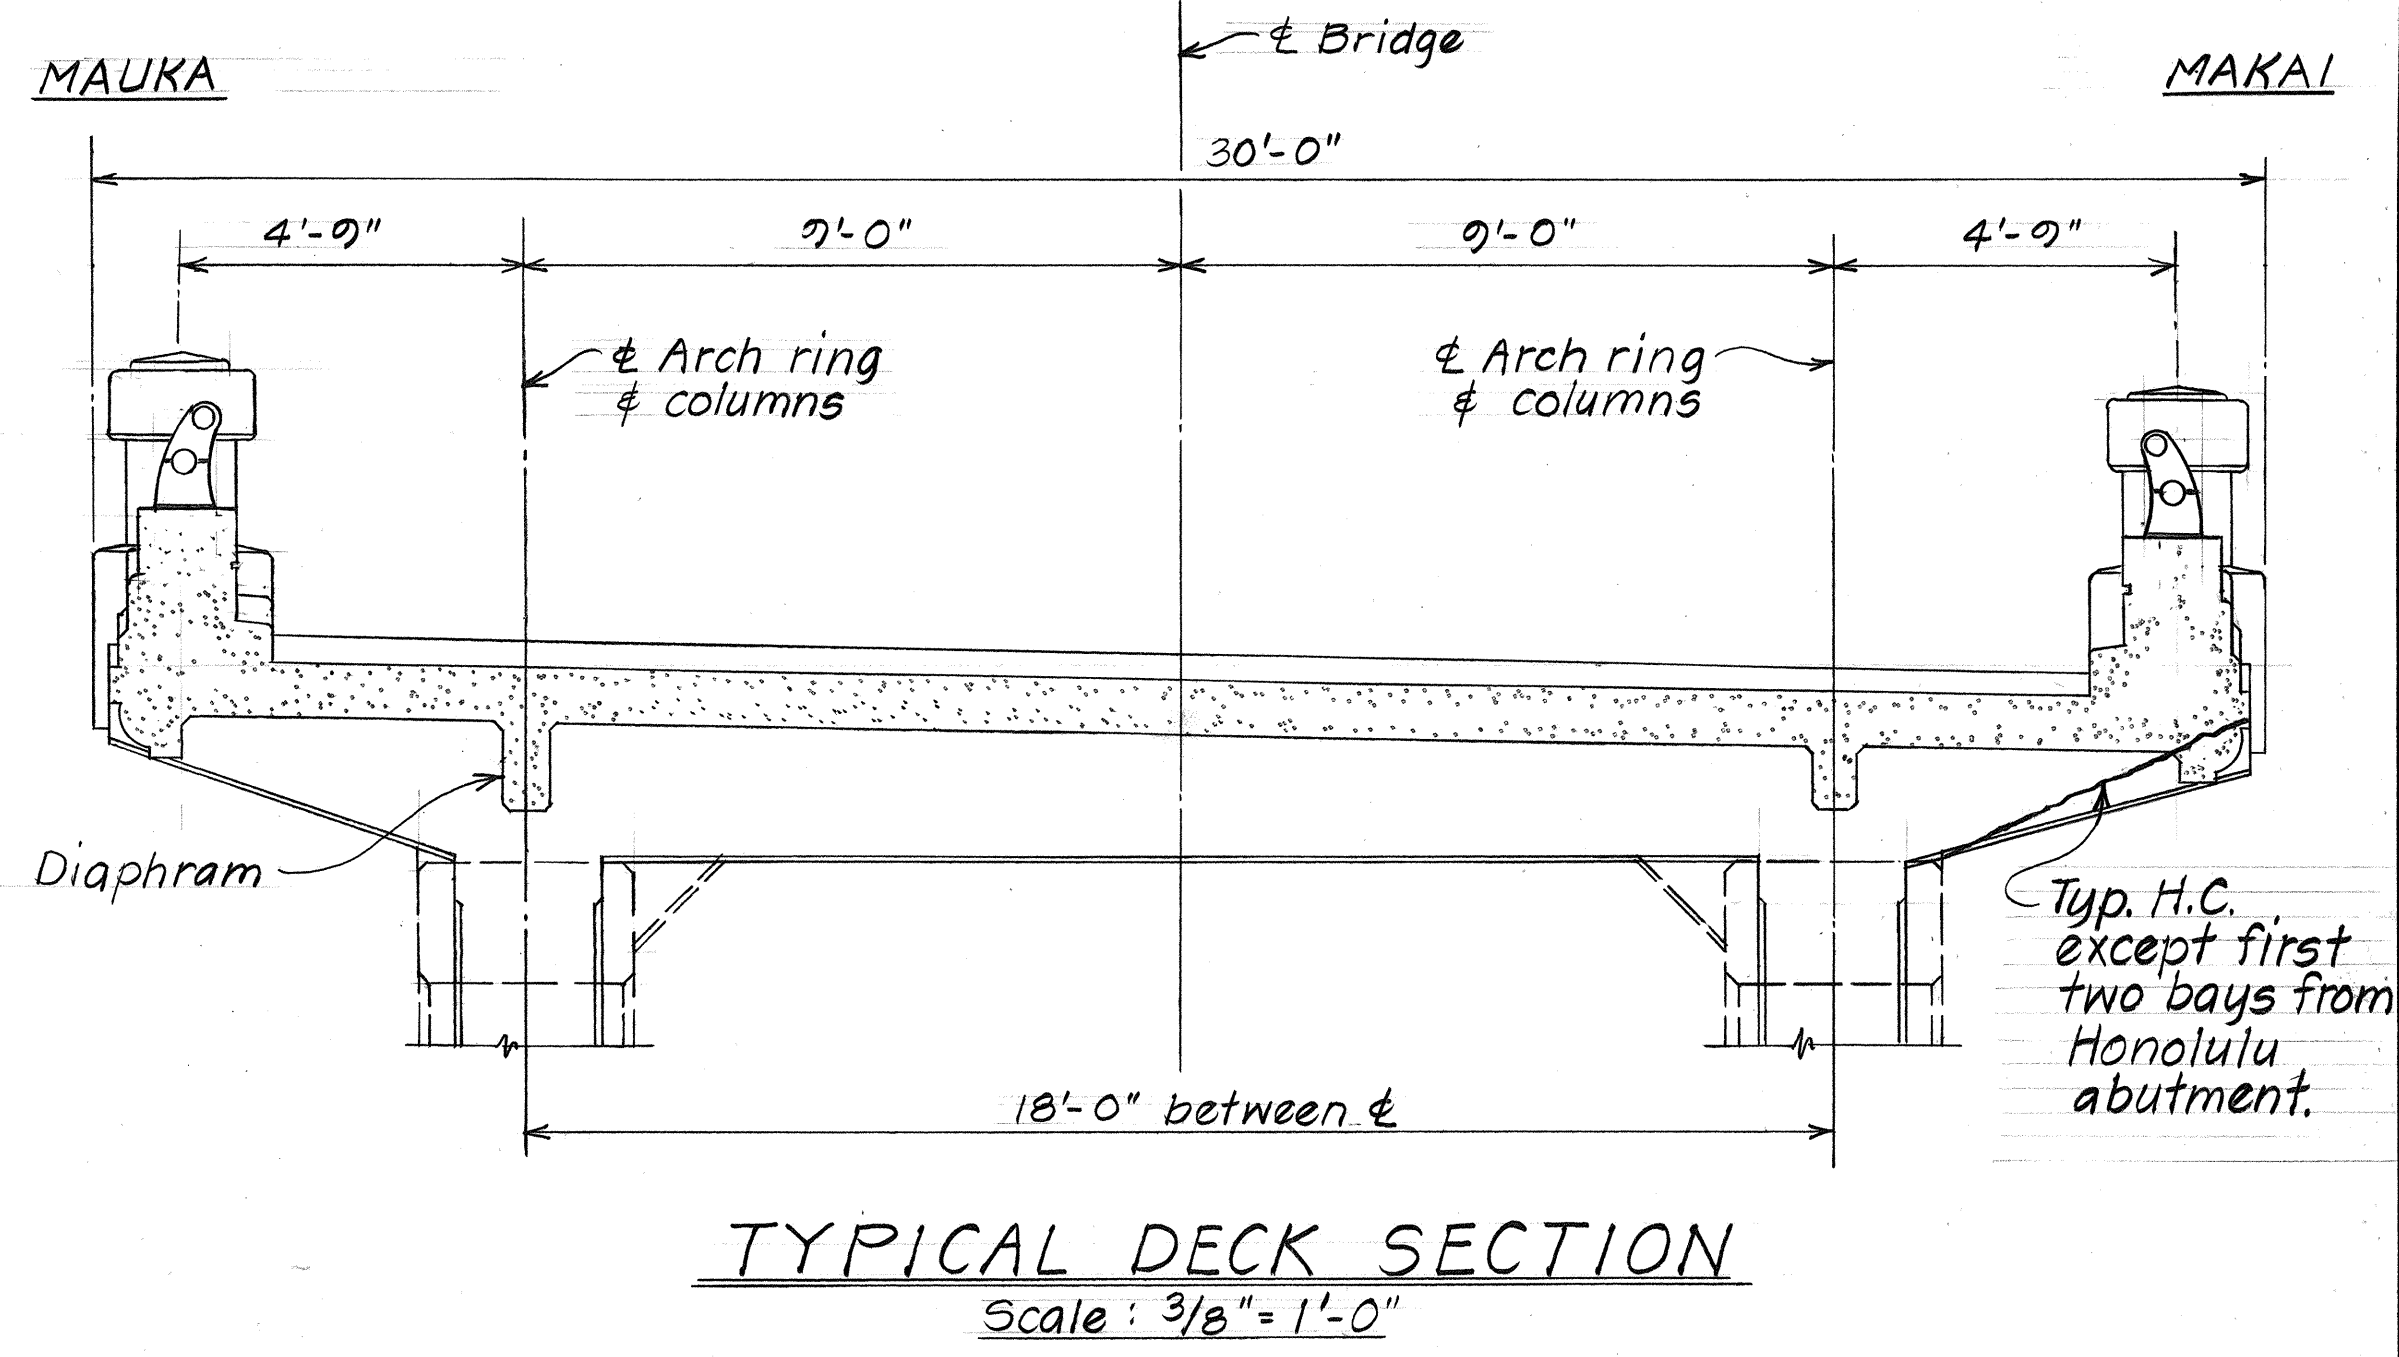


FED. ROAD DIST. NO.	STATE	FED. AID PROJ. NO.	FISCAL YEAR	SHEET NO.	TOTAL SHEETS
HAWAII	HAW.	HWY-0-01-84M	1984	3	9

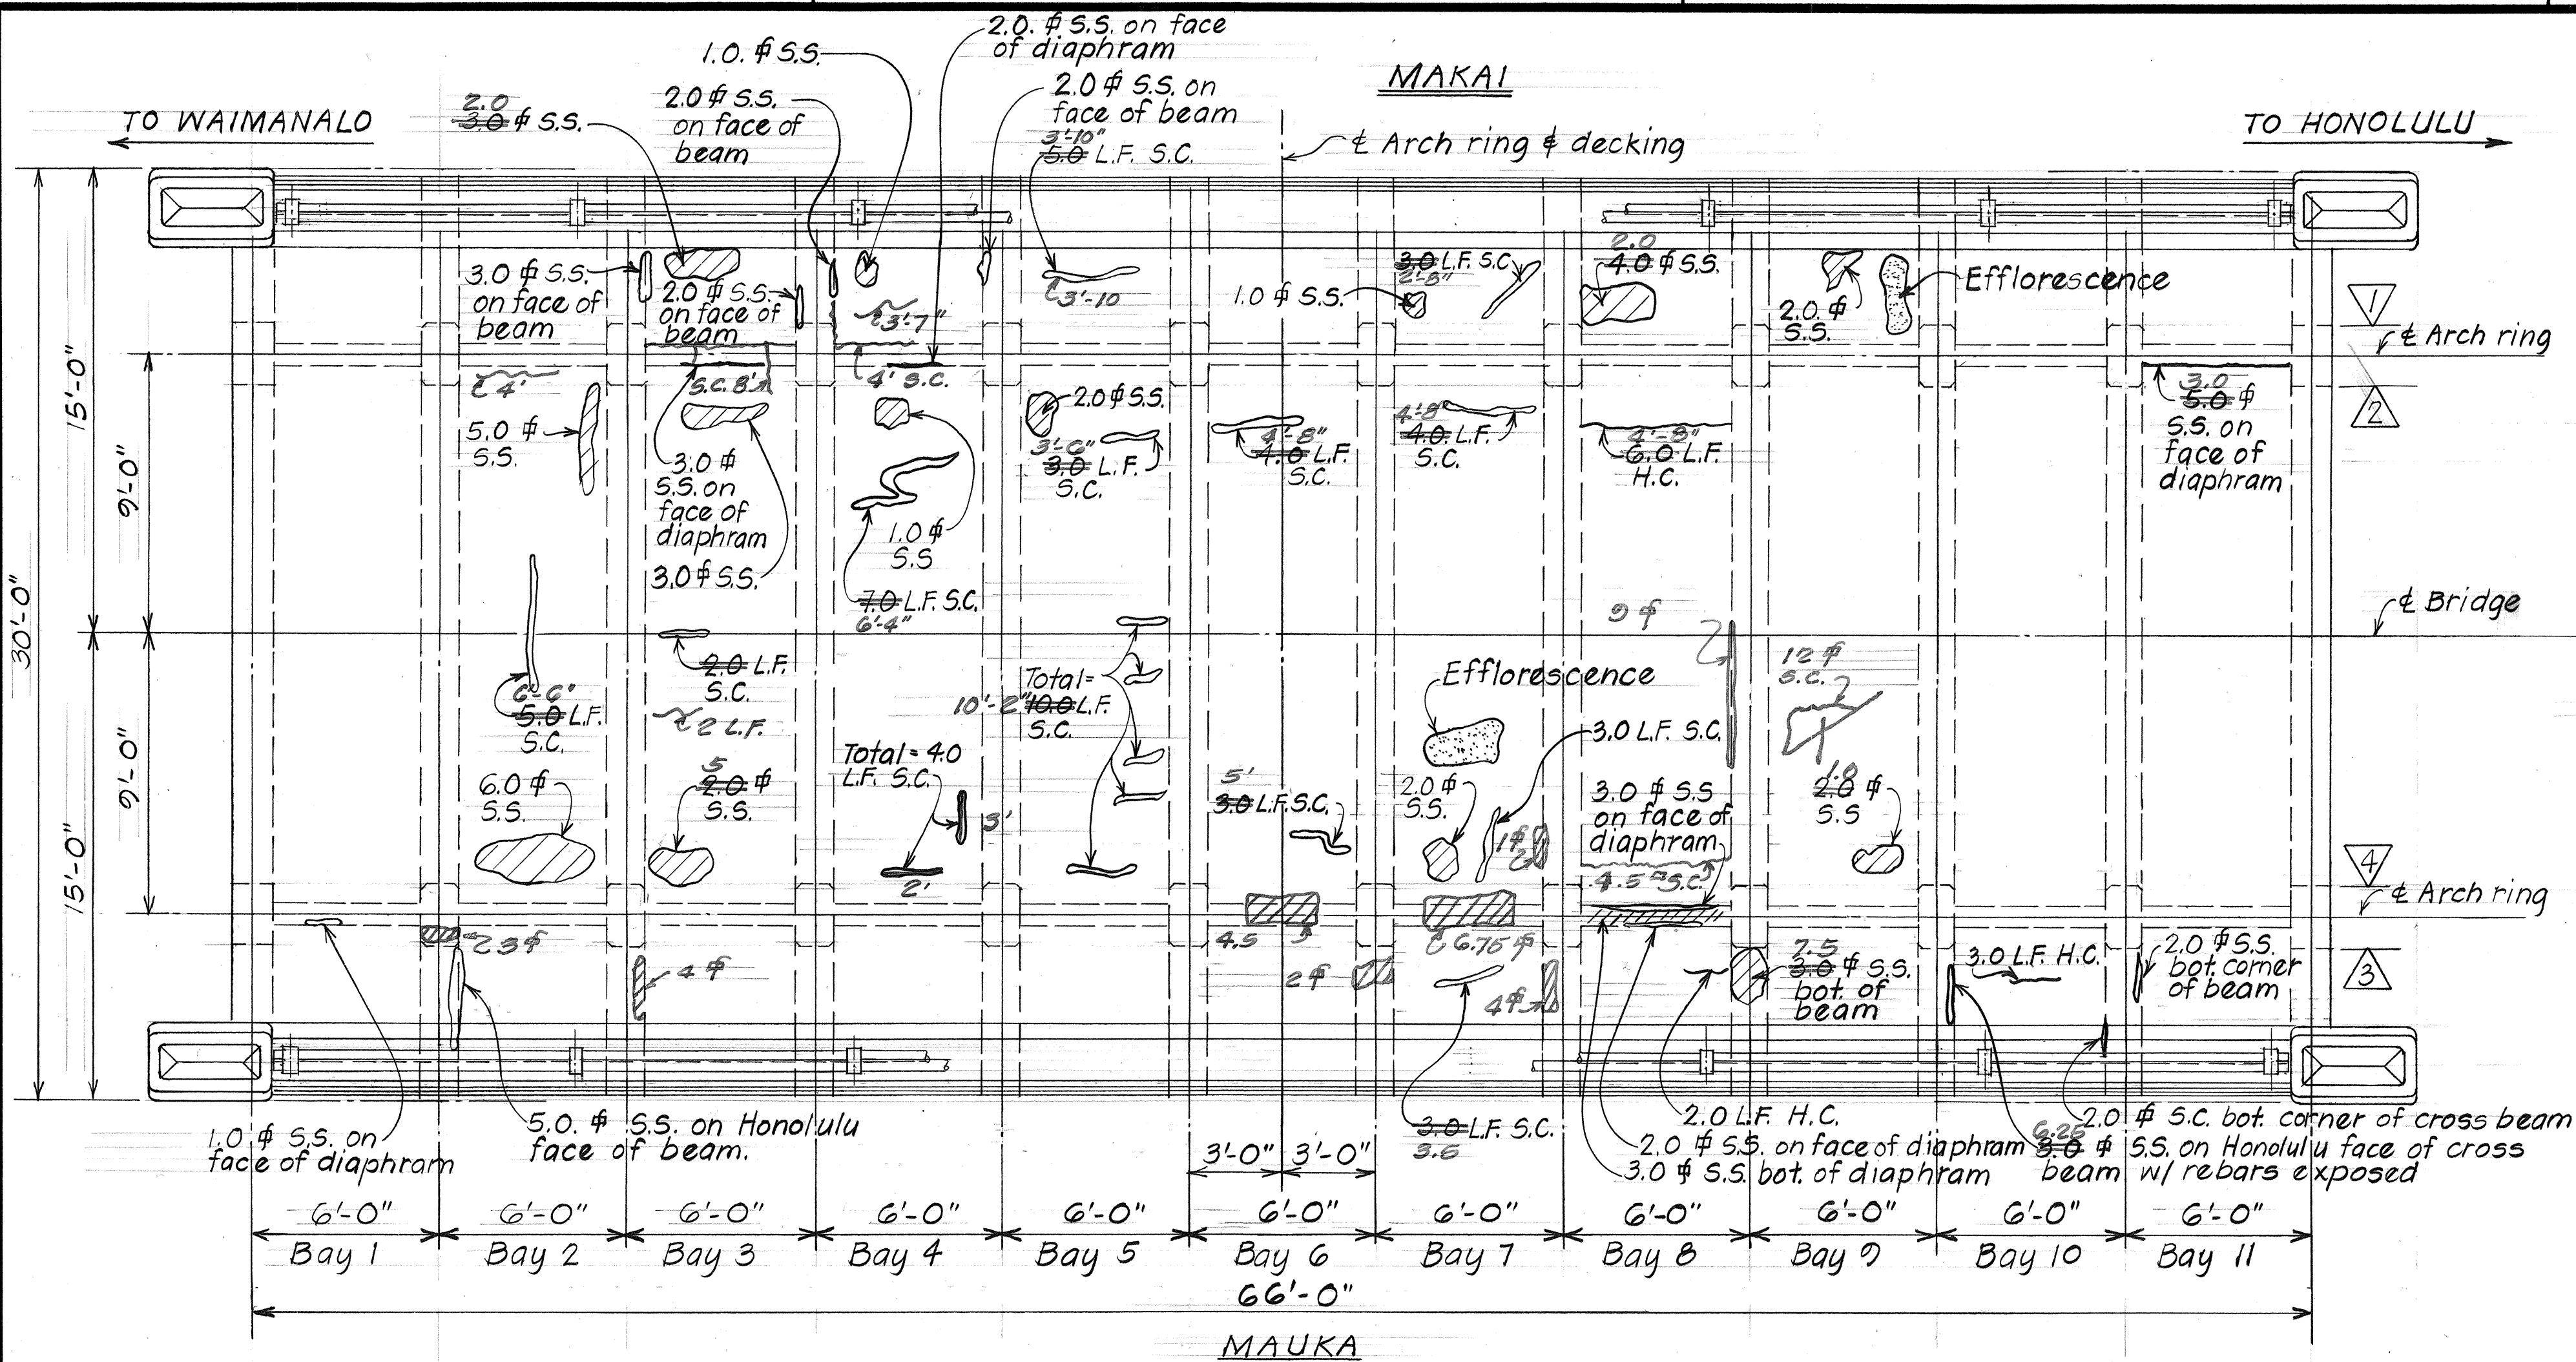

ESTIMATED QUANTITIES

ITEM NO.	ITEM	UNIT	* QUANTITY
676.06	Repairs of Spalls and Honeycombed Concrete to Ihihilauakea Bridge	S.F.	480 S.F.
676.07	Repairs of Spalls and Honeycombed Concrete to Kawaiakaiea Bridge	S.F.	140 S.F.
676.08	Repairs of Spalls and Honeycombed Concrete to Slip Cover No.1	S.F.	460 S.F.
677.06	Sealing Cracks in Ihihilauakea Bridge	L.F.	210 L.F.
677.07	Sealing Cracks in Kawaiakaiea Bridge	L.F.	210 L.F.
677.08	Sealing Cracks in Slip Cover No.1	L.F.	80 L.F.

* Includes estimated overrun

STATE OF HAWAII

DEPARTMENT OF TRANSPORTATION

LAND TRANSPORTATION FACILITIES DIVISION

IHIHILAUAKEA BRIDGE

REPAIR OF BRIDGES ON KALANIANA'OLE & NIMITZ HWYS

Proj. No. HWY-0-01-84M


Scale: As Shown Date: Feb. 1984

SHEET NO. 1 OF 3 SHEETS


3

ORIGINAL PLAN	DATE
DESIGNED BY	DATE
QUANTITIES BY	DATE
CHECKED BY	DATE

FED. ROAD DIST. NO.	STATE	FED. AID PROJ. NO.	FISCAL YEAR	SHEET NO.	TOTAL SHEETS
HAWAII	HAW.	HWY-0-01-84M	1984	4	9

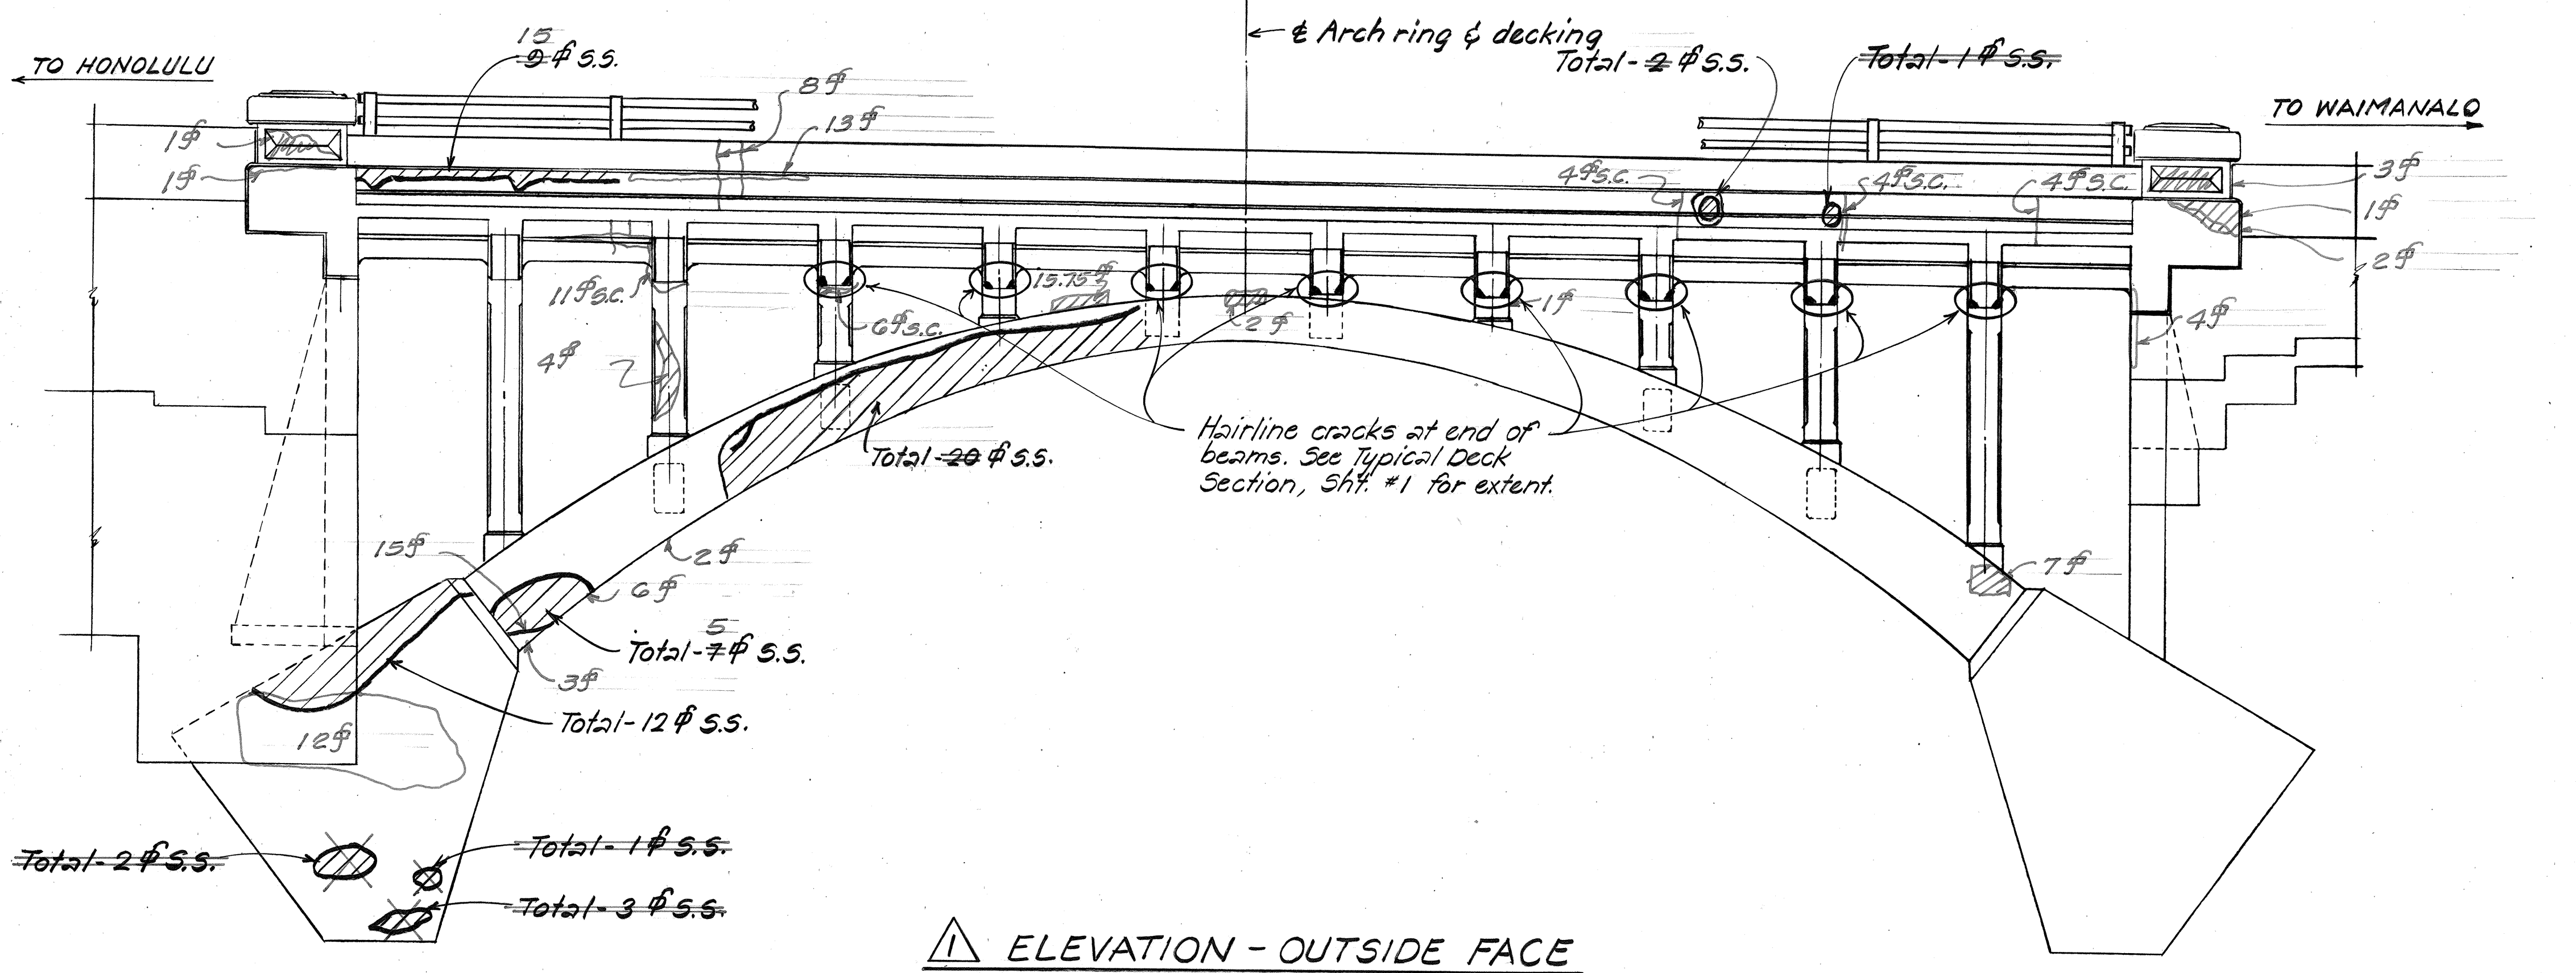

1 ELEVATION - OUTSIDE FACE

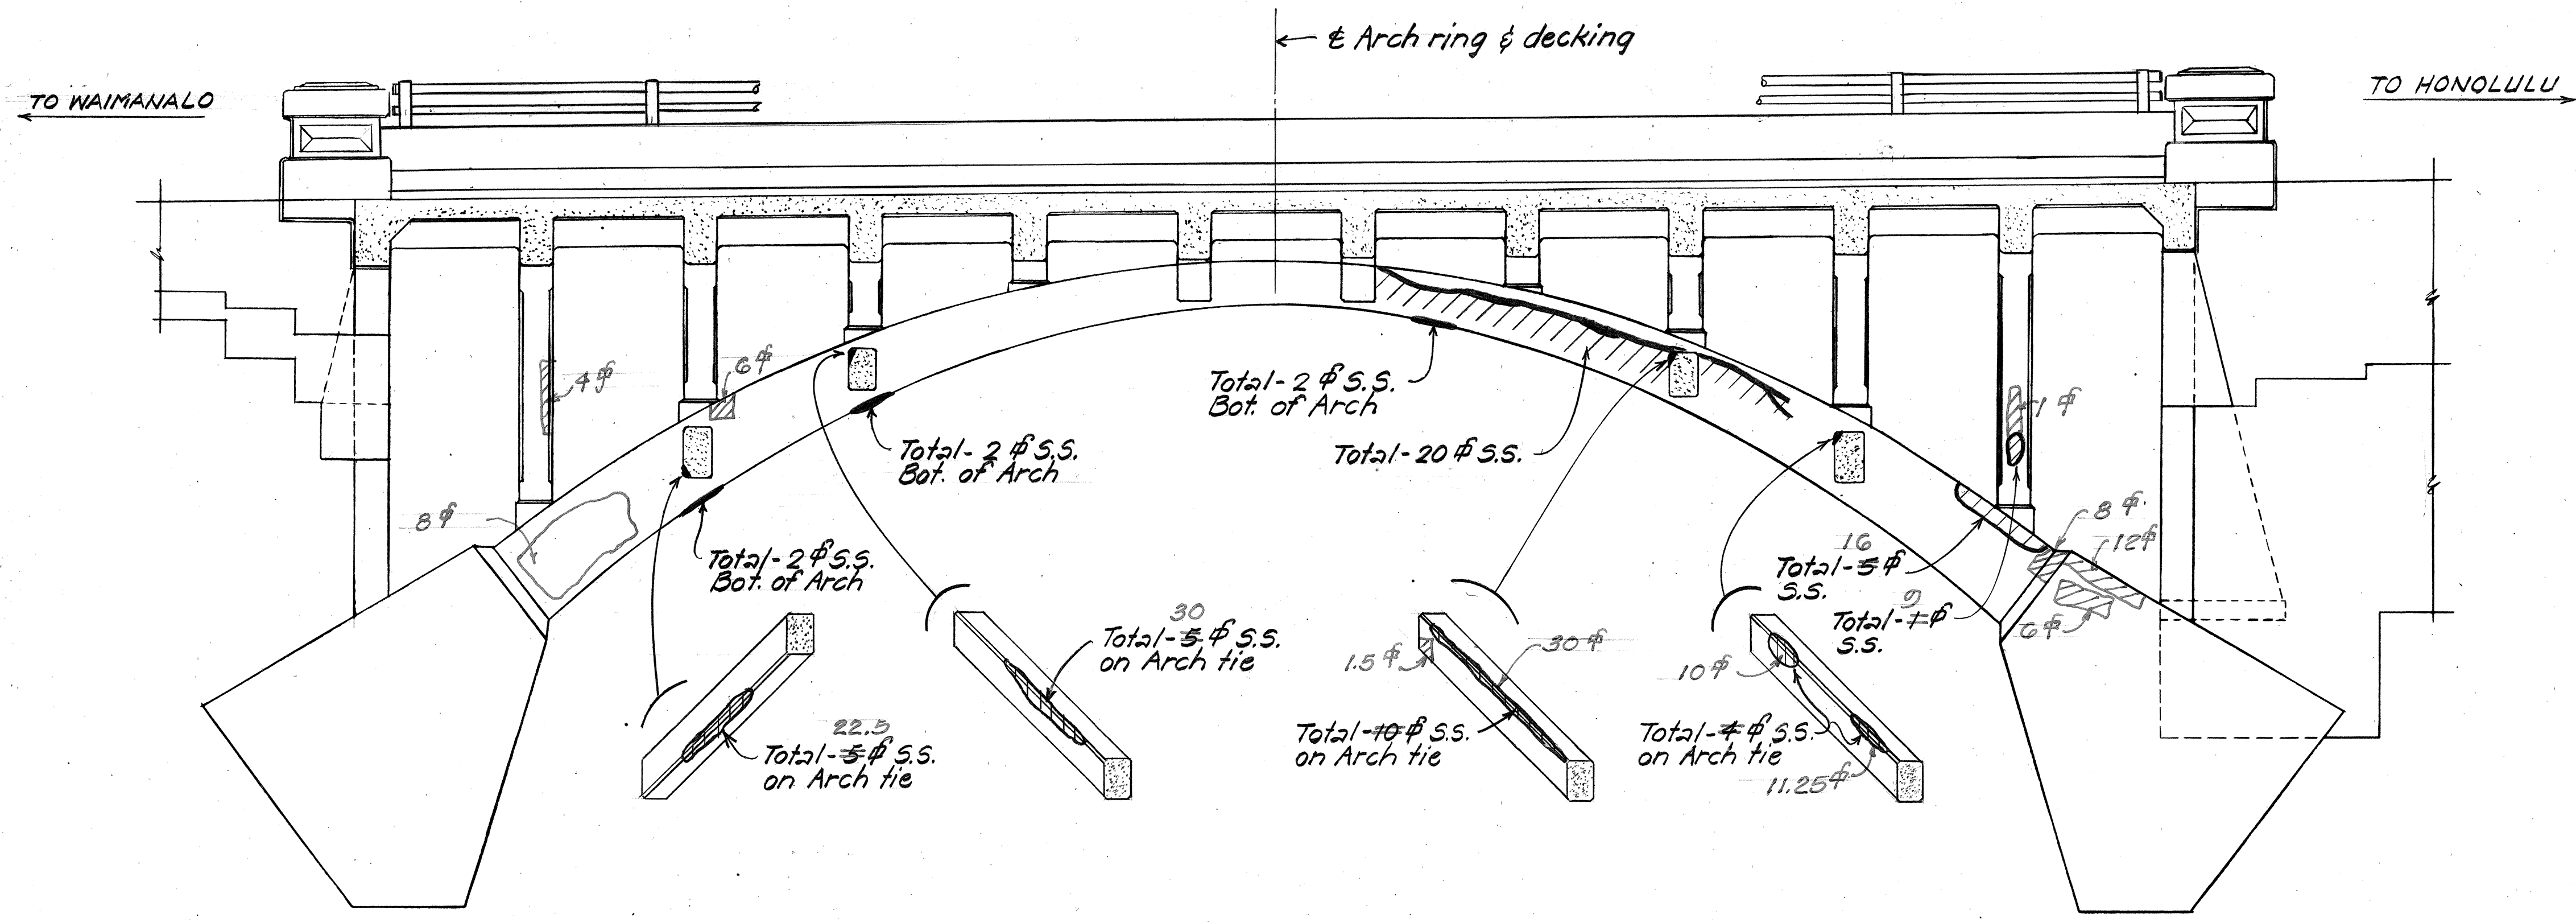

2 ELEVATION - INSIDE FACE

MAKAI ARCH (IHIHILAUAKEA BRIDGE)
Scale: 1/4" = 1'-0"

ORIGINAL PLAN	SURVEY PLOTTED BY	DATE
PLAN	DRAWN BY	7/6/84
NOTE BOOK	DESIGNED BY	7/6/84
NO.	QUANTITIES BY	7/6/84
	CHECKED BY	7/6/84

STATE OF HAWAII
DEPARTMENT OF TRANSPORTATION
LAND TRANSPORTATION FACILITIES DIVISION
IHIHILAUAKEA BRIDGE
REPAIR OF BRIDGES ON
KALANIANA'OLE & NIMITZ HWYS
Proj. No. HWY-0-01-84M
Scale: As Shown Date: Feb. 1984
SHEET No. 2 OF 3 SHEETS

ORIGINAL PLAN	SURVEY PLOTTED BY _____	DATE _____
NOTE BOOK	DRAWN BY <i>T.K.M.</i>	" "
	TRACED BY <i>T.K.M.</i>	" "
	DESIGNED BY <i>A.L.</i>	" "
	QUANTITIES BY <i>S.T.</i>	" "
No. _____	CHECKED BY <i>K.B.V.</i>	" "