


ORIGINAL PLAN	SURVEY PLOTTED BY	DATE
	DRAWN BY <i>T.K.M.</i>	"
	TRACED BY <i>T.K.M.</i>	"
	DESIGNED BY <i>A.L.</i>	"
NOTE BOOK	QUANTITIES BY <i>G.T.</i>	"
	CHECKED BY <i>K.B.V.</i>	"
No. _____		




- STATE OF HAWAII
DEPARTMENT OF TRANSPORTATION
LAND TRANSPORTATION FACILITIES DIVISION
- KAWAIAKAIEA BRIDGE
- REPAIR OF BRIDGES ON
KALANIANA'OLE & NIMITZ HWYS
Proj. No. HWY-0-01-84M
- Scale: As Shown Date: Feb. 1984
- SHEET NO. 1 OF 3 SHEETS


FED. ROAD DIST. NO.	STATE	FED. AID PROJ. NO.	FISCAL YEAR	SHEET NO.	TOTAL SHEETS
HAWAII	HAW.	HWY-0-01-84M	1984	7	9

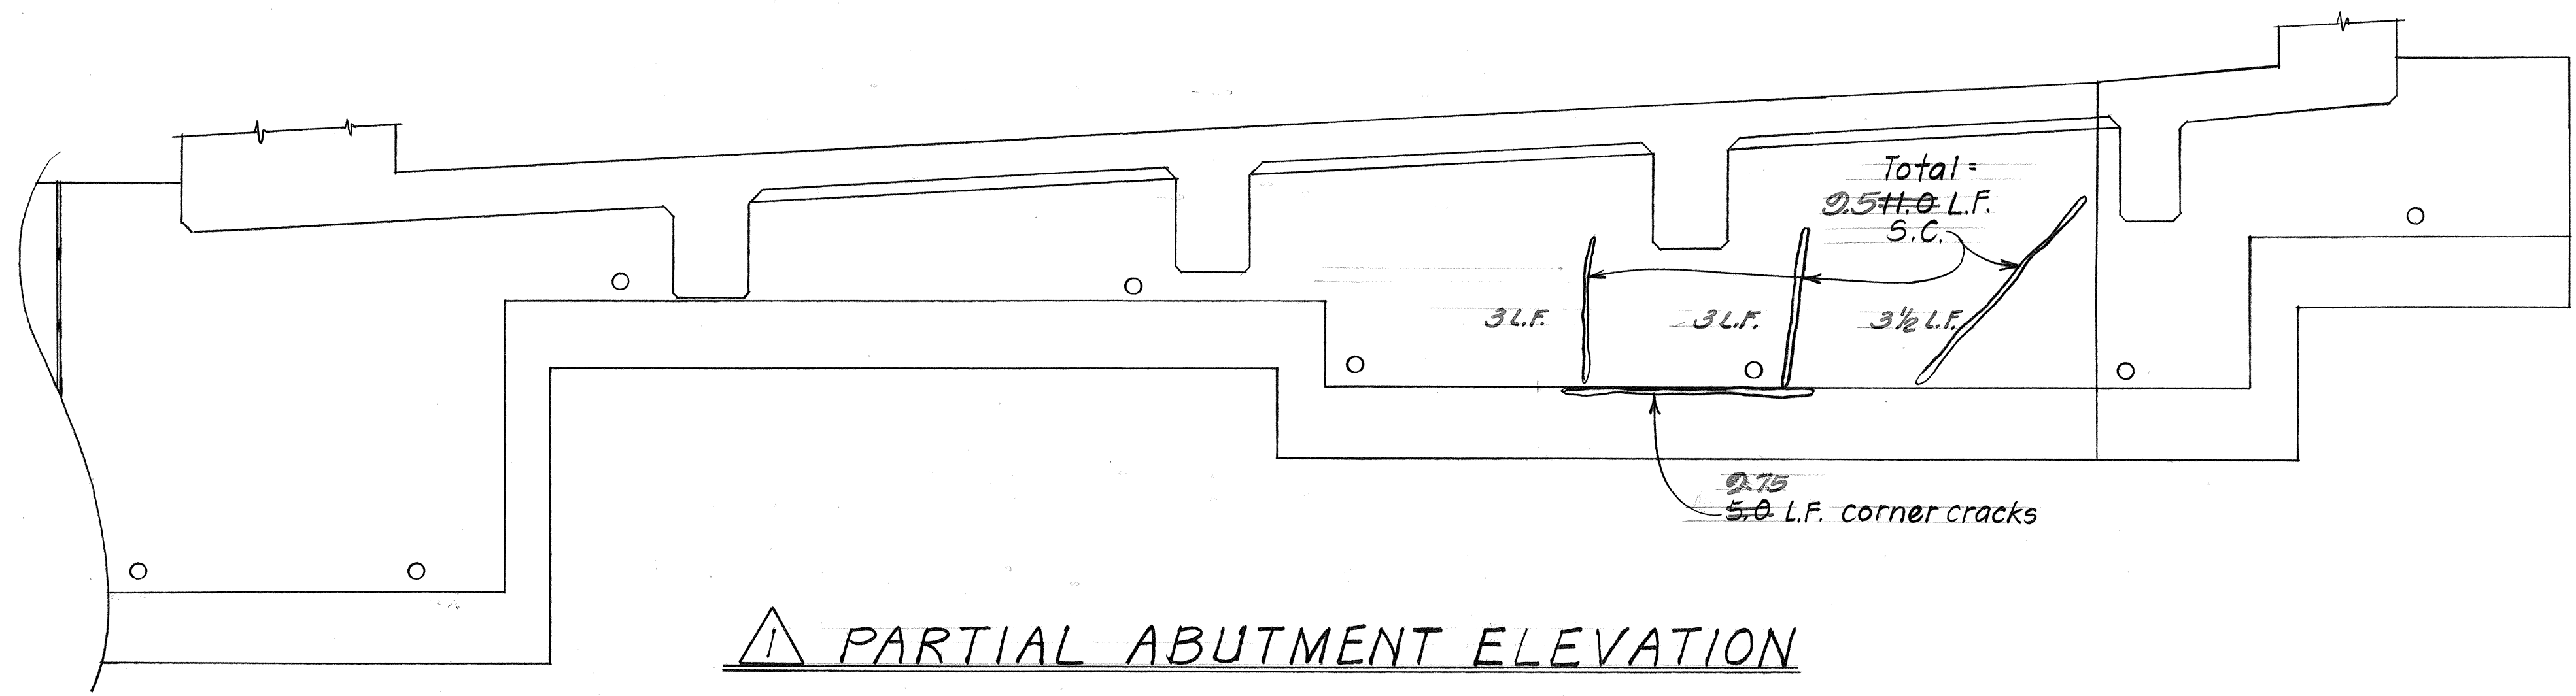

1 PARTIAL ABUTMENT ELEVATION
FACING HONOLULU
 Scale: 3/8" = 1'-0"

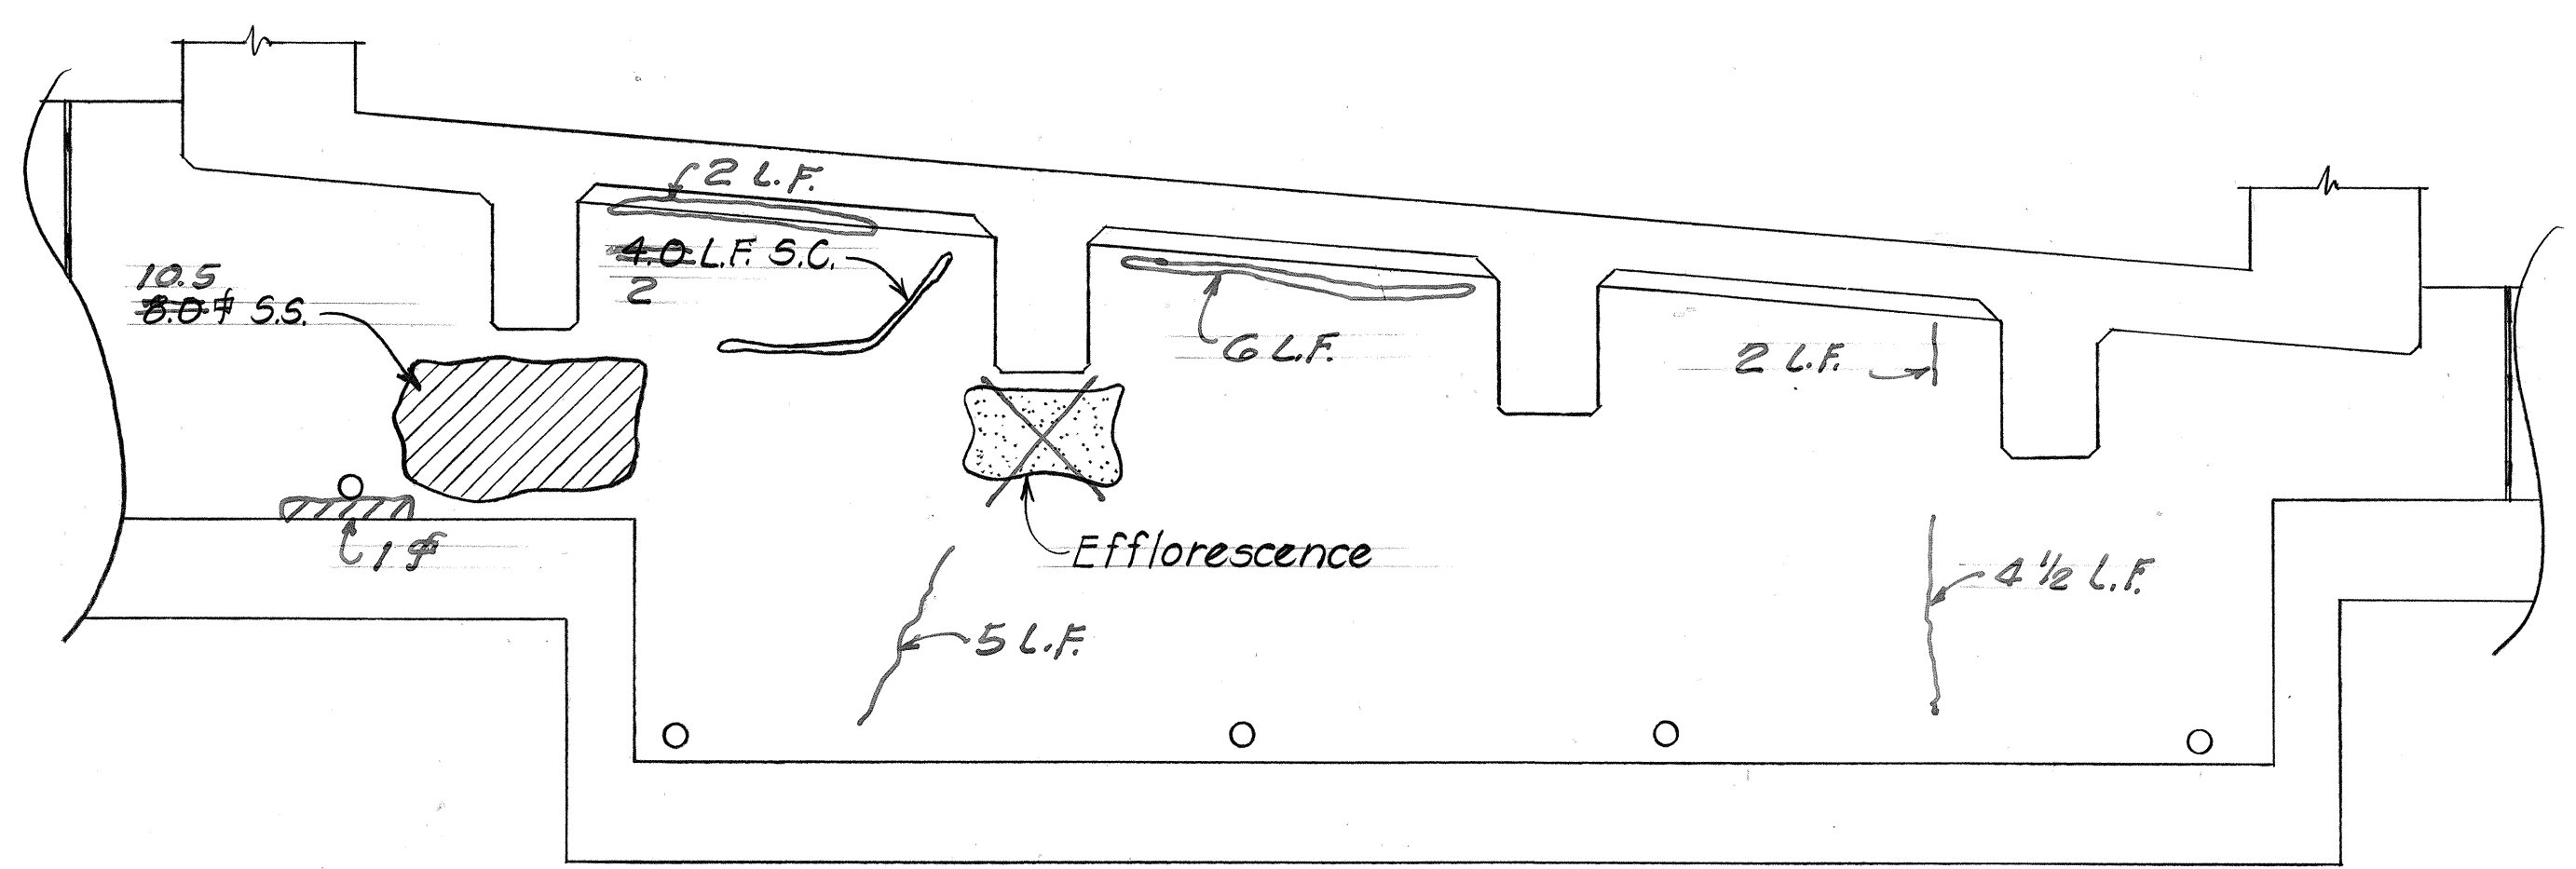

2 PARTIAL ABUTMENT ELEVATION
FACING WAIMANALO
 Scale: 3/8" = 1'-0"

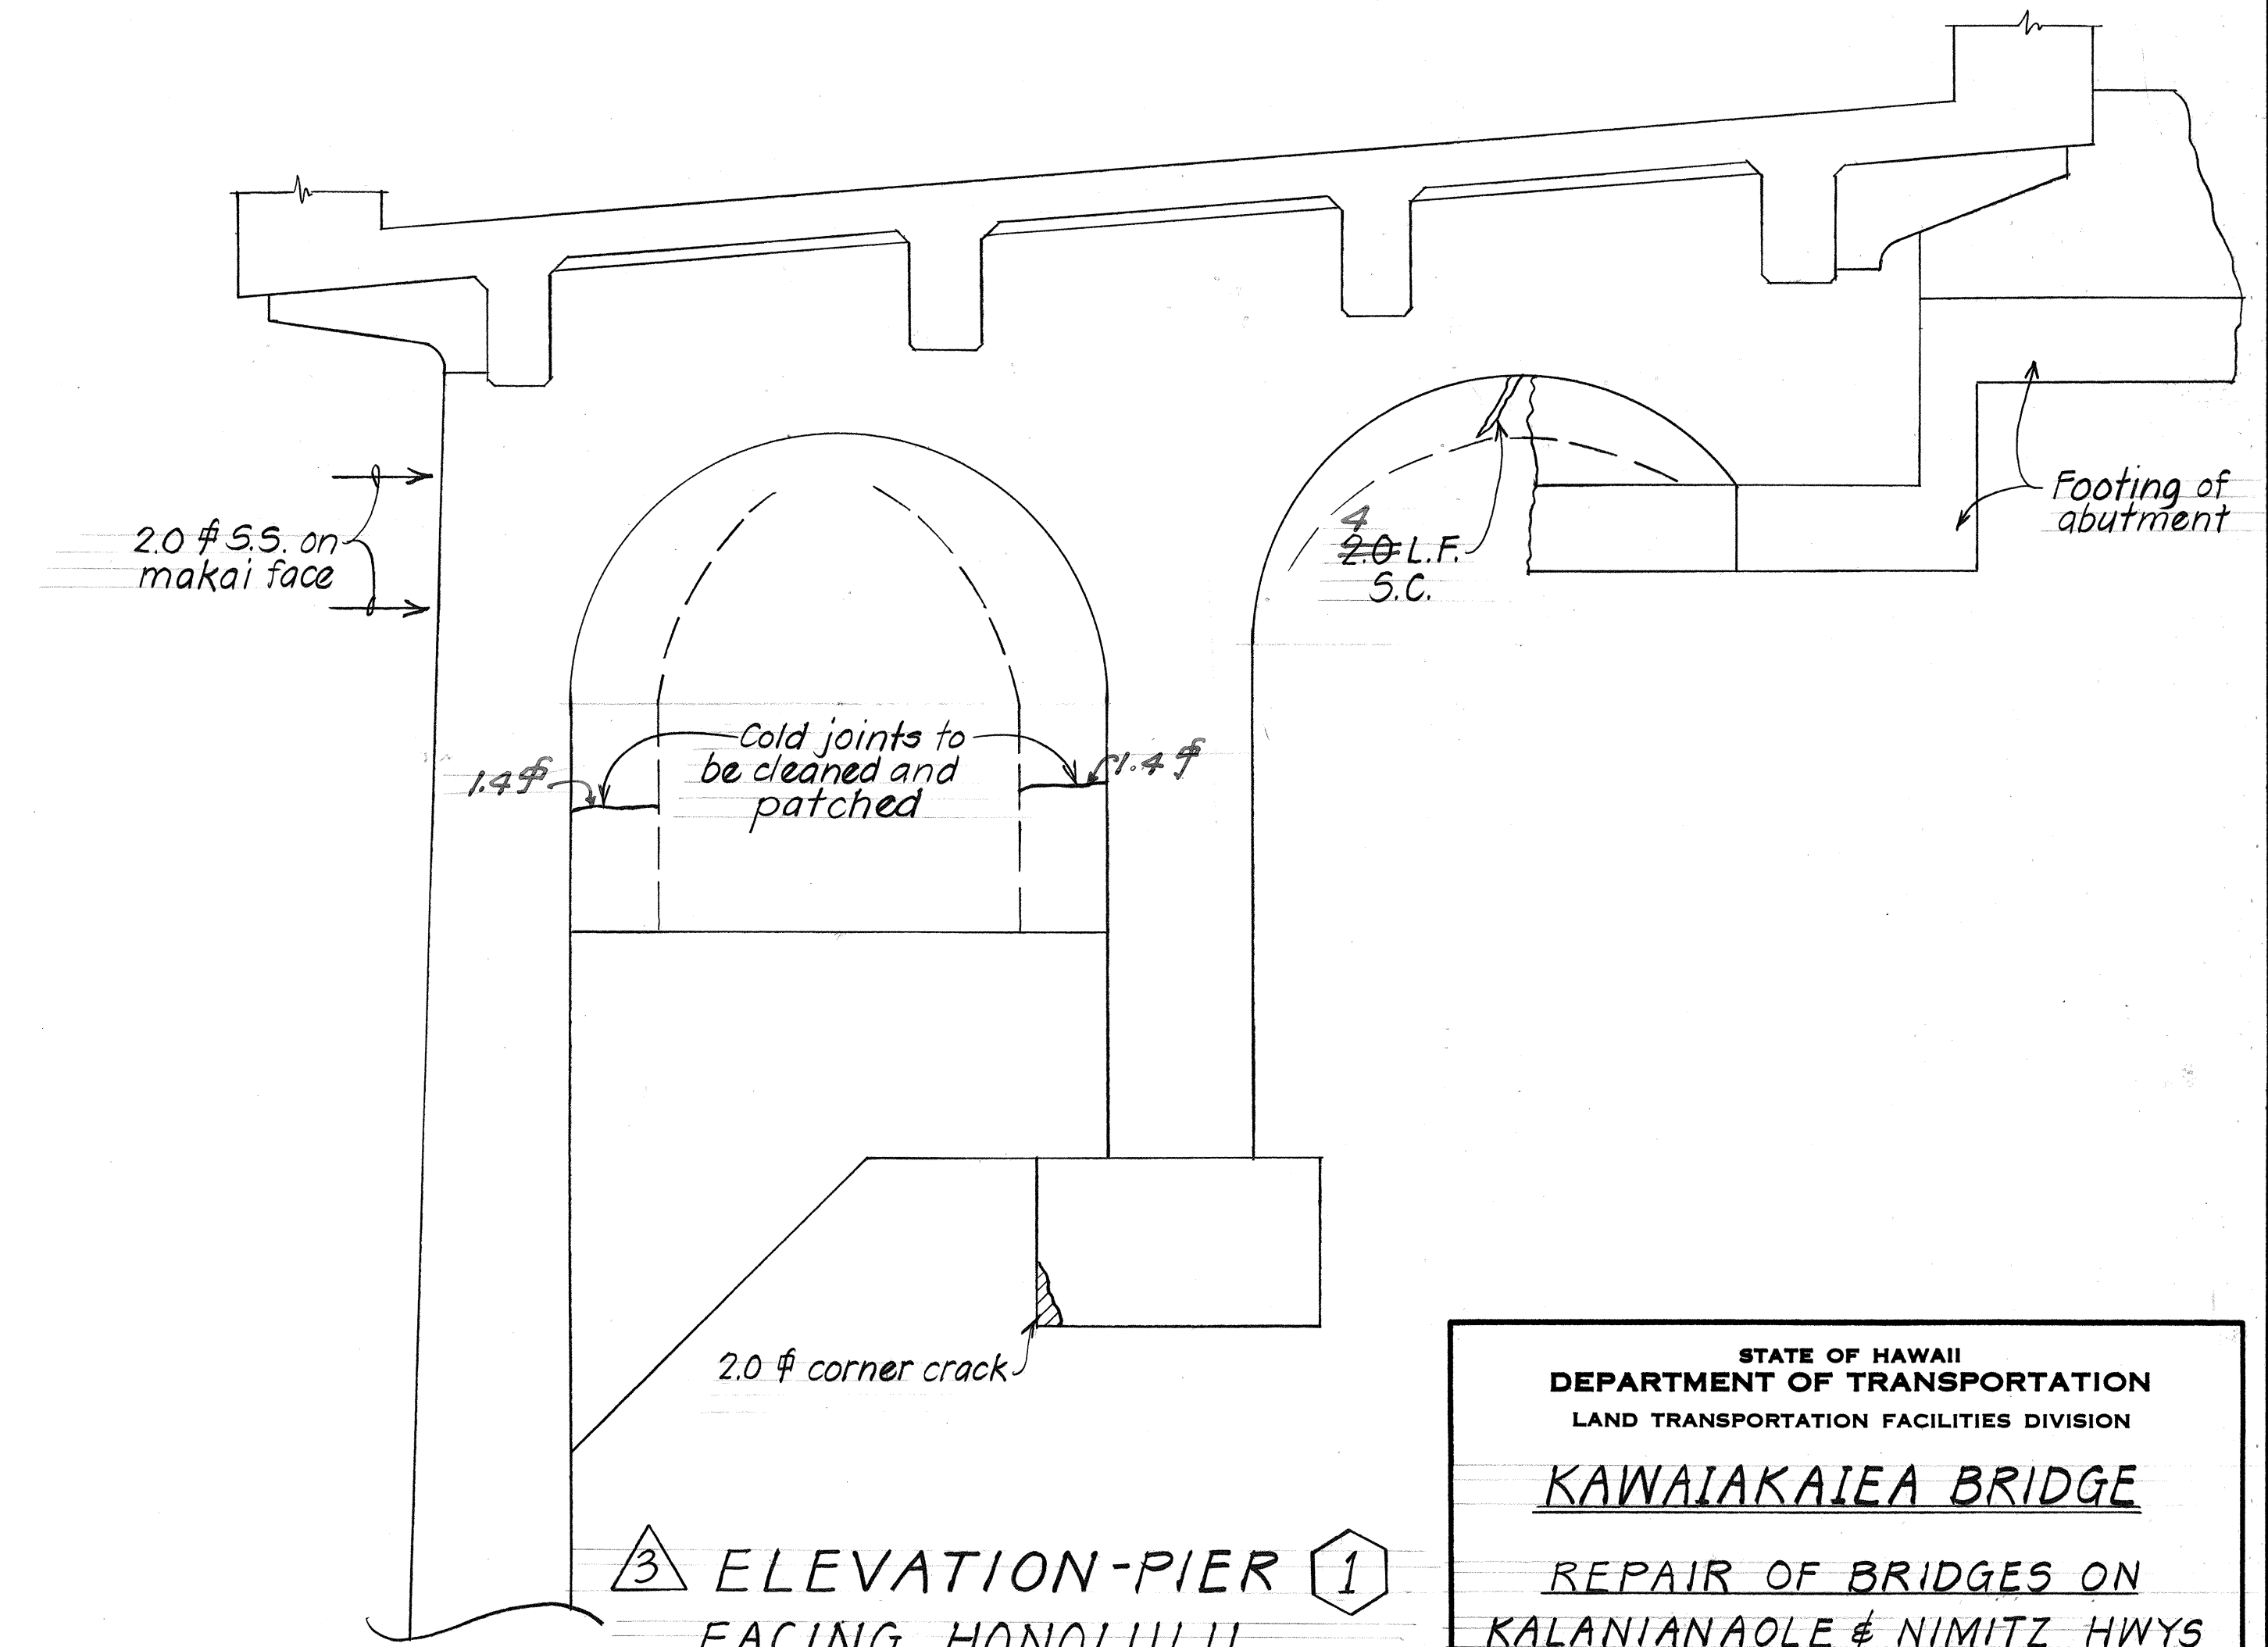

3 ELEVATION-PIER 1
FACING HONOLULU
 Scale: 3/8" = 1'-0"

STATE OF HAWAII
 DEPARTMENT OF TRANSPORTATION
 LAND TRANSPORTATION FACILITIES DIVISION

KAWAIAKAIEA BRIDGE

REPAIR OF BRIDGES ON
 KALANIANA'OLE & NIMITZ HWYS
 Proj. No. HWY-0-01-84M
 Scale: As Shown Date: Feb. 1984

SHEET NO. 2 OF 3 SHEETS

ORIGINAL PLAN	DATE
SURVEYED BY	
DRAWN BY	
DESIGNED BY	
QUANTITIES BY	
CHECKED BY	

STATE OF HAWAII
DEPARTMENT OF TRANSPORTATION
LAND TRANSPORTATION FACILITIES DIVISION

KAWAIAKAIEA BRIDGE

REPAIR OF BRIDGES ON
KALANIANA'OLE & NIMITZ HWYS
Proj. No. HWY-0-01-84M

Scale: As Shown Date: Feb. 1984

SHEET NO. 3 OF 3 SHEETS

