
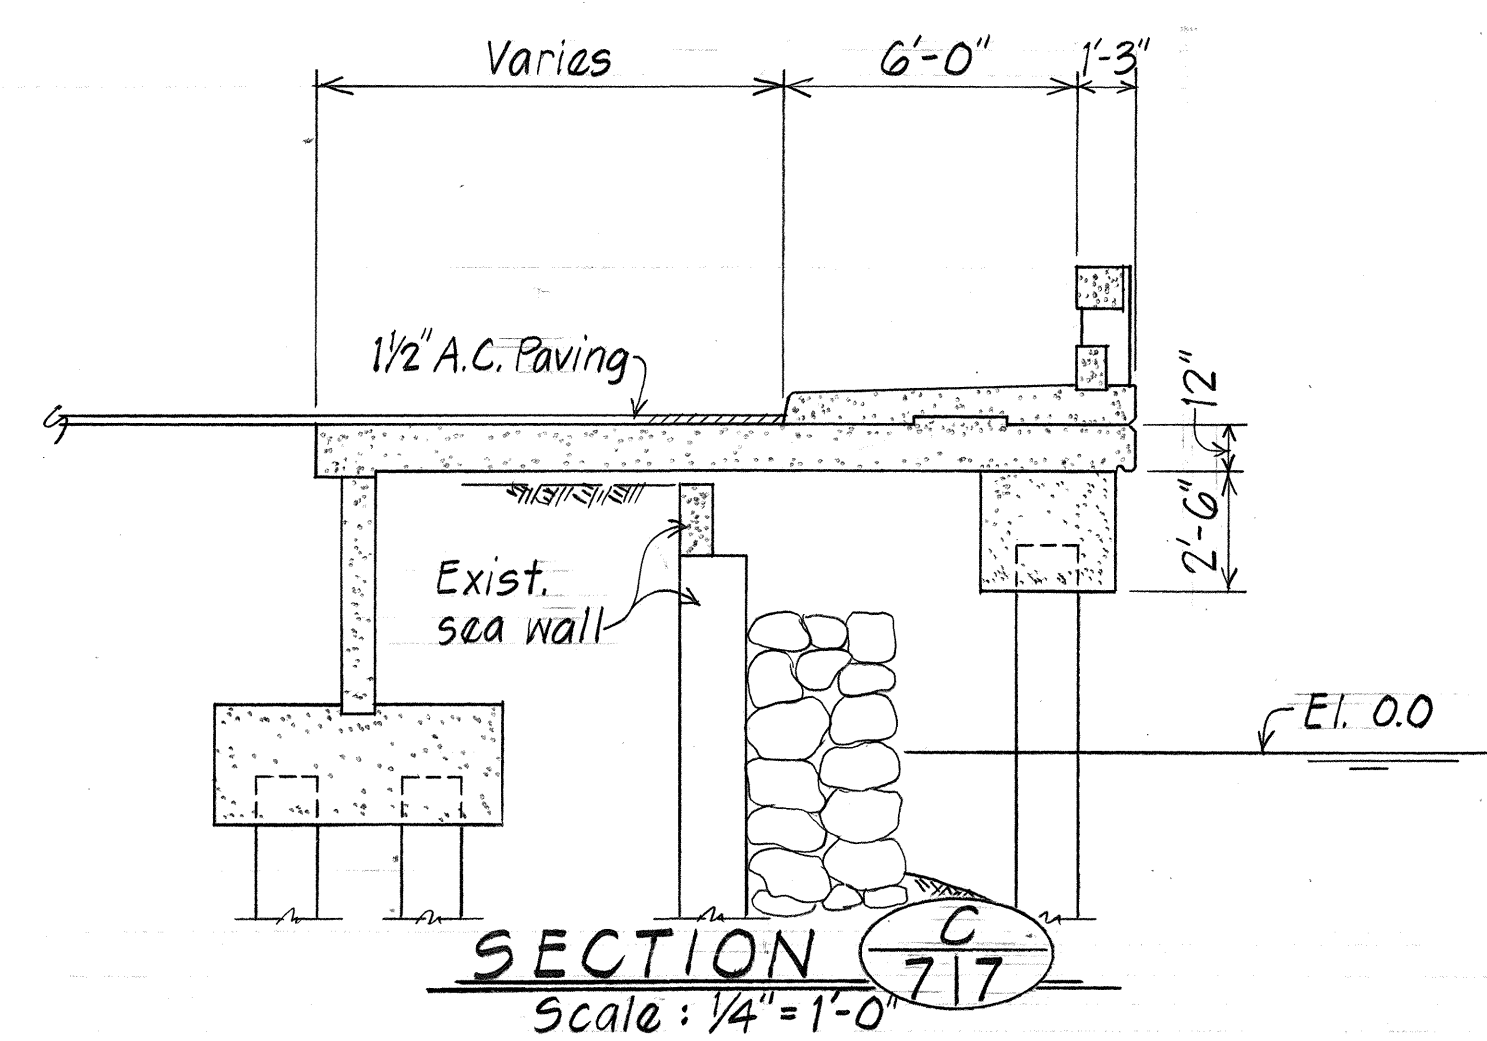
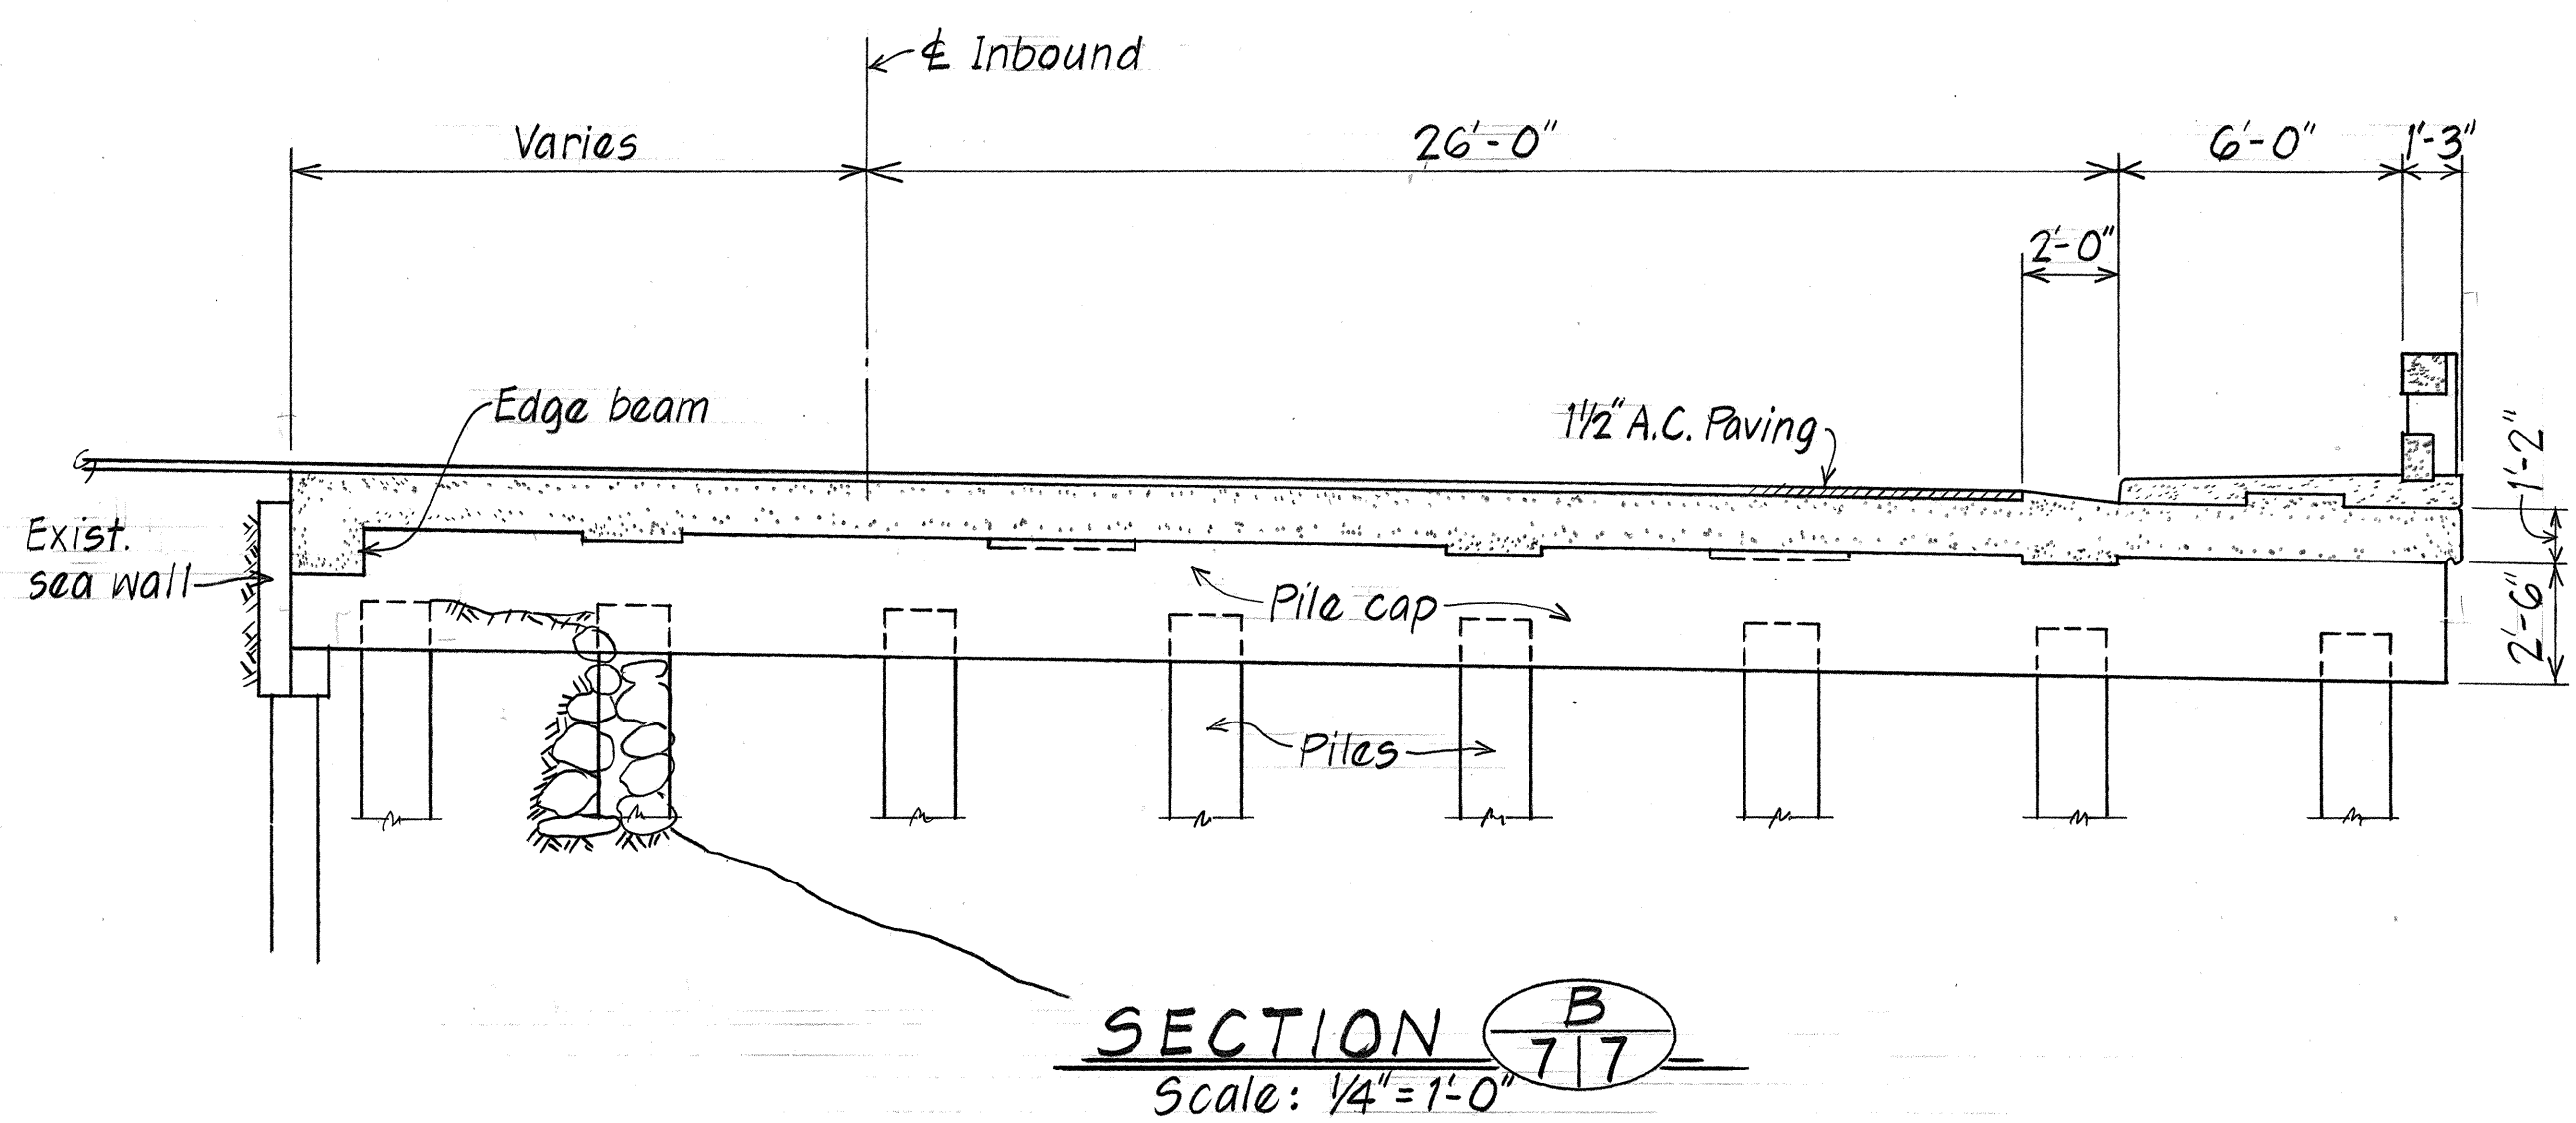
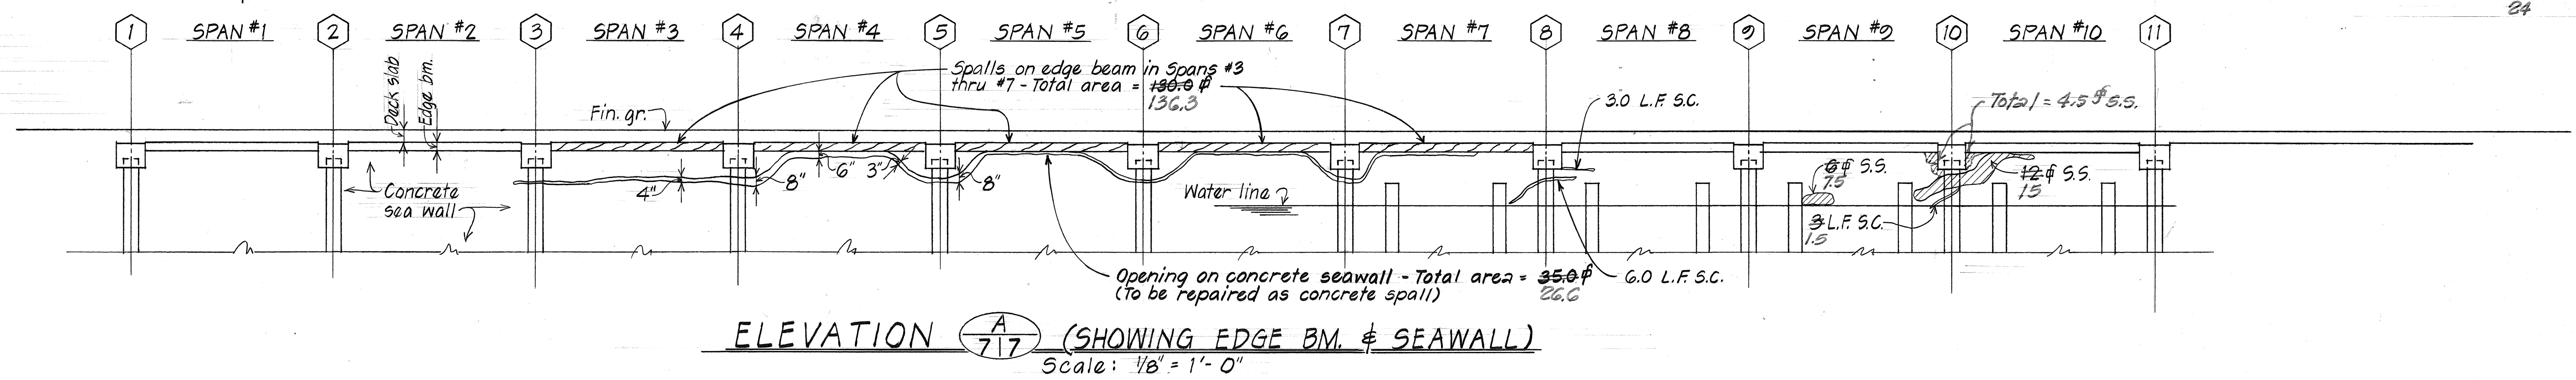


FED. ROAD DIST. NO.	STATE	FED. AID PROJ. NO.	FISCAL YEAR	SHEET NO.	TOTAL SHEETS
HAWAII	HAW.	HWY-0-01-84M	1984	9	9

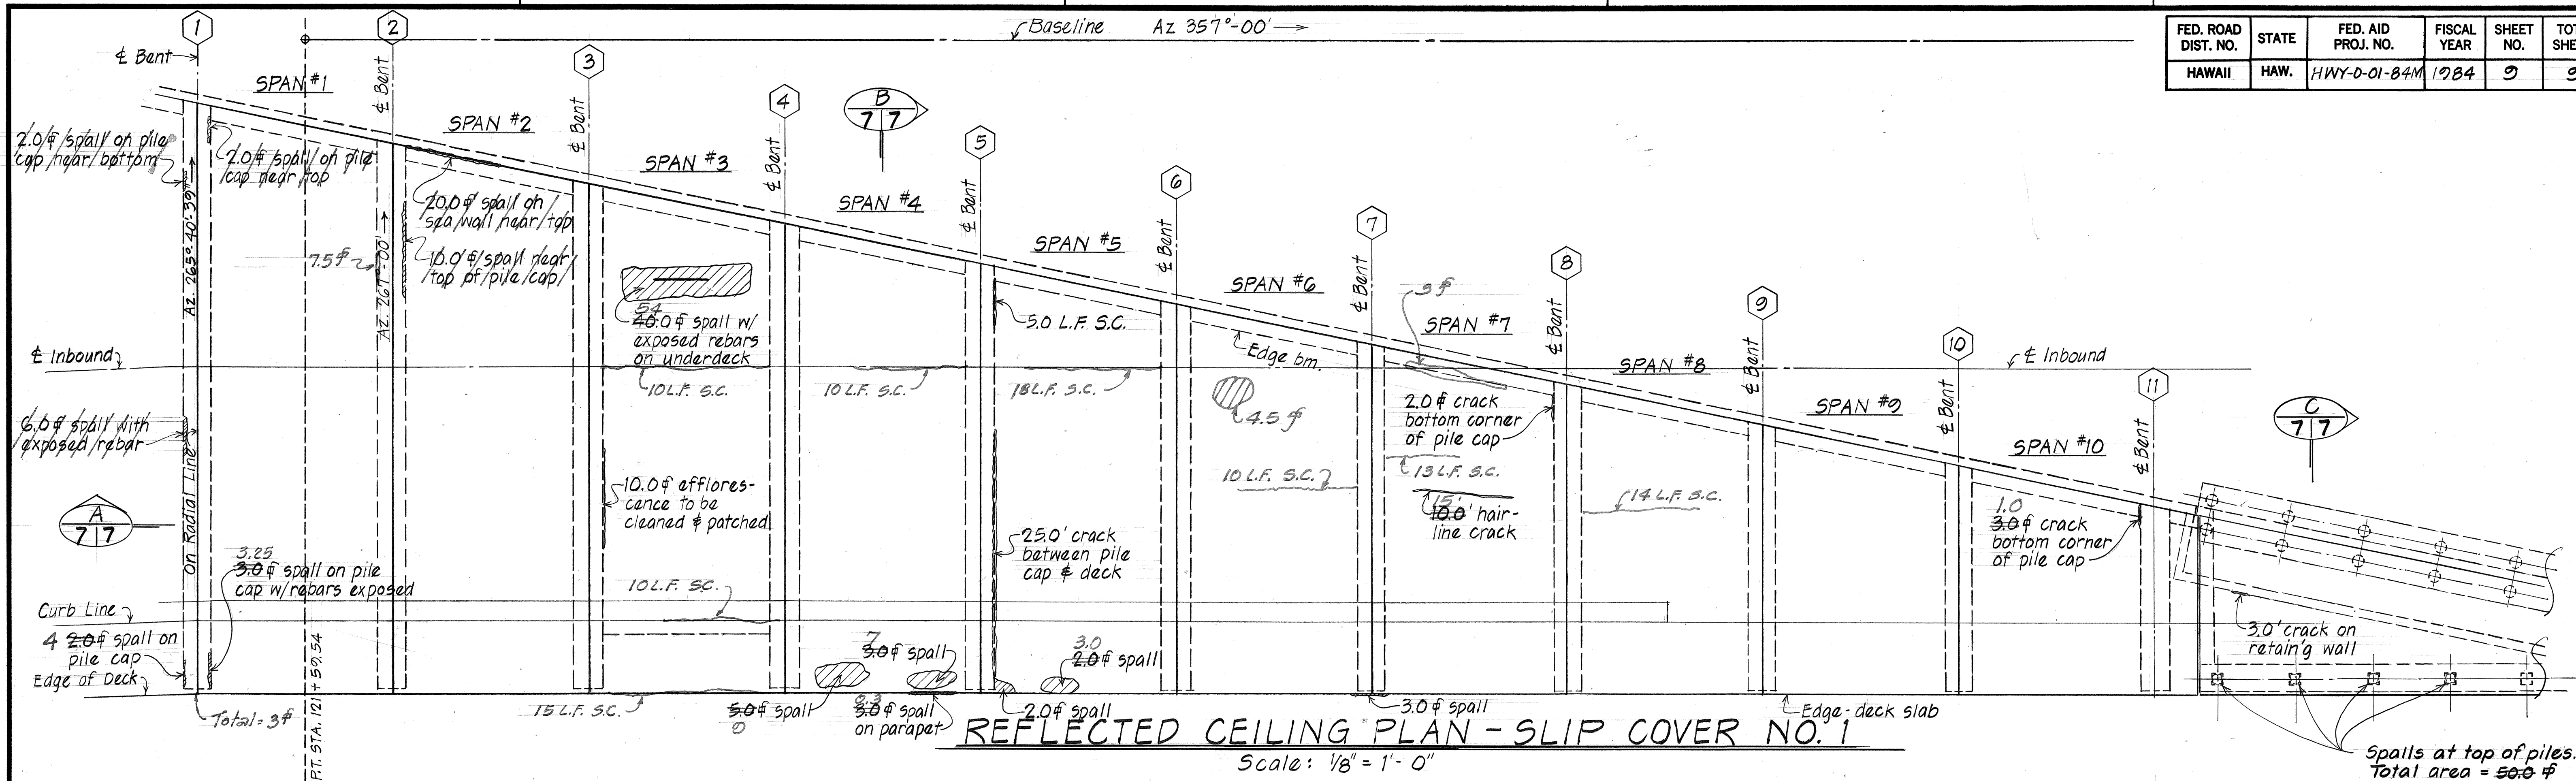

STATE OF HAWAII
DEPARTMENT OF TRANSPORTATION
LAND TRANSPORTATION FACILITIES DIVISION
SLIP COVER NO. 1
REPAIR OF BRIDGES ON
KALANIANA'OLE & NIMITZ HWYS
Proj. No. HWY-0-01-84M
Scale: As Shown Date: Feb. 1984
SHEET NO. 1 OF 1 SHEETS

ORIGINAL PLAN
SURVEY PLOTTED BY DATE
DRAWN BY N.Y.G.U.
CHECKED BY N.Y.G.U.
DESIGNED BY N.Y.G.U.
NOTED BY N.Y.G.U.
QUANTITIES BY N.Y.G.U.
NO.