,	·
	INDEX TO DRAWINGS
SHEET NO.	DESCRIPTION
	TITLE SHEET
2	TYPICAL DETAILS AND GENERAL NOTES
3 - 5	PLAN & SECTION IHIIHILAUAKEA BRIDGE
6 - 8	PLAN & SECTION KAWAIAKAIEA BRIDGE
9	PLAN & SECTION SLIP COVER NO. I
,	
,	




STATE OF HAWAII

DEPARTMENT OF TRANSPORTATION HIGHWAYS DIVISION "AS-BUILT" PLANS FOR

REPAIR OF BRIDGES ON KALANIANAOLE HWY. AND NIMITZ HWY.

PROJECT NO. HWY-0-01-84M

DISTRICT OF HONOLULU ISLAND OF OAHU

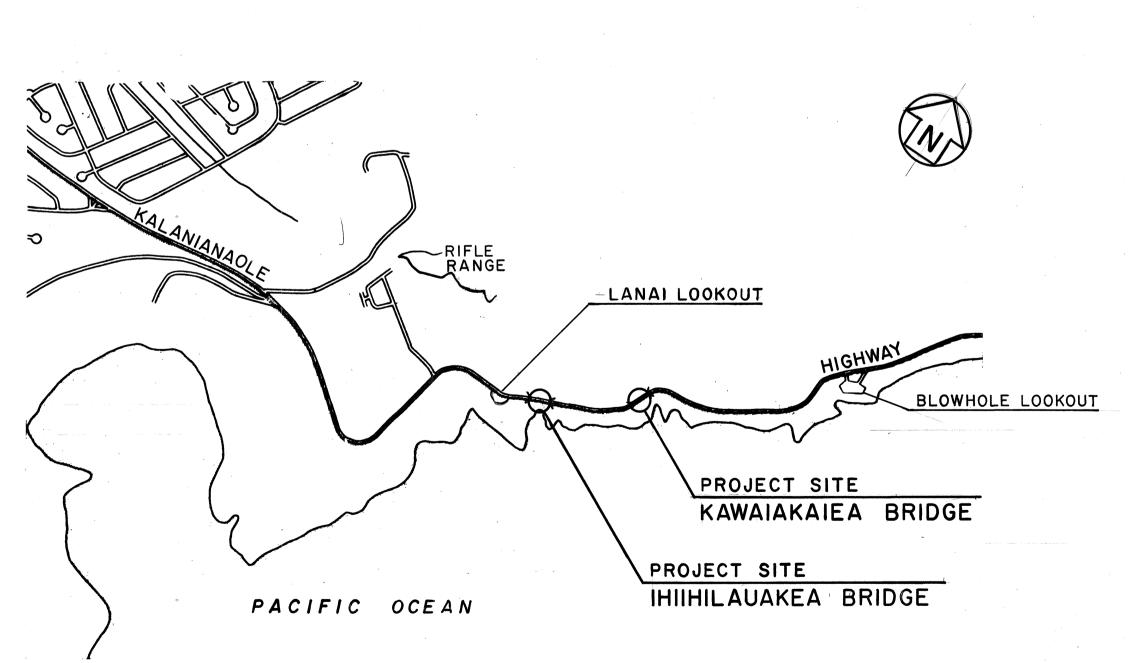

KALANIANAOLE HIGHWAY LAYOUT PLAN

SCALE IN THOUSAND FEET

PROJECT SITE

HONOLULU HARBOR

NIMITZ HIGHWAY

SLIP COVER NO. I

PROJECT LOCATIONS SCALE IN MILES

FED. ROAD DIST. NO.

FISCAL YEAR

HWY-0-01-84M | 1984

STATE OF HAWAII

NO SIGNIFICANT CHANGES WERE MADE DURING CONSTRUCTION ON THESE PLANS EXCEPT CHANGES IN THE ORIGINAL THEORETICAL QUANTITIES. FOR ACTUAL QUANTITIES, REFER TO PROJECT LEDGER AND/OR COMPUTATION BOOK.

Llavet Zamashero RESIDENT ENGINEER

> DEPARTMENT OF TRANSPORTATION STATE OF HAWAII APPROVED:

2/13/86

DATE

3/19/84 O'DIR. OF TRANSPORTATION DATE

MAR., 1984 DATE 548-7490 PHONE

NISHIMURA
P. S. & E. BY NISHIMURA DESIGNED BY