	INDEX TO DRAWINGS
SHEET NO.	DESCRIPTION
A	TITLE SHEET
2	GENERAL NOTES
3	TYPICAL SECTION
4	MISCELLANEOUS DETAILS
5-8	PLAN
9-17	STANDARD DETAILS
18-21	SIGNING, MARKING PLAN
22-34	STANDARD DETAILS
	,



STATE OF HAWAII

DEPARTMENT OF TRANSPORTATION


HIGHWAYS DIVISION


"AS-BUILT"

PLANS FOR

KALANIANAOLE HIGHWAY RESURFACING C & C CORPORATION YARD TOWARDS WAIMANALO FEDERAL AID PROJECT NO. F-072-I(28)

DISTRICT OF KOOLAUPOKO ISLAND OF OAHU

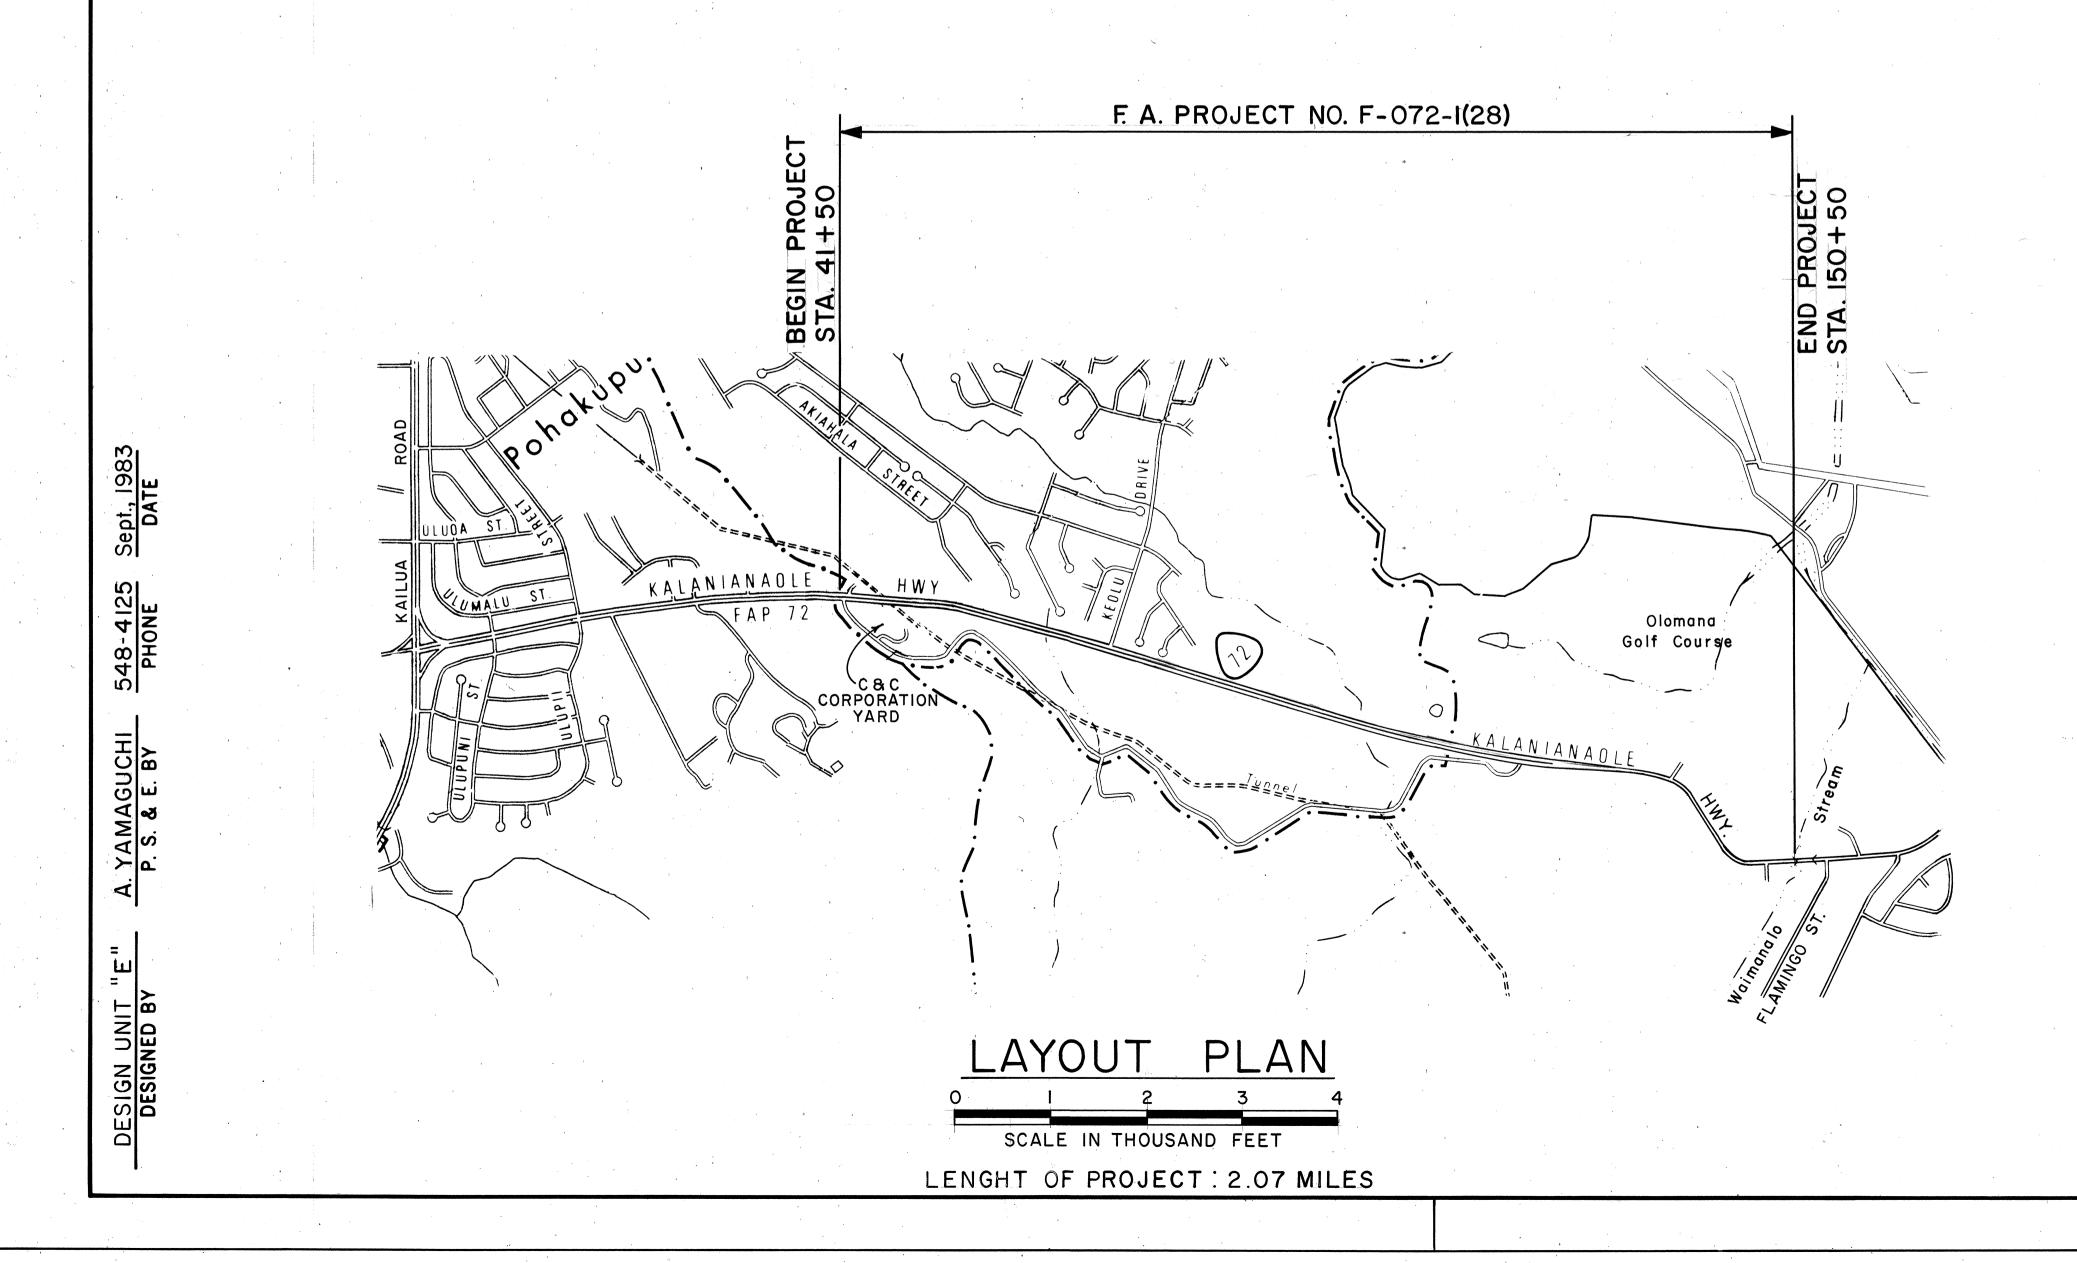

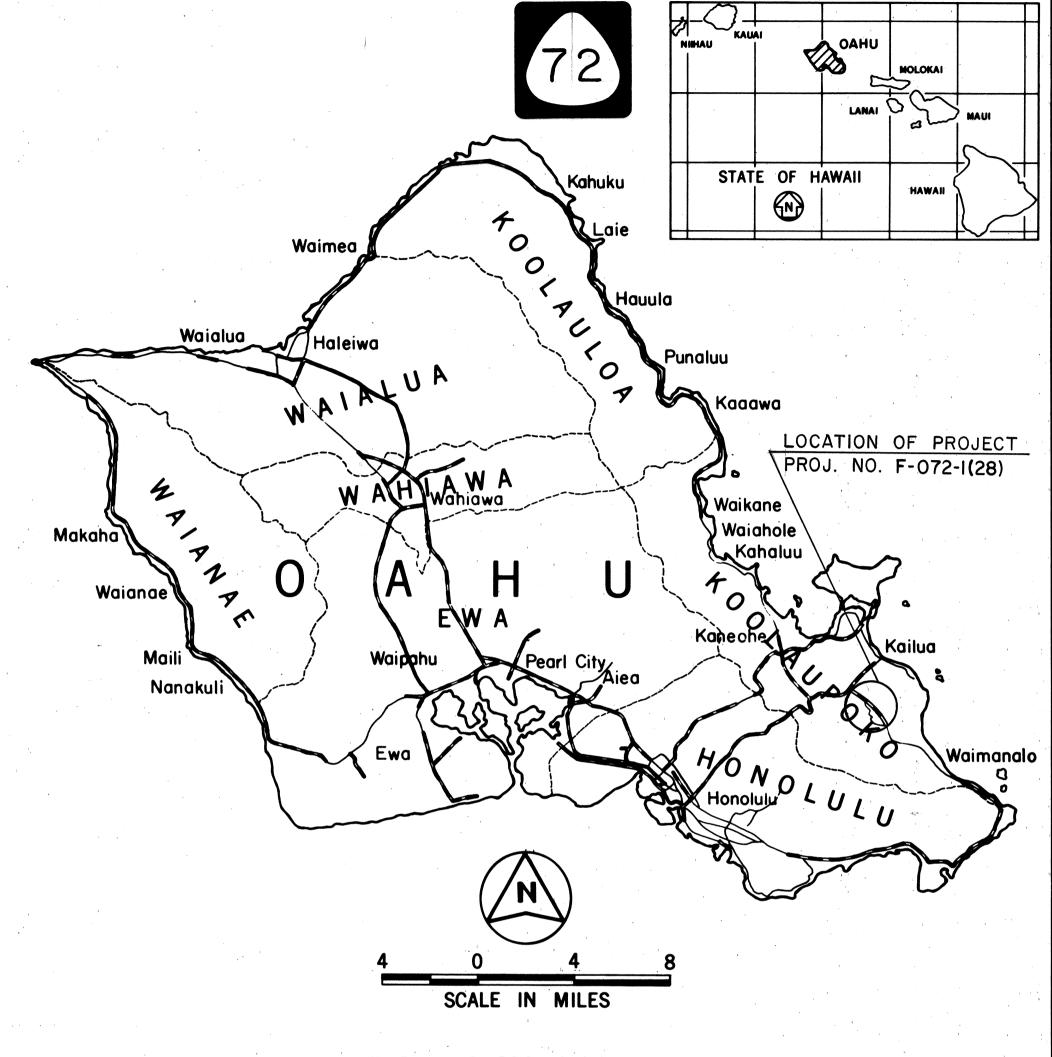

FED. ROAD DIST. NO. FED. AID PROJ. NO.

F-072-1(28)

FEDERAL AID PROJECTS PREVIOUSLY CONSTRUCTED OR UNDER CONSTRUCTION

NO SIGNIFICANT CHANGES WERE MADE DURING CONSTRUCTION ON THESE PLANS EXCEPT CHANGES IN THE ORIGINAL THEORETICAL QUANTITIES. FOR ACTUAL QUANTITIES, REFER TO PROJECT LEDGER AND/OR COMPUTATION BOOK.

RESIDENT ENGINEER

5/25/90 DATE

DESIGN DESIGNATION

CURRENT ADT (1984) ... 24,300
DESIGN ADT (1994) ... 35,500
DHV ... 3,040
D ... 53%
T ... 2.5%
V ... 60 & 25 MPH

DEPARTMENT OF TRANSPO	RTATION
FEDERAL HIGHWAY ADMINIS	TRATION
APPROVED:	
Wellthur	5/zz/84 DATE
DIVISION ADMINISTRATOR	DATE

DEPARTMENT OF TRANSPORTATION		
STATE OF HAWAII	•	
APPROVED:		
Cheryl D. Soon FUR. OF TRANSPORTATION	5/8/84	
FUIR. OF TRANSPORTATION	DATE	