




FED. ROAD DIST. NO.	STATE	FED. AID PROJ. NO.	FISCAL YEAR	SHEET NO.	TOTAL SHEETS
HAWAII	HAW.	F-072-1(28)	1984	3	34

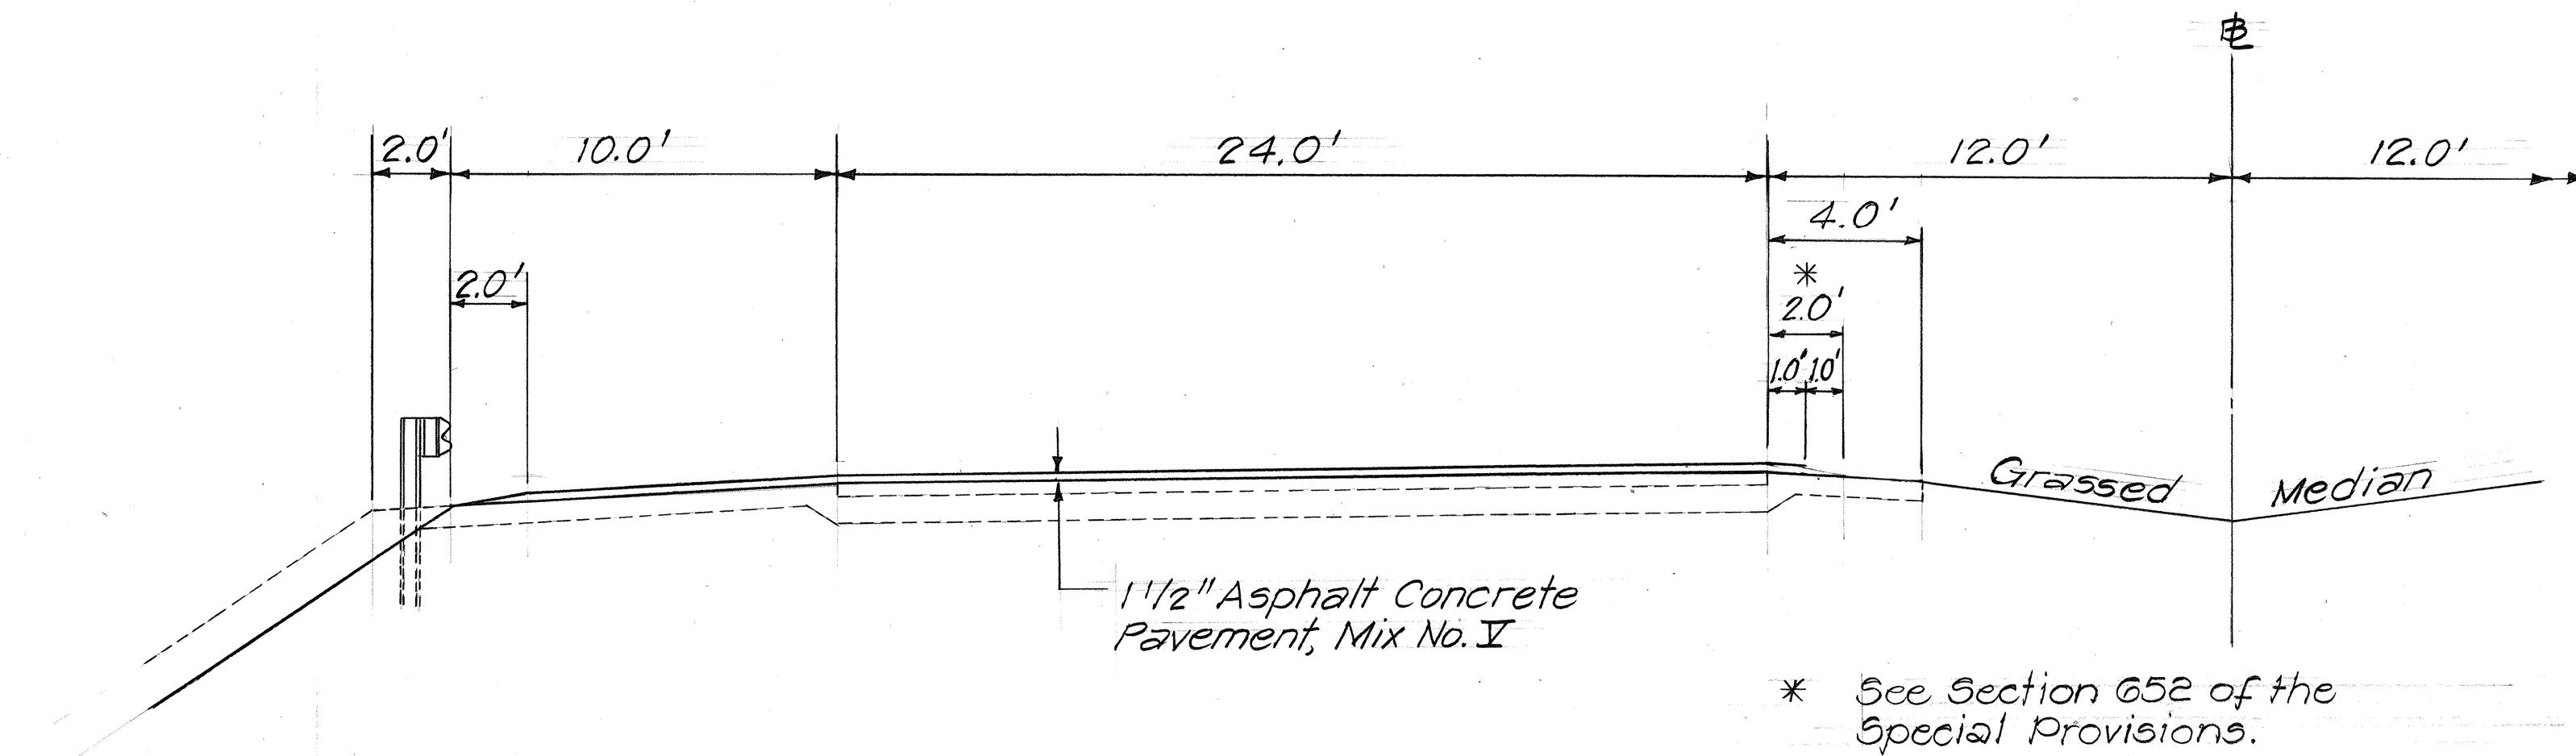


TYPICAL HALF SECTION AT UNPAVED SHOULDER AND MEDIAN AREA
Scale: 1/4" = 1'-0"

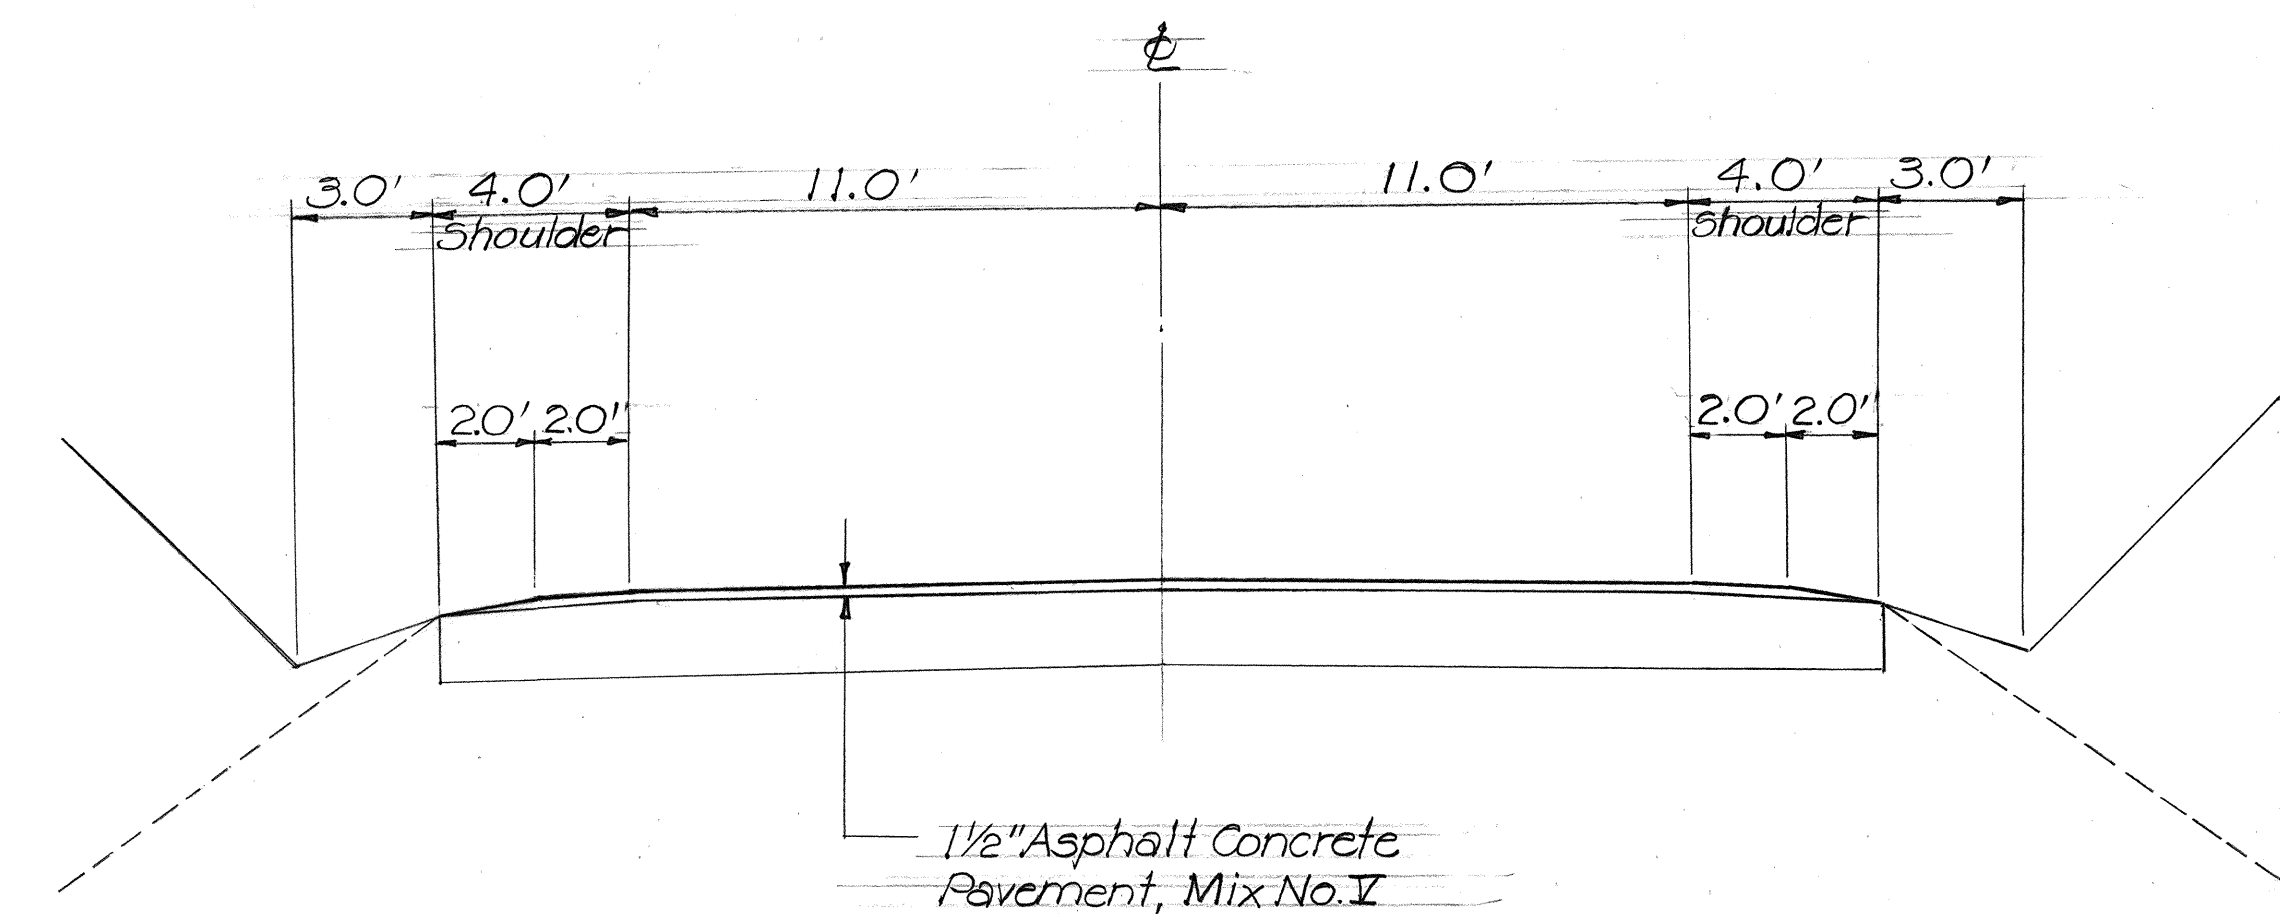


TYPICAL SECTION OLD KALANIANA'OLE ROAD
Scale: 1/4" = 1'-0"

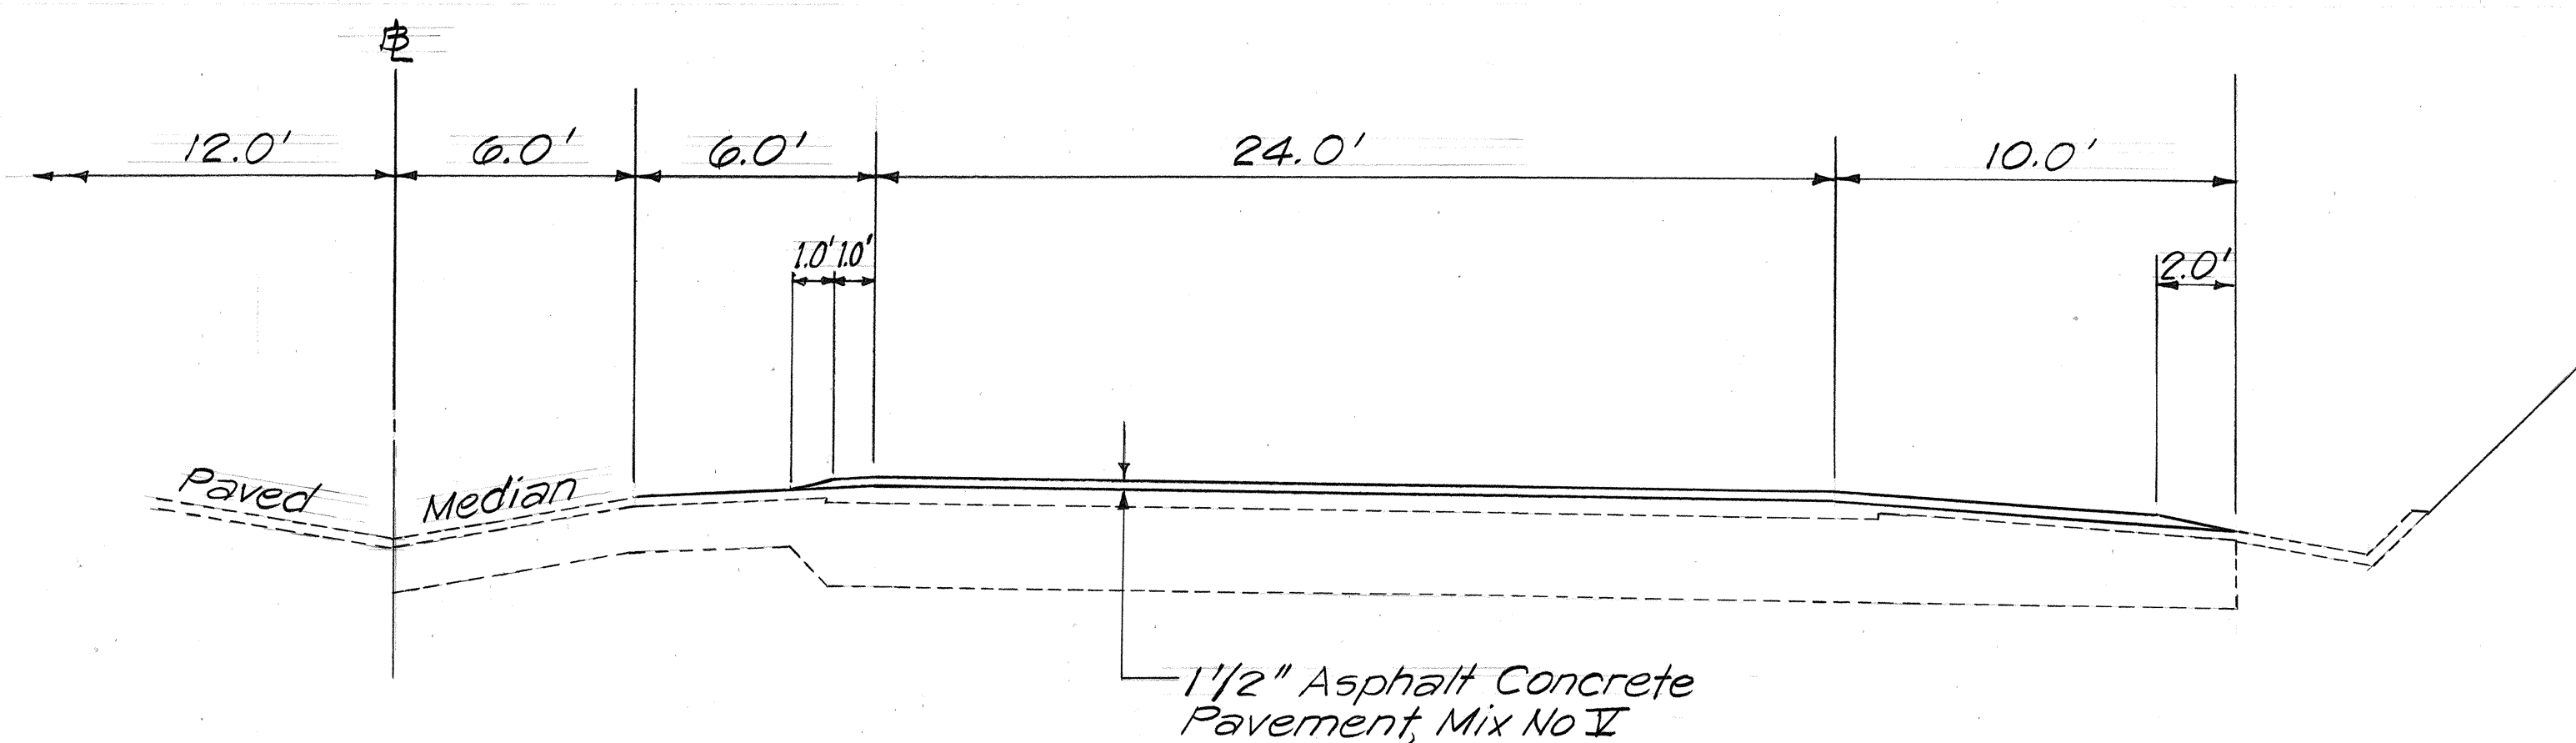


TYPICAL HALF SECTION AT PAVED SHOULDER AND MEDIAN AREA
Scale: 1/4" = 1'-0"

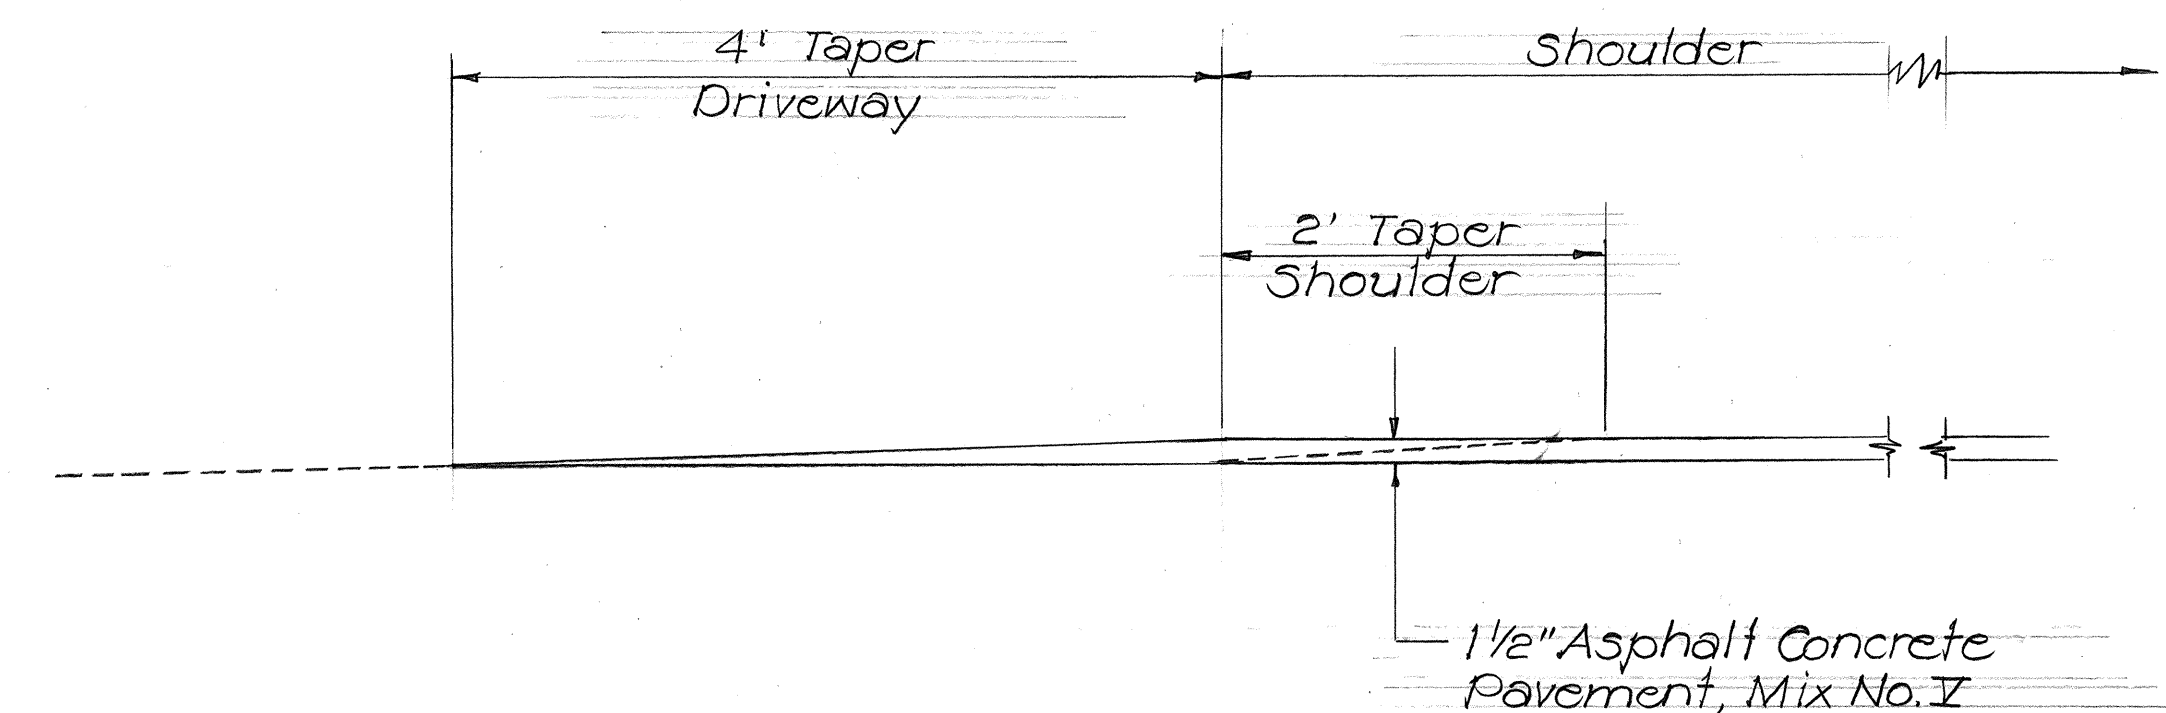

TYPICAL SECTION AT DRIVEWAYS
Scale: 1" = 1'-0"

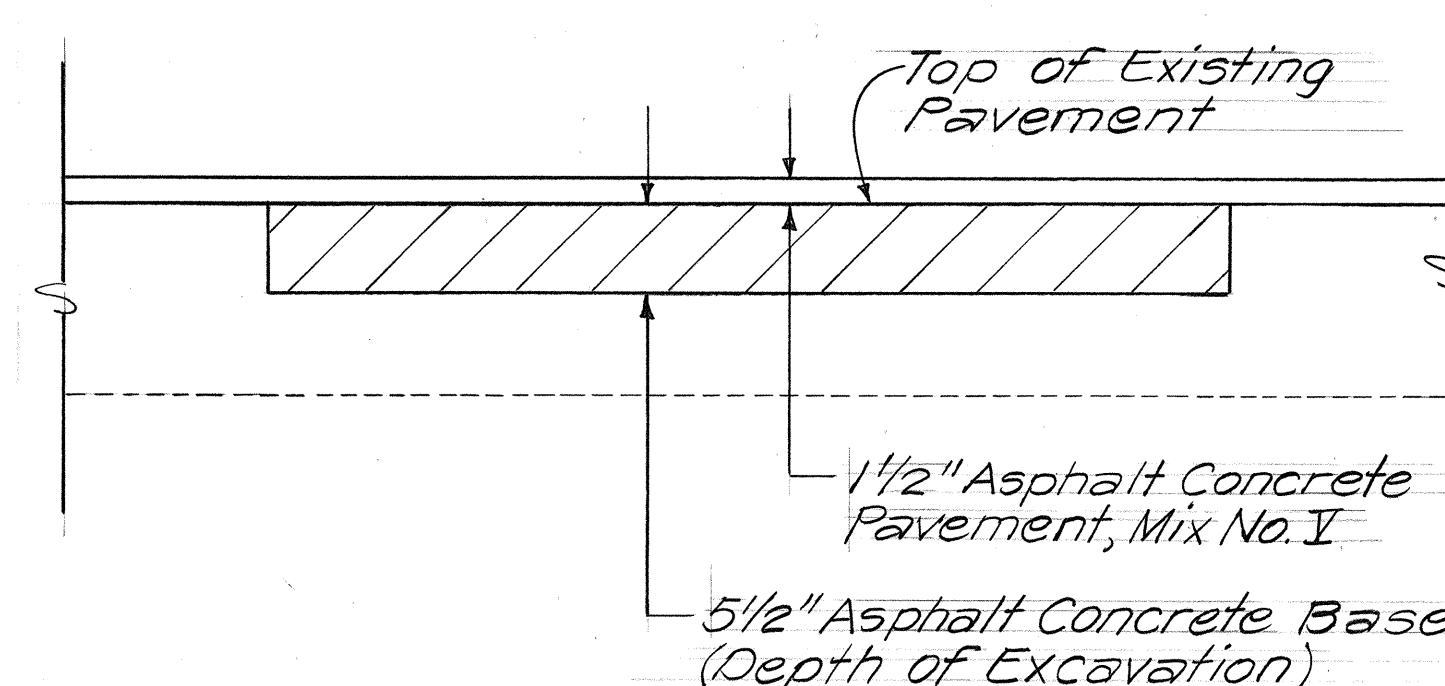

RECONSTRUCTION AREA DETAIL
Scale: 1" = 1'-0"

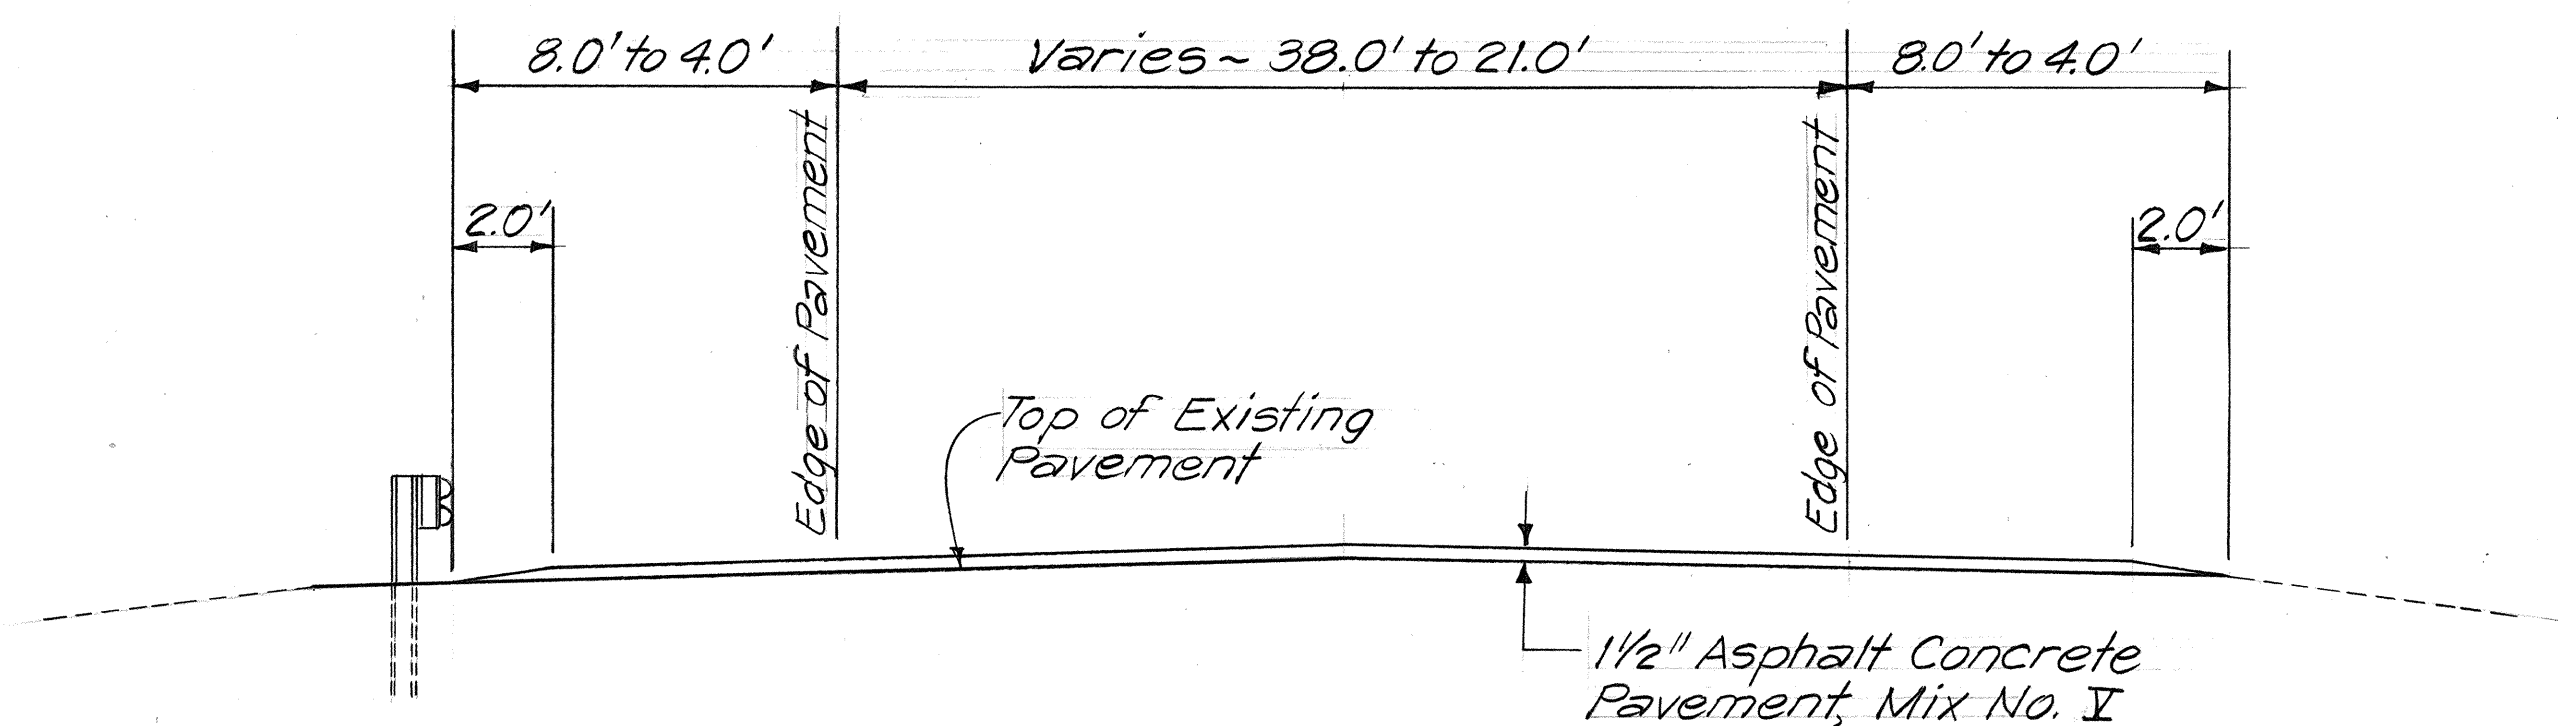

TYPICAL SECTION ~ UNDIVIDED ROADWAY
STA. 125+50± TO END OF PROJECT
Scale: 1/4" = 1'-0"

STATE OF HAWAII
DEPARTMENT OF TRANSPORTATION
HIGHWAYS DIVISION

TYPICAL SECTION

KALANIANA'OLE HIGHWAY RESURFACING
C&C Corporation Yard
Towards Waimanalo
F.A. PROJECT No. F-072-1(28)
Scale: As Shown Date: April, 1984

SHEET NO. OF SHEETS