


| FED. ROAD DIST. NO. | STATE | FED. AID PROJ. NO. | FISCAL YEAR | SHEET NO. | TOTAL SHEETS |
|---------------------|-------|--------------------|-------------|-----------|--------------|
| HAWAII              | HAW.  | HES-0300(23)       | 1984        | 5         | 42           |

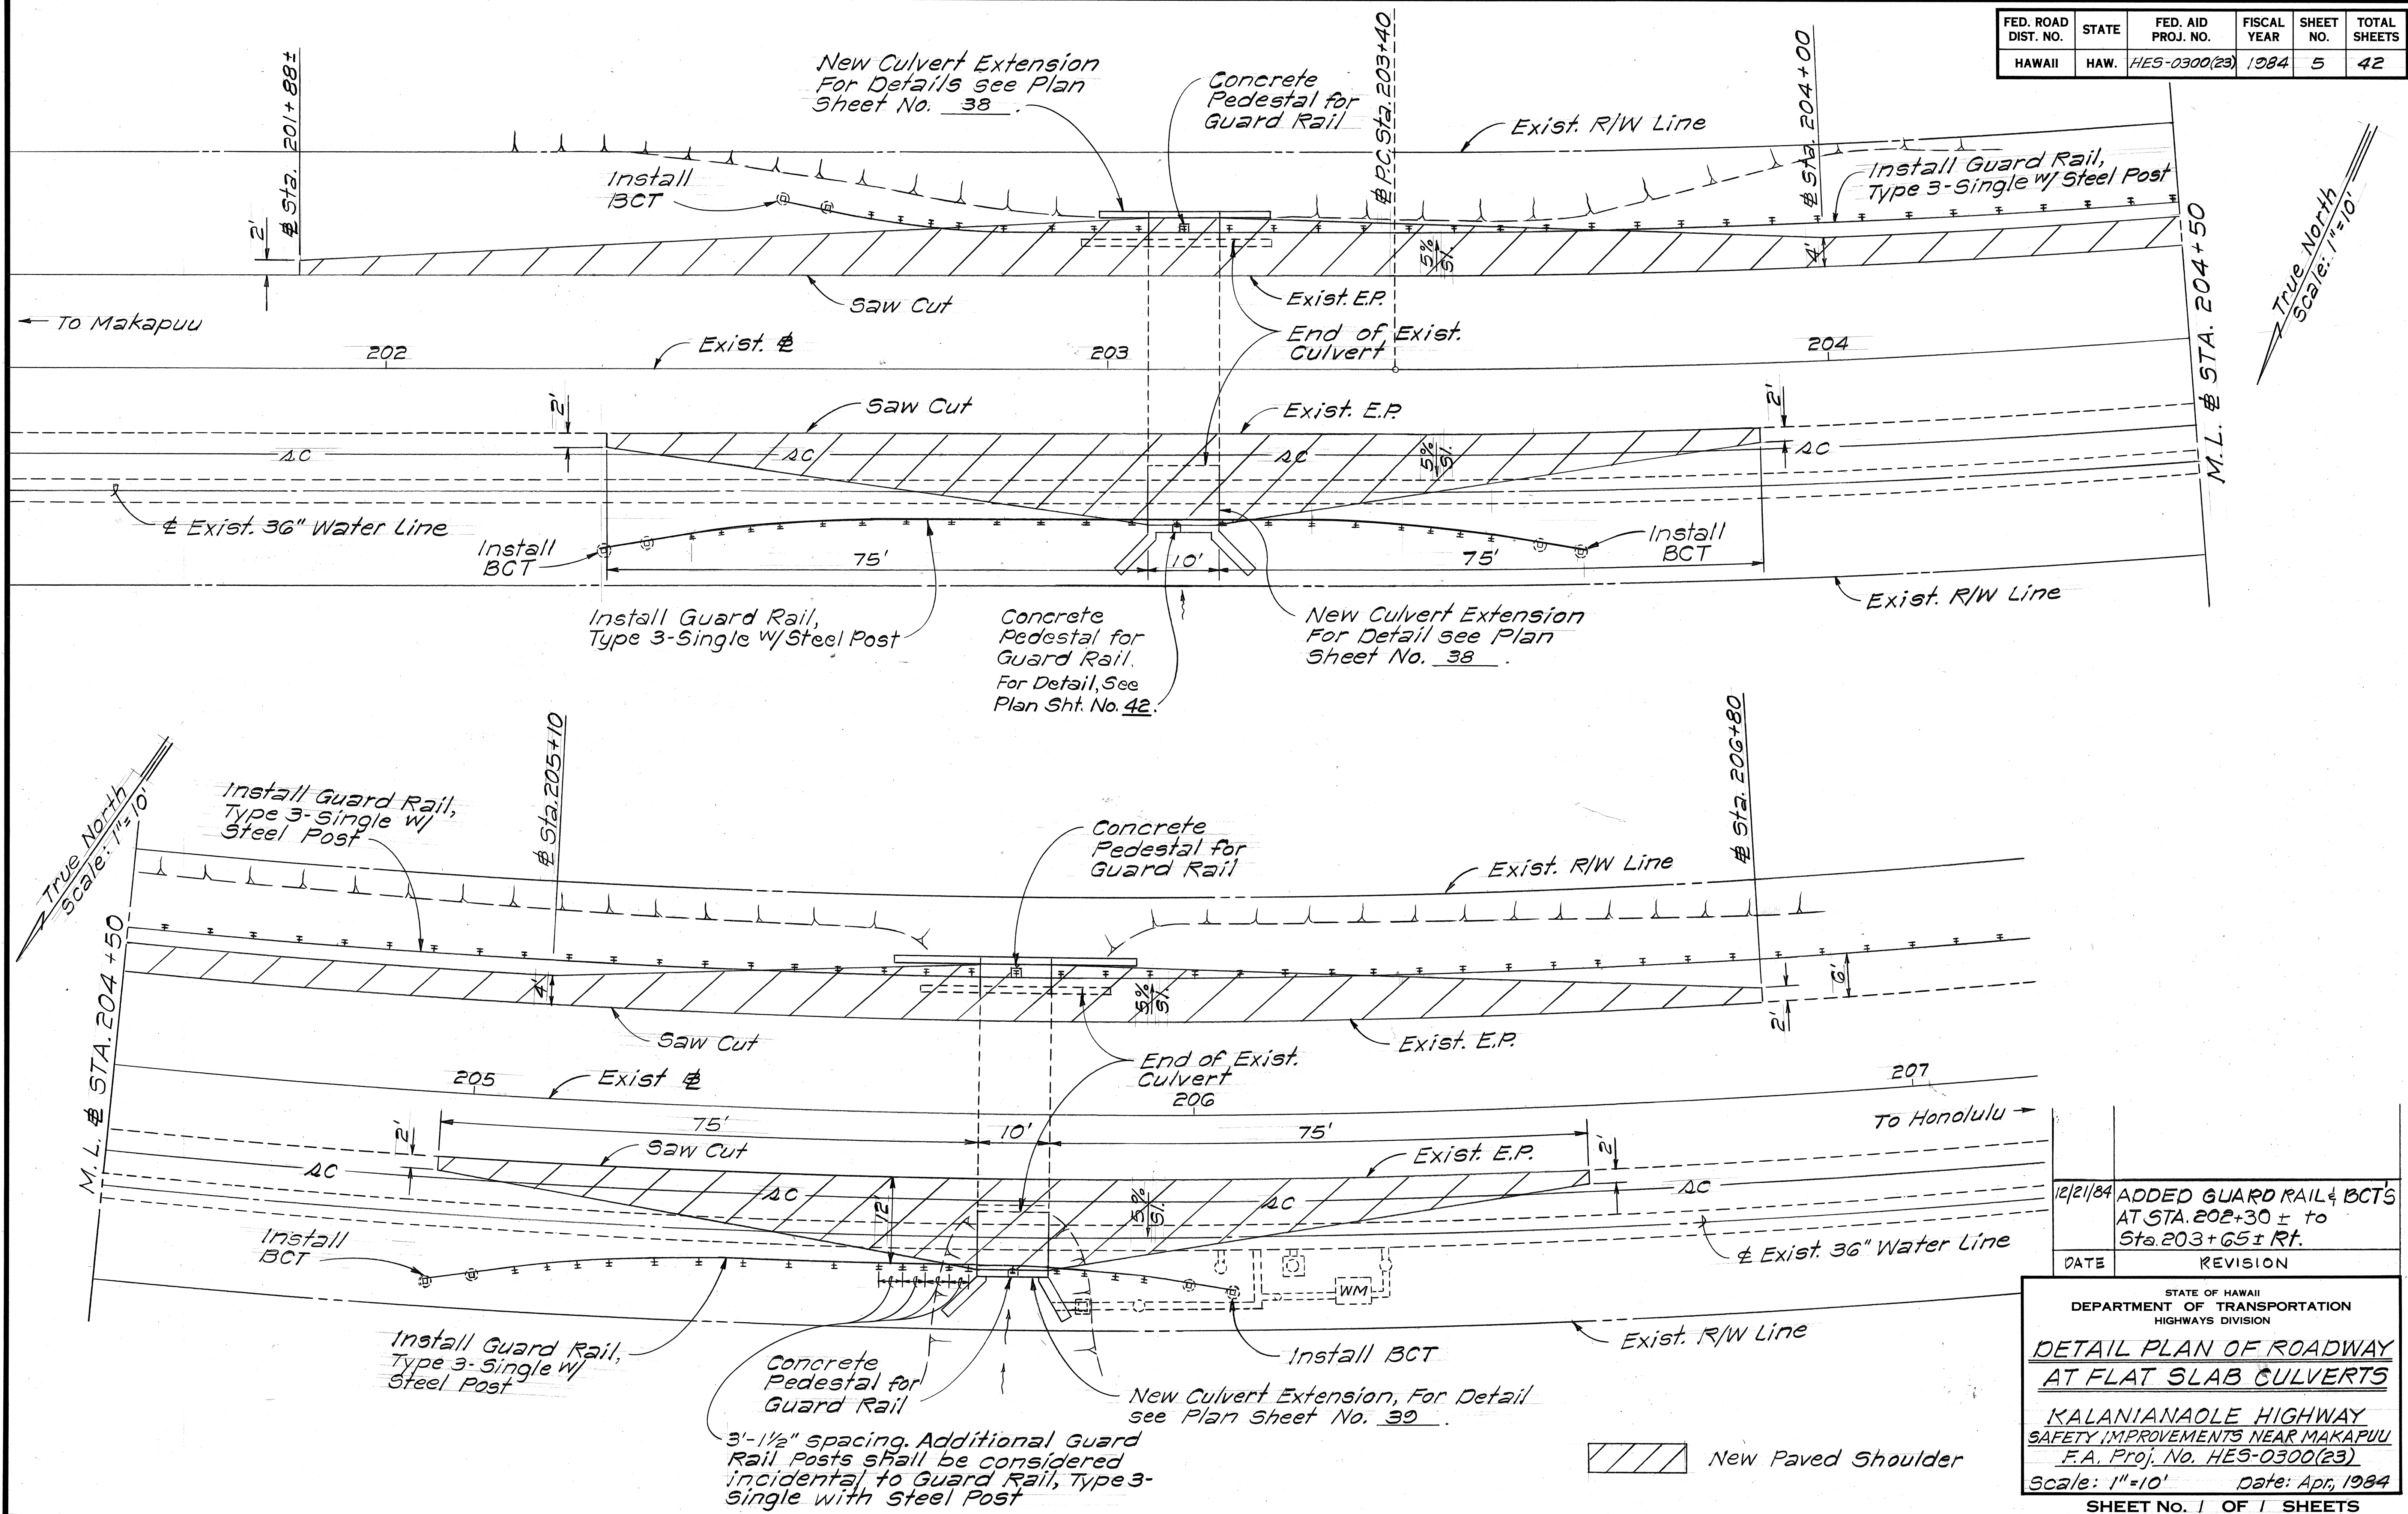

|          |                                                                |
|----------|----------------------------------------------------------------|
| 12/21/84 | ADDED GUARD RAIL & BCT'S AT STA. 202+30 ± to Sta. 203+65 ± Rt. |
| DATE     | REVISION                                                       |

STATE OF HAWAII  
DEPARTMENT OF TRANSPORTATION  
HIGHWAYS DIVISION

**DETAIL PLAN OF ROADWAY  
AT FLAT SLAB CULVERTS**

KALANIANA'OLE HIGHWAY  
SAFETY IMPROVEMENTS NEAR MAKAPUU  
F.A. Proj. No. HES-0300(23)  
Scale: 1"=10' Date: Apr, 1984  
SHEET NO. 1 OF 1 SHEETS

New Paved Shoulder

3'-1/2" spacing. Additional Guard Rail Posts shall be considered incidental to Guard Rail, Type 3-Single with Steel Post