

INDEX TO DRAWINGS	
SHEET NO.	DESCRIPTION
1	TITLE SHEET
2	TYPICAL SECTIONS AND GENERAL NOTES
3-4	PLANS
5	DETAIL PLAN OF ROADWAY AT FLAT SLAB CULVERTS
6	CONSTRUCTION PHASING PLANS
7-13	TYPICAL AND STANDARD GUARD RAIL DETAILS
14-25	SIGNING, PAV'T. MARKINGS AND BARRICADE STANDARD DETAILS
26-35	DRAINAGE PLANS AND DETAILS
36-42	WAWAMALU BRIDGE & FLAT SLAB EXTENSION PLANS AND DETAILS




STATE OF HAWAII

DEPARTMENT OF TRANSPORTATION

HIGHWAYS DIVISION

"AS-BUILT"

PLANS FOR



KALANIANA'OLE HIGHWAY

SAFETY IMPROVEMENTS NEAR MAKAPUU

FED. AID PROJECT NO. HES-0300(23)

DISTRICTS OF HONOLULU AND KOOLAUPOKO

ISLAND OF OAHU

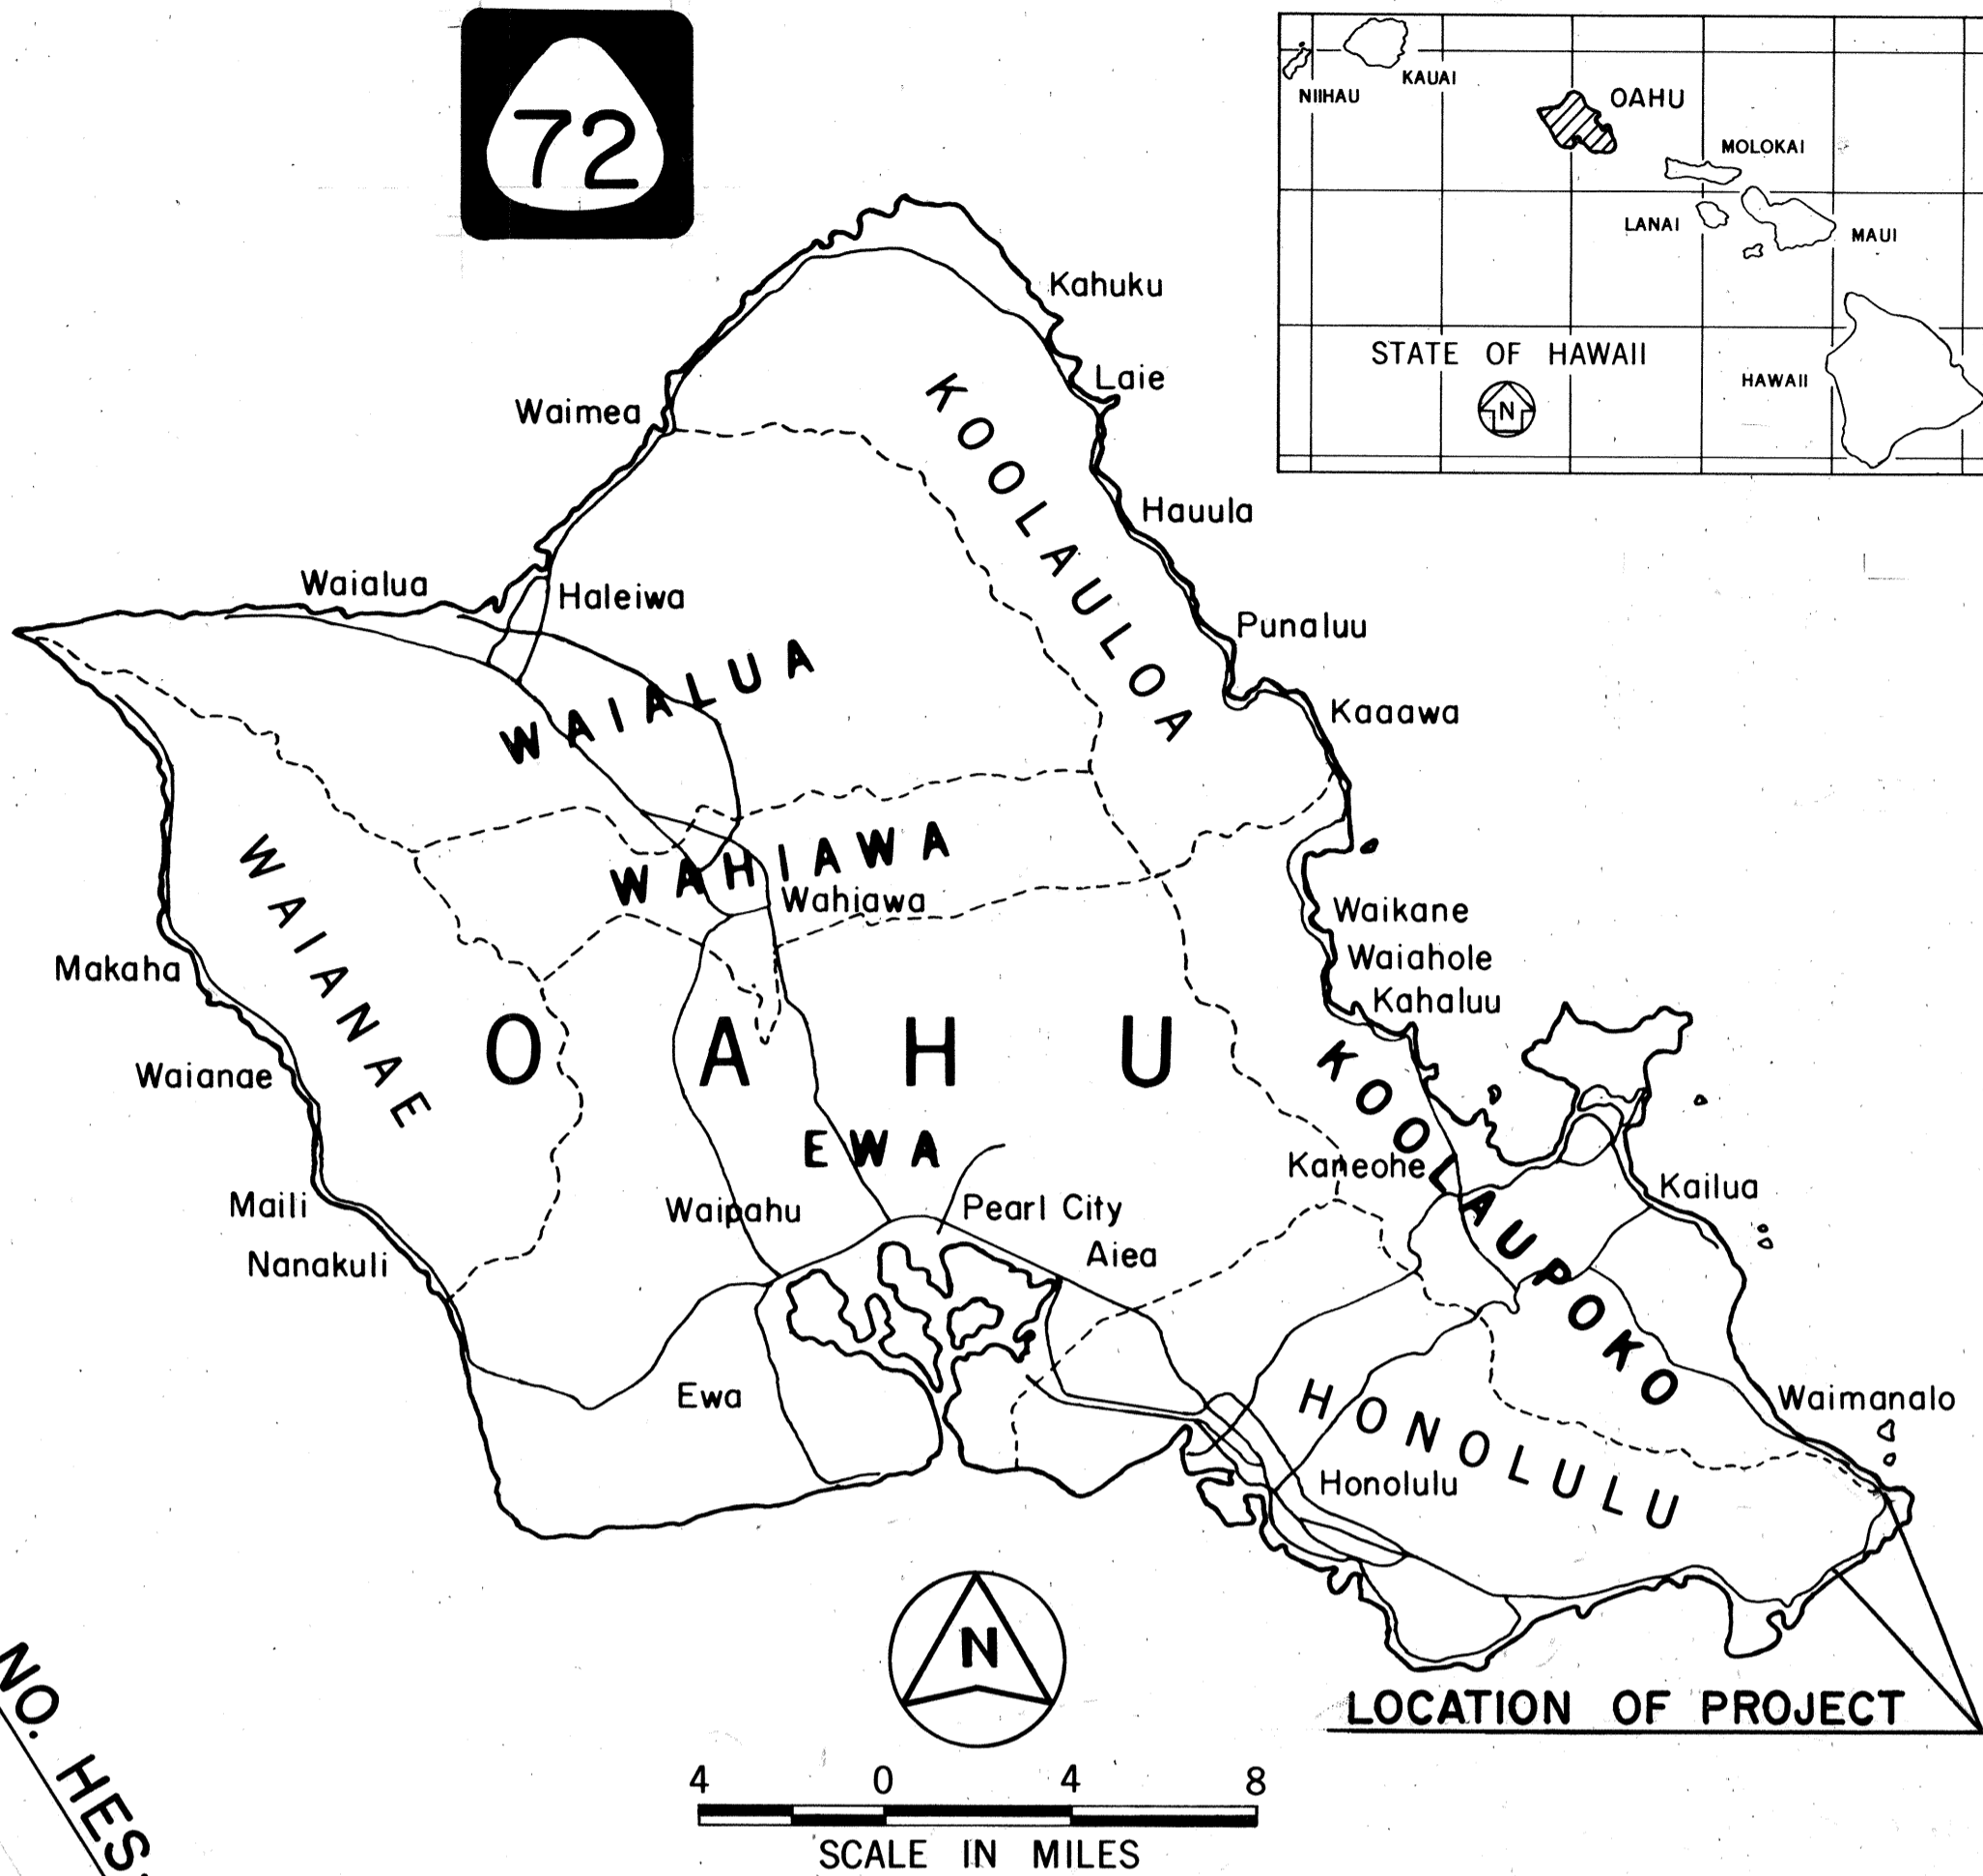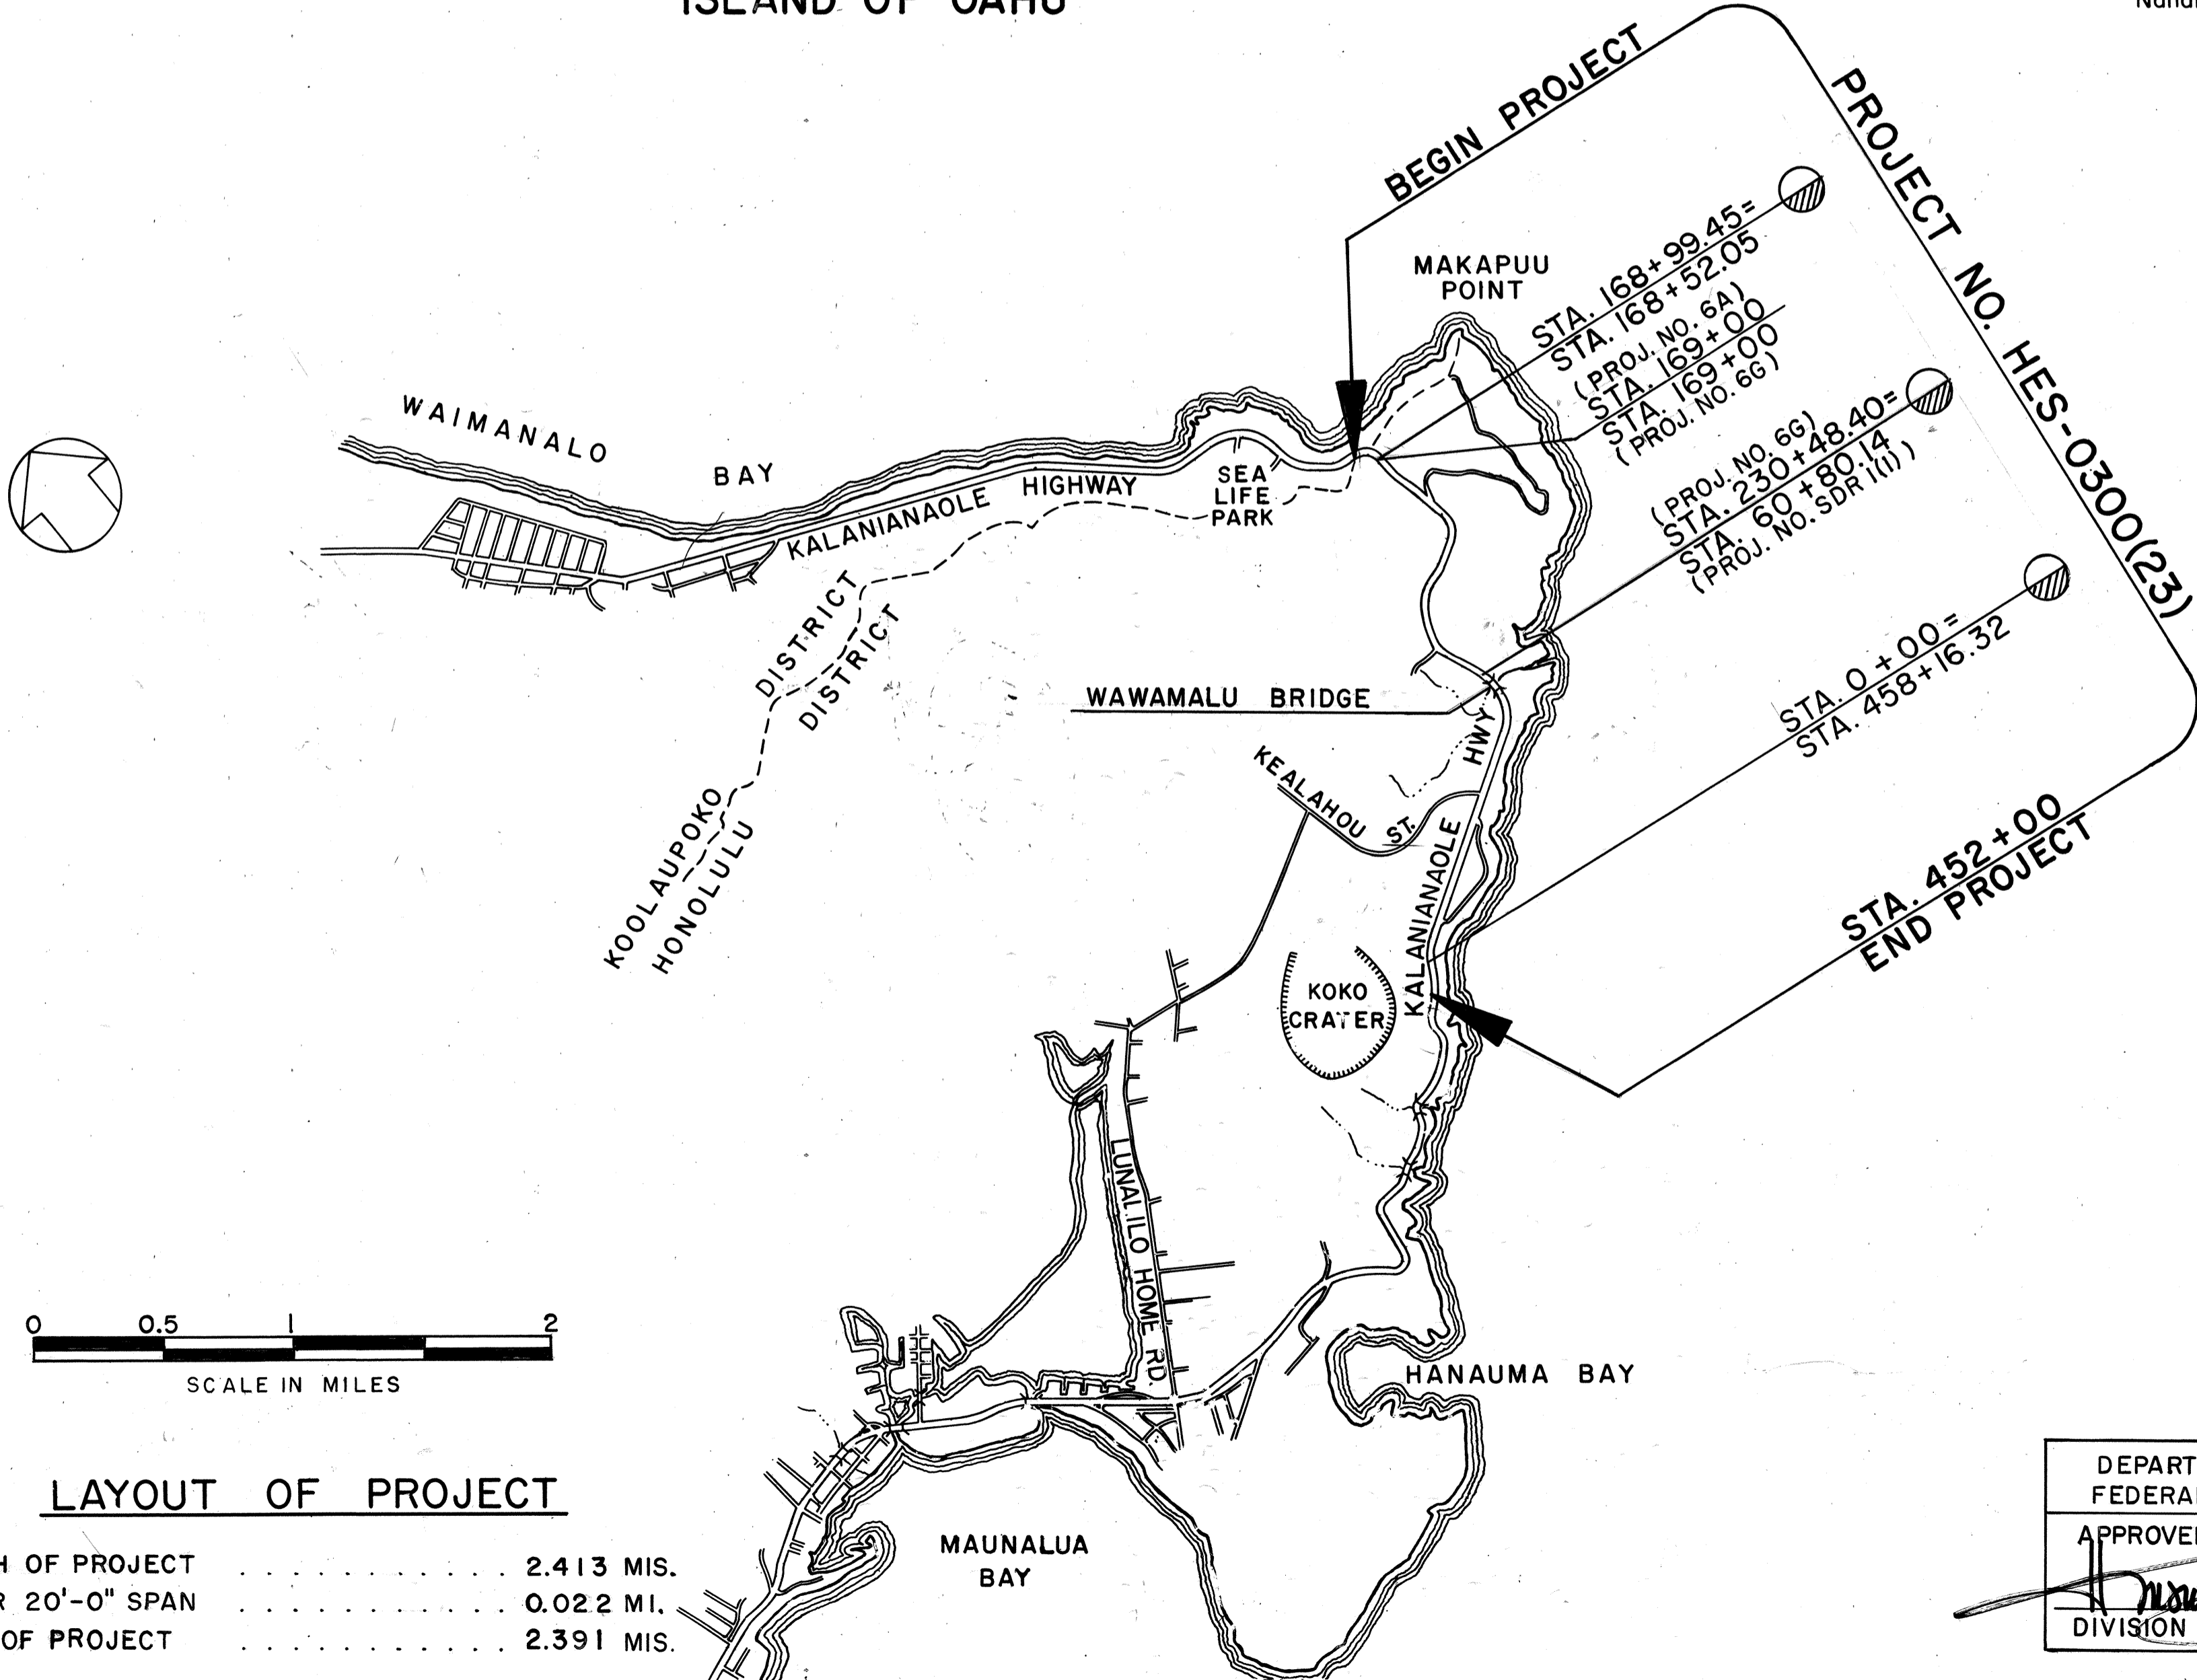

CHANGES MADE DURING CONSTRUCTION HAVE BEEN INCORPORATED ON THESE PLANS EXCEPT CHANGES IN THE ORIGINAL THEORETICAL QUANTITIES. FOR ACTUAL QUANTITIES, REFER TO PROJECT LEDGER AND/OR COMPUTATION BOOK.

Michael D. Amiga *6/9/84*
RESIDENT ENGINEER DATE

DESIGN DESIGNATION

CURRENT ADT (1984)	7,480
DESIGN ADT (2004)	9,900
DHV	940
D	55/45
T ₂₄	5.5%
V	40/50 MPH

DEPARTMENT OF TRANSPORTATION

FEDERAL HIGHWAY ADMINISTRATION

APPROVED:

[Signature] *8/31/84*

DIVISION ADMINISTRATOR DATE

DEPARTMENT OF TRANSPORTATION

STATE OF HAWAII

APPROVED:

[Signature] *8/16/84*

DIR. OF TRANSPORTATION DATE

ALLAN NISHIMURA

DESIGNED BY

ALLAN NISHIMURA

P. S. & E. BY

548-7490

PHONE

AUG. 1984

DATE