


FED. ROAD DIST. NO.	STATE	PROJ. NO.	FISCAL YEAR	SHEET NO.	TOTAL SHEETS
HAWAII	HAW.	HE5-072-1(32)	1985	5	18

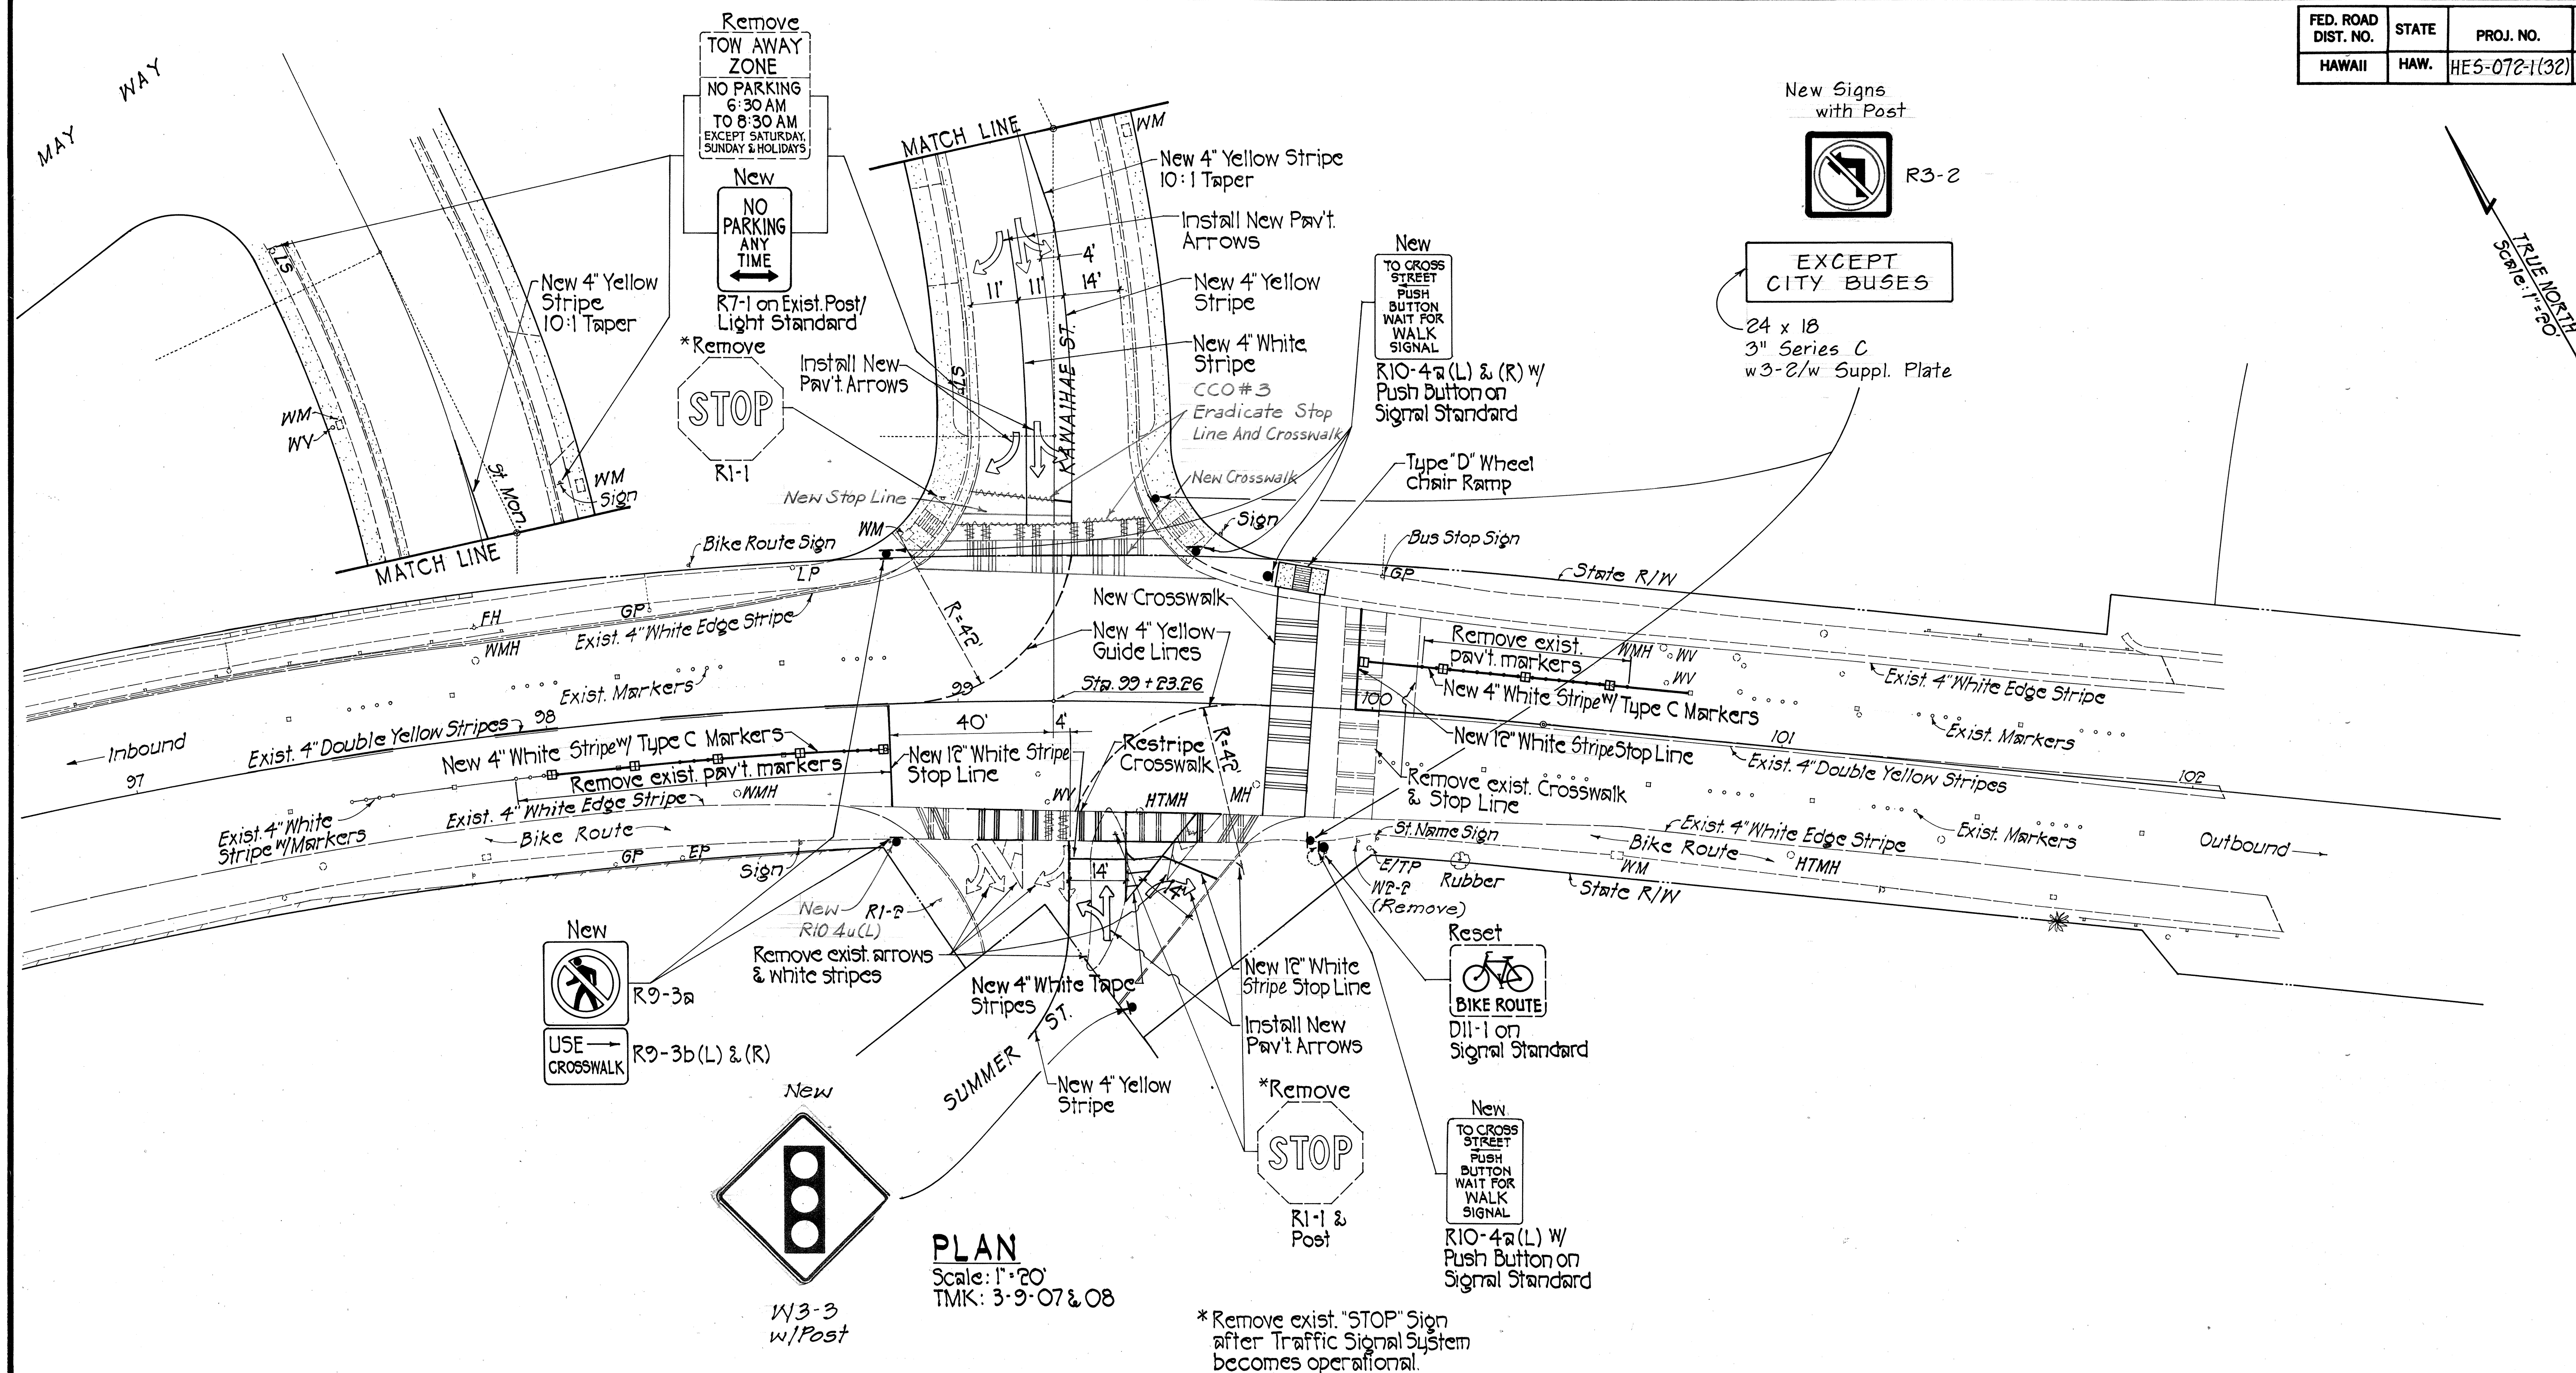


ORIGINAL PLAN	DATE
SURVEY PLATTED BY	
DRAWN BY	
DESIGNED BY	
QUANTITIES BY	
CHECKED BY	
NO.	

PLAN
Scale: 1"=20'
TMK: 3-9-07 & 08

* Remove exist. "STOP" Sign after Traffic Signal System becomes operational.

APPROVED:

[Signature]
CHIEF, DIVISION OF ENGINEERING, DPW
(APPROVED FOR CONSTRUCTION WITH CITY R/W ONLY) DATE: 4/20/85

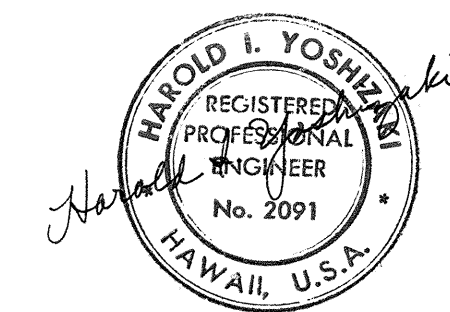

STATE OF HAWAII
DEPARTMENT OF TRANSPORTATION
HIGHWAYS DIVISION

TRAFFIC SIGNALS ON
KALANIANA'OLE HWY. AT KAWAIIHAE ST.

SIGNS & PAVEMENT MARKINGS

PROJECT NO. HE5-072-1(32)
SCALE: 1"=20' DATE: Feb. 25, 1985
SHEET NO. 5 OF 18 SHEETS