




STATE OF HAWAII


DEPARTMENT OF TRANSPORTATION HIGHWAYS DIVISION

HONOLULU, HAWAII
"AS-BUILT"
PLANS FOR

KALANIANAOLE HIGHWAY TRAFFIC SIGNALS AT
KAWAIHAE STREET AND INTERCONNECTION FROM
KULIOUOU ROAD TO KEAHOLE STREET
FEDERAL AID PROJECT NO. HES-072-1(32)

DISTRICT OF HONOLULU ISLAND OF OAHU

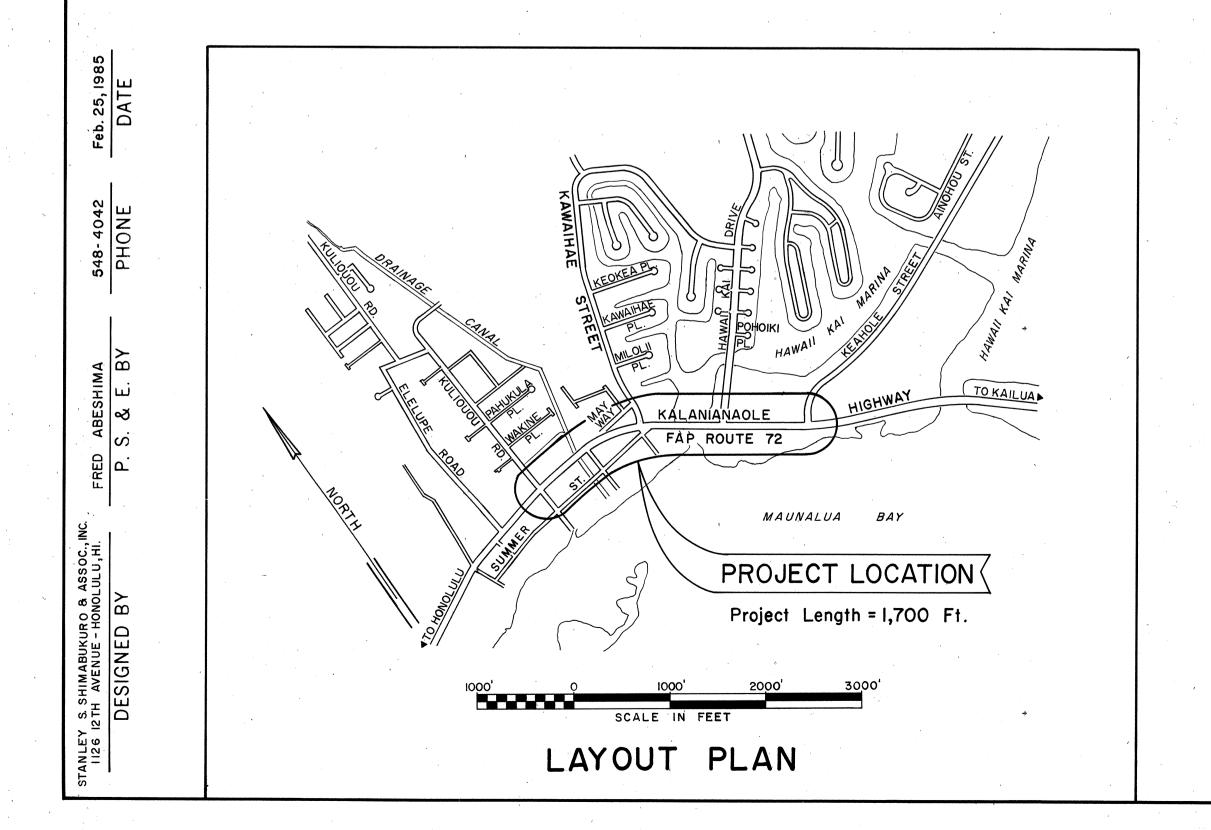

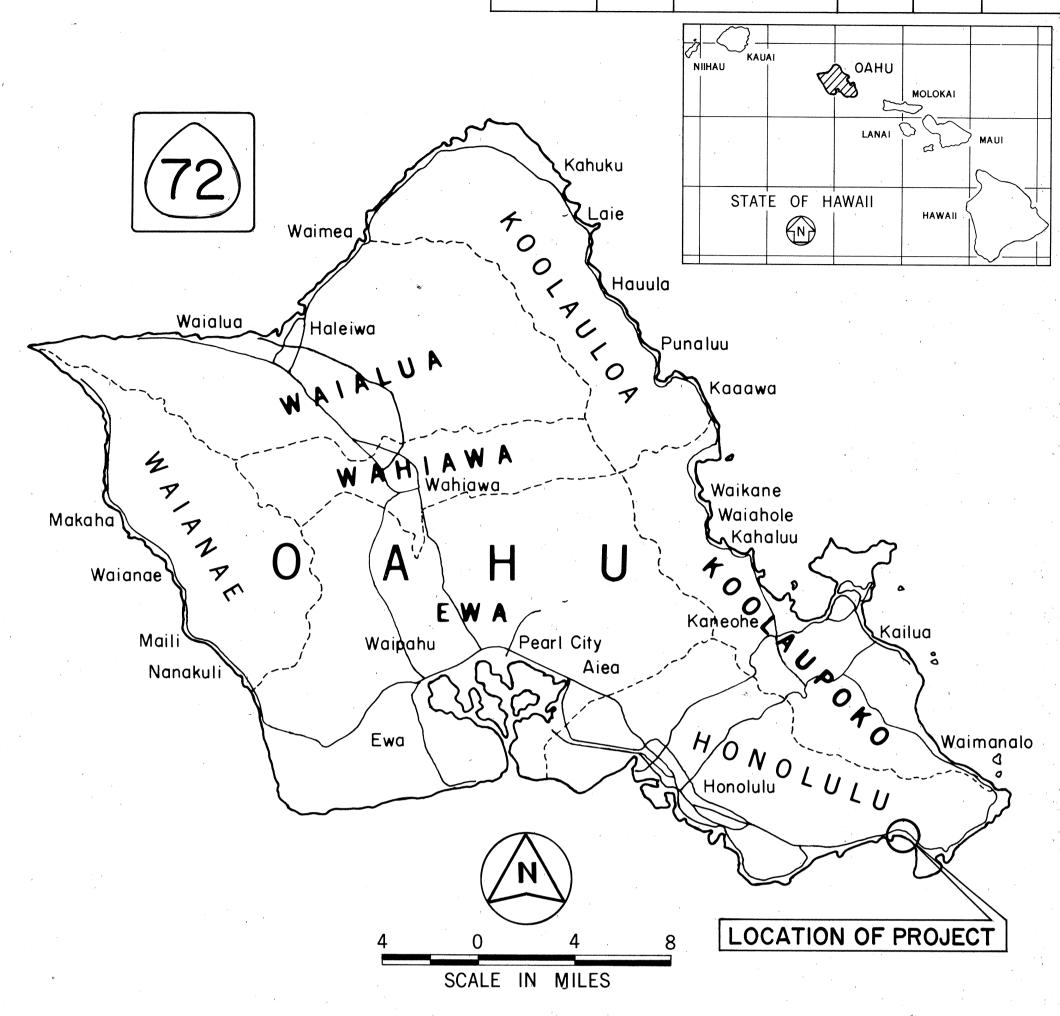

DIST. NO.

CHANGES MADE DURING CONSTRUCTION HAVE NOTED ON THESE PLANS AND CHECKED BY:

RESIDENT ENGINEER DATE

DEPARTMENT OF TRANSPORTATION FEDERAL HIGHWAY ADMINISTRATION

APPROVED:

5/3/85

DIVISION ADMINISTRATOR

DEPARTMENT OF TRANSPORTATION
STATE OF HAWAII

APPROVED:

Check B. Soon 3/25/85

DIR. OF TRANSPORTATION DATE

D-8-8

FISCAL SHEET TOTAL YEAR NO. SHEETS

PROJ. NO.

HE5-072-1(32) 1985