

DON'T WALK
WALK

R
Y
G

A-1*
B-1*
C-4,5
D-2
E-1*

A-2,3
C-1,2,3
D-1,3
E-2,3,4

SIGNAL INDICATIONS

* w/ Pedestrian Push Button


Relocate Per
Masatani Of
C+C Traffic

Deleted; Relocate at
Opposite Of Street

4-8'x6' Loop
Detectors
S/N 482-12427
3/4" Mtr.


4-Controller Barriers
Controller w/ Coordinator
8' Std. Type I

PHASE DIAGRAM

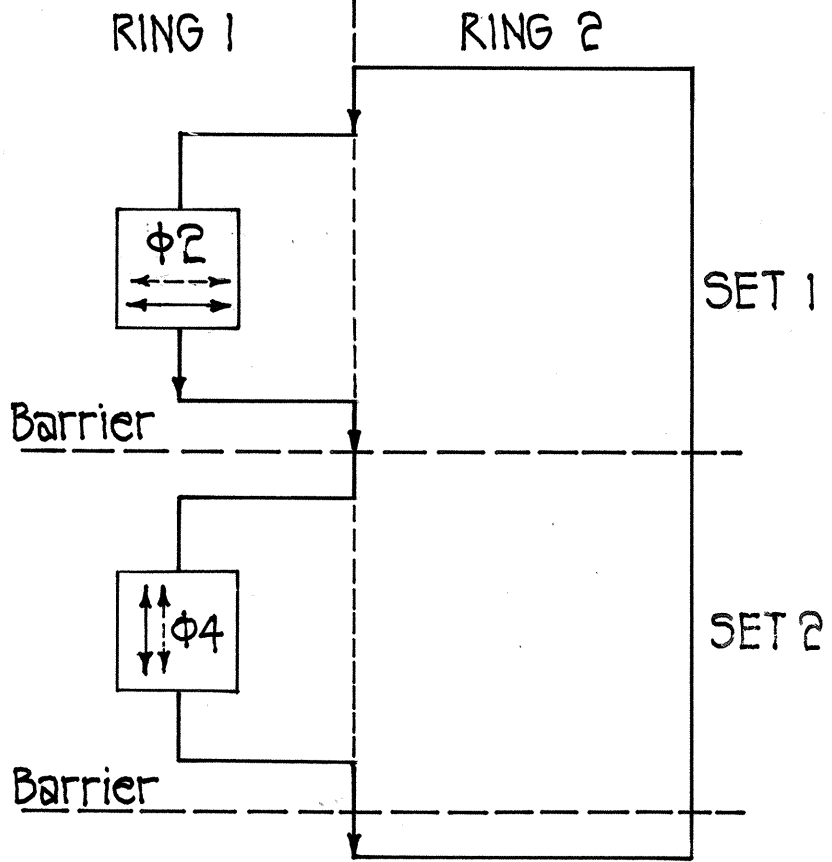

FED. ROAD DIST. NO.	STATE	PROJ. NO.	FISCAL YEAR	SHEET NO.	TOTAL SHEETS
HAWAII	HAW.	HES-072-1(32)	1985	3	18

TRUE NORTH
Scale: 1"=20'

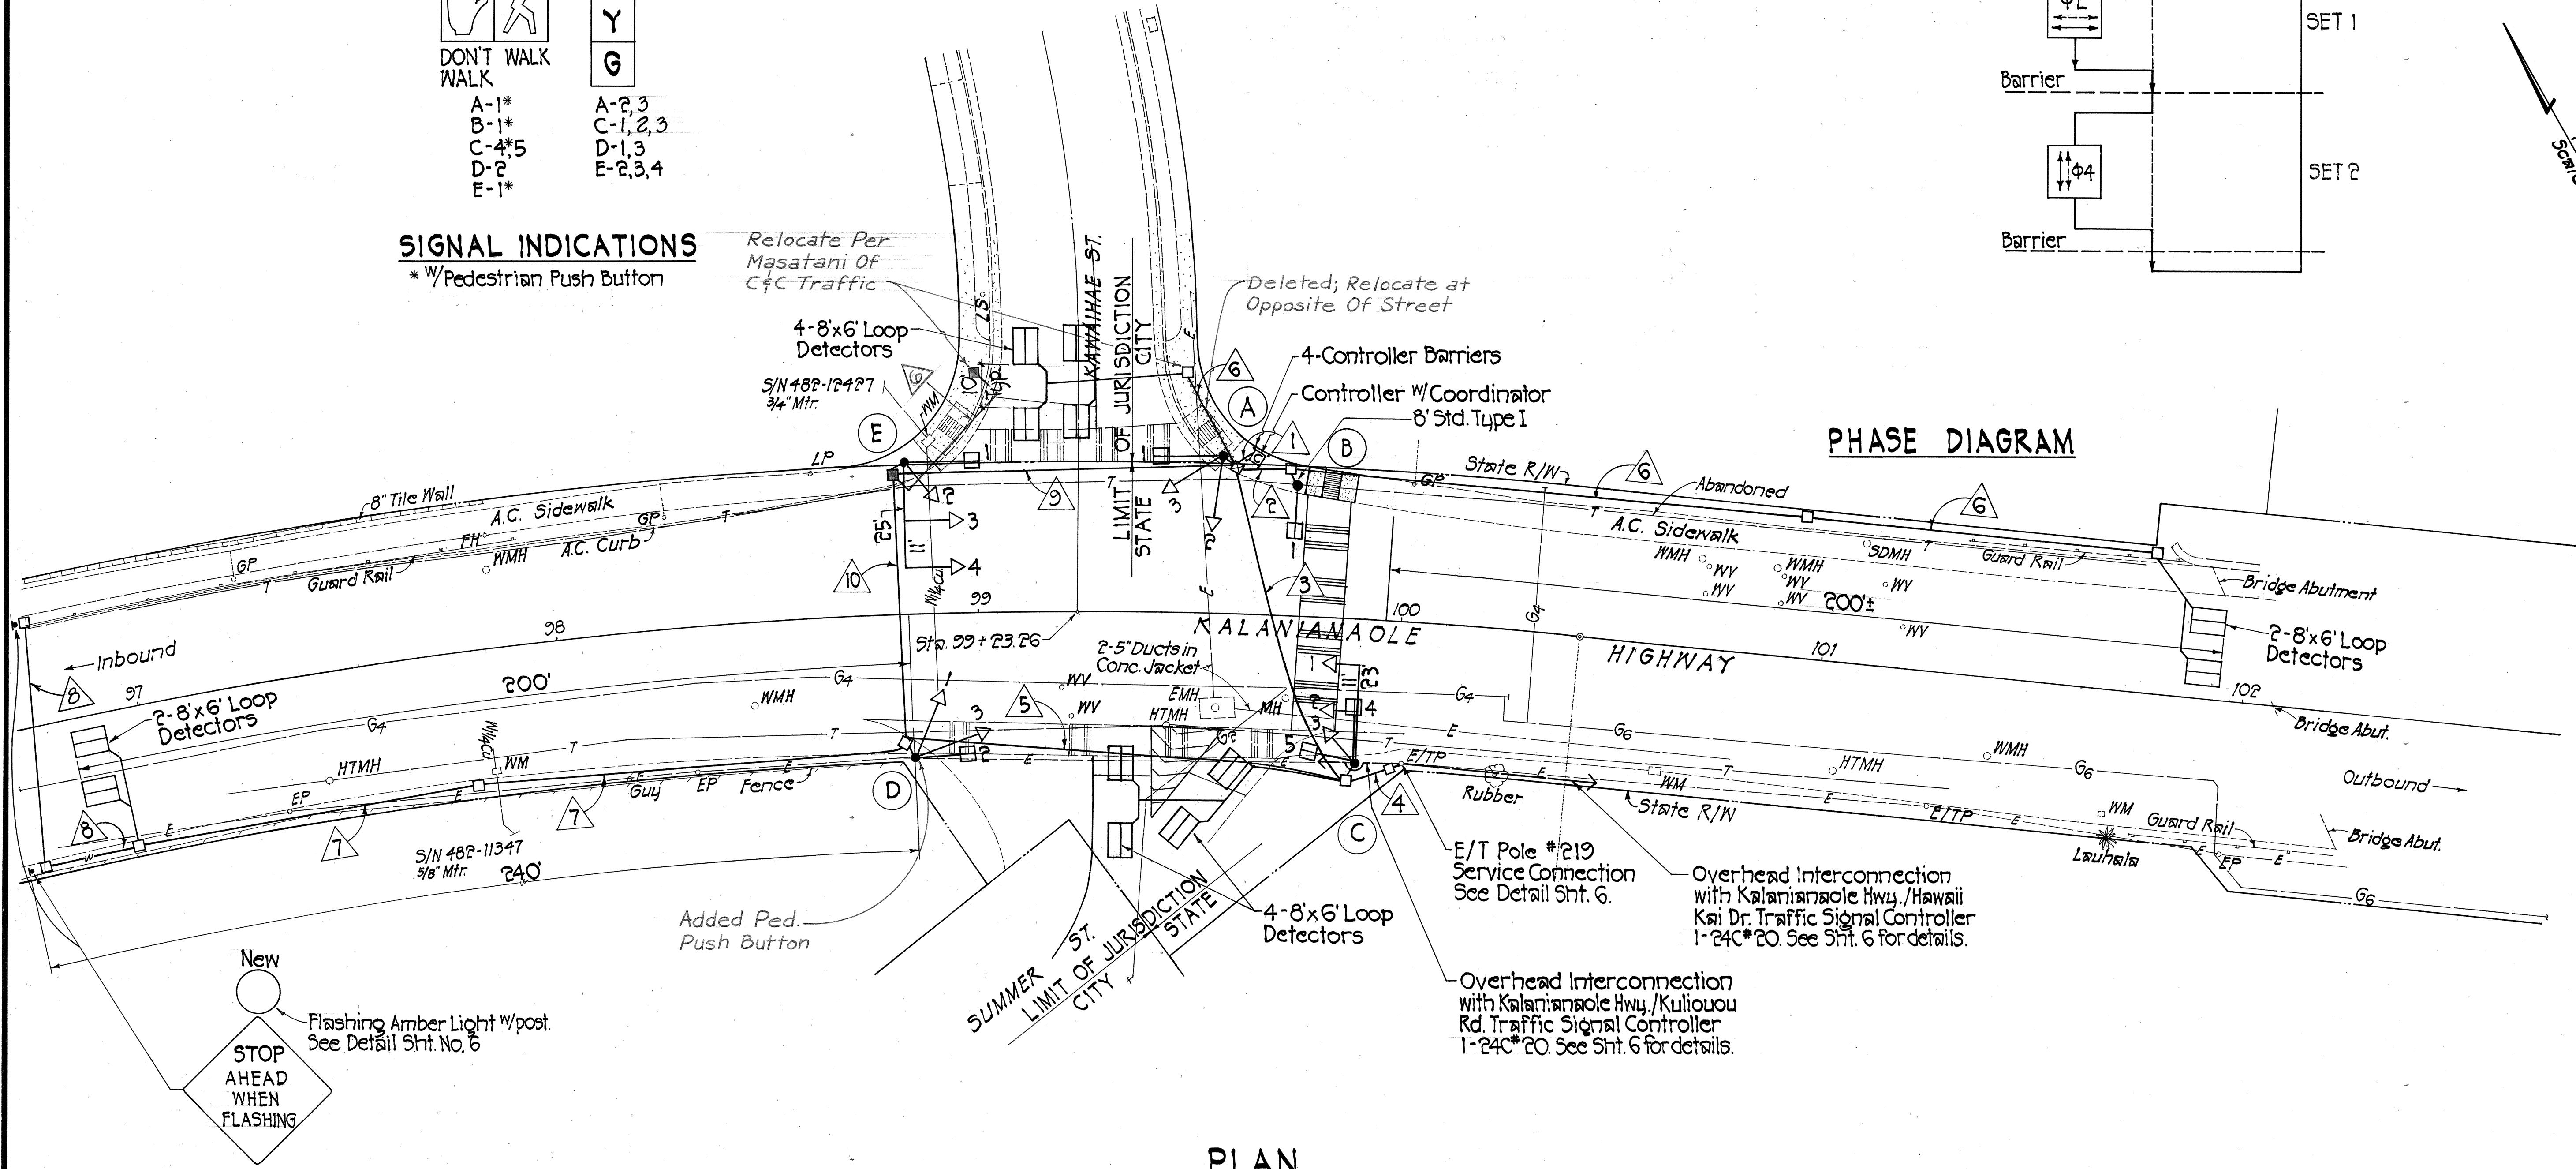

New

Flashing Amber Light w/post.
See Detail Sht. No. 6

STOP
AHEAD
WHEN
FLASHING

W3-4

PLAN

Scale: 1"=20'
TMK: 3-9-07 & 08


CONDUIT & CABLE SCHEDULE

△	CONDUIT	CABLE
1	5-2" Sch. 80	1-3C #8, 2-26C #14, 1-24C #20, 6-2C #14, 1-3C #12
2	2-2" Sch. 80	1-26C #14, 2-2C #14
3	4-2" Sch. 80	1-3C #8, 1-26C #14, 1-24C #20, 2-2C #14
4	2-2" Sch. 80	1-3C #8, 1-24C #20
5	1-2" Sch. 80	1-26C #14
6	1-2" Sch. 80	1-2C #14
7	2-2" Sch. 80	1-3C #12, 1-2C #14
8	1-2" Sch. 80	1-3C #12
9	3-2" Sch. 80	1-26C #14, 2-2C #14, 1-3C #12
10	3-2" Sch. 80	1-26C #14, 1-2C #14, 1-3C #12

APPROVED:

CHIEF, DIVISION OF ENGINEERING, DPW
(APPROVED FOR CONSTRUCTION W/IN CITY R/W ONLY)

CHIEF, PLANNING & ENGINEERING, BWS

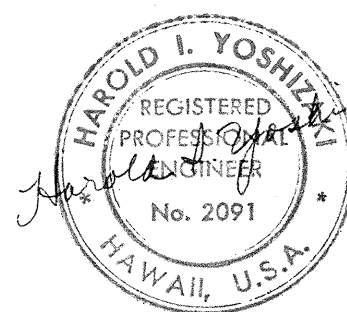

STATE OF HAWAII
DEPARTMENT OF TRANSPORTATION
HIGHWAYS DIVISION

TRAFFIC SIGNALS ON
KALANIANA'OLE HWY. AT KAWAIIHAE ST.

PLAN-TRAFFIC SIGNAL SYSTEM

PROJECT NO. HES-072-1(32)
SCALE: 1"=20' DATE: Feb. 25, 1985
SHEET NO. 3 OF 18 SHEETS