



FED. ROAD DIST. NO.	STATE	PROJ. NO.	FISCAL YEAR	SHEET NO.	TOTAL SHEETS
HAWAII	HAW.	72C-01-86	1986	4	18

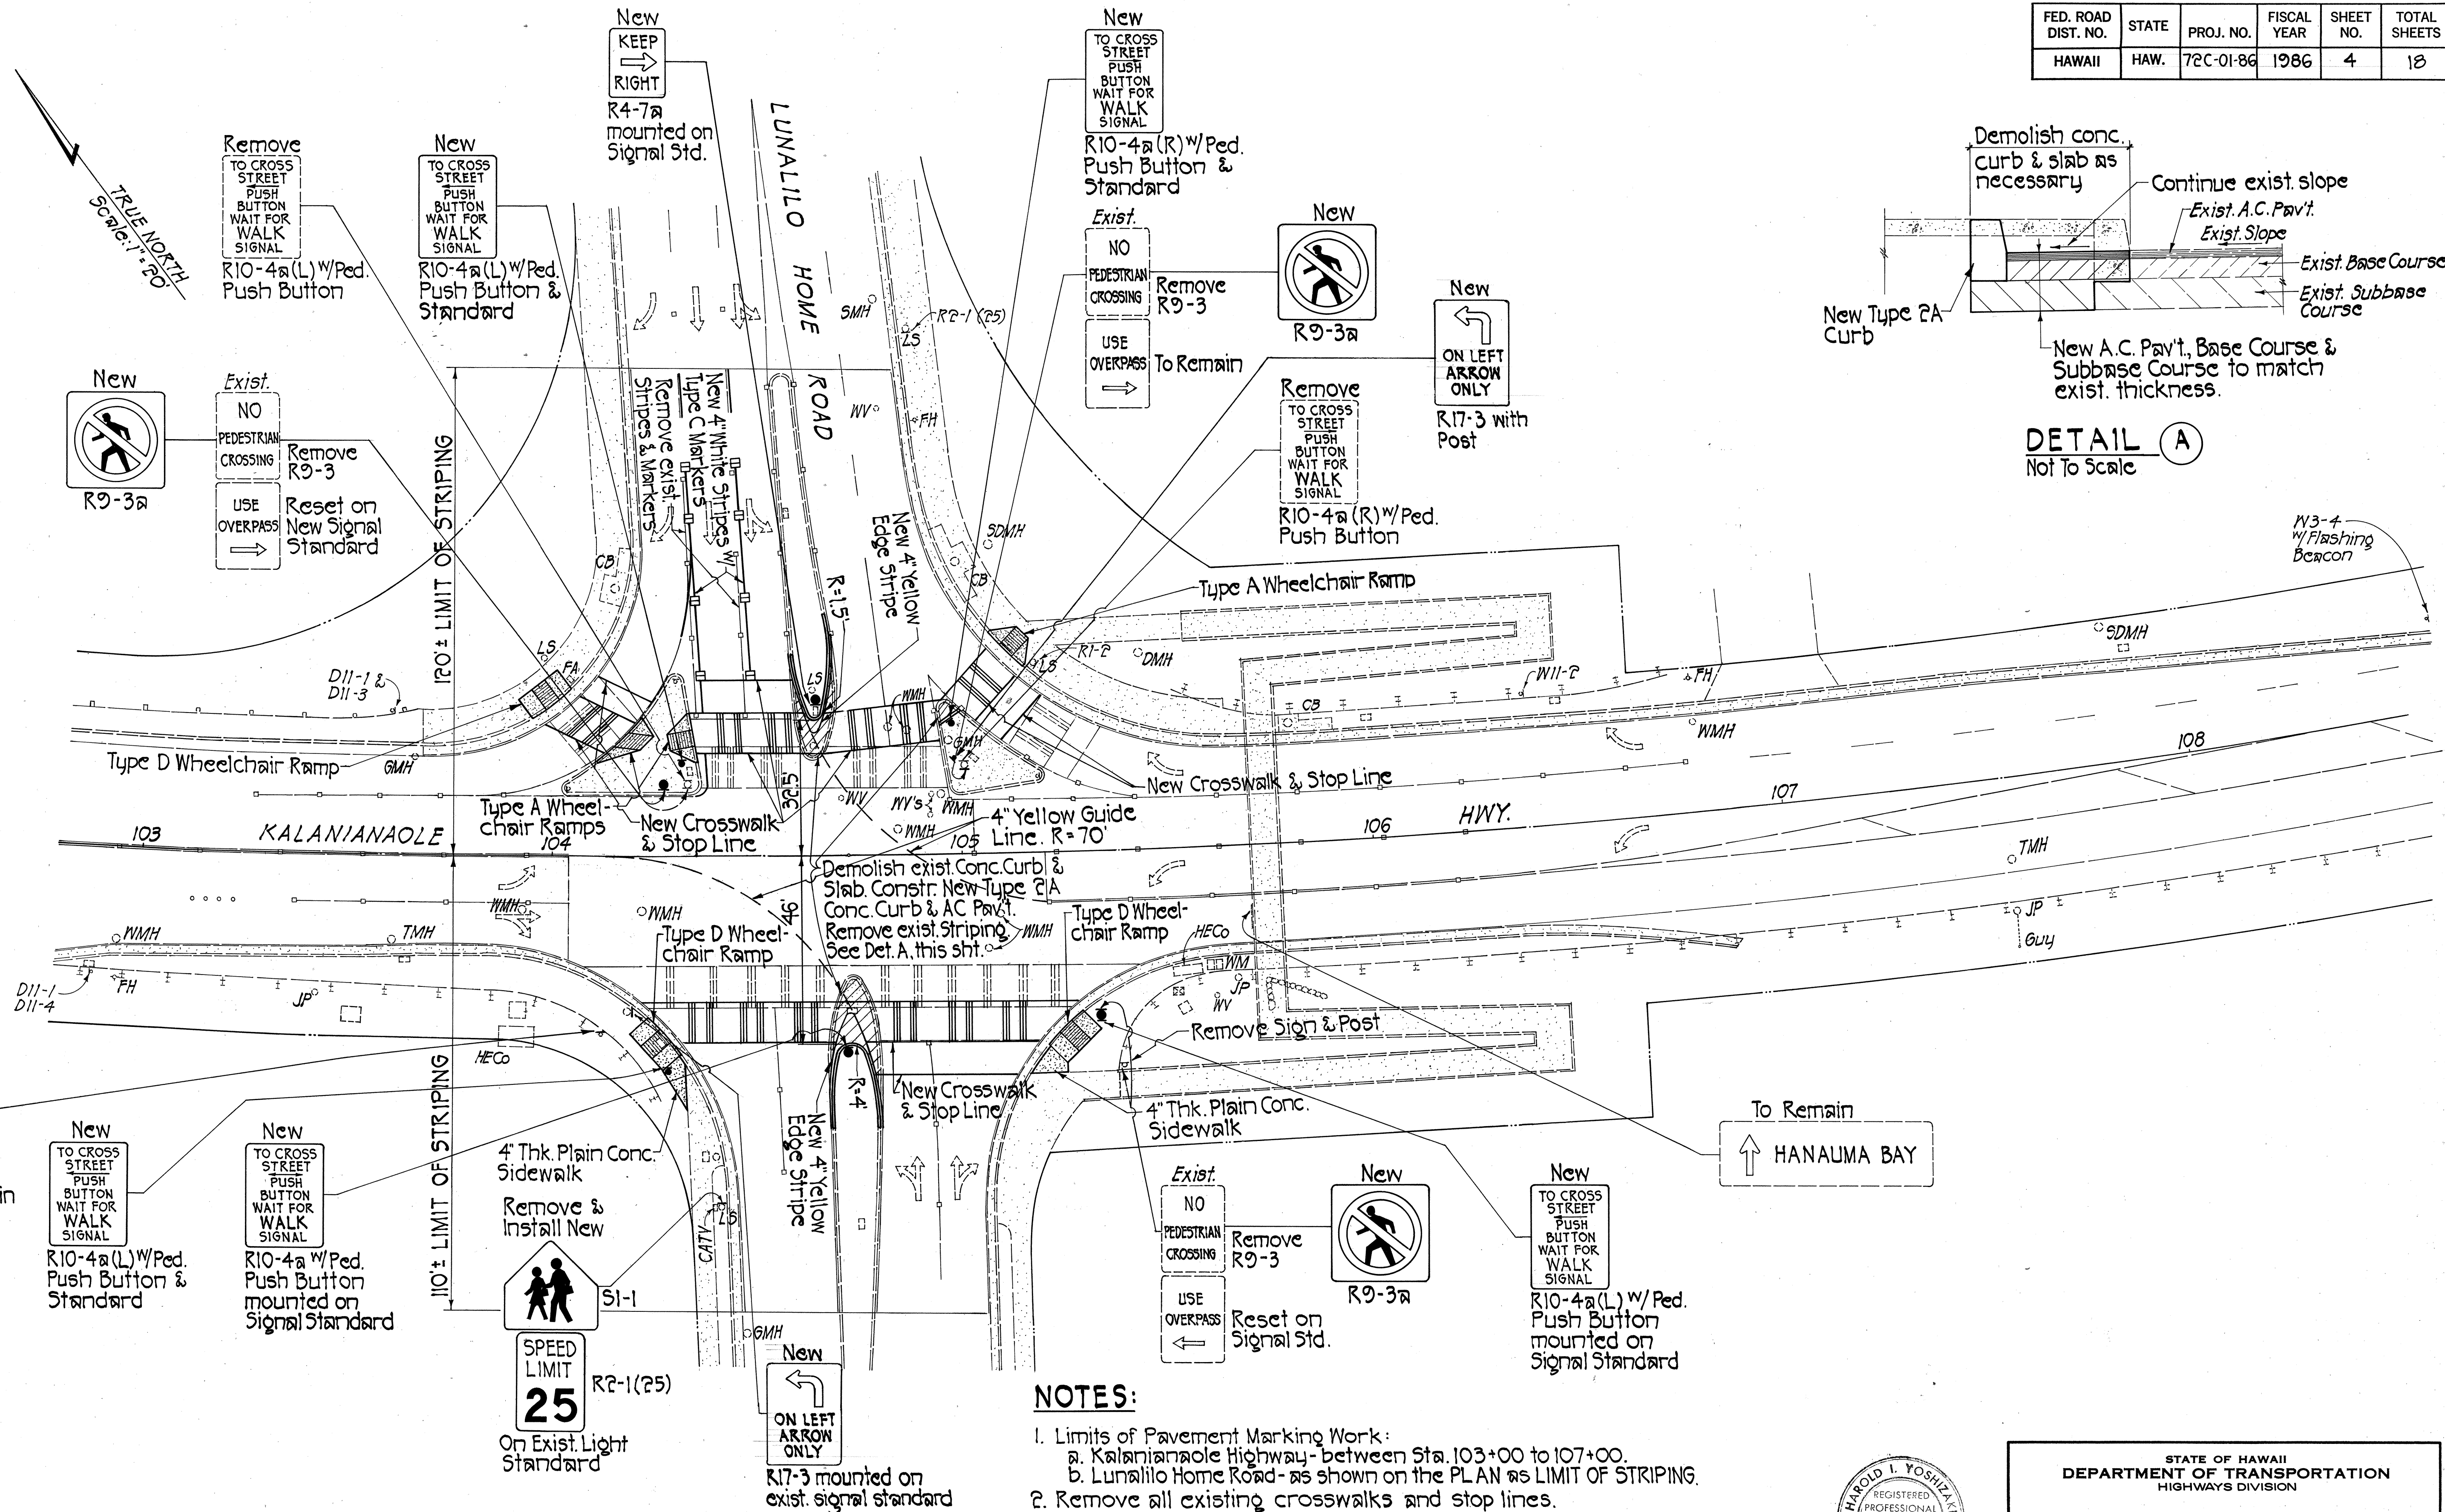

NOTES:

- Limits of Pavement Marking Work:
 - Kalanianaʻole Highway - between Sta. 103+00 to 107+00.
 - Lunalilo Home Road - as shown on the PLAN as LIMIT OF STRIPING.
- Remove all existing crosswalks and stop lines.
- New Striping & Restriping shall be as follows:
 - Paint - white & yellow edge stripe
 - Tape - yellow center & guide lines, stop lines, lane lines, crosswalks & pavement directional arrows.
- Install new pavement markers where markers are missing or damaged with the proper type markers.

PLAN
Scale: 1"=20'

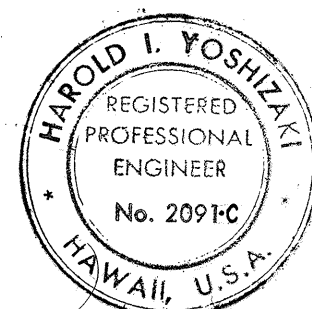

THIS WORK WAS PREPARED BY
ME OR UNDER MY SUPERVISION.
Harold I. Yoshizaki

STATE OF HAWAII
DEPARTMENT OF TRANSPORTATION
HIGHWAYS DIVISION
KALANIANAʻOLE HWY. AT LUNALILO HOME RD.
IMPROVEMENTS TO EXISTING TRAFFIC SIGNALS
SIGNS, PAVEMENT MARKINGS & WHEELCHAIR RAMPS
PROJECT NO. 72C-01-86
SCALE: 1"=20' MAR. 12, 1986
SHEET No. 1 OF 4 SHEETS

DATE	_____
SURVEY PLATTED BY	_____
DRAWN BY	_____
DESIGNED BY	_____
CHECKED BY	_____
ORIGINAL PLAN	_____
NOTE BOOK	_____
QUANTITIES BY	_____
CHECKED BY	_____