


HONOLULU, HAWAII

"AS-BUILT"

PLANS FOR
KALANIANA'OLE HIGHWAY AT LUNALILO HOME ROAD
IMPROVEMENTS TO EXISTING TRAFFIC SIGNALS
PROJECT NO. 72C-01-86


DISTRICT OF HONOLULU
ISLAND OF OAHU

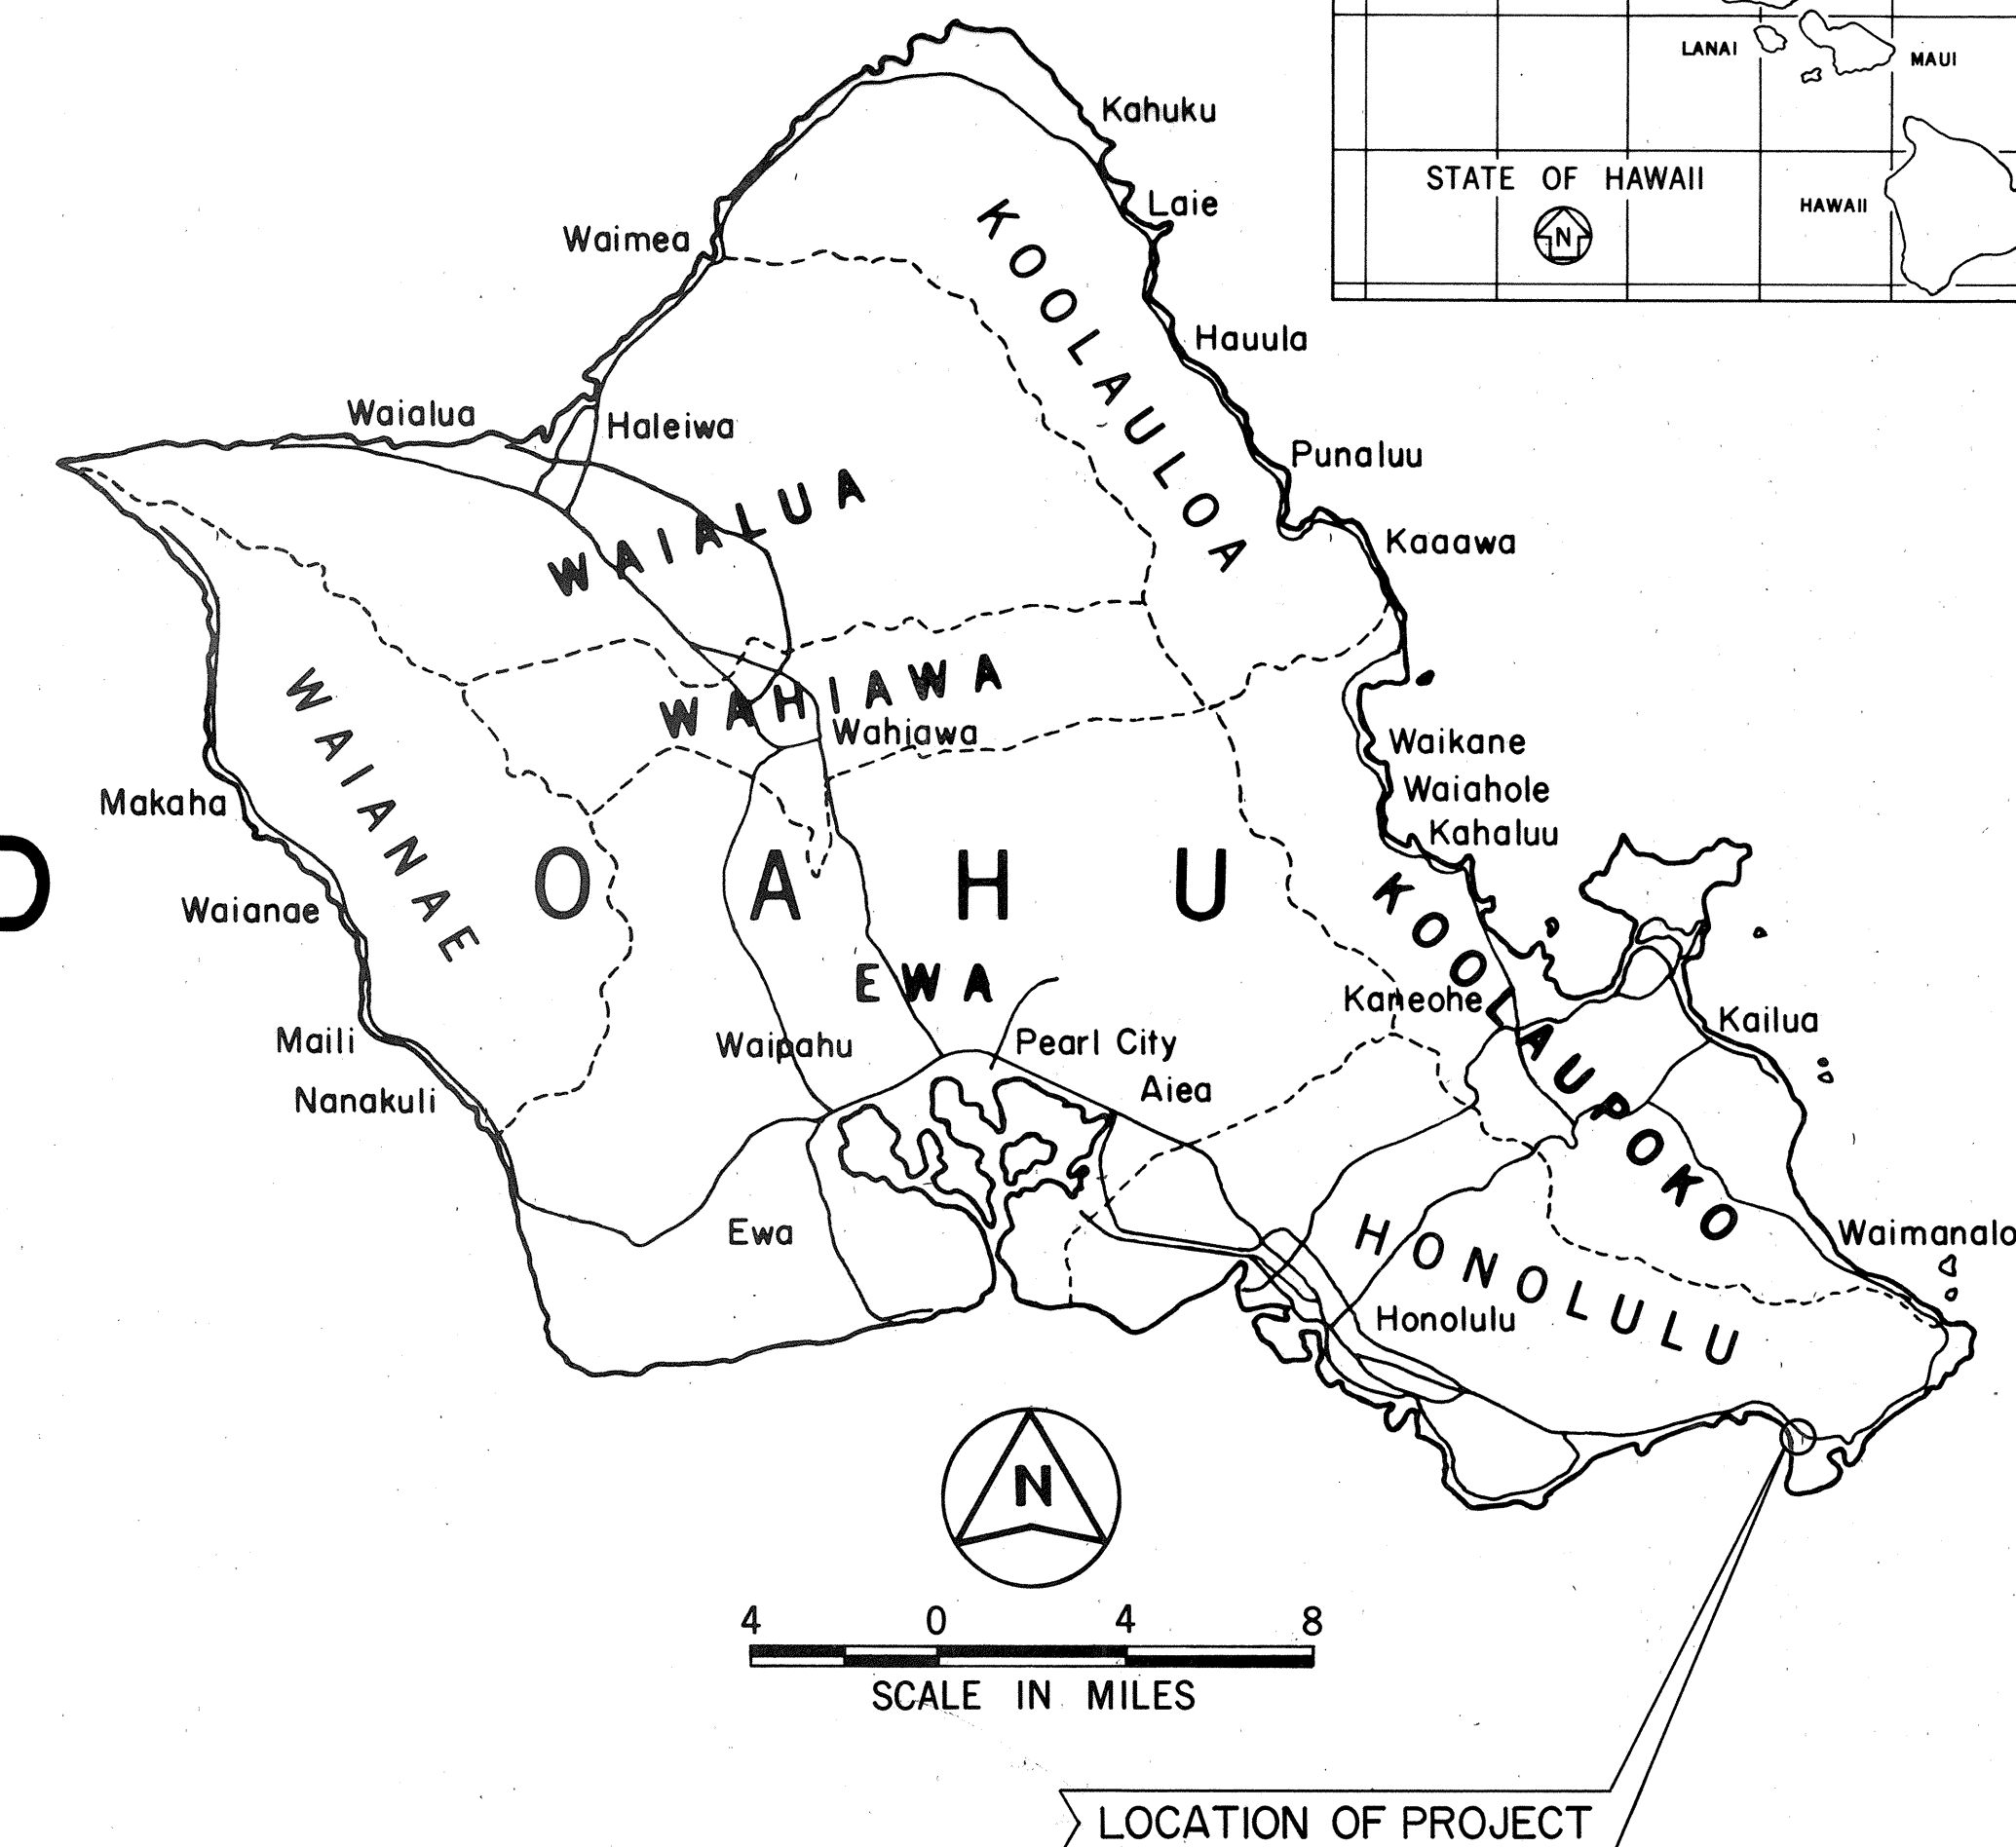

NO SIGNIFICANT CHANGES WERE MADE DURING CONSTRUCTION ON THESE PLANS EXCEPT CHANGES IN THE ORIGINAL THEORETICAL QUANTITIES. FOR ACTUAL QUANTITIES, REFER TO PROJECT LEDGER AND/OR COMPUTATION BOOK.

Virginia P. Gangel
RESIDENT ENGINEER

8/31/88
DATE

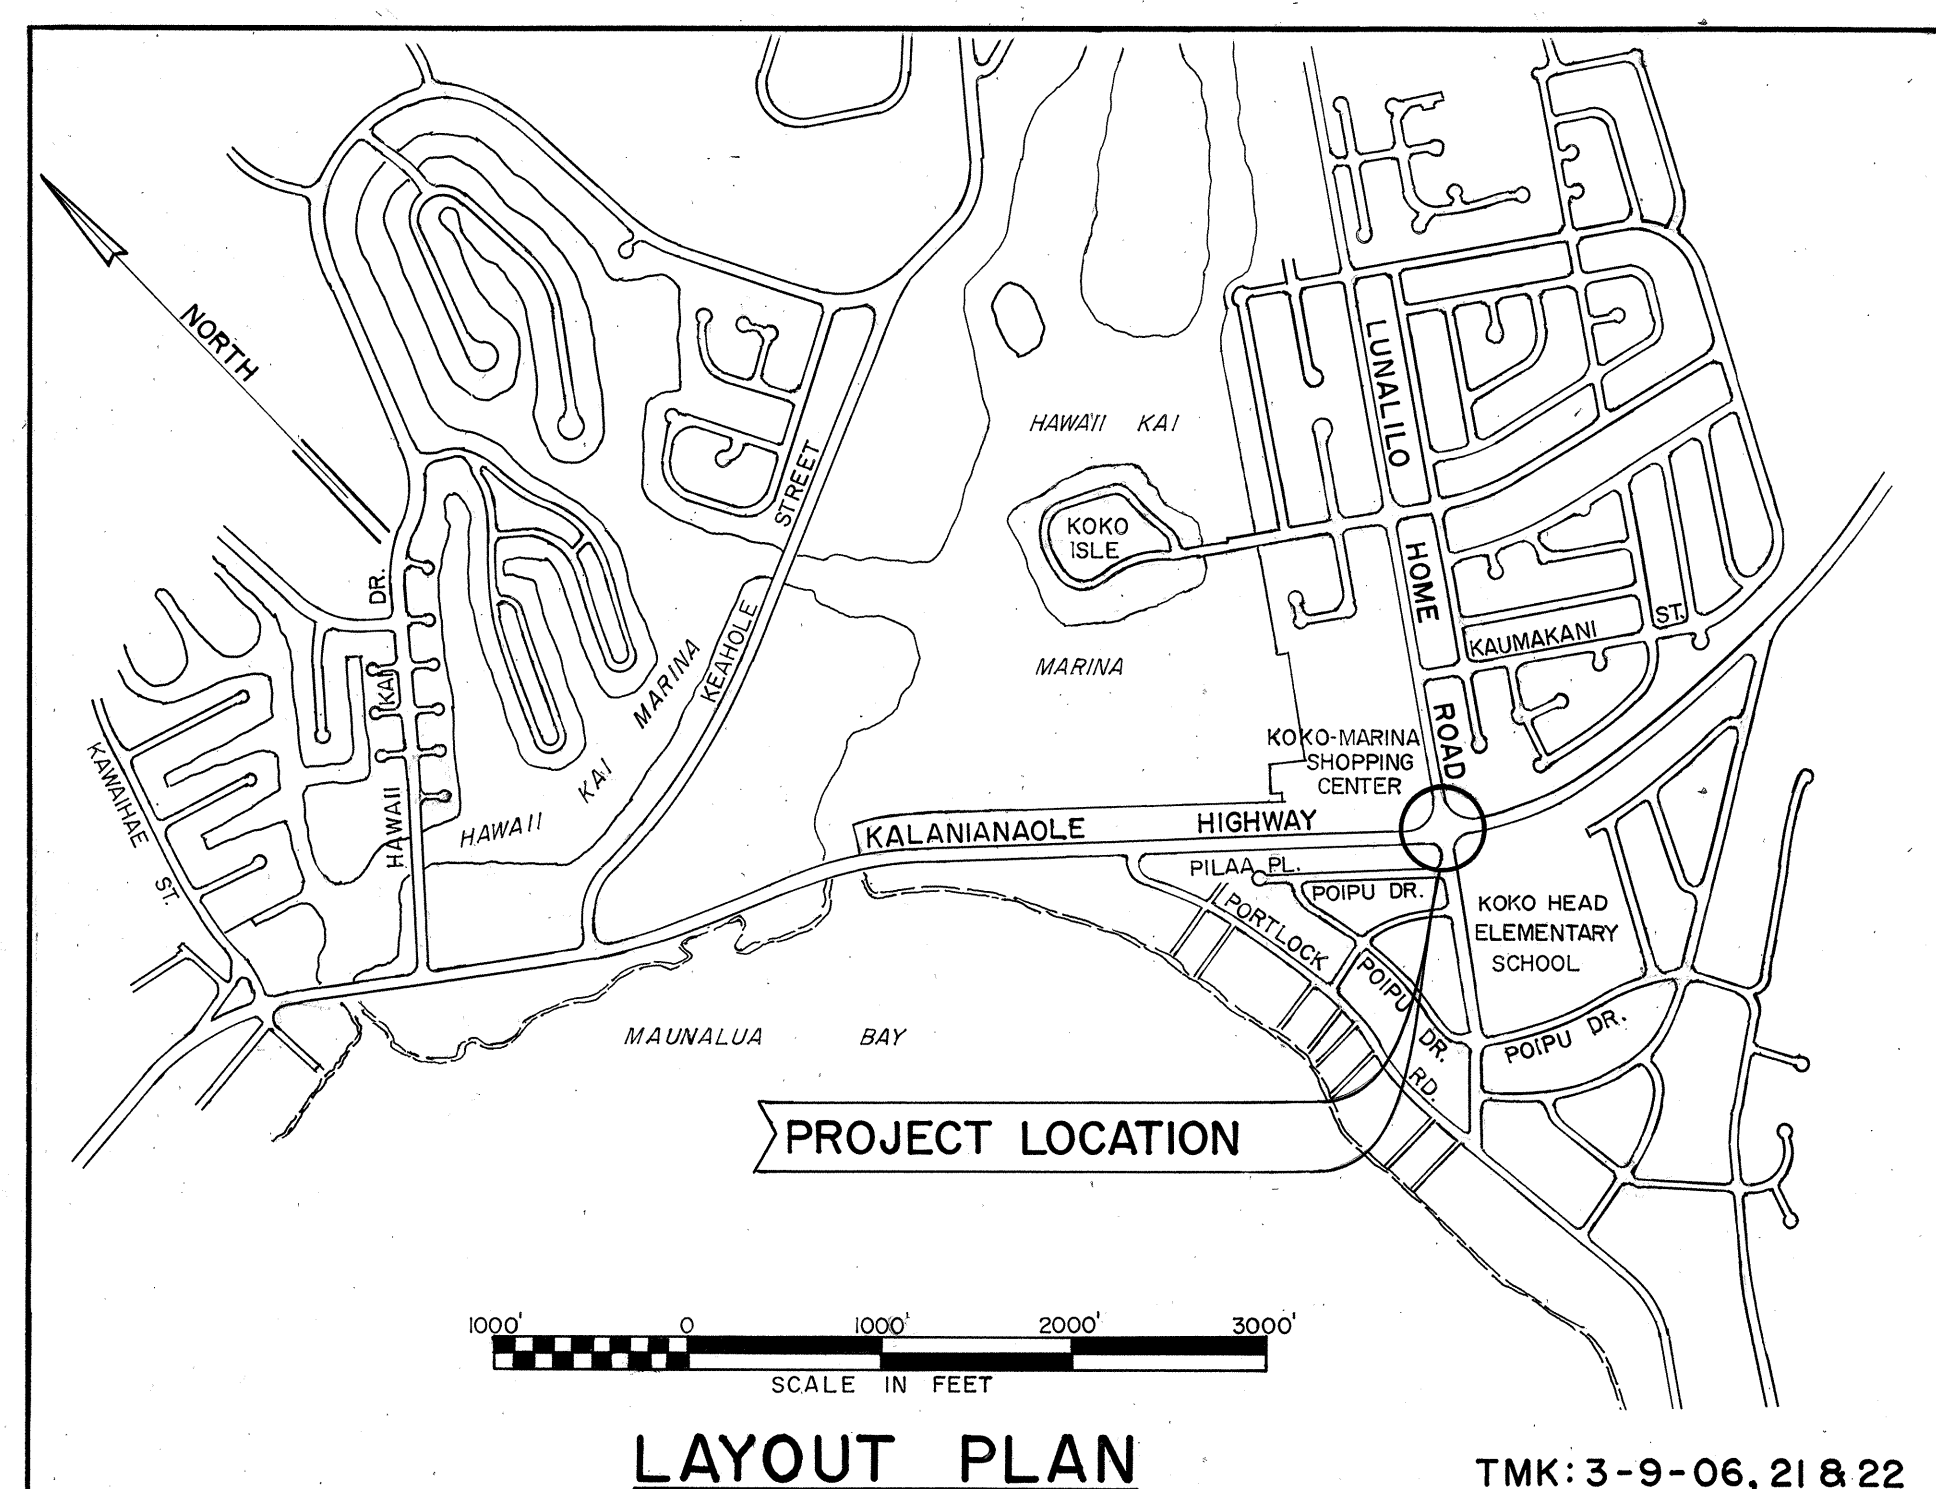

TMK: 3-9-06, 21 & 22

STANLEY S. SHIMABUKURO & ASSOC., INC.
1126 12TH AVENUE - HONOLULU, HI

DESIGNED BY

FRED ABESHIMA

548-4042

PHONE

DATE

MARCH 12, 1986

DEPARTMENT OF TRANSPORTATION STATE OF HAWAII	
APPROVED:	
<i>Carol D. Rom</i>	<i>4/22/88</i>
<u>DIR. OF TRANSPORTATION</u>	<u>DAT</u>