x		
	INDEX TO DRAWINGS	
SHEET NO.	DESCRIPTION	
. 1	TITLE SHEET	
2	NOTES AND LEGEND	
3	TRAFFIC SIGNAL SYSTEM	
4	KALANIANAOLE HWY. TRAFFIC SIGNAL	
	INTERCONNECTION-W.HIND TO E.HIND DRIVES	
5	SIGNS AND PAVEMENT MARKINGS	
6	MISCELLANEOUS DETAILS	
7-14	STANDARD DETAILS	
•		

STATE OF HAWAII

DEPARTMENT OF TRANSPORTATION HIGHWAYS DIVISION

HONOLULU, HAWAII


"AS-BUILT"


PLANS FOR

KALANIANAOLE HIGHWAY TRAFFIC SIGNALS
AT

NENUE STREET
PROJECT NO. 72C-01-83

DISTRICT OF HONOLULU ISLAND OF OAHU

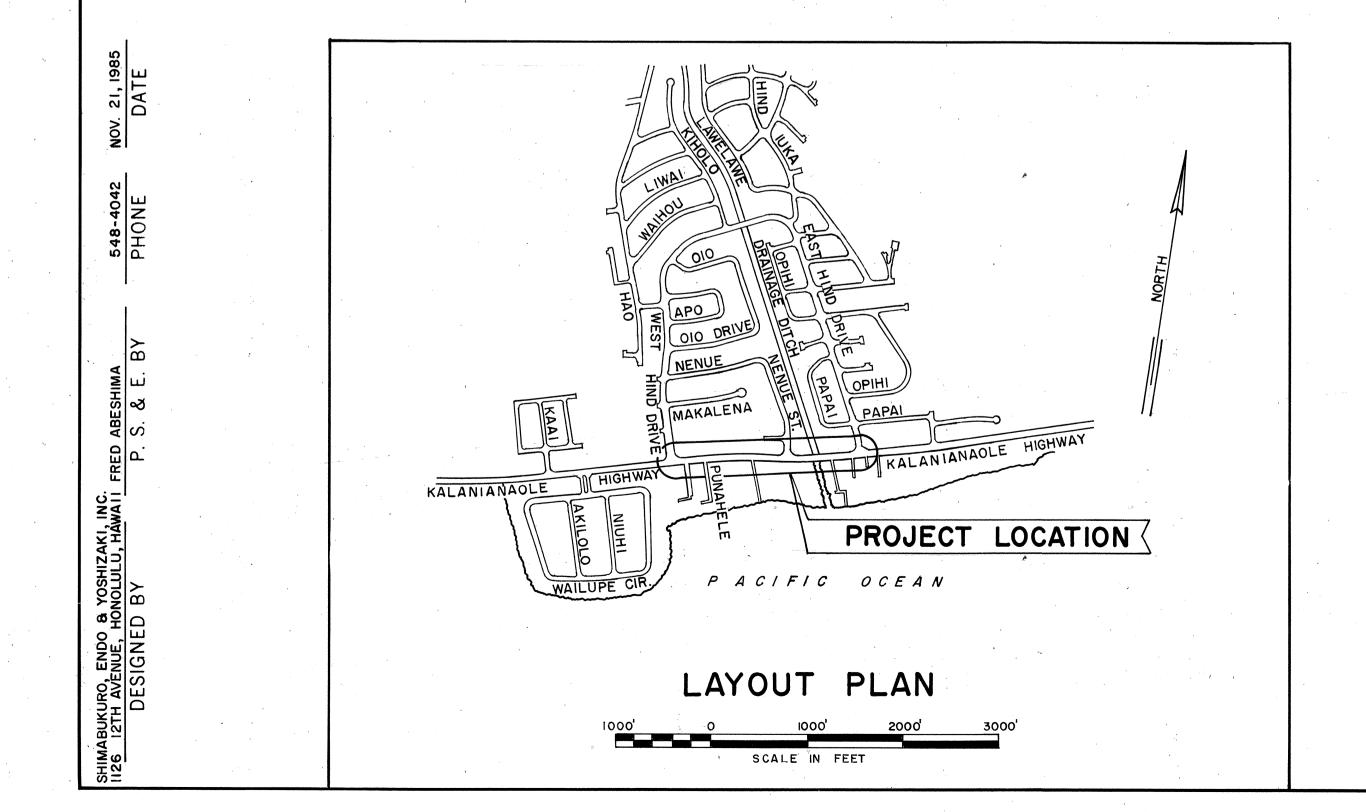

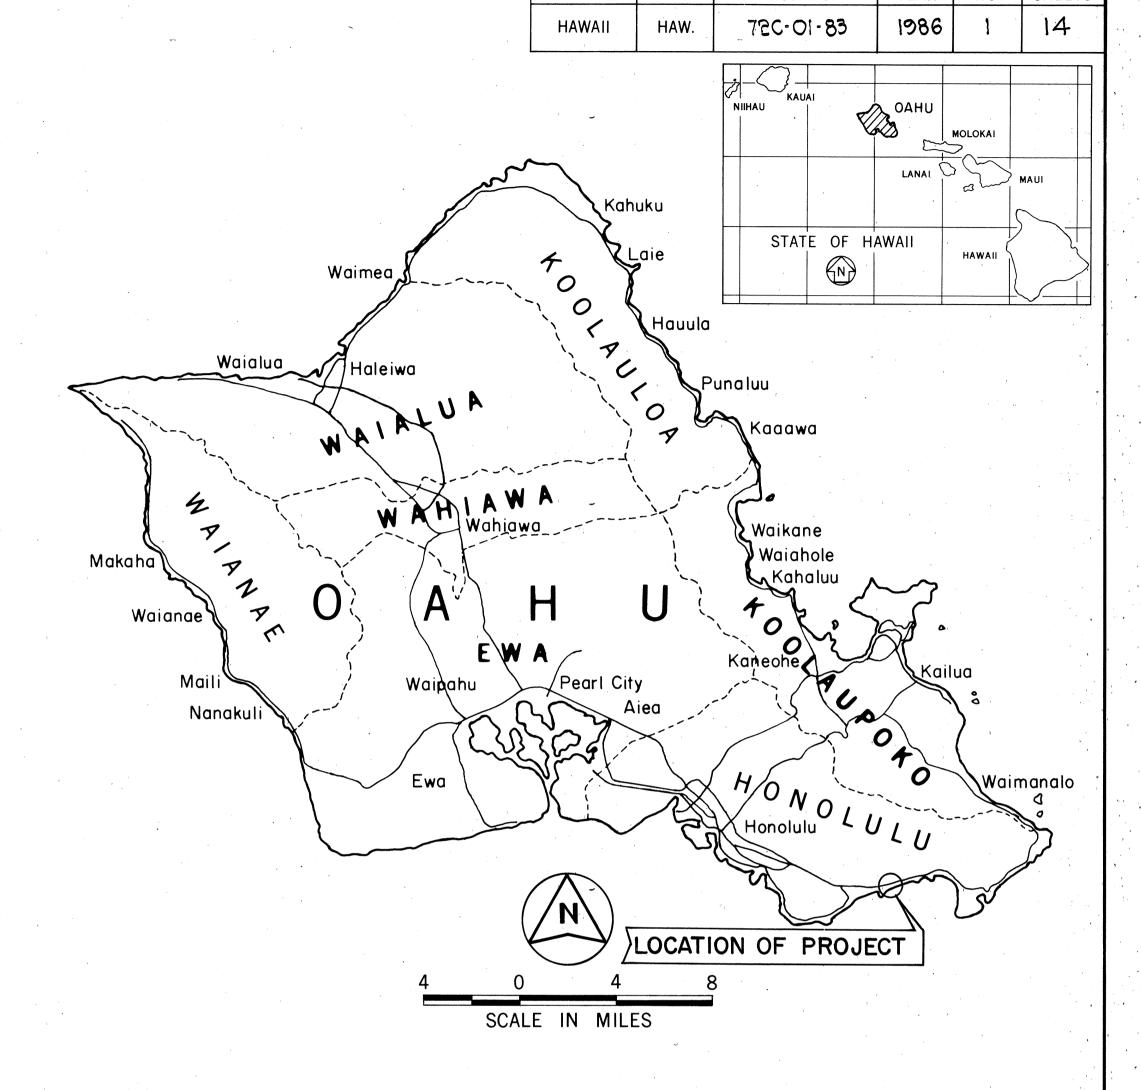

CHANGES MADE DURING CONSTRUCTION HAVE
BEEN INCORPORATED ON THESE PLANS EXCEPT
CHANGES IN THE ORIGINAL THEORETICAL
QUANTITIES. FOR ACTUAL QUANTITIES, REFER TO
PROJECT LEDGER, AND/OR COMPUTATION BOOK.

RESIDENT ENGINEER
B41-6549
PHONE ##

	DEPARTMENT OF TRANSPORTATION STATE OF HAWAII		
	APPROVED:		
	South Dir. OF TRANSPORTATION	12/3//05	
2	€ DIR. OF TRANSPORTATION	DATE	

D-8-8