


FED. ROAD DIST. NO.	STATE	PROJ. NO.	FISCAL YEAR	SHEET NO.	TOTAL SHEETS
HAWAII	HAW.	72C-01-83	1986	3	14

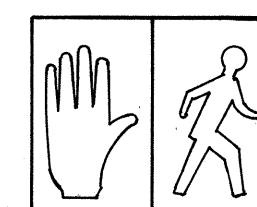

DON'T WALK
WALK
A-1
B-2, 4
C-4, 5
D-1

R
Y
G

A-2, 3
B-3
C-3
D-2
E-1, 2*
F-2
G-1


R
Y
↑

B-1*
C-1, 2
F-1

* Programmed Visibility Signal


SIGNAL INDICATIONS

Interconnect at this existing Pull Box W/ West Hind Drive & East Hind Drive.

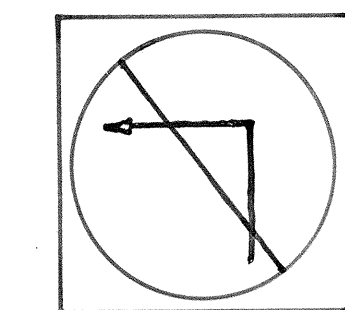

5:00-8:30 A.M.
EXCEPT SAT. SUN. HUL.

PHASE DIAGRAM

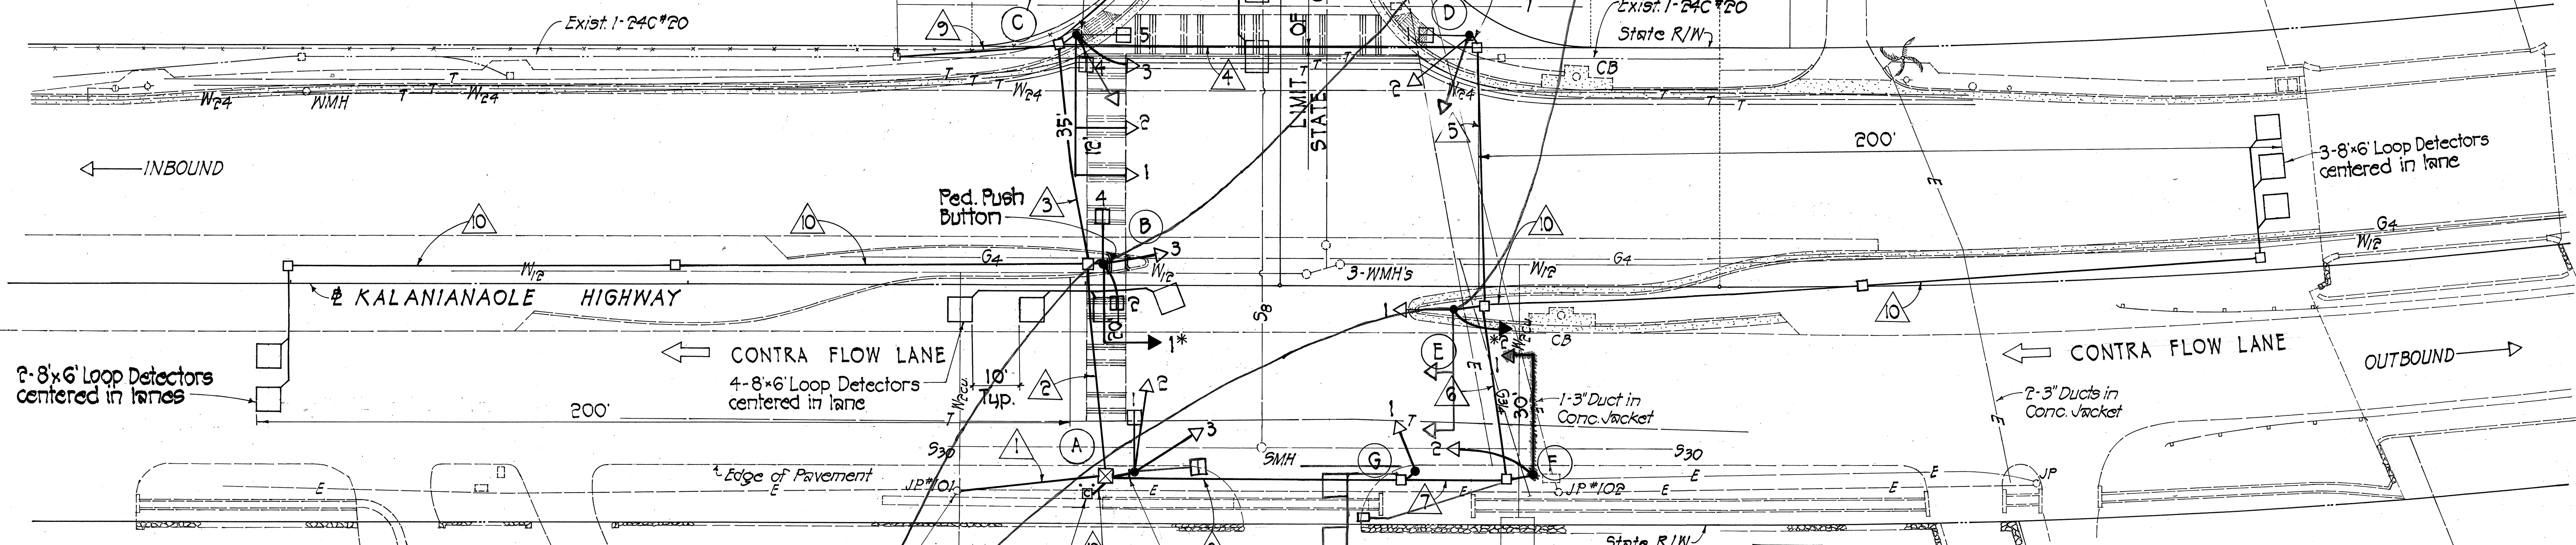


CONDUIT & CABLE SCHEDULE

CONDUIT	CABLE
1-2" Sch. 80	1-3C*6
3-2" Sch. 80	1-26C*14, 1-24C*20, 5-2C*14
3-2" Sch. 80	1-26C*14, 1-24C*20, 3-2C*14
2-2" Sch. 80	1-26C*14, 1-2C*14
1-2" Sch. 80	1-26C*14
2-2" Sch. 80	1-26C*14, 1-2C*14
2-2" Sch. 80	1-26C*14, 1-2C*14
2-2" Sch. 80	1-26C*14, 1-2C*14
1-2" Sch. 80	1-24C*20
1-2" Sch. 80	1-2C*14
5-2" Sch. 80	1-3C*6, 2-26C*14, 6-2C*14, 1-24C*20
1-2" Sch. 80	2-2C*14

PLAN


Scale: 1"=20'
TMK: 3-6-02 & 05

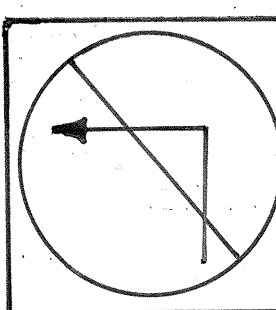

WHEN CONED

EXIST. PHASE DIAGRAM 3 PHASE WEST HIND DRIVE CONTROLLER

APPROVED: *[Signature]* 4/20/87
CHIEF, DIVISION OF ENGINEERING, DPW
(APPROVED FOR CONSTRUCTION WITH CITY R/W ONLY)

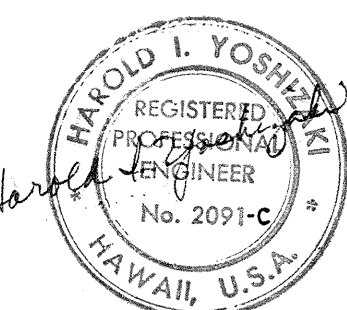

EXIST. PHASE DIAGRAM 2 PHASE EAST HIND DRIVE CONTROLLER

STATE OF HAWAII
DEPARTMENT OF TRANSPORTATION
HIGHWAYS DIVISION
KALANIANA'OLE HIGHWAY TRAFFIC SIGNALS
AT NENUKE STREET

PLAN-TRAFFIC SIGNAL SYSTEM

PROJECT NO. 72C-01-83
SCALE: 1"=20' DATE: Nov. 21, 1985
SHEET No. 1 OF 2 SHEETS