

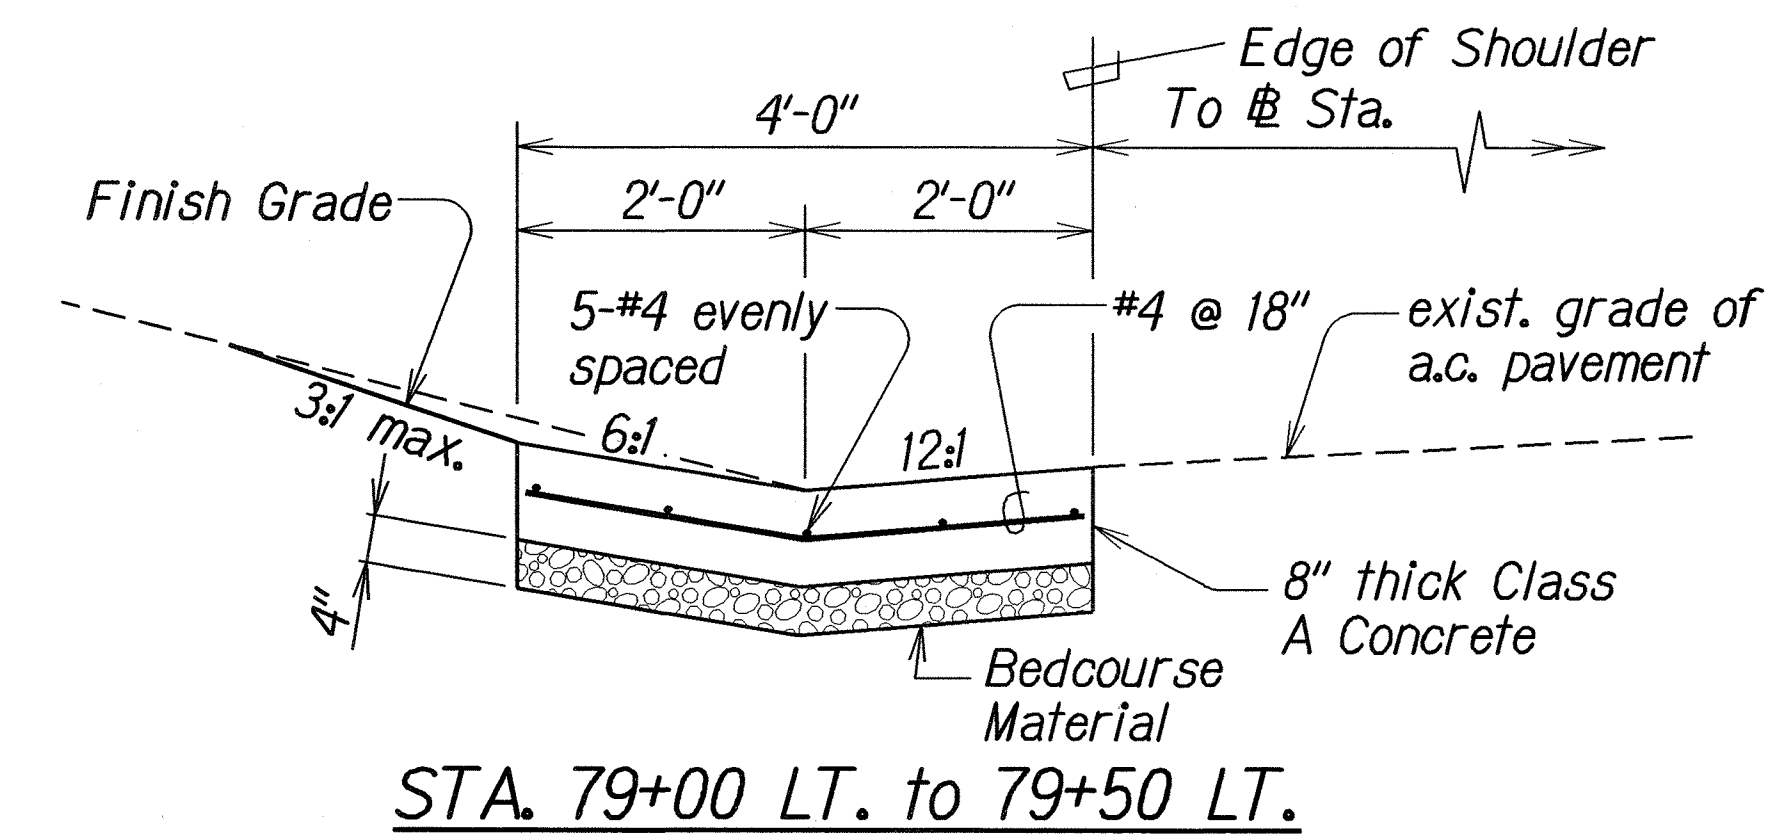
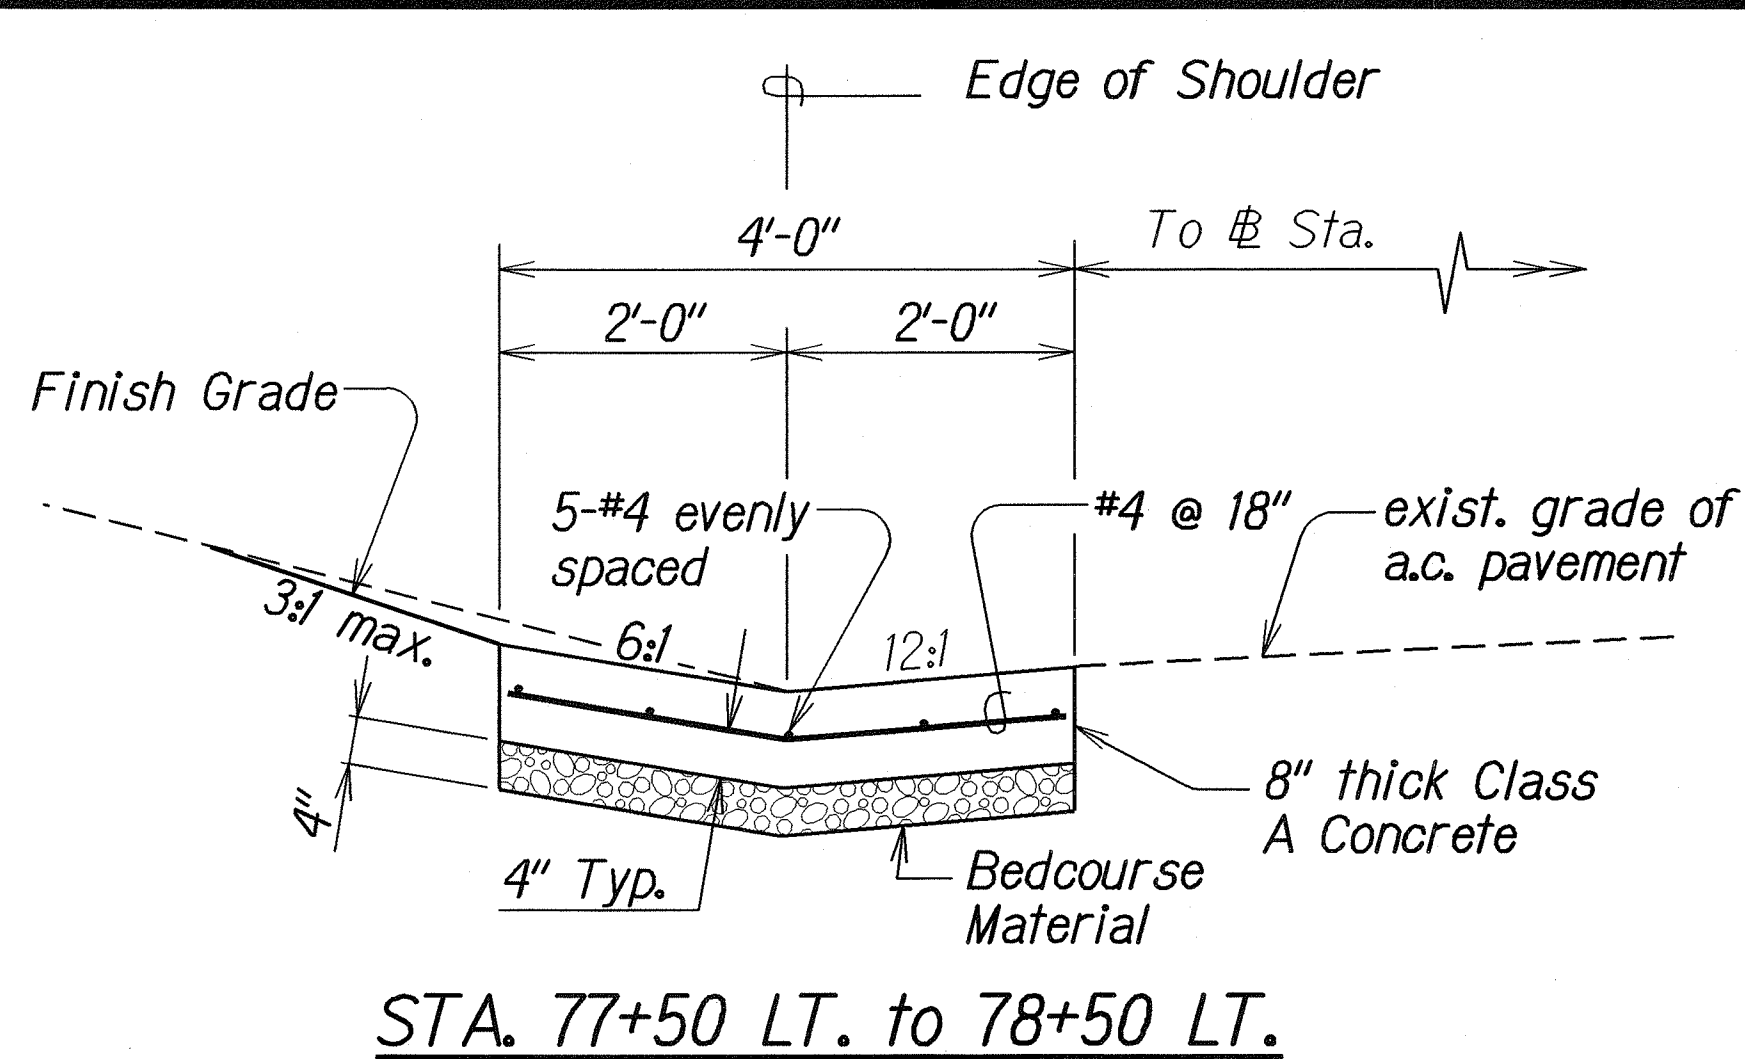
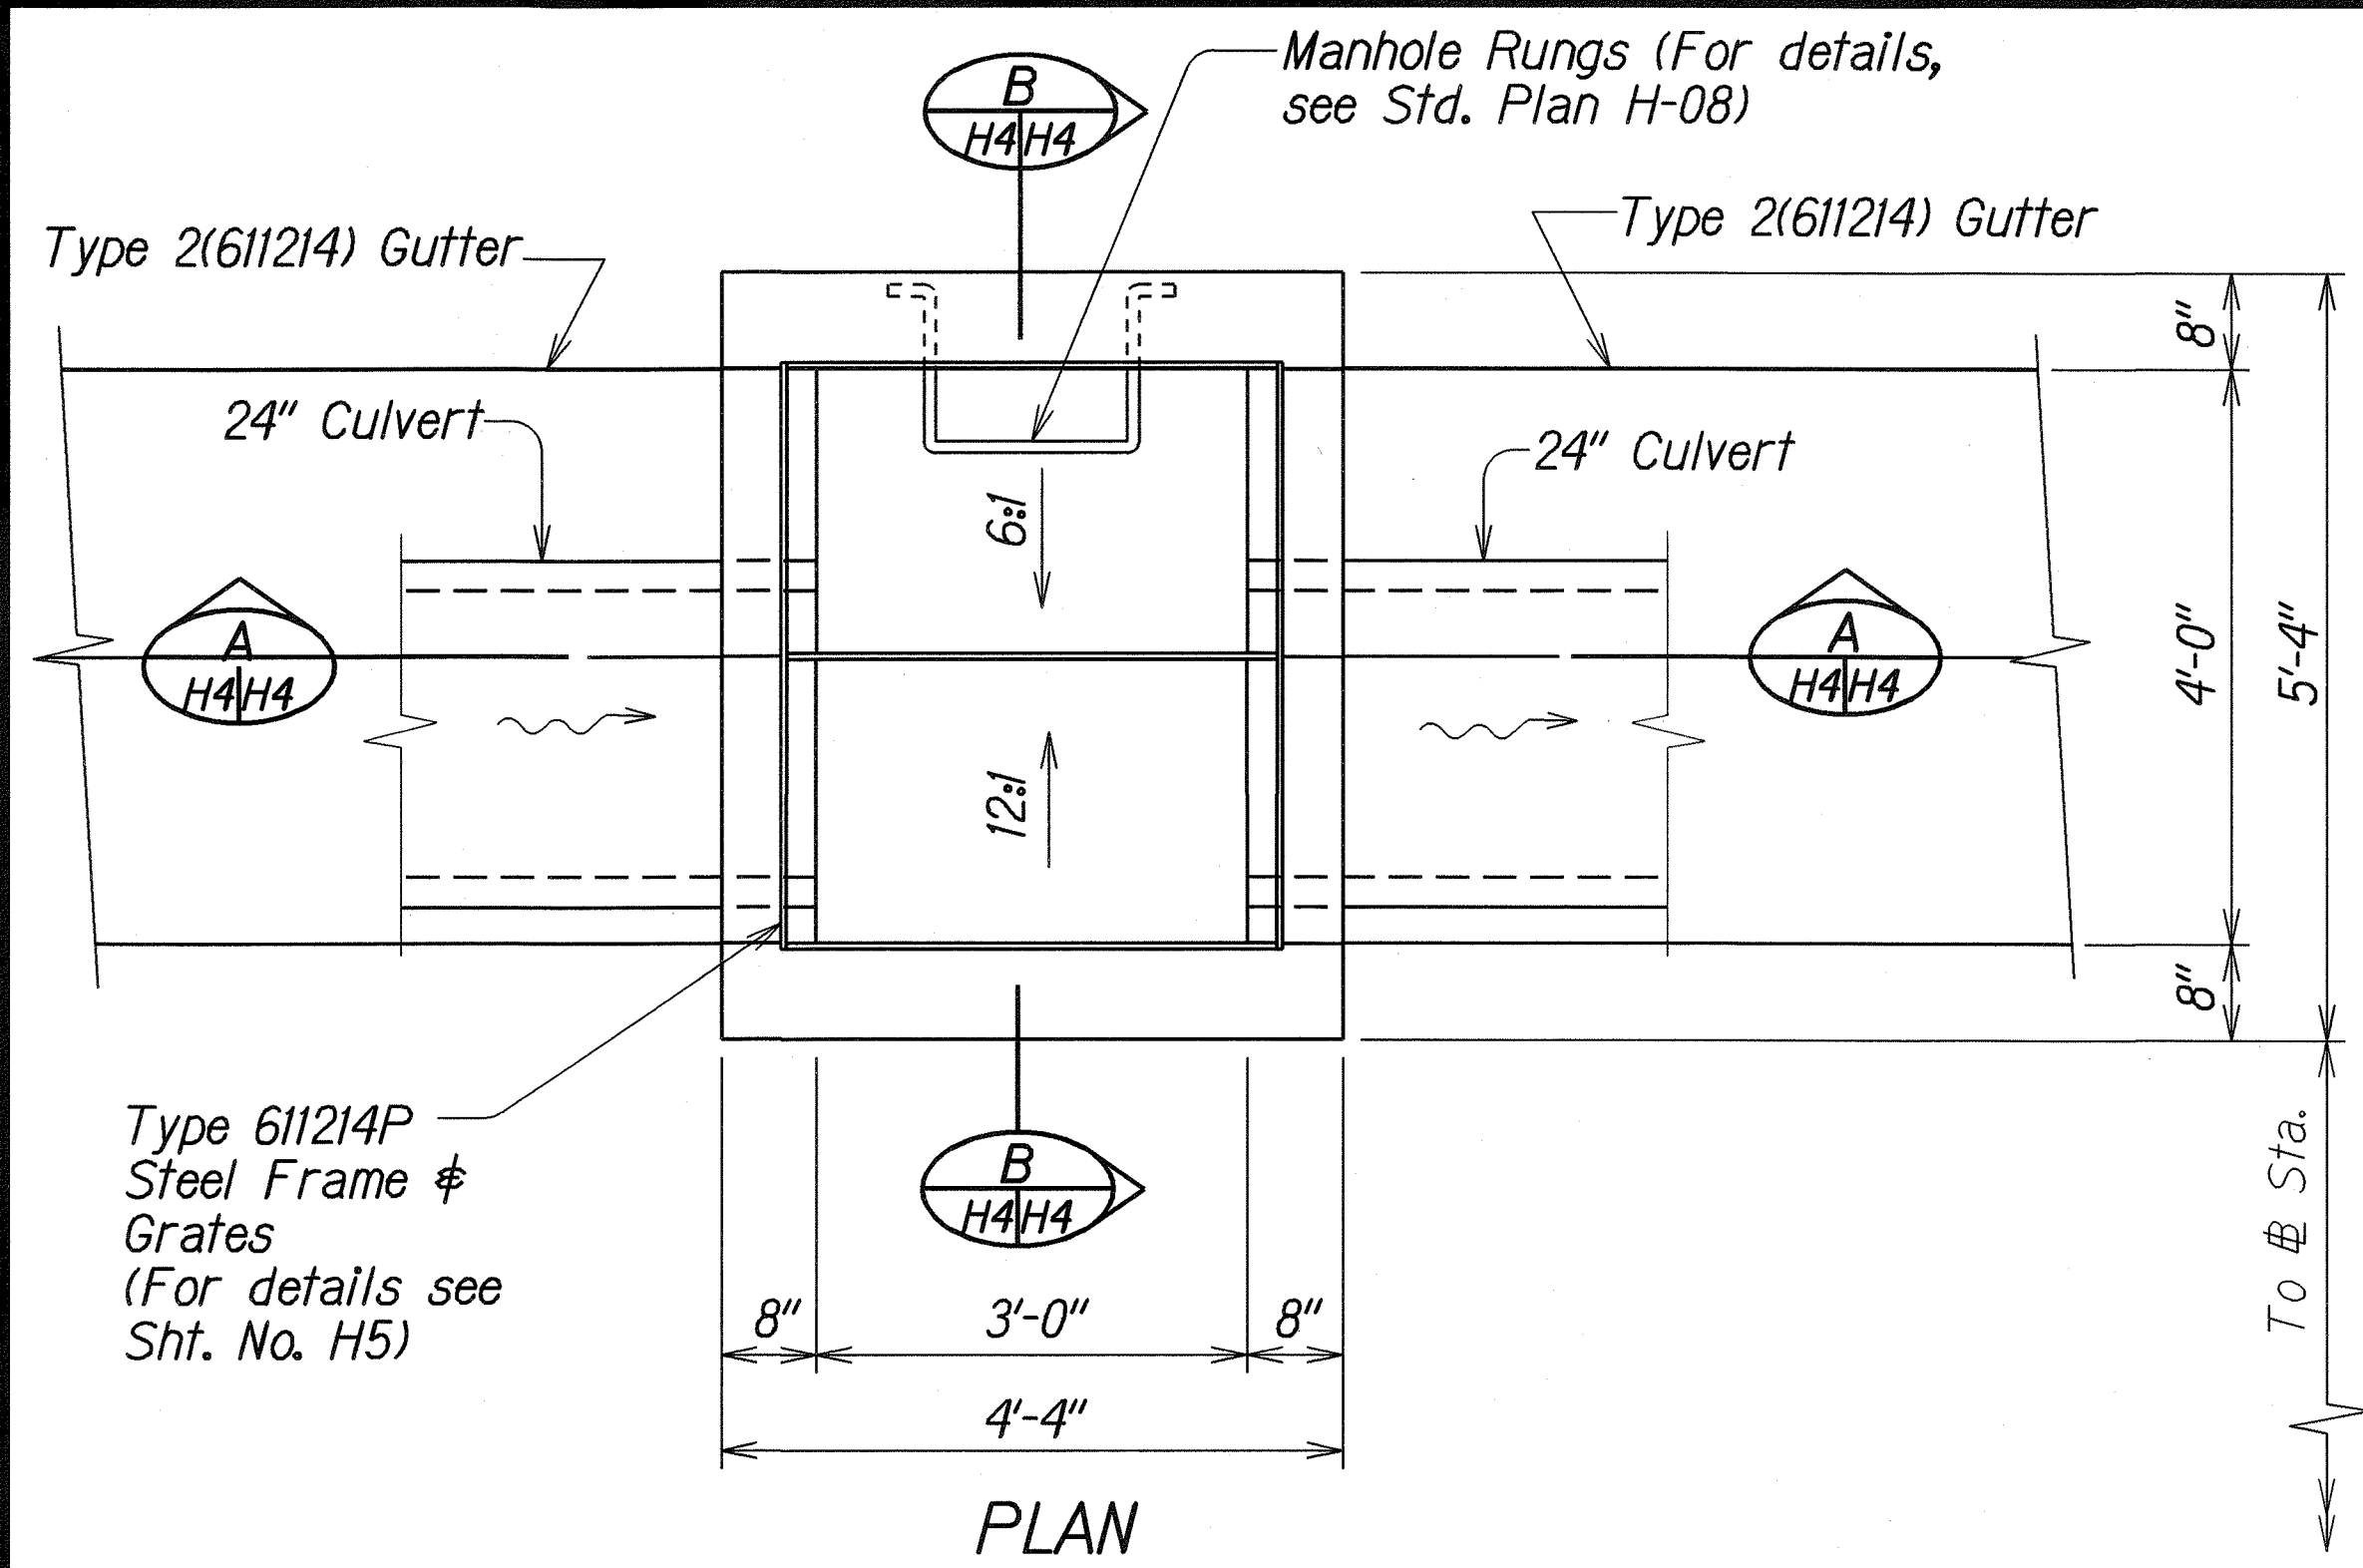
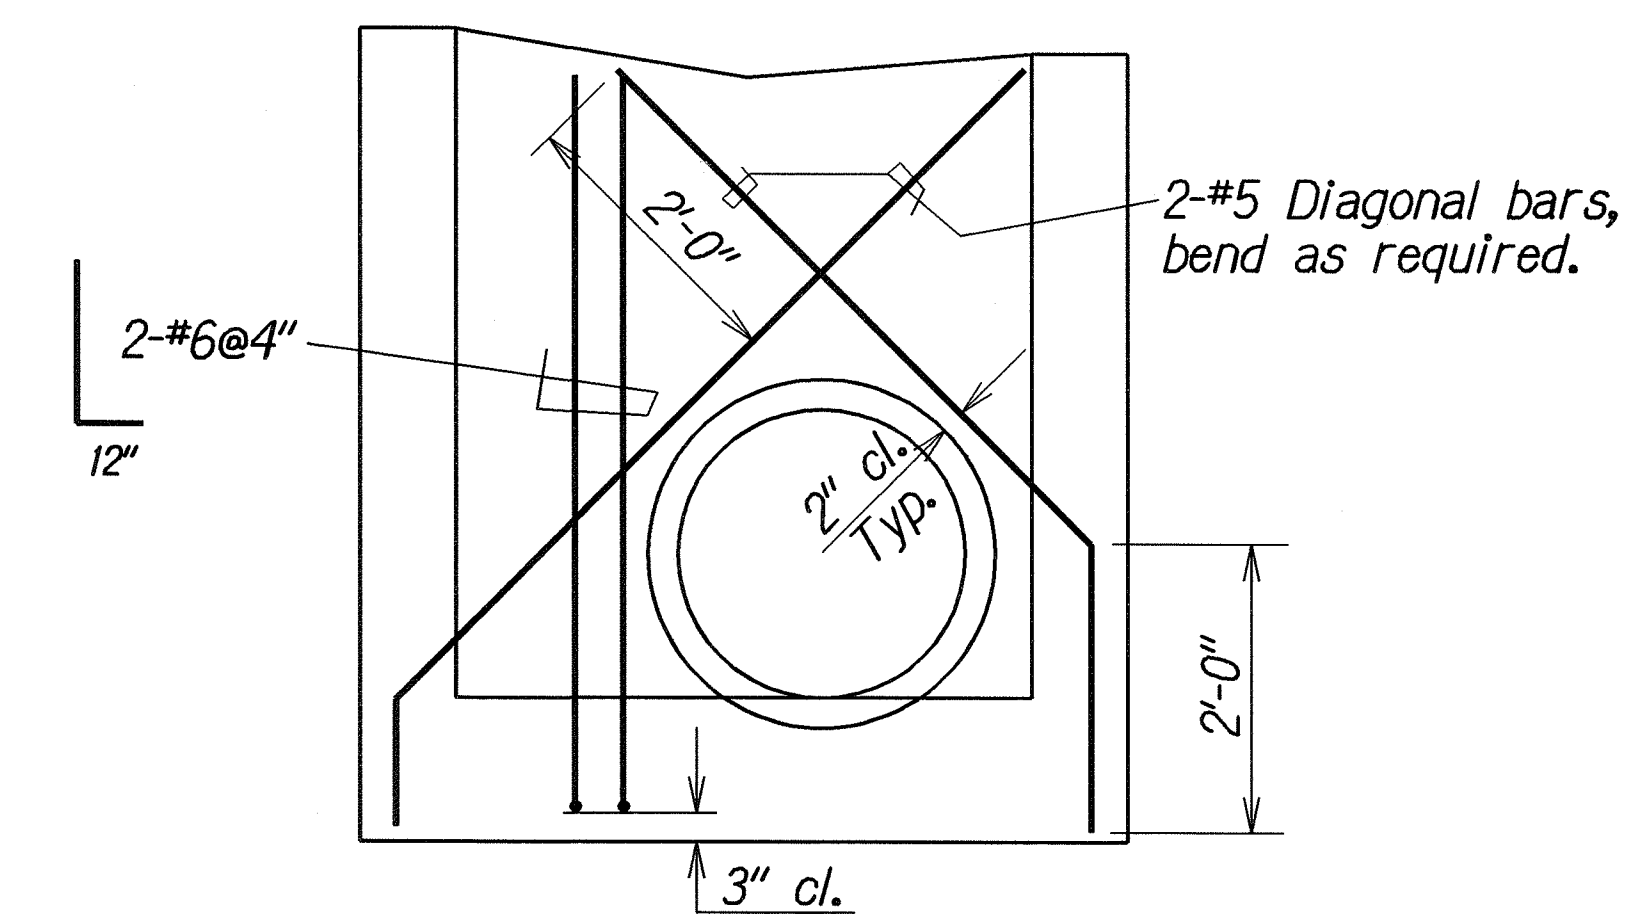
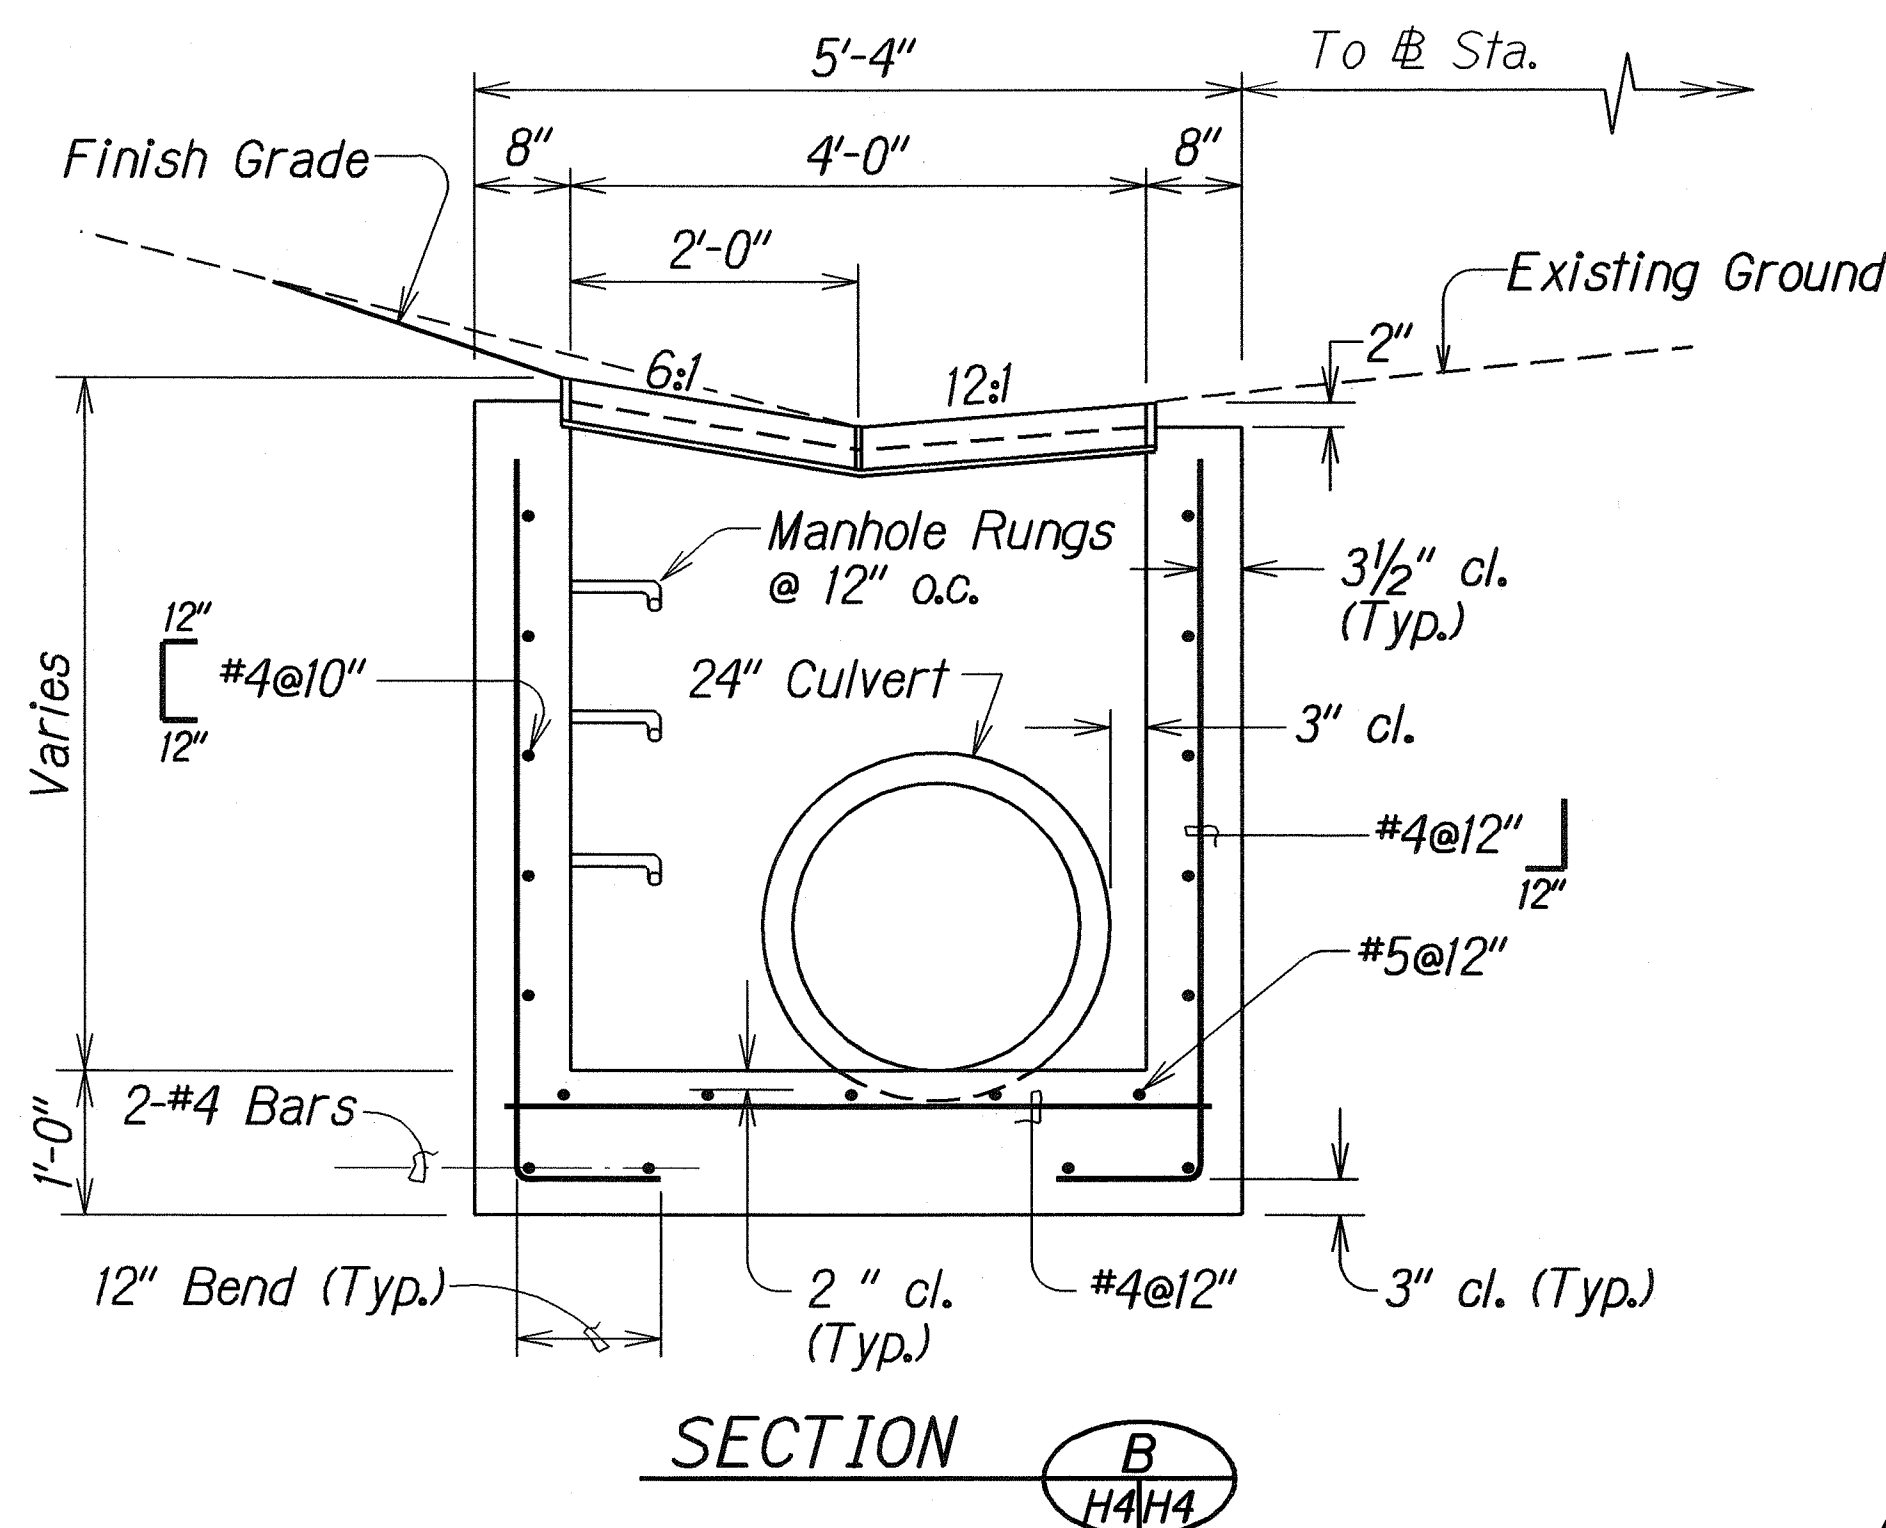


FED. ROAD DIST. NO.	STATE	FED. AID PROJ. NO.	FISCAL YEAR	SHEET NO.	TOTAL SHEETS
HAWAII	HAW.	DE-072-1(48)R	2006	9	20

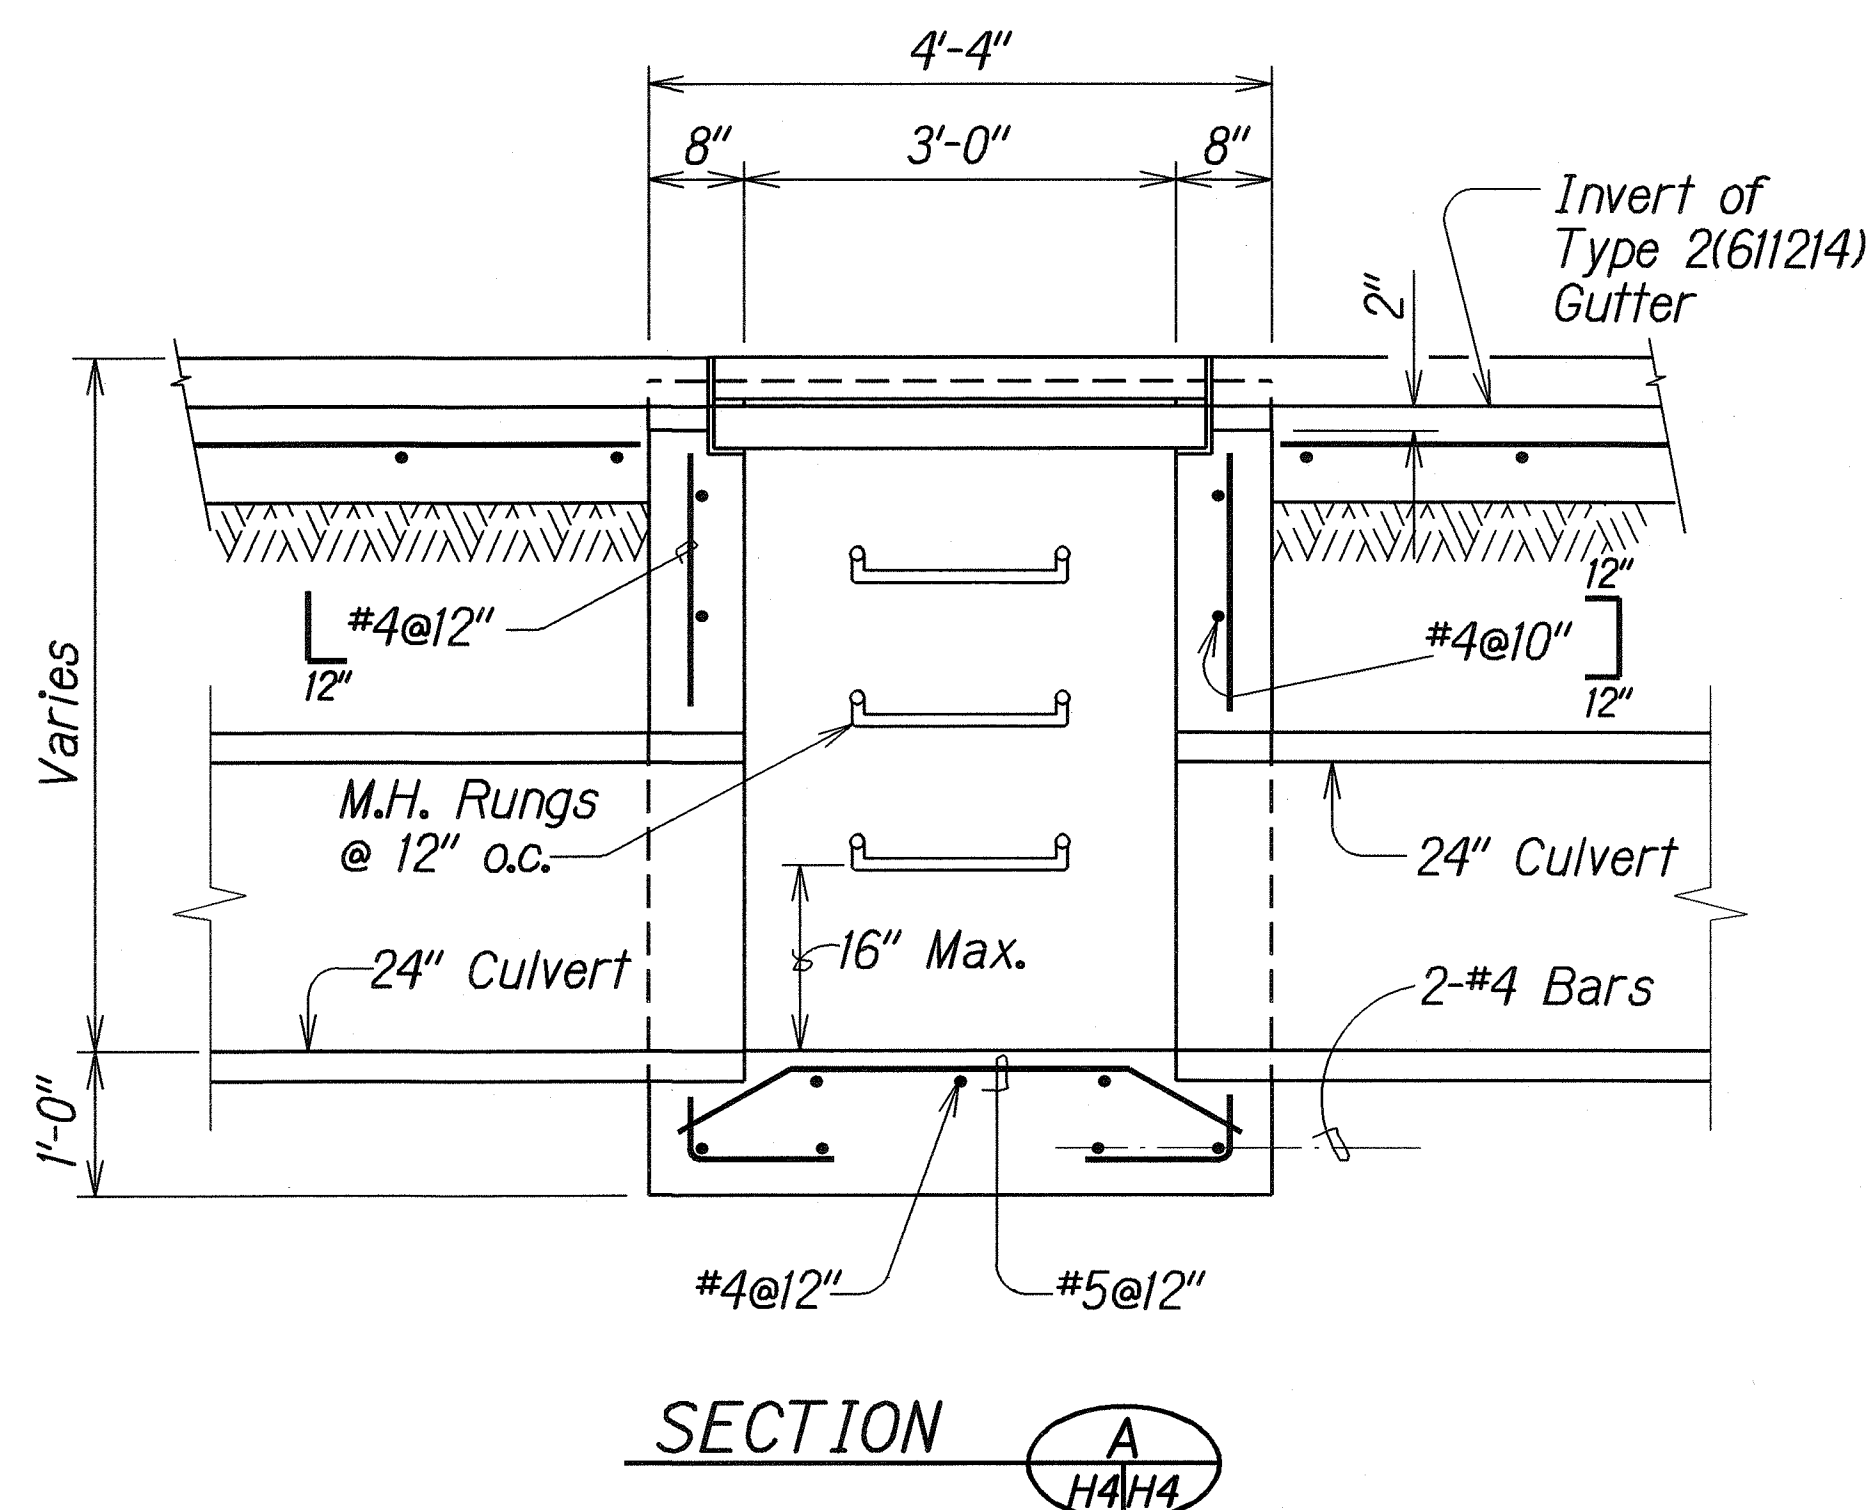

DETAILS OF TYPE 2(611214) GUTTER

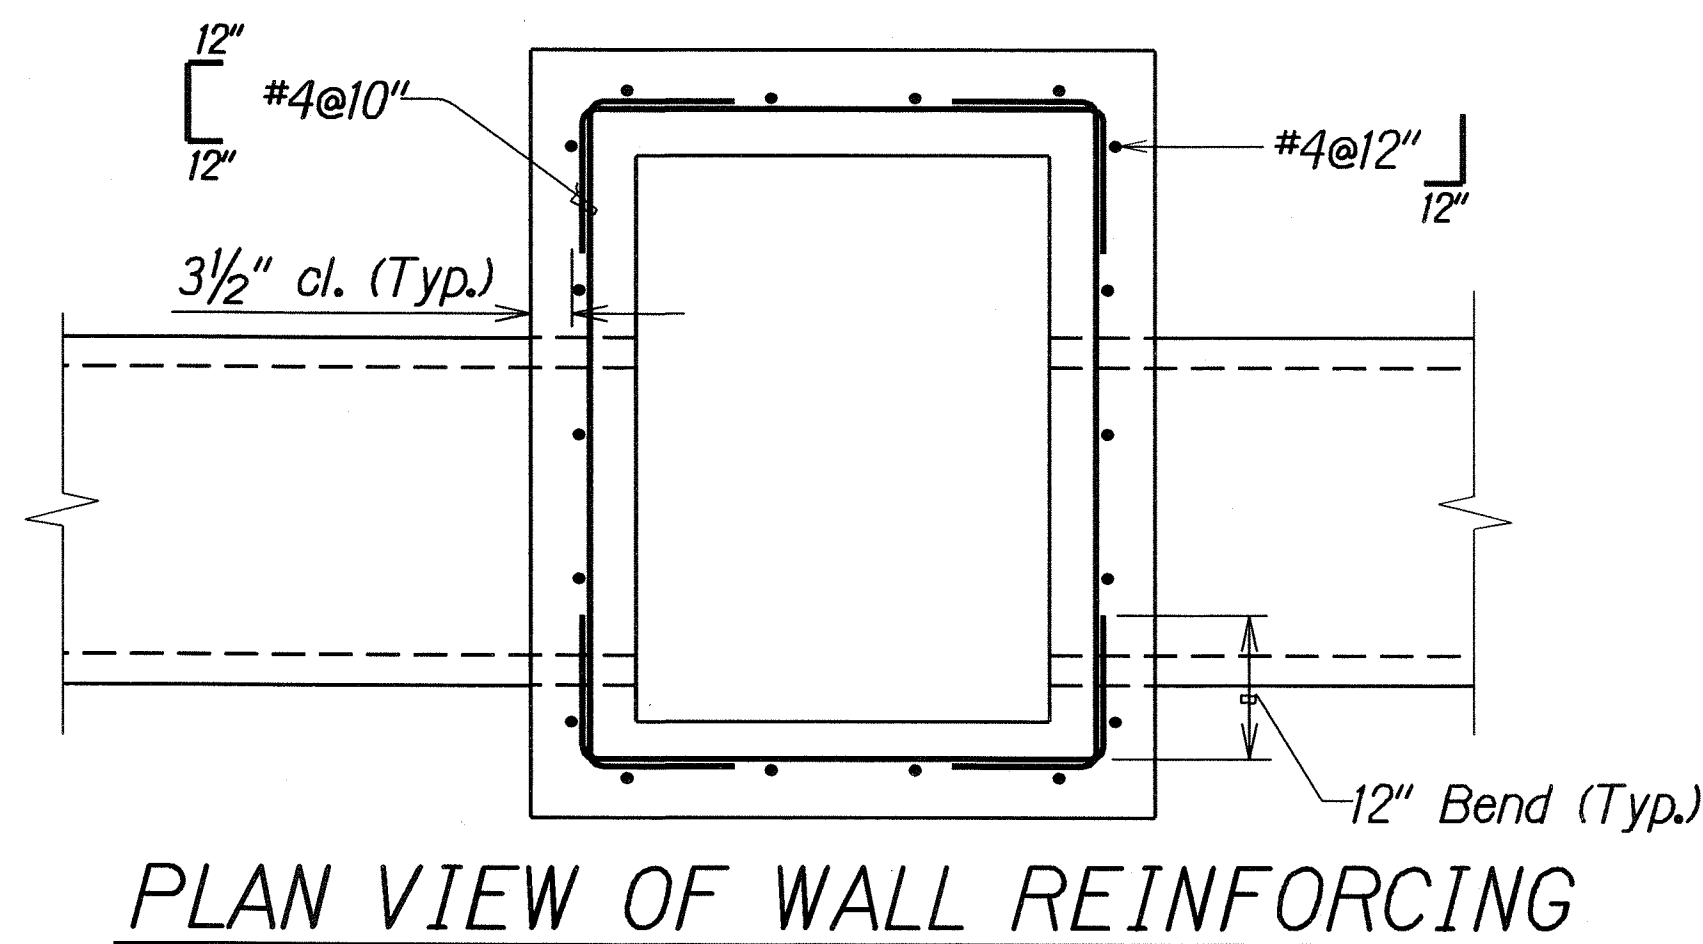

ADDED REINFORCING FOR CULVERT OPENING


DETAILS OF TYPE 611214P GRATED DROP INLET

ORIGINAL PLAN	DATE	10/15/03
SURVEY PLOTTED BY		
DRAWN BY		
TRACED BY		
QUANTITIES BY		
CHECKED BY		

STATE OF HAWAII
DEPARTMENT OF TRANSPORTATION
HIGHWAYS DIVISION

DRAINAGE DETAIL
KALANIANA'OLE HIGHWAY
DRAINAGE IMPROVEMENTS
Vicinity of Keolu Hills
Fed. Aid Project No. DE-072-1(48)R
Scale: 3/4"=1'-0" Date: May, 2005


FED. ROAD DIST. NO.	STATE	FED. AID PROJ. NO.	FISCAL YEAR	SHEET NO.	TOTAL SHEETS
HAWAII	HAW.	DE-072-1(48)R	2006	C.O.10S-1	20

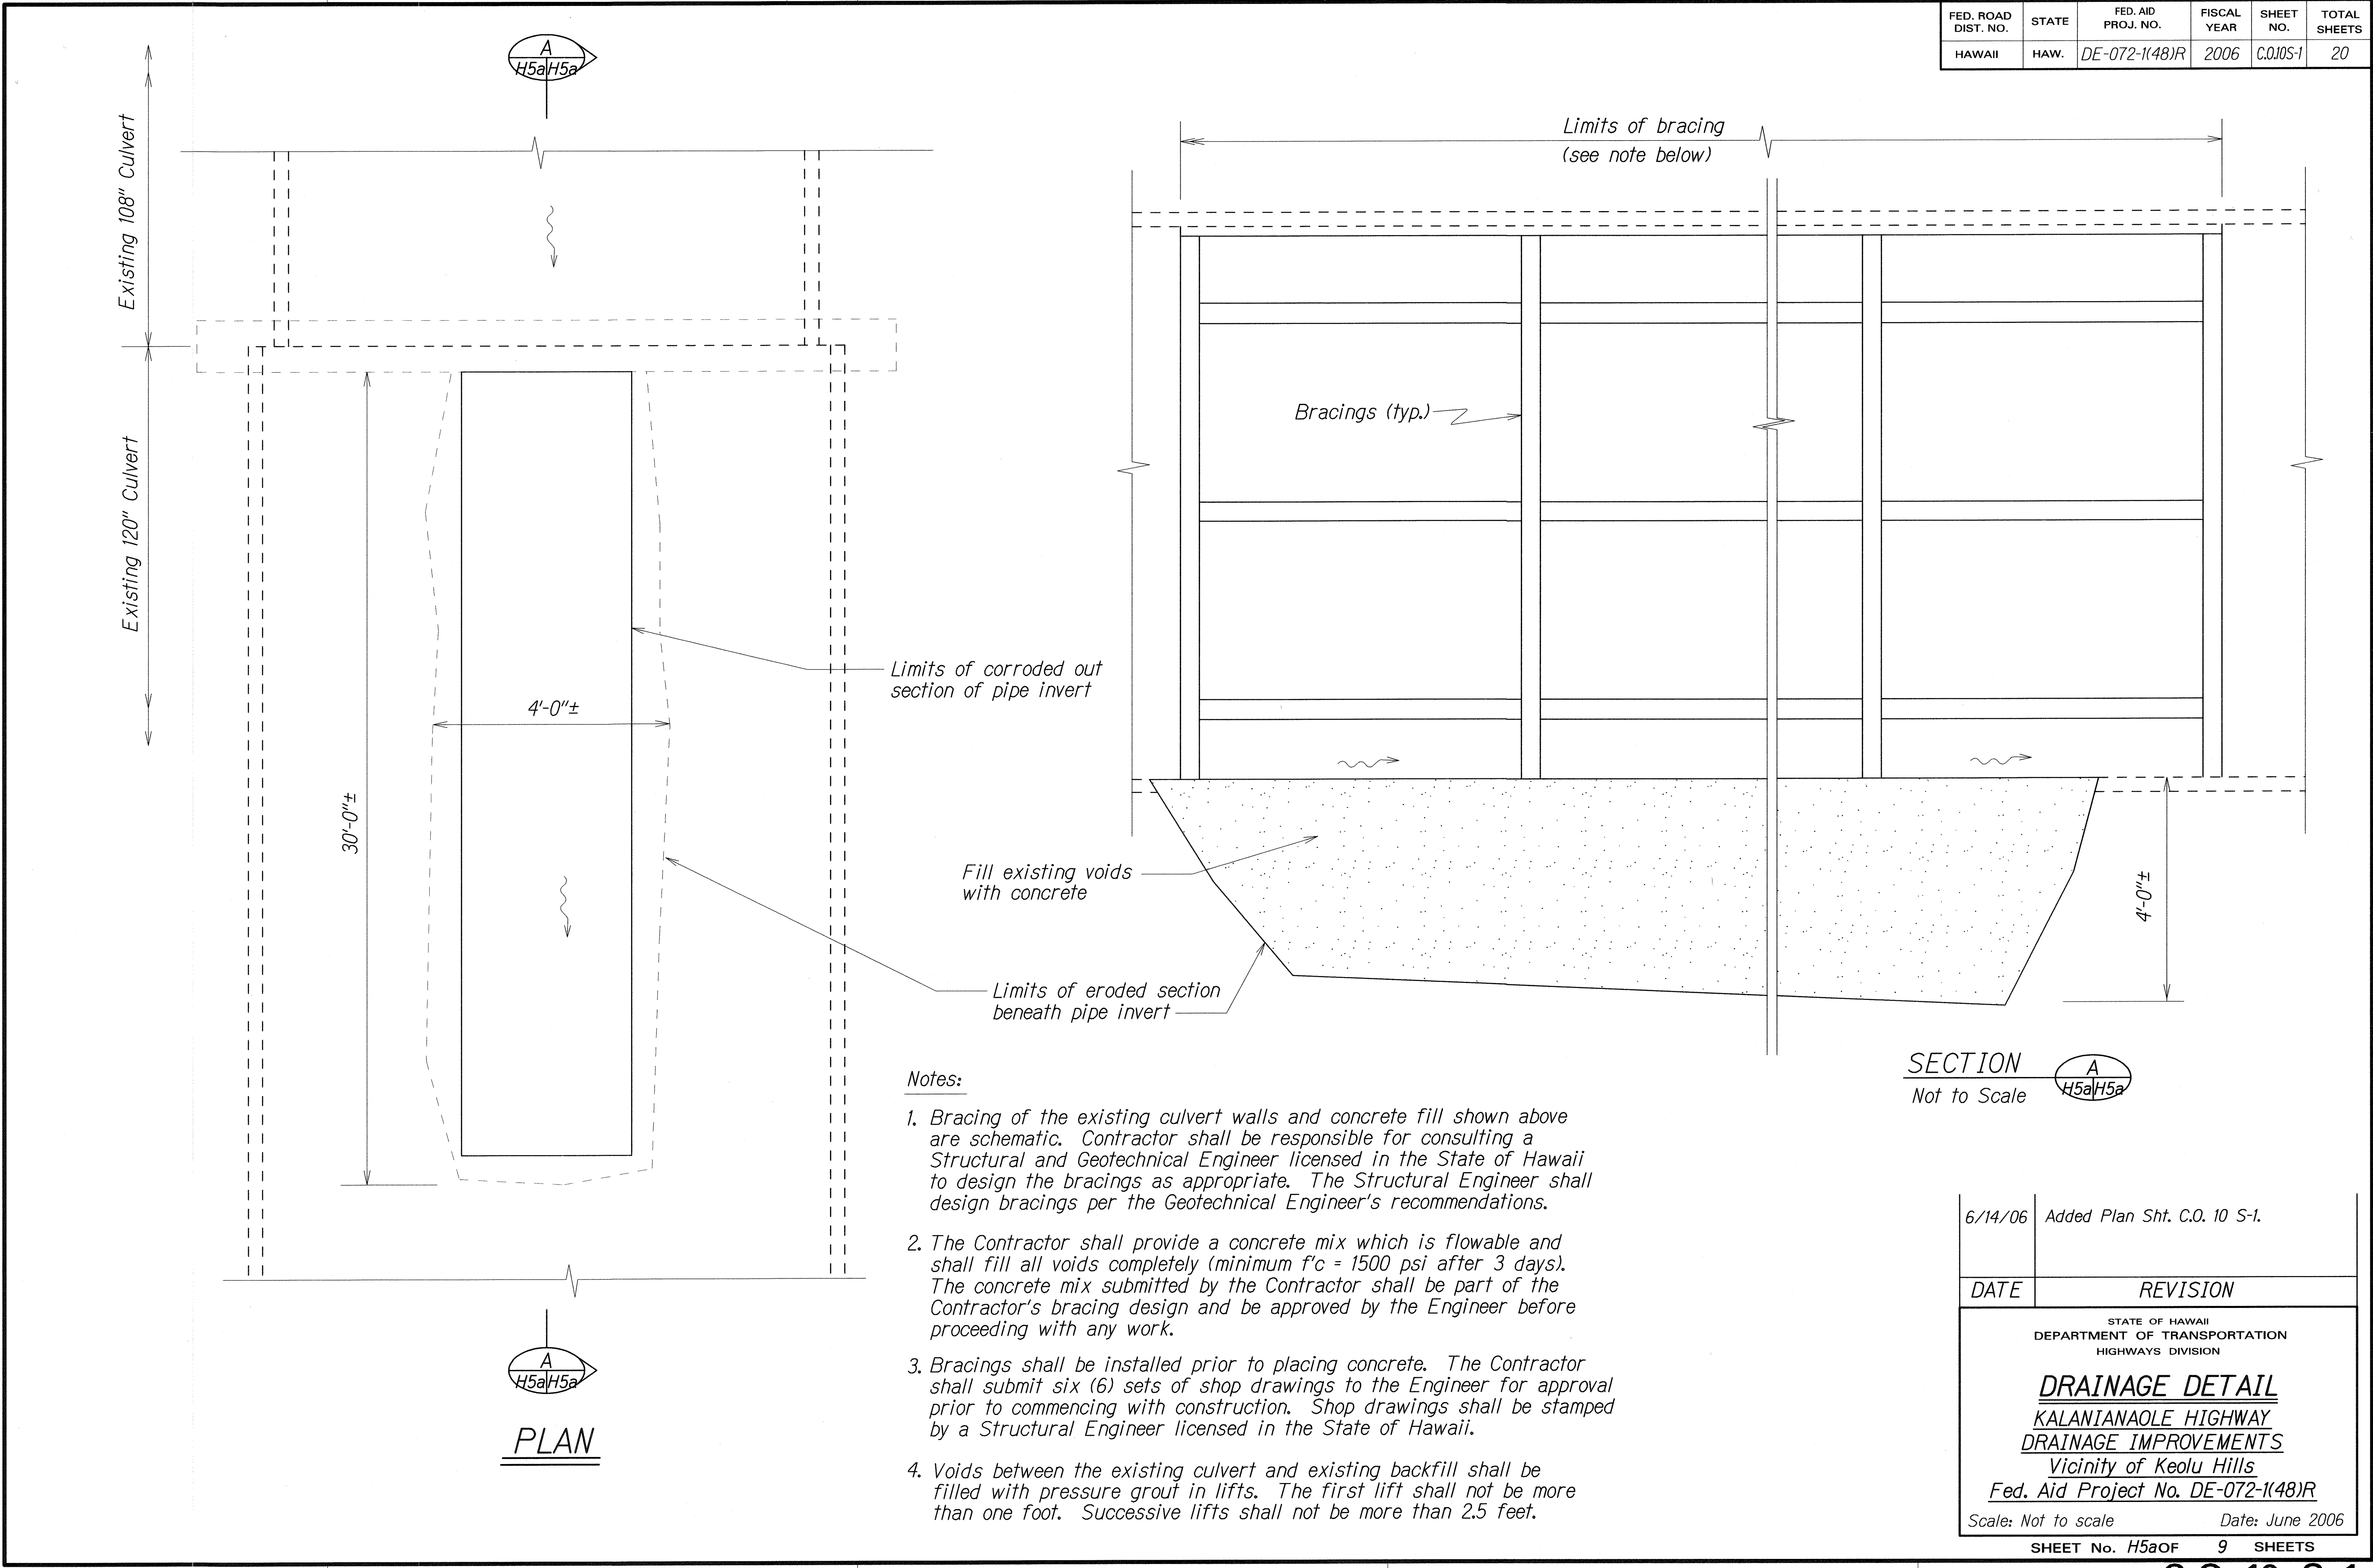

ORIGINAL PLAN	SURVEY PLOTTED BY	DATE
NOTE BOOK	DRAWN BY	
012/curtis/cke	DESIGNED BY	
01/05/06	CHECKED BY	

6/14/06	Added Plan Sht. C.O. 10 S-1.
DATE	REVISION
STATE OF HAWAII DEPARTMENT OF TRANSPORTATION HIGHWAYS DIVISION DRAINAGE DETAIL KALANIANA'OLE HIGHWAY DRAINAGE IMPROVEMENTS Vicinity of Keolu Hills Fed. Aid Project No. DE-072-1(48)R Scale: Not to scale Date: June 2006 SHEET No. H5aOF 9 SHEETS	

FED. ROAD DIST. NO.	STATE	FED. AID PROJ. NO.	FISCAL YEAR	SHEET NO.	TOTAL SHEETS
HAWAII	HAW.	DE-072-1(48)R	2006	C.O.10S-2	20

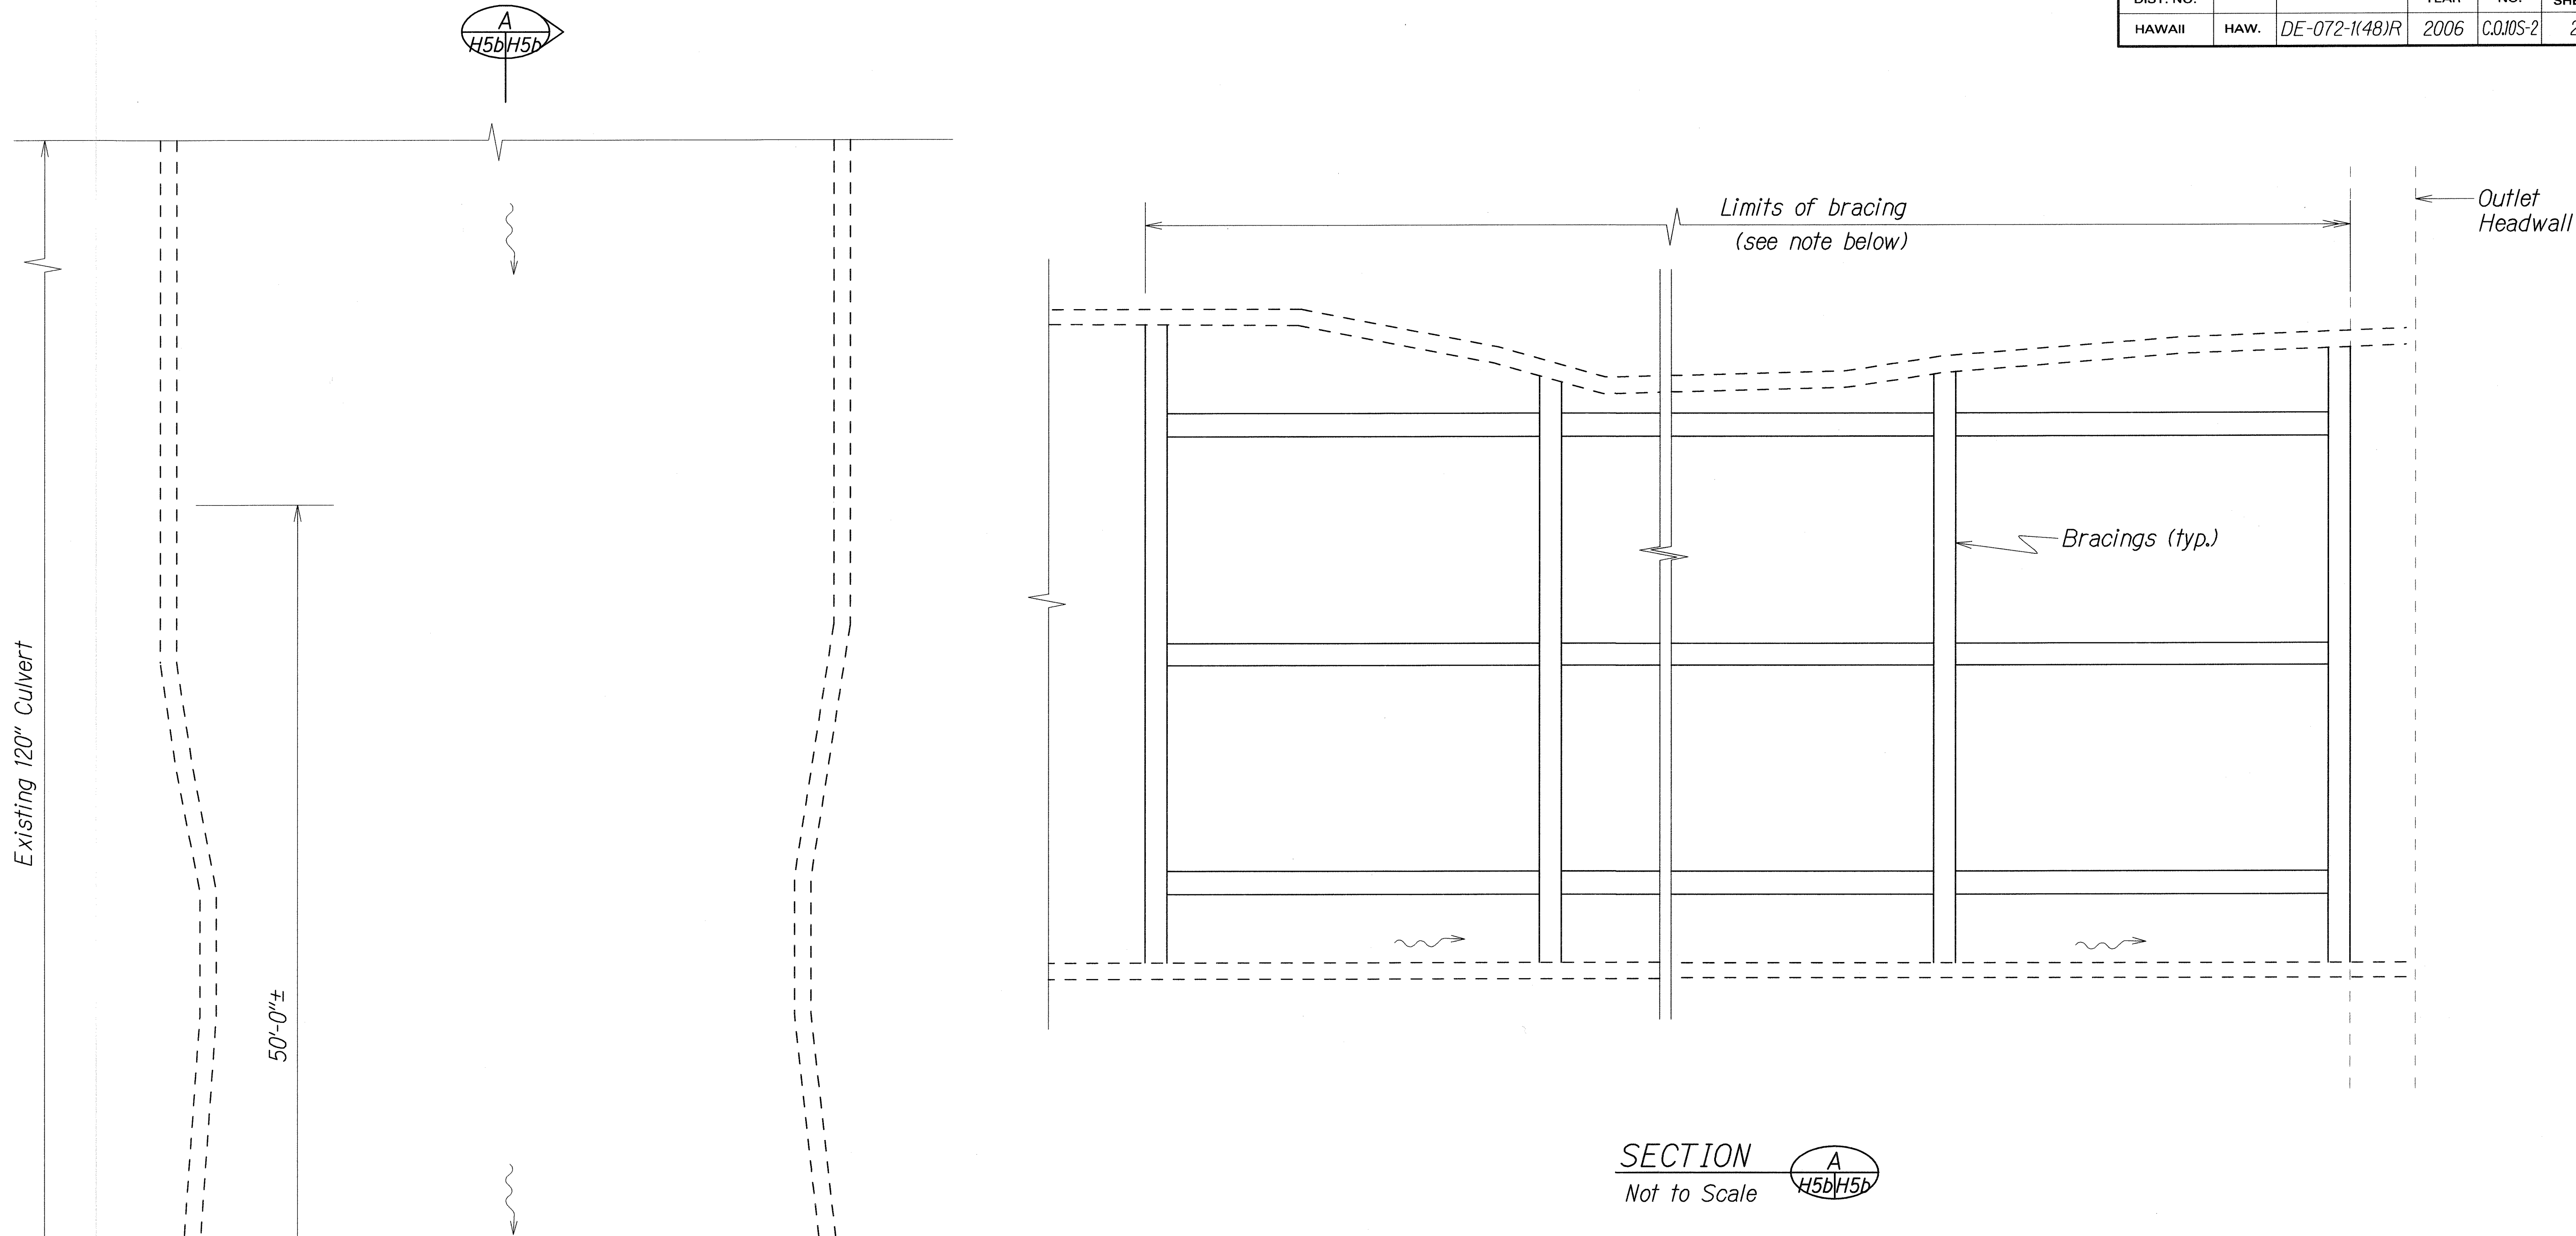


ORIGINAL PLAN	SURVEY PLOTTED BY	DATE
NOTE BOOK	DRAWN BY	
012/cutls/ghw	DESIGNED BY	
9/8/06bgn	CHECKED BY	

- Notes:
1. Bracing of the existing culvert walls shown above are schematic. Contractor shall be responsible for consulting a Structural and Geotechnical Engineer licensed in the State of Hawaii to design the bracings as appropriate. The Structural Engineer shall design bracings per the Geotechnical Engineer's recommendations.
 2. The Contractor shall submit six (6) sets of shop drawings to the Engineer for approval prior to commencing with construction. Shop drawings shall be stamped by a Structural Engineer licensed in the State of Hawaii.

6/14/06	Added Plan Sht. C.O. 10 S-2.
DATE	REVISION
STATE OF HAWAII DEPARTMENT OF TRANSPORTATION HIGHWAYS DIVISION DRAINAGE DETAIL KALANIANA'OLE HIGHWAY DRAINAGE IMPROVEMENTS Vicinity of Keolu Hills Fed. Aid Project No. DE-072-1(48)R Scale: Not to scale Date: June 2006 SHEET No. H5bOF 9 SHEETS	

FED. ROAD DIST. NO.	STATE	FED. AID PROJ. NO.	FISCAL YEAR	SHEET NO.	TOTAL SHEETS
HAWAII	HAW.	DE-072-1(48)R	2006	11	20

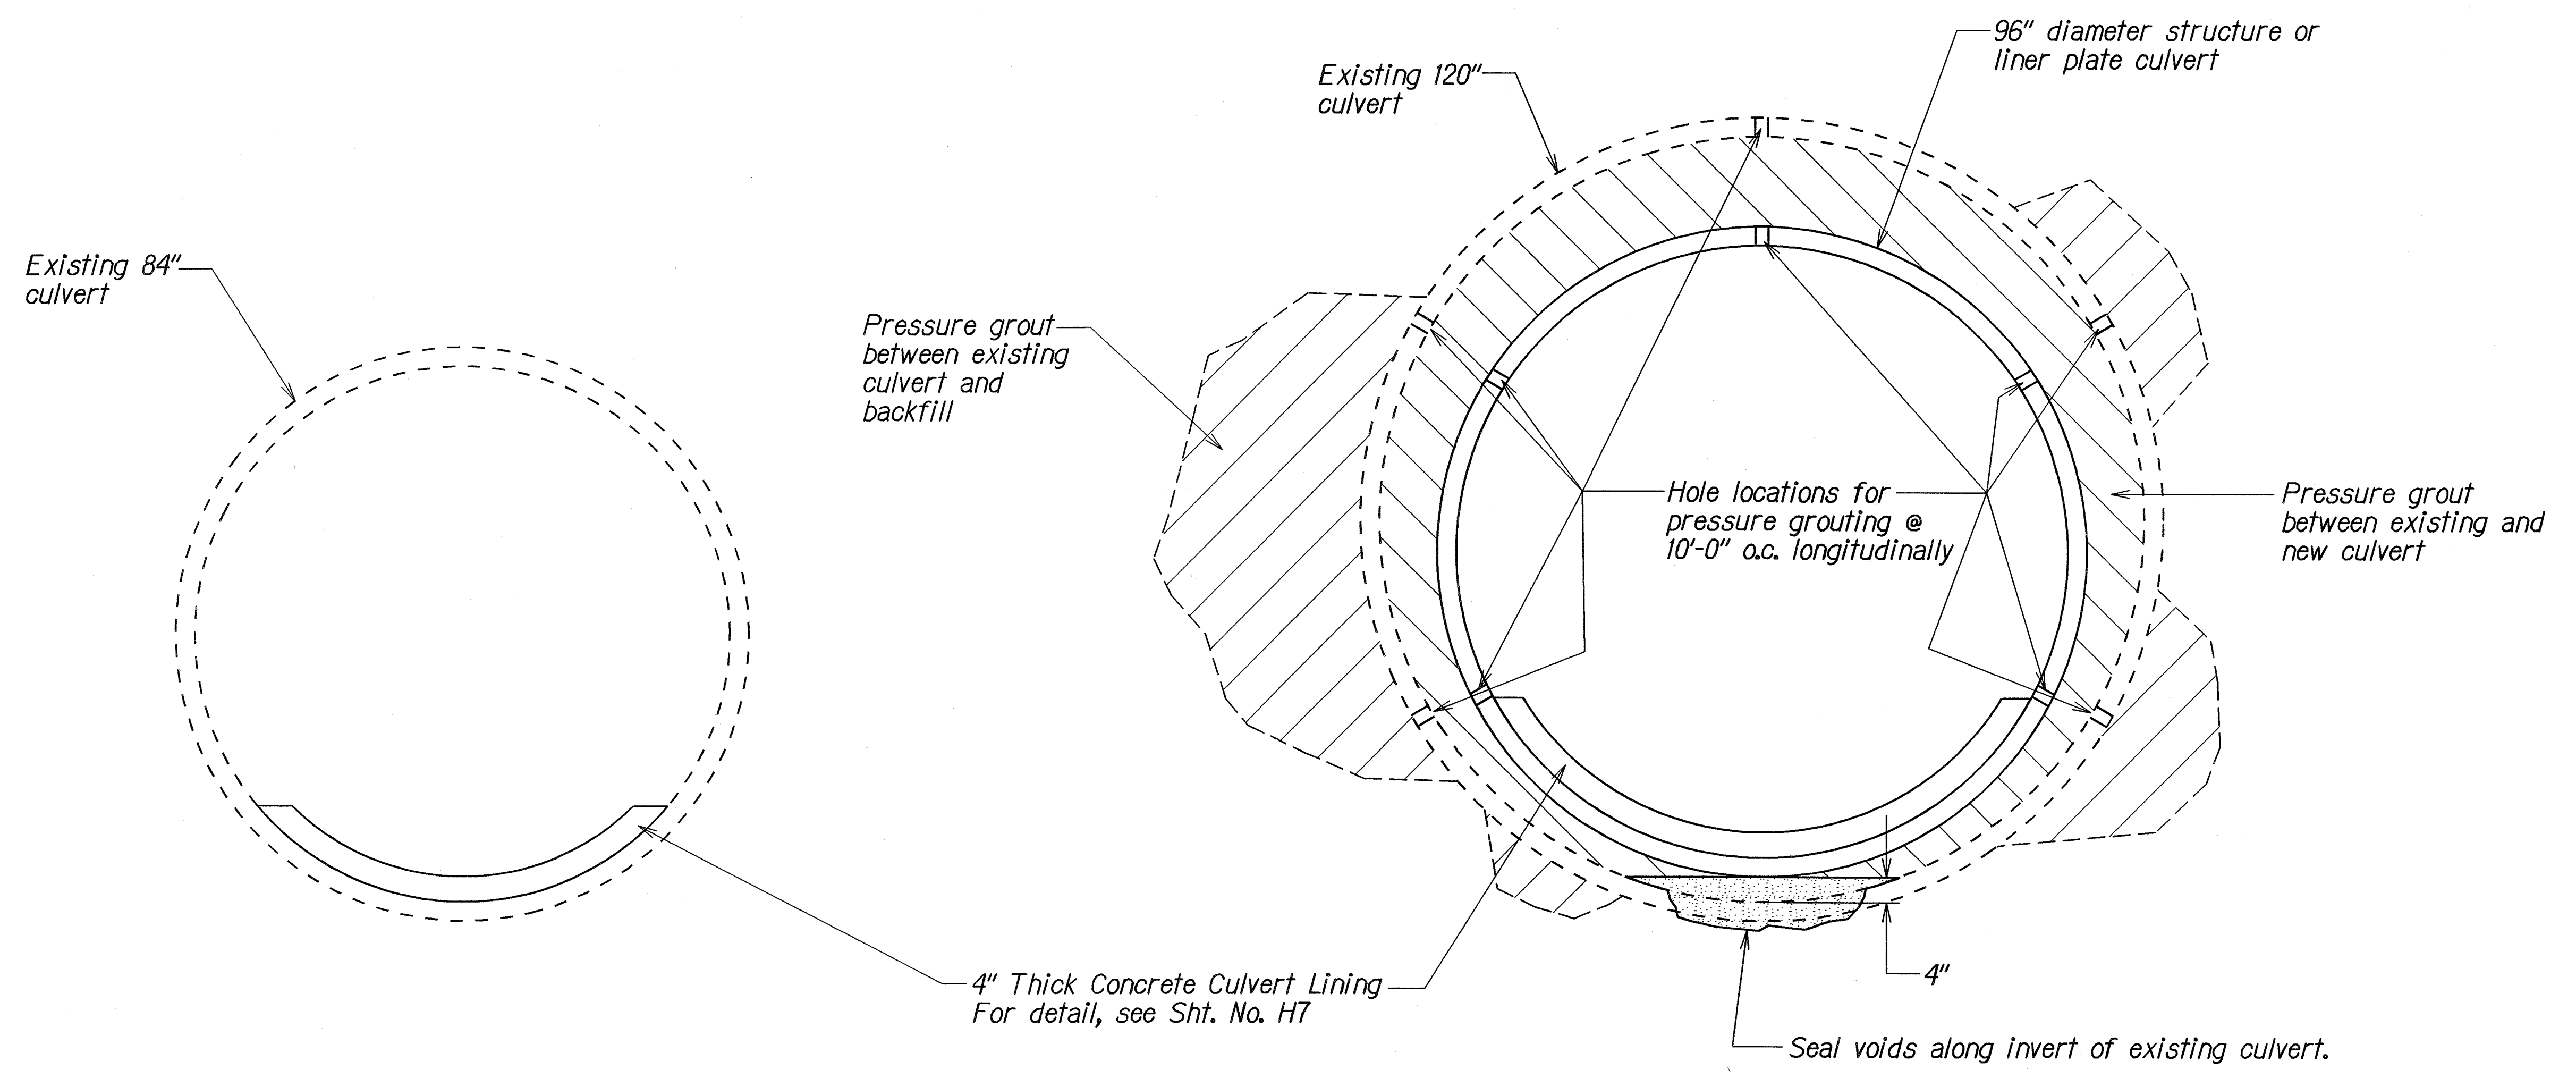

Note: Contractor shall seal voids along the existing invert prior to pressure grouting between the existing culvert and backfill.

TYPICAL CULVERT SECTION LOOKING DOWNSTREAM

ORIGINAL PLAN	SURVEY PLOTTED BY	DATE
NOTE BOOK	DRAWN BY	1/24/01
DESIGNED BY	CHECKED BY	
QUANTITIES BY		
CHECKED BY		

STATE OF HAWAII
DEPARTMENT OF TRANSPORTATION
HIGHWAYS DIVISION

DRAINAGE DETAIL
KALANIANA'OLE HIGHWAY
DRAINAGE IMPROVEMENTS
Vicinity of Keolu Hills
Fed. Aid Project No. DE-072-1(48)R


Scale: 3/4"=1'-0" Date: May, 2005

SHEET No. H6 OF 9 SHEETS

FED. ROAD DIST. NO.	STATE	FED. AID PROJ. NO.	FISCAL YEAR	SHEET NO.	TOTAL SHEETS
HAWAII	HAW.	DE-072-1(48)R	2006	ADD 12	20


NOTES:

1. The culvert surface shall be cleaned of all dirt, rust, scale, and other foreign materials. Cut, remove and dispose of corroded sections as ordered by the Engineer in increments not exceeding 50-feet in length.
2. The Contractor shall provide adequate bracing for the culvert. The Contractor shall, at his own expense, consult with a Geotechnical Engineer to determine the required amount of bracing based on his construction methodology.
3. Angle irons shall be welded to the structural plate culvert at two-feet on-center longitudinally. Welded wire fabric steel reinforcement shall be placed two inches above the crest of the corrugations. The welded wire fabric shall be lapped a minimum of six inches.
4. The culvert surface to be in contact with the epoxy shall be clean and dry. The epoxy bonding agent shall be applied just before the placement of the concrete. Any excess bonding agent that collects in pockets shall be removed.
5. The concrete for the culvert lining shall have a minimum 28-day strength of 4,000 psi. Coarse aggregate no. 67 (3/4 inch to No. 4) shall be used. The total free water shall not exceed 285 pounds per cubic yard of concrete and the water cement ratio shall not exceed 0.45. The slump of concrete shall be 3 to 5 inches. The Contractor shall proportion the concrete lining mix to provide a workable mix of uniform composition and consistency. Water-reducing, water-reducing and retarding, or high range water reducing admixtures may be used as needed to achieve the desired slump and workability. No water shall be added at the jobsite.
6. Voids under the structural plate shall be filled with concrete. The concrete shall be troweled to form a smooth, dense surface finish.
7. The concrete culvert lining shall be scored 3/4-inch deep laterally along the crest of the corrugations, 10-feet (max) on-center.
8. Apply one-foot wide coating of Emulsified Asphalt to the score lines on the existing concrete lining, to both edges of the new concrete lining, and to the 3/4-inch scores after the new concrete lining has cured. The finished coating shall be a continuous film free of voids, gaps or pin holes.
9. All construction joints shall be perpendicular to the surface and to the full depth of the concrete lining.

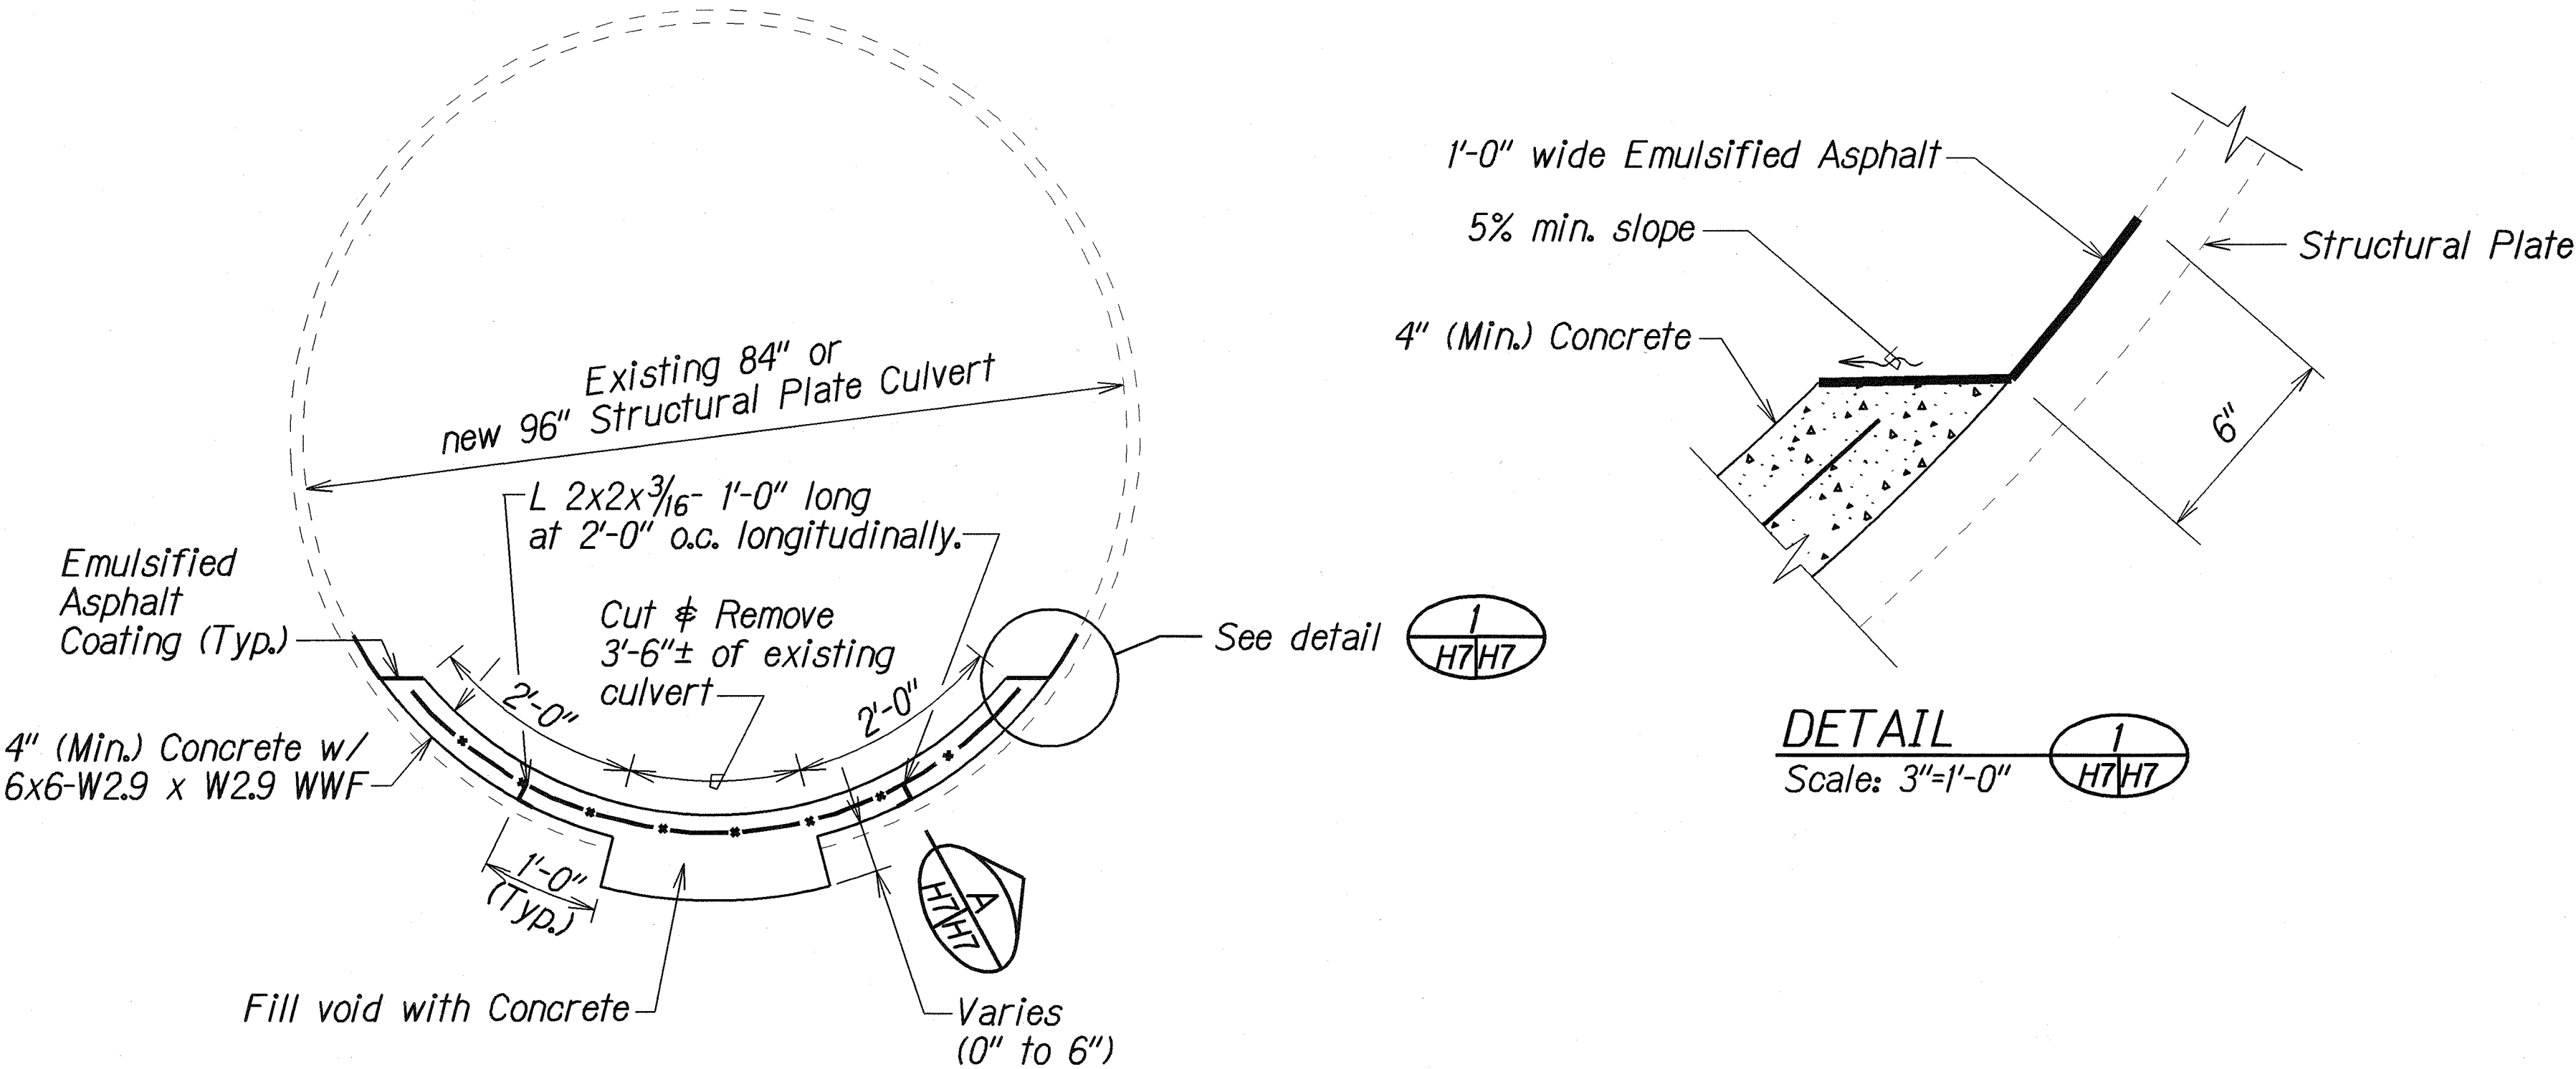

TYPICAL SECTION OF CULVERT

Scale: 3/4"=1'-0"

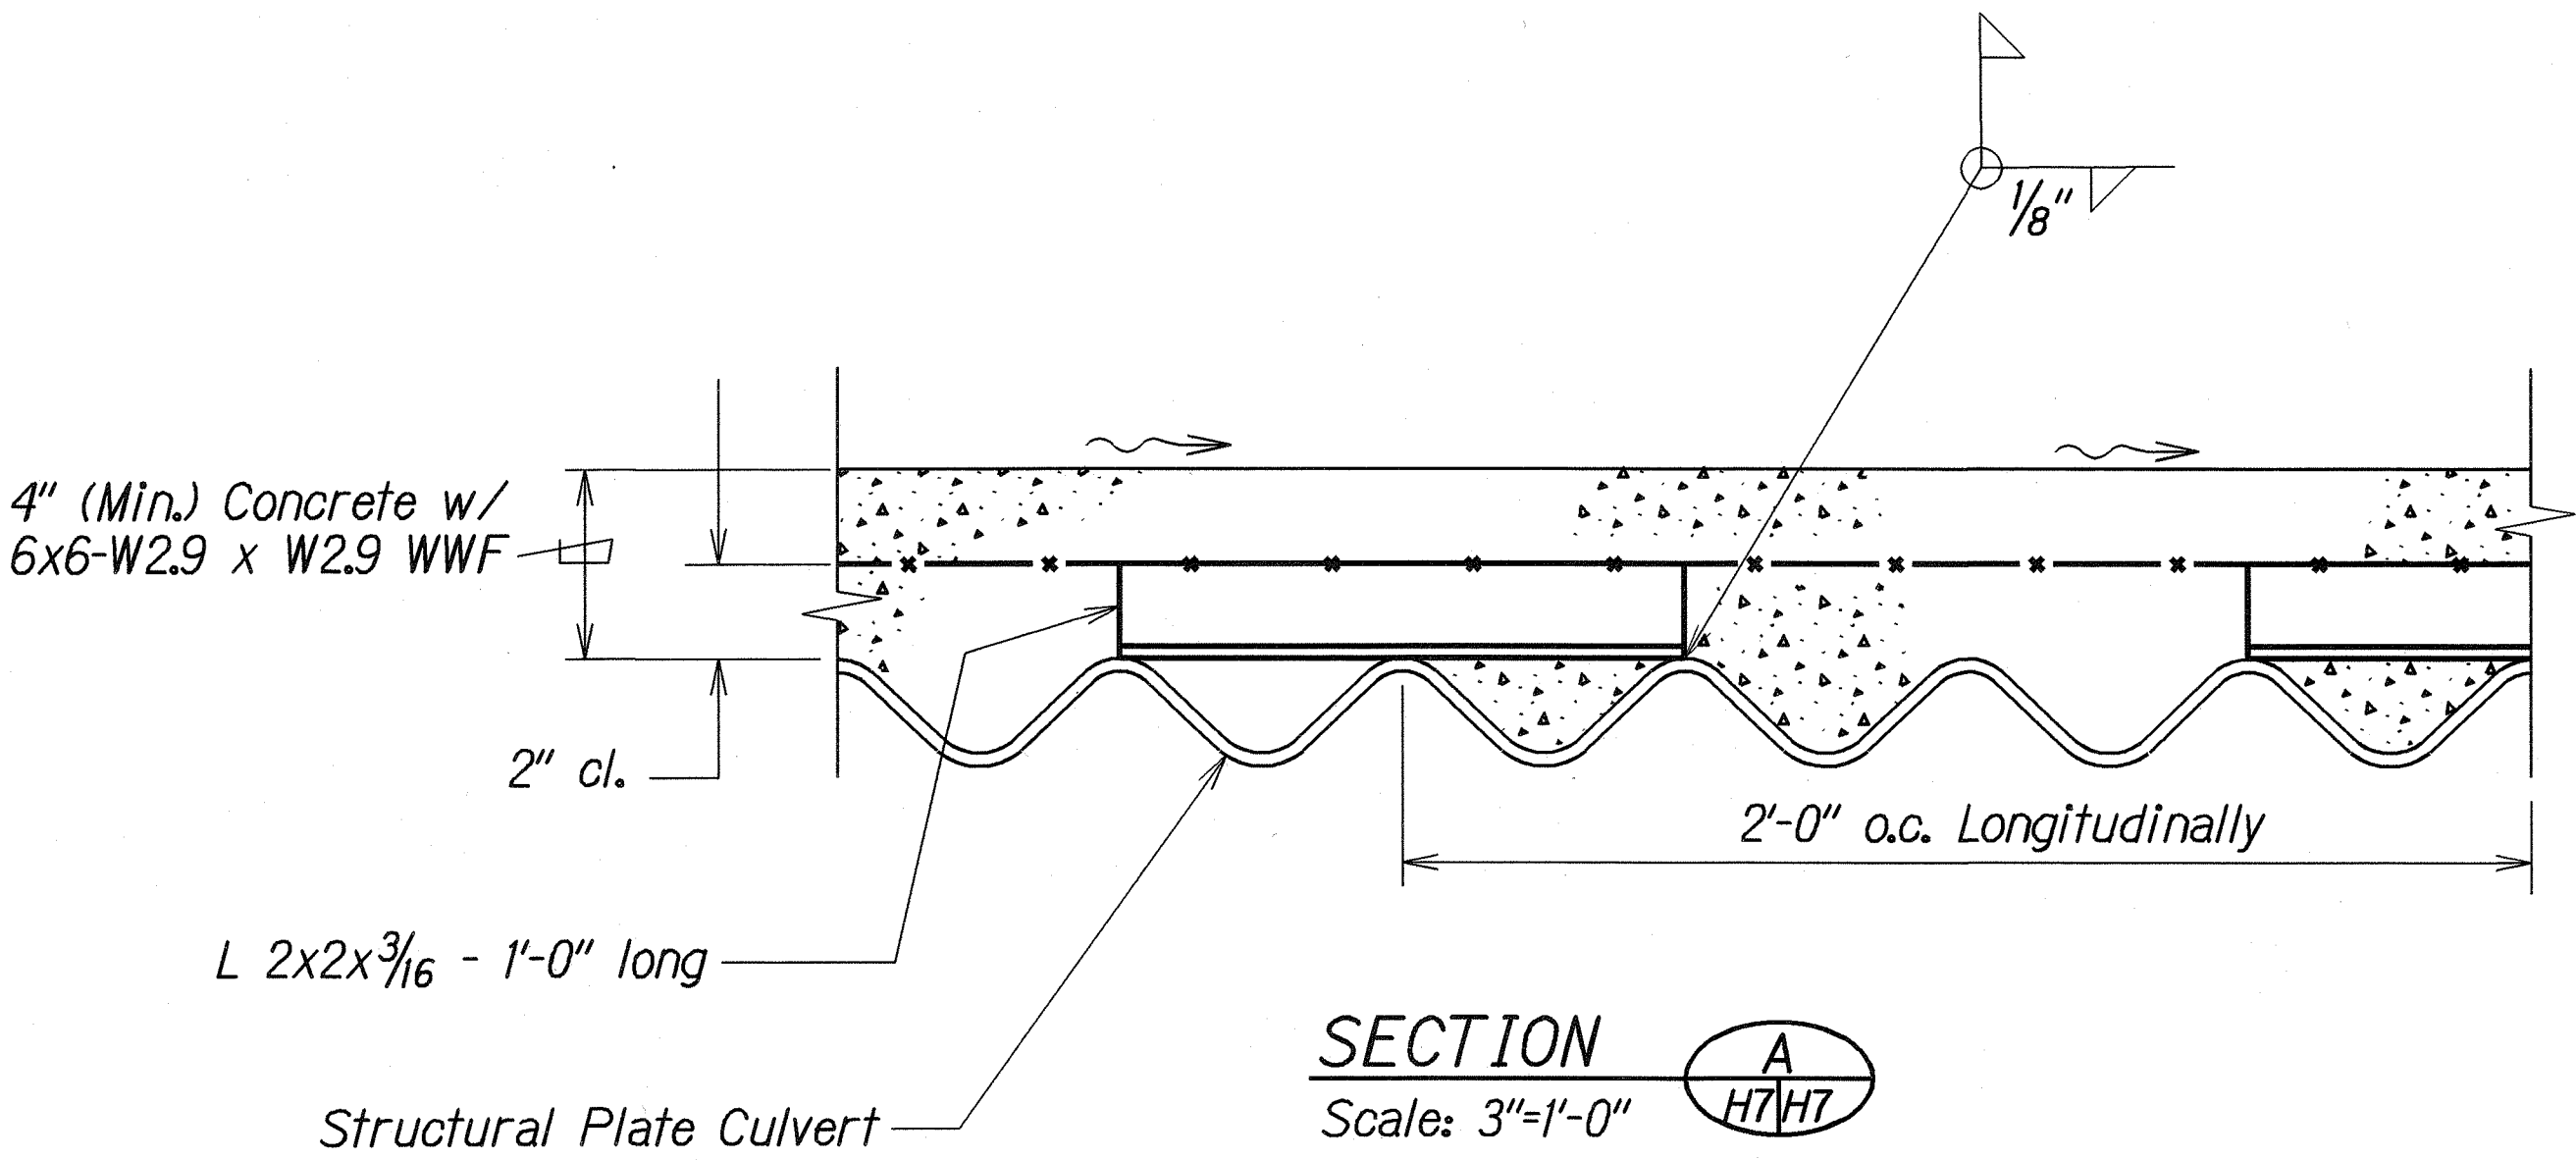

SECTION A

Scale: 3"=1'-0"

DETAILS OF CONCRETE CULVERT LINING

8/15/05 Removed Longitudinal Rebars

DATE REVISION

STATE OF HAWAII
DEPARTMENT OF TRANSPORTATION
HIGHWAYS DIVISION

DRAINAGE DETAIL
KALANIANA'OLE HIGHWAY
DRAINAGE IMPROVEMENTS
Vicinity of Keolu Hills
Fed. Aid Project No. DE-072-1(48)R



Scale: 3/4"=1'-0"

Date: May, 2005

SHEET No. H7 OF 9 SHEETS

ADD 12

FED. ROAD DIST. NO.	STATE	FED. AID PROJ. NO.	FISCAL YEAR	SHEET NO.	TOTAL SHEETS
HAWAII	HAW.	DE-072-1(48)R	2006	000	20

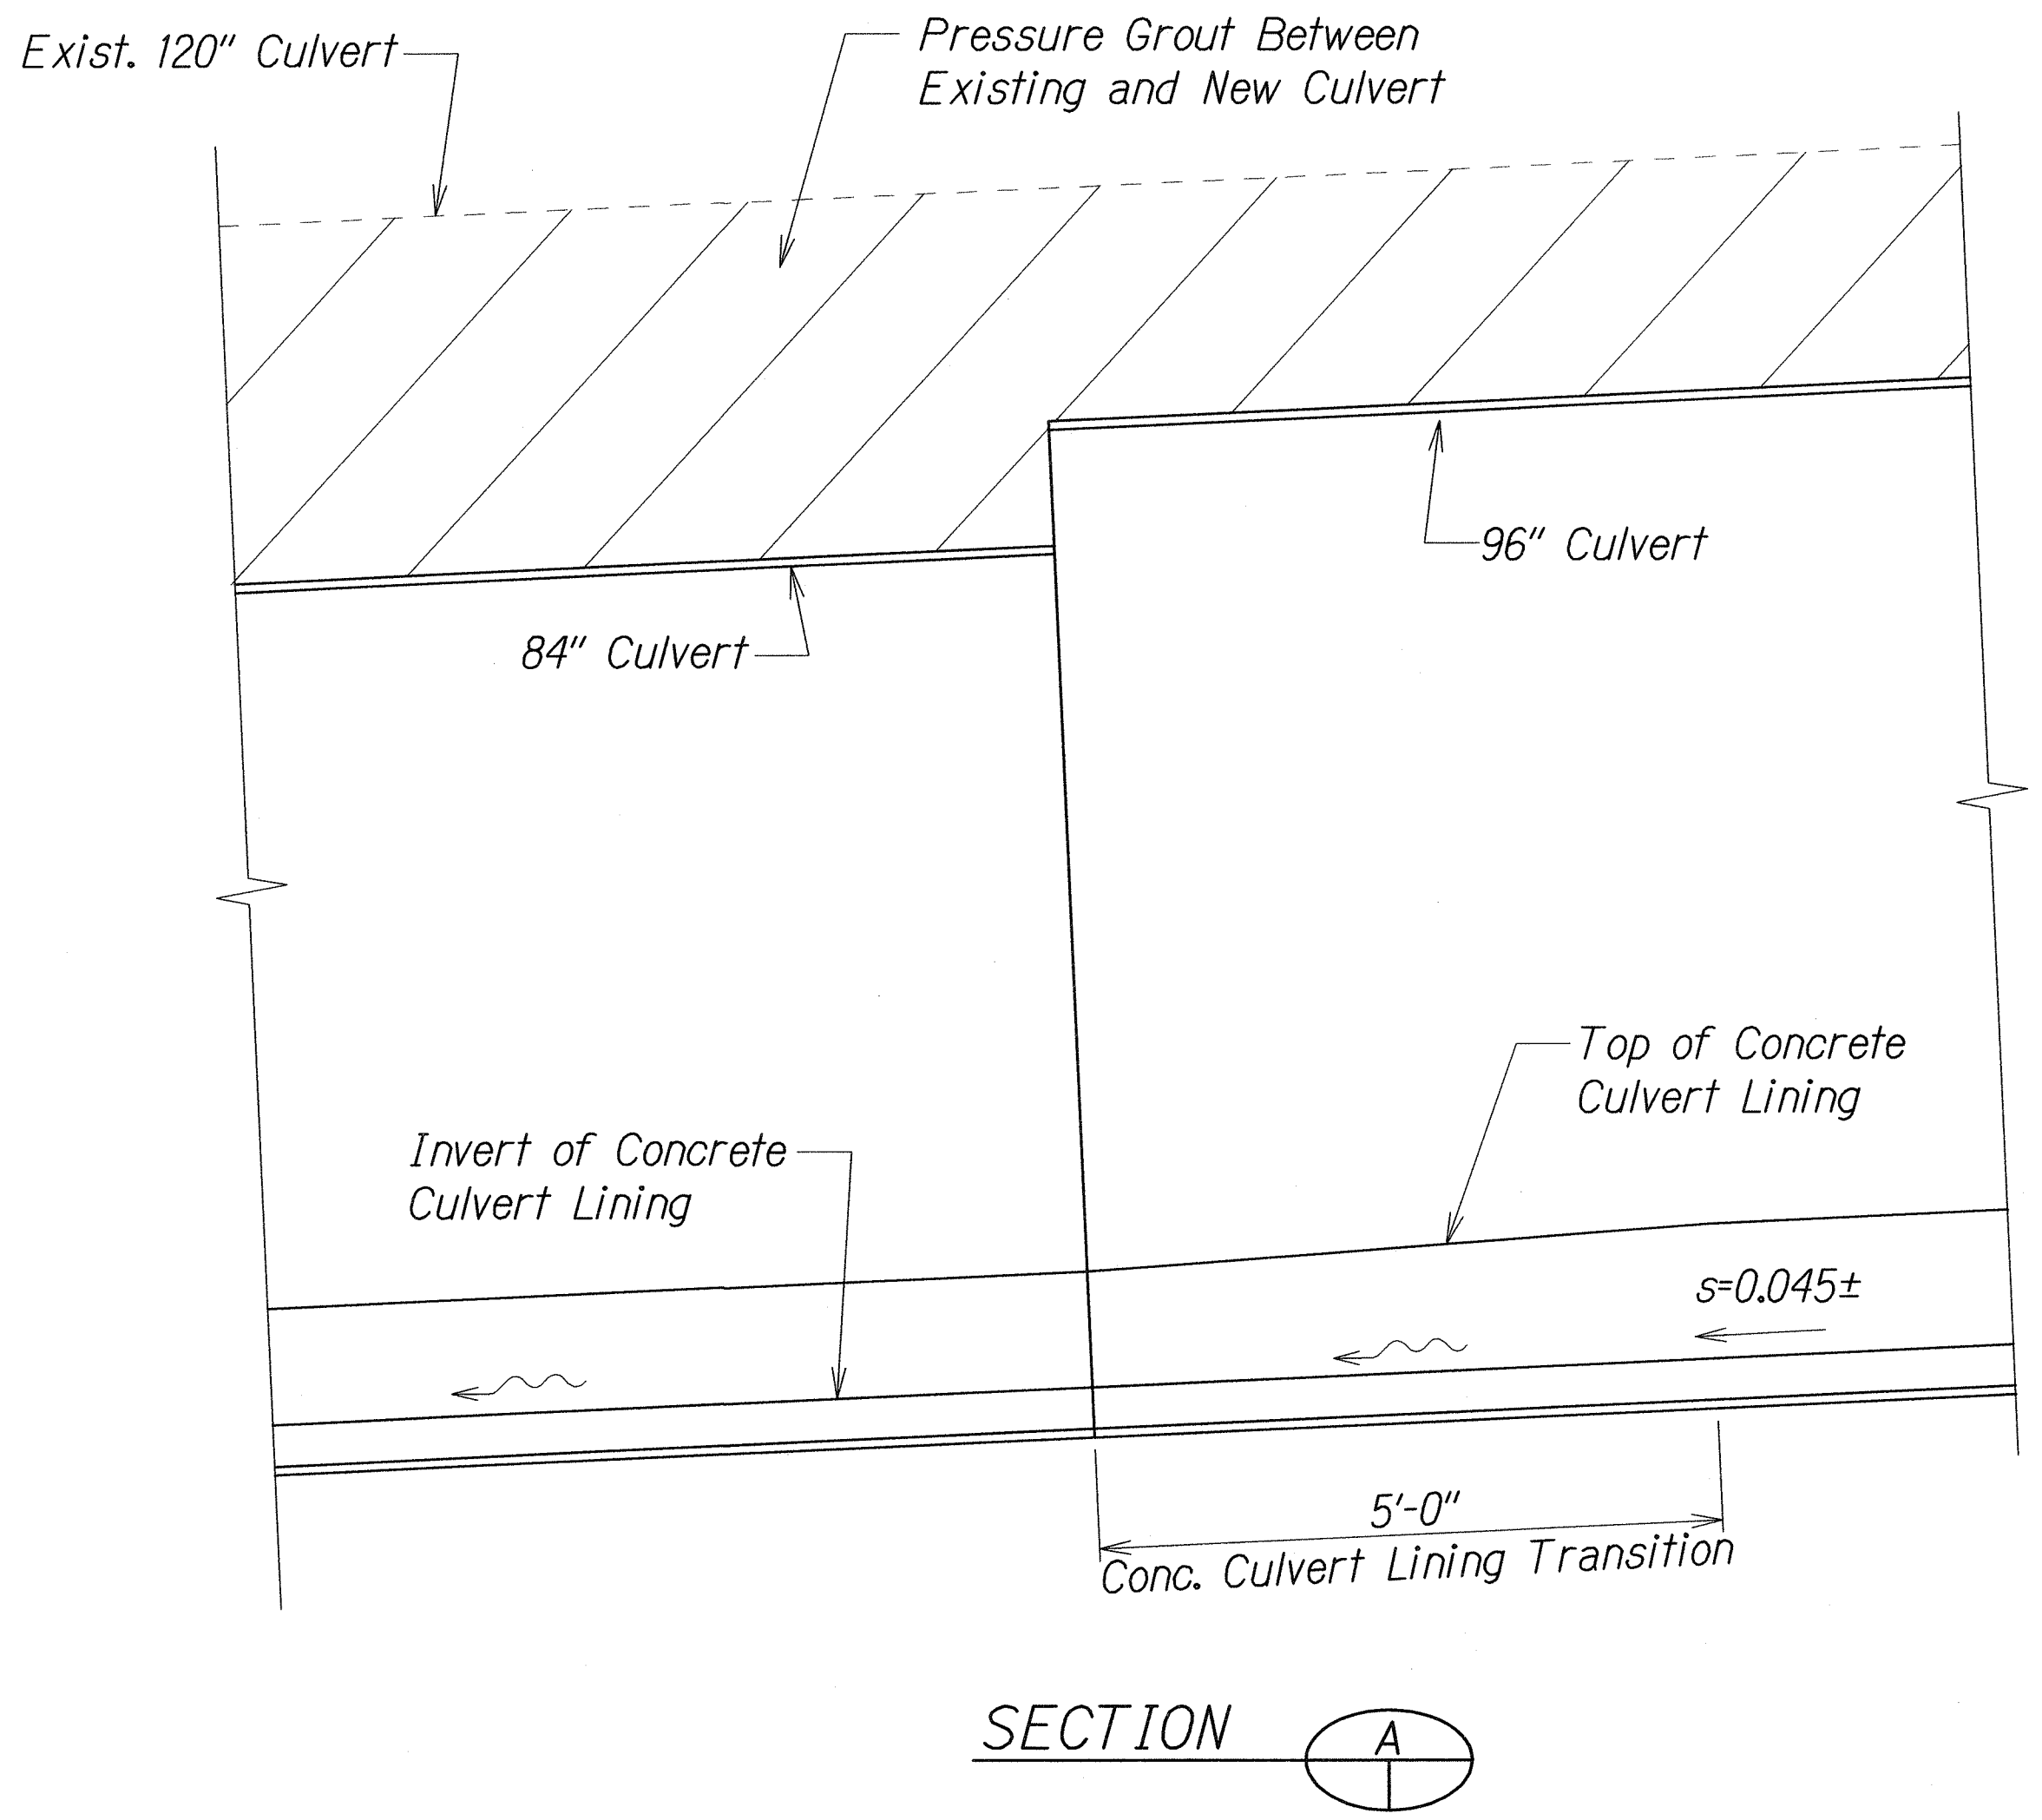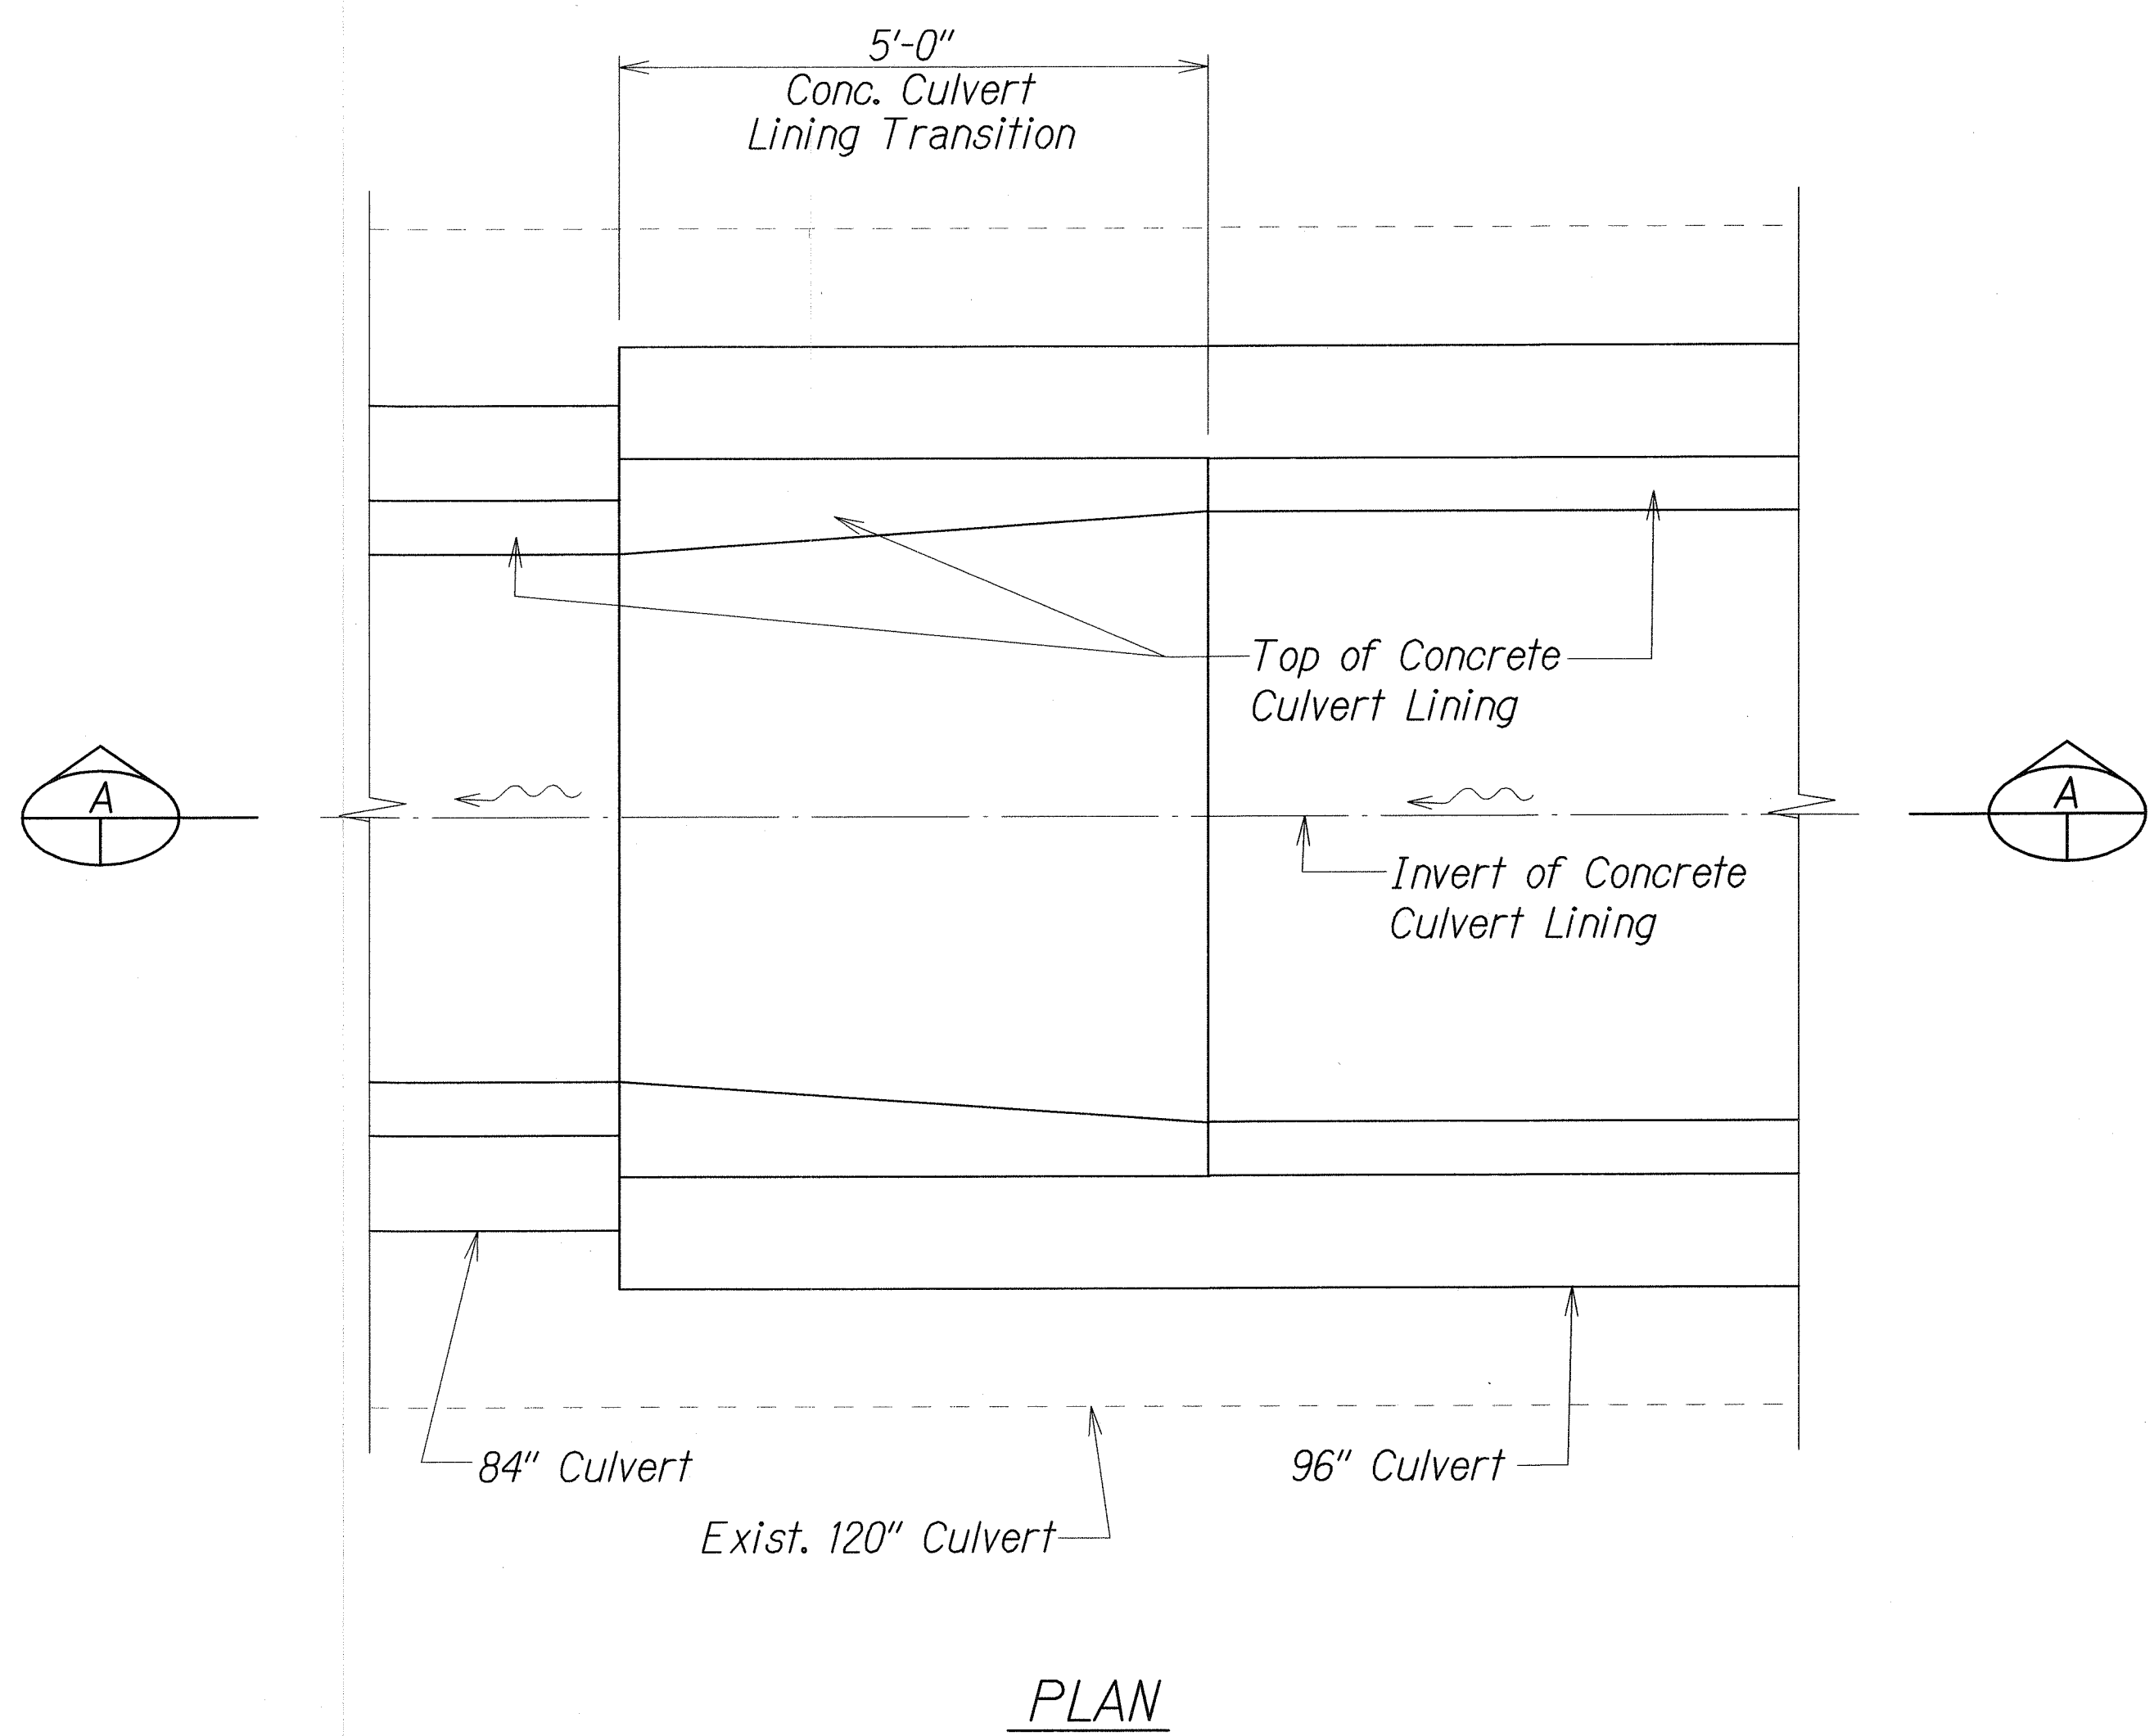

ORIGINAL PLAN	SURVEY PLOTTED BY	DATE
NOTE BOOK	DRAWN BY	1/09/03
DESIGNED BY	CHECKED BY	
CHECKED BY		

DETAILS OF CONCRETE CULVERT TRANSITION

12/21/06 Added Plan Sht. C.O. ADD. 12 S-1

DATE REVISION


STATE OF HAWAII
DEPARTMENT OF TRANSPORTATION
HIGHWAYS DIVISION

DRAINAGE DETAIL
KALANIANA'OLE HIGHWAY
DRAINAGE IMPROVEMENTS
Vicinity of Keolu Hills
Fed. Aid Project No. DE-072-1(48)R
Scale: 3/4"=1'-0" Date: May, 2005

SHEET No. H7a OF 9 SHEETS

C.O. ADD. 12 S-1

FED. ROAD DIST. NO.	STATE	FED. AID PROJ. NO.	FISCAL YEAR	SHEET NO.	TOTAL SHEETS
HAWAII	HAW.	DE-072-1(48)R	2006	C.O.13	20

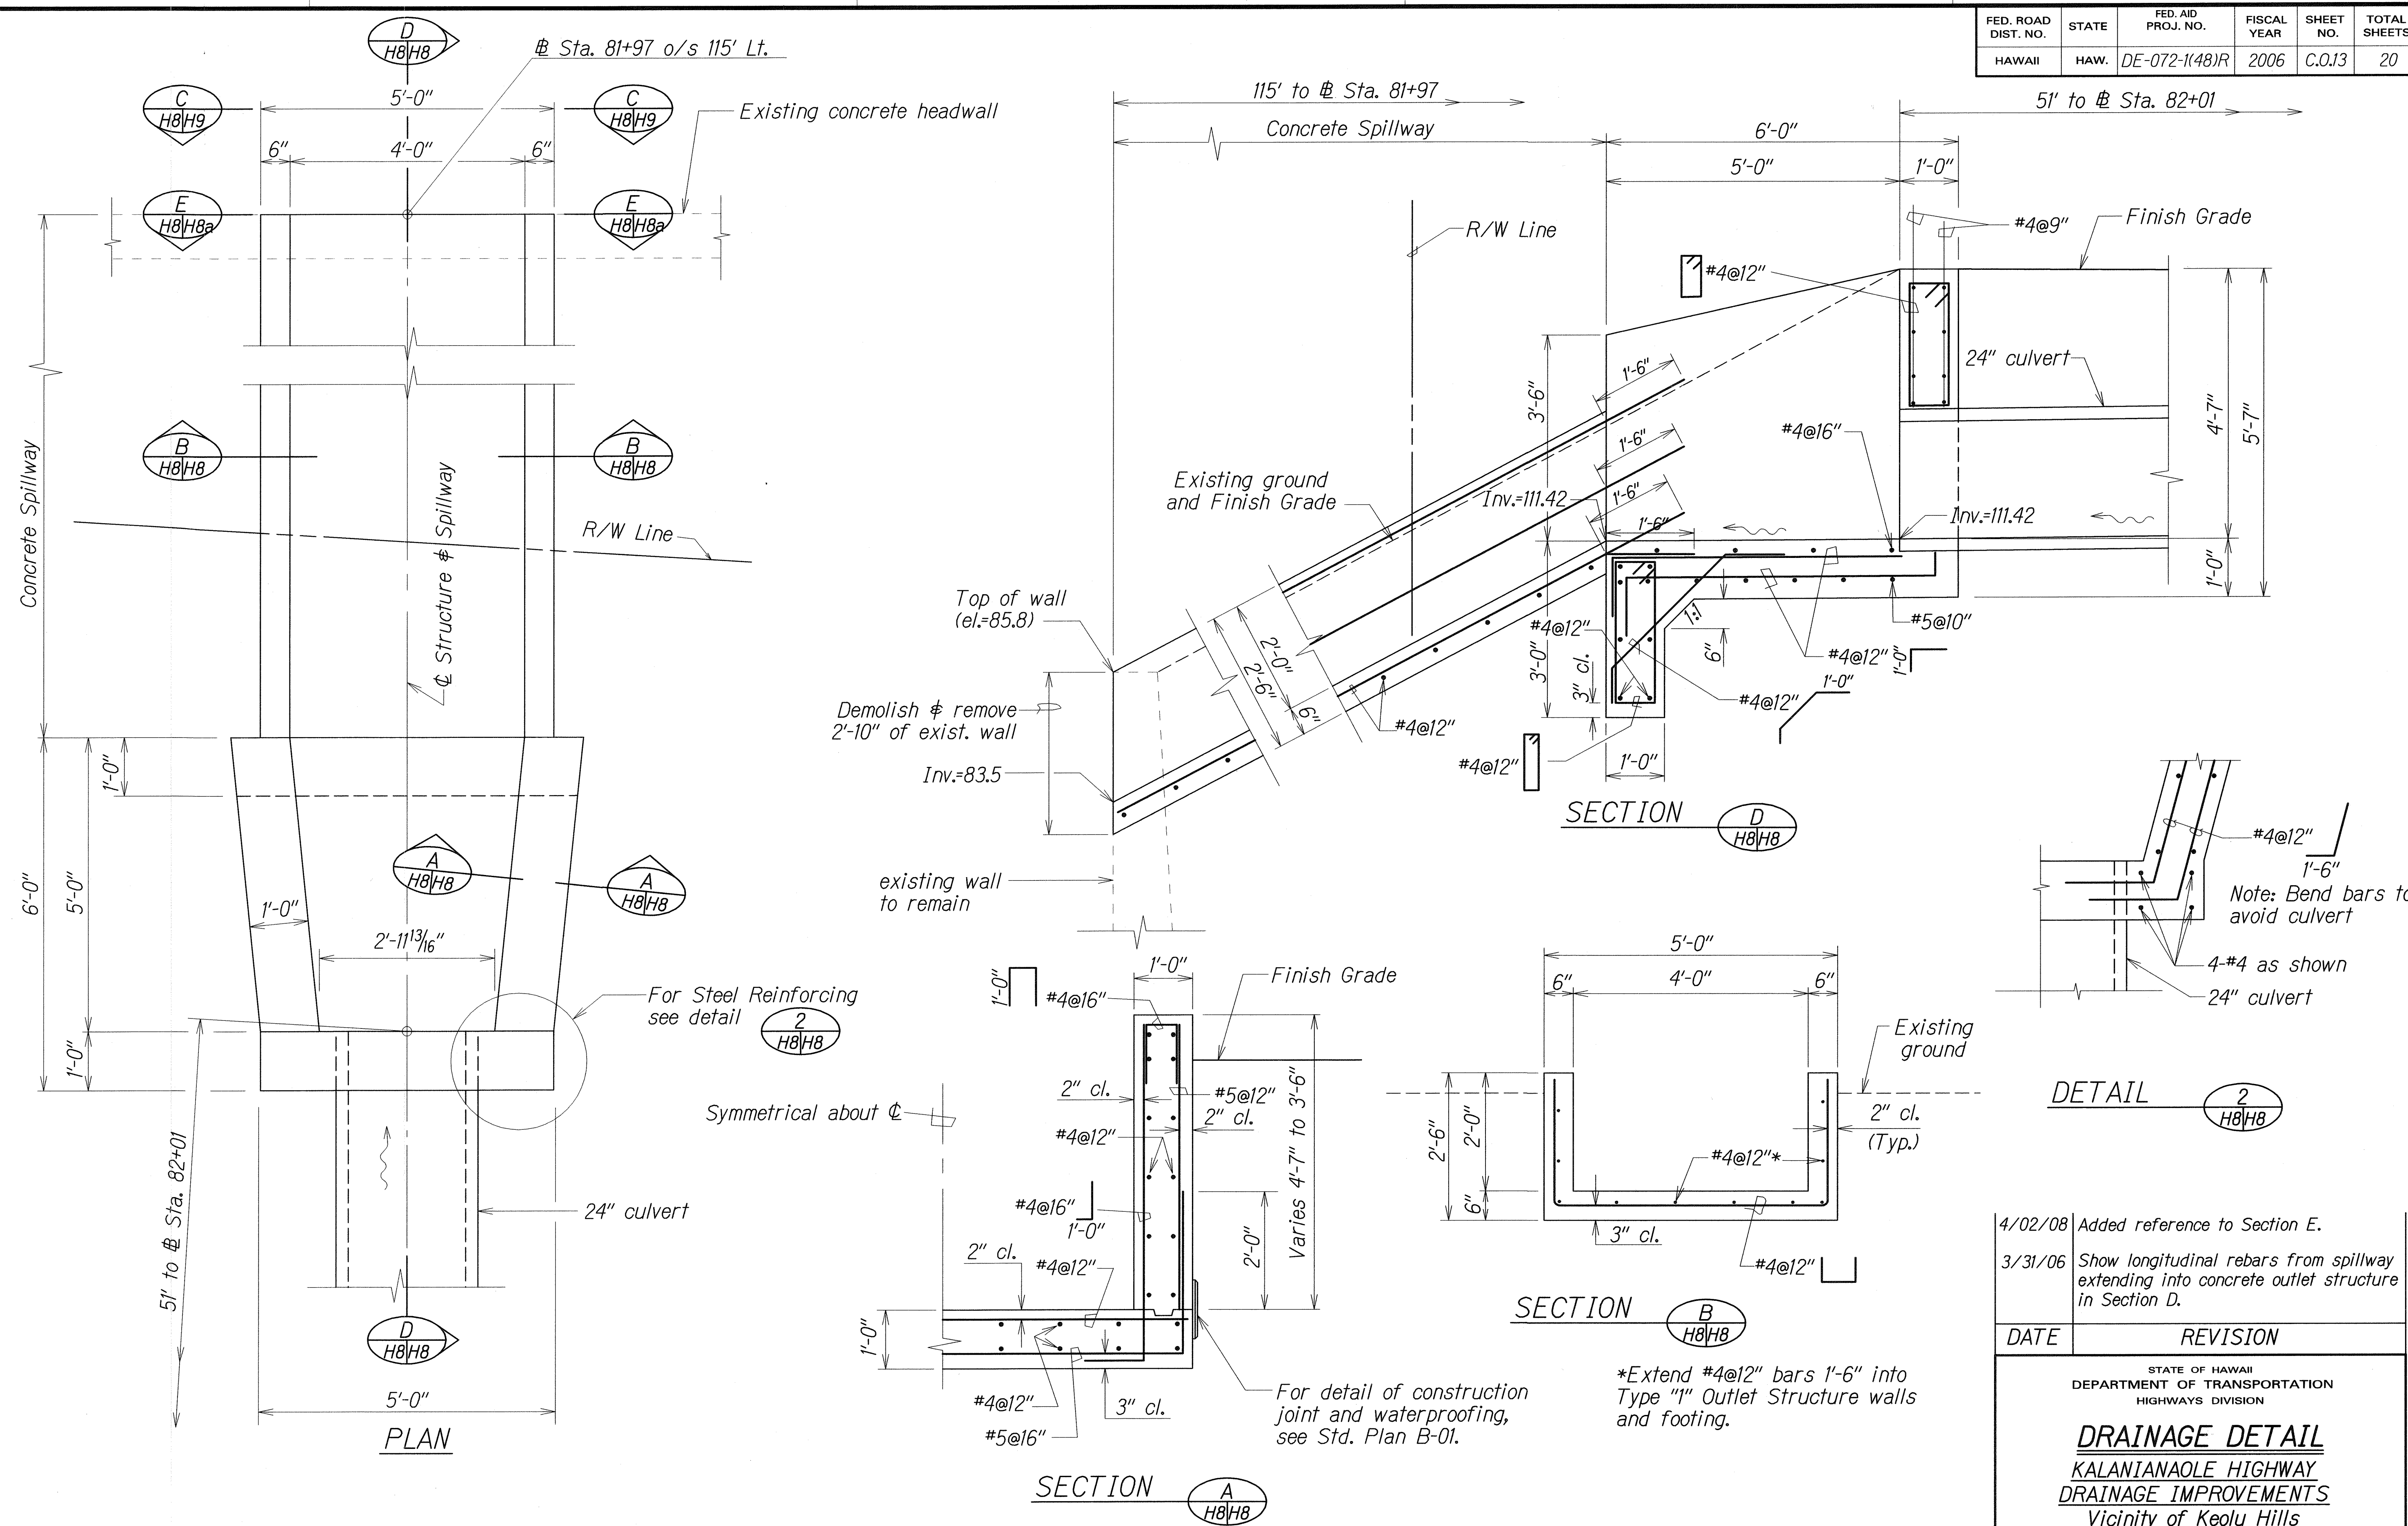


DETAILS OF TYPE "I" OUTLET STRUCTURE AND CONCRETE SPILLWAY AT STA. 82+01 O/S 51' LT.

DATE	REVISION
4/02/08	Added reference to Section E.
3/31/06	Show longitudinal rebars from spillway extending into concrete outlet structure in Section D.


STATE OF HAWAII DEPARTMENT OF TRANSPORTATION HIGHWAYS DIVISION
DRAINAGE DETAIL
KALANIANA'OLE HIGHWAY
DRAINAGE IMPROVEMENTS
Vicinity of Keolu Hills
Fed. Aid Project No. DE-072-1(48)R
Scale: 3/4"=1'-0"
Date: May, 2005

SHEET No. H8 OF 9 SHEETS

FED. ROAD DIST. NO.	STATE	FED. AID PROJ. NO.	FISCAL YEAR	SHEET NO.	TOTAL SHEETS
HAWAII	HAW.	DE-072-1(48)R	2006	C.O.14	20

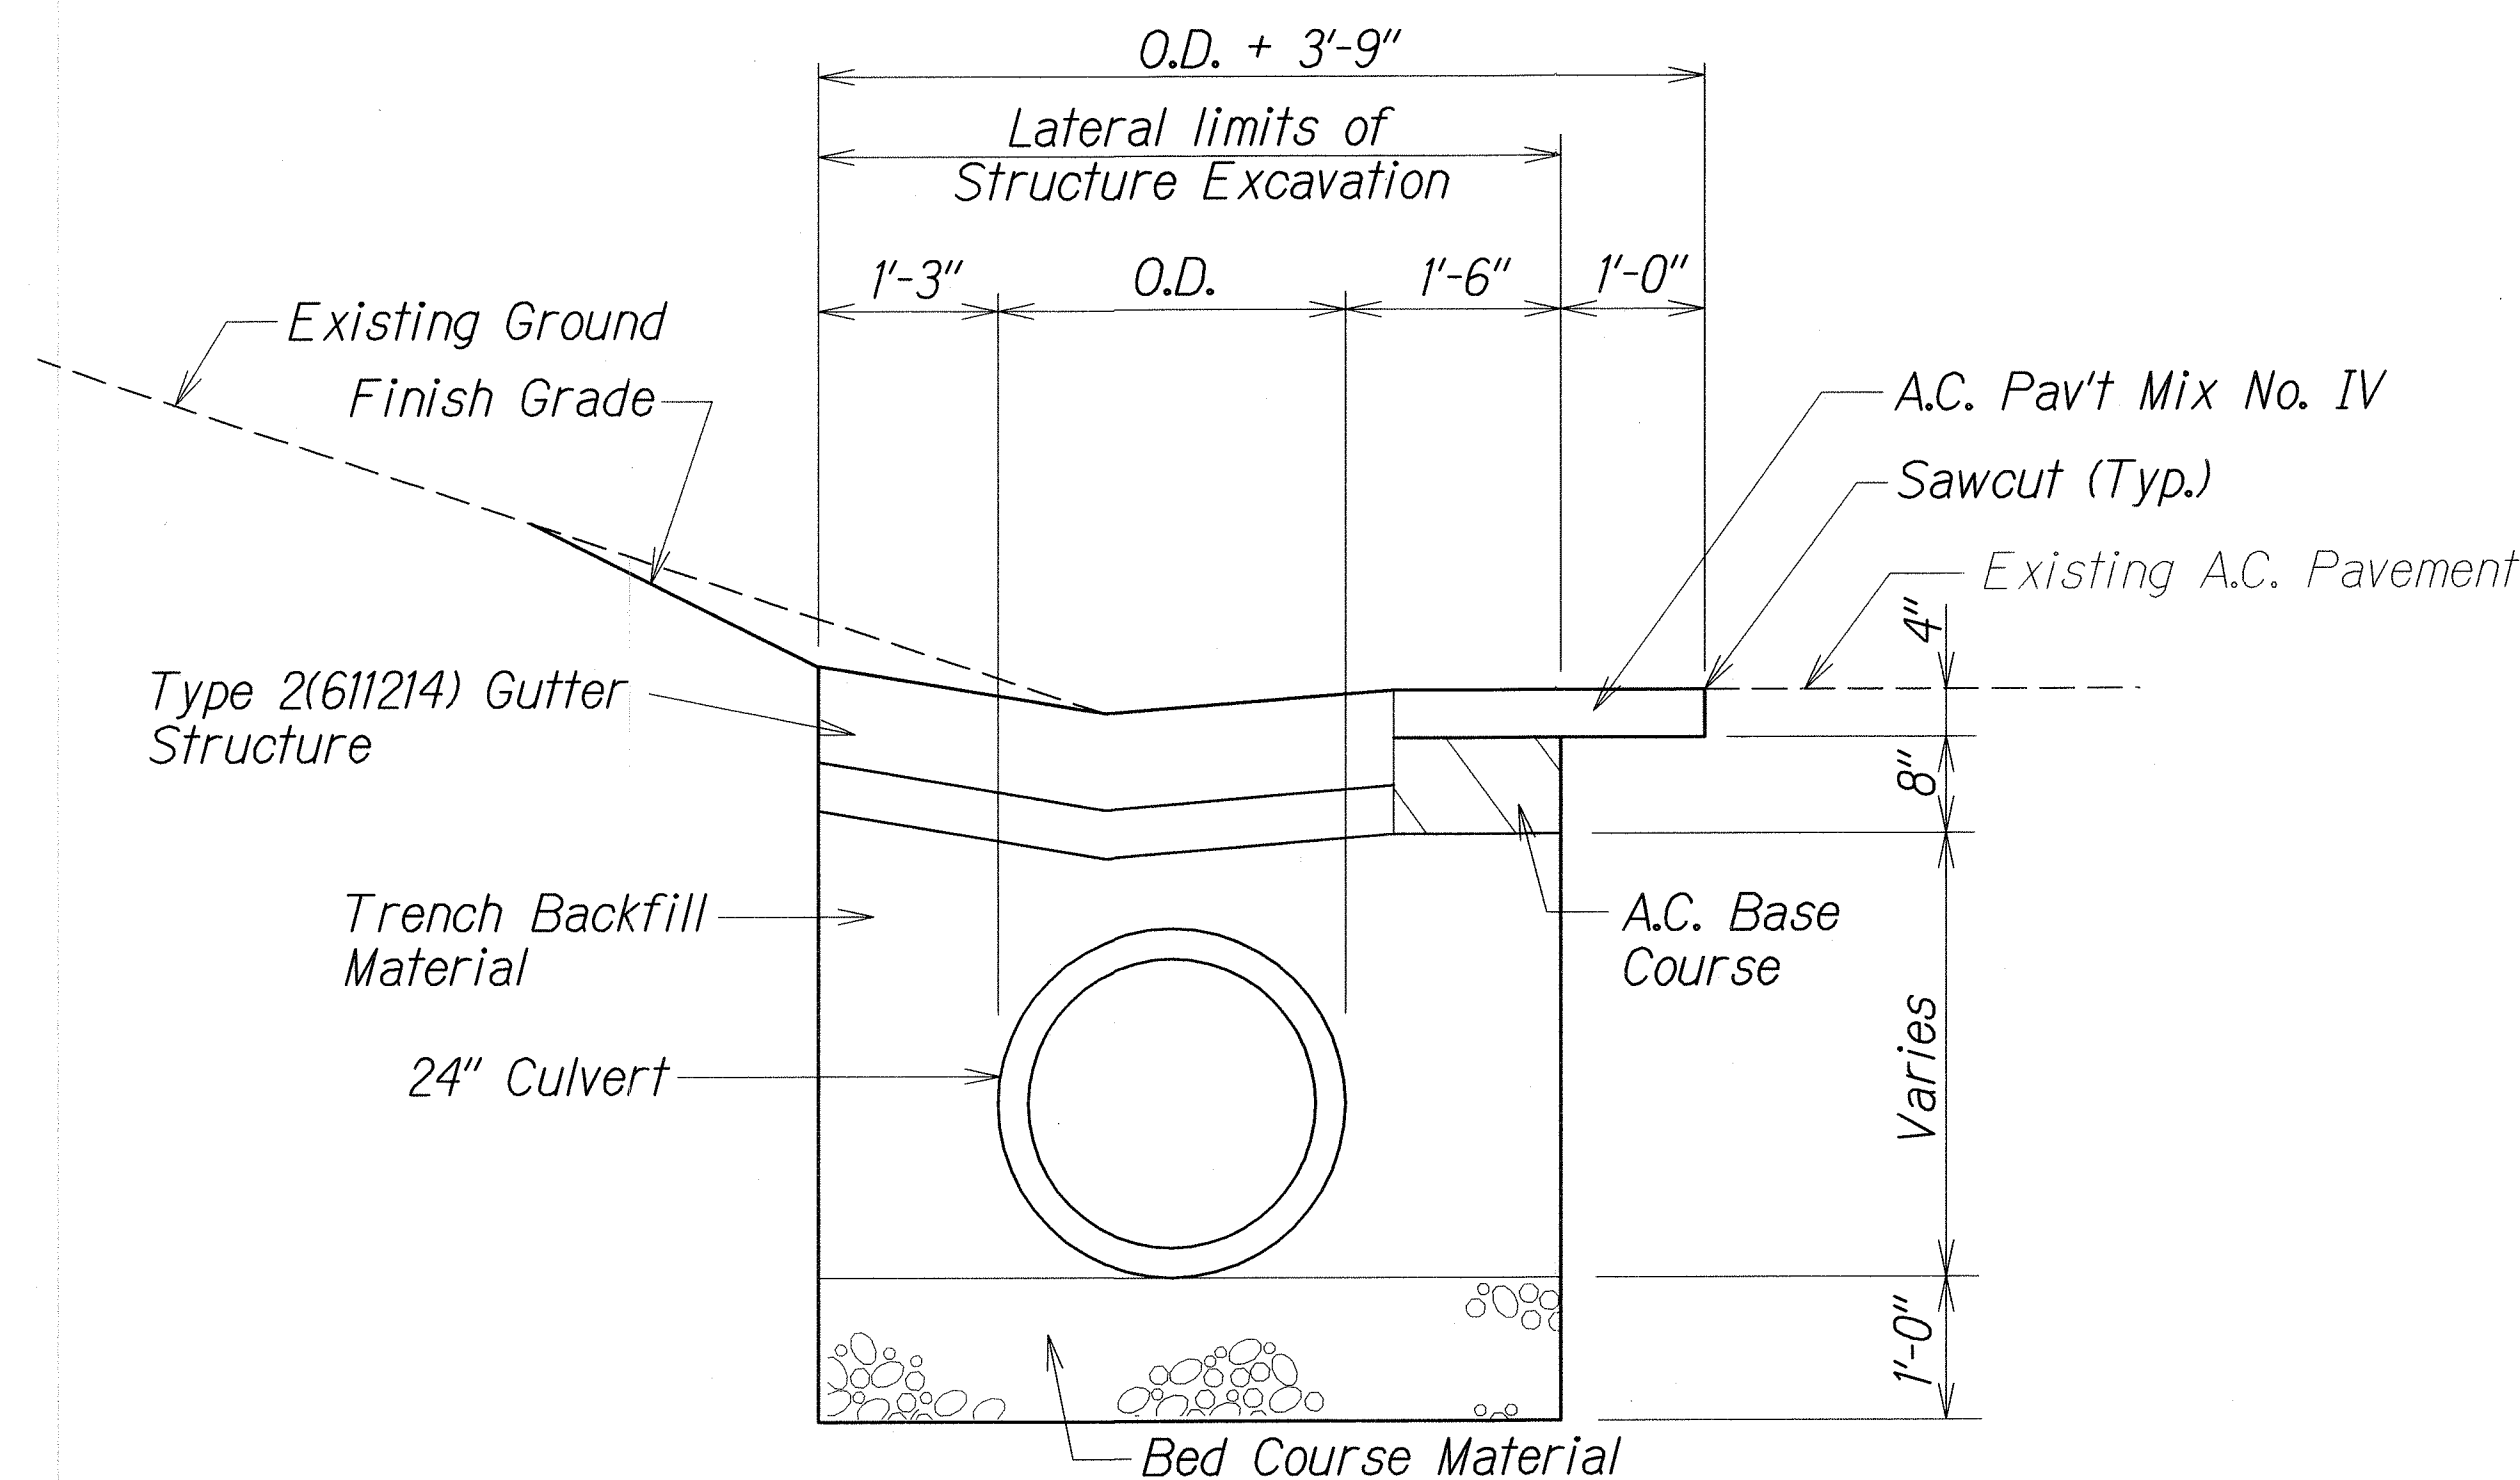


± STA. 78+00 LT. TO STA. 79+50 LT.

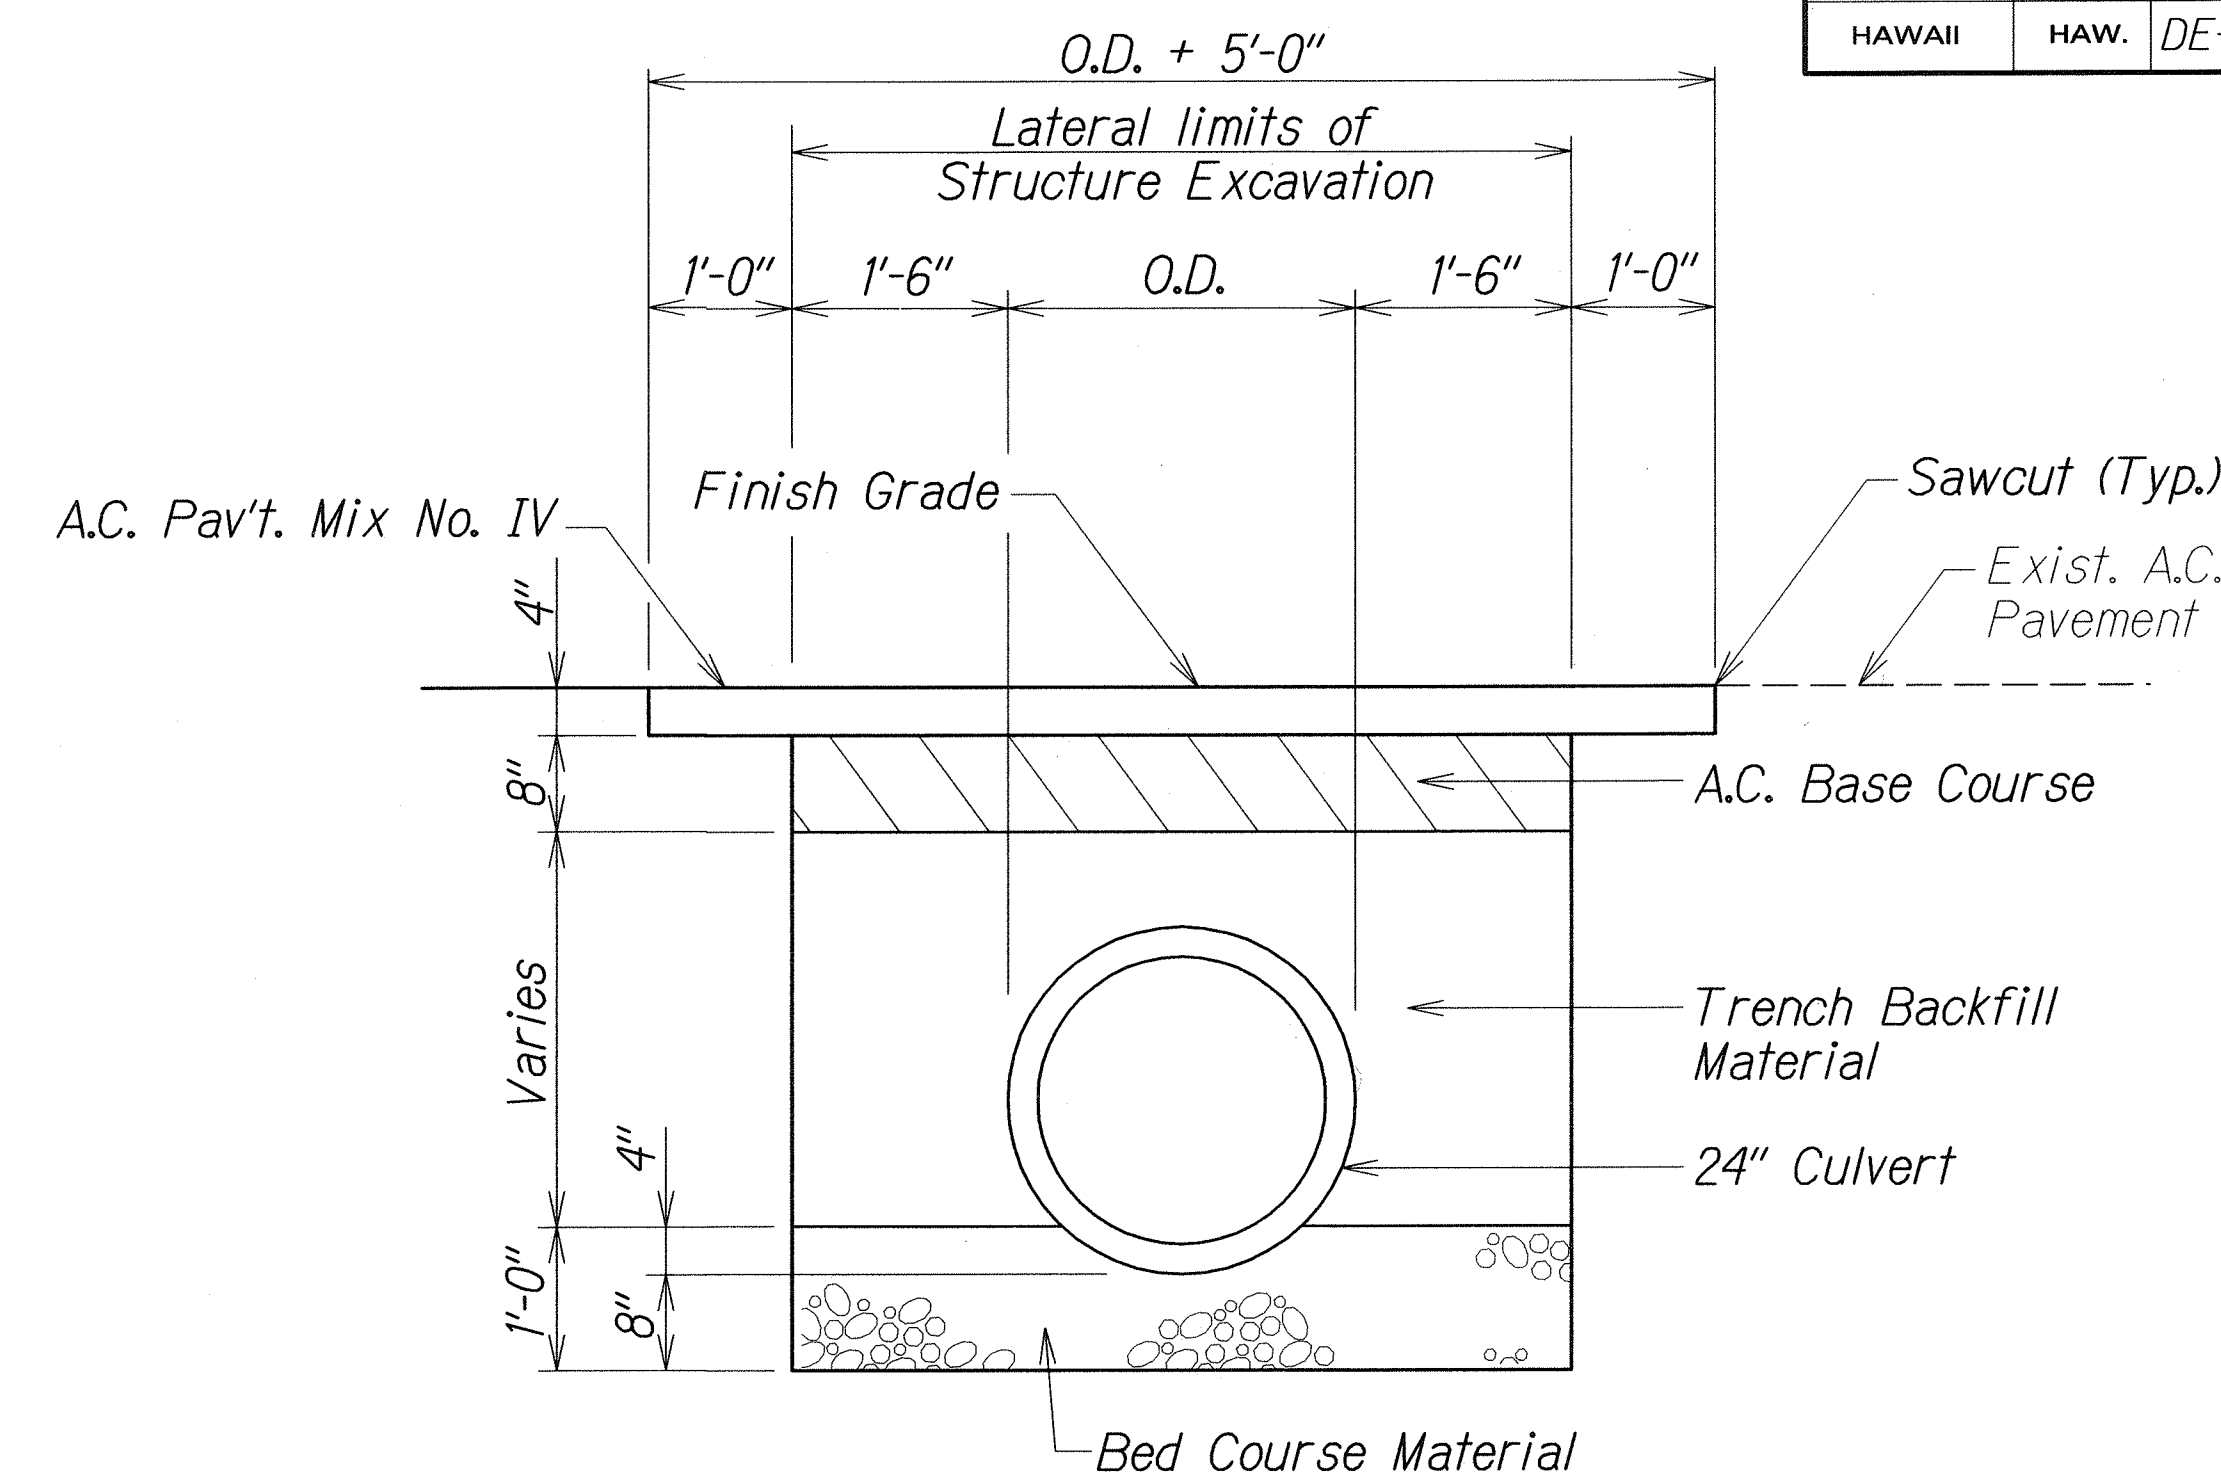

± STA. 79+50 LT. TO STA. 82+01 LT.

DETAILS OF CULVERT TRENCH RESTORATION


Scale: 3/4"=1'-0"

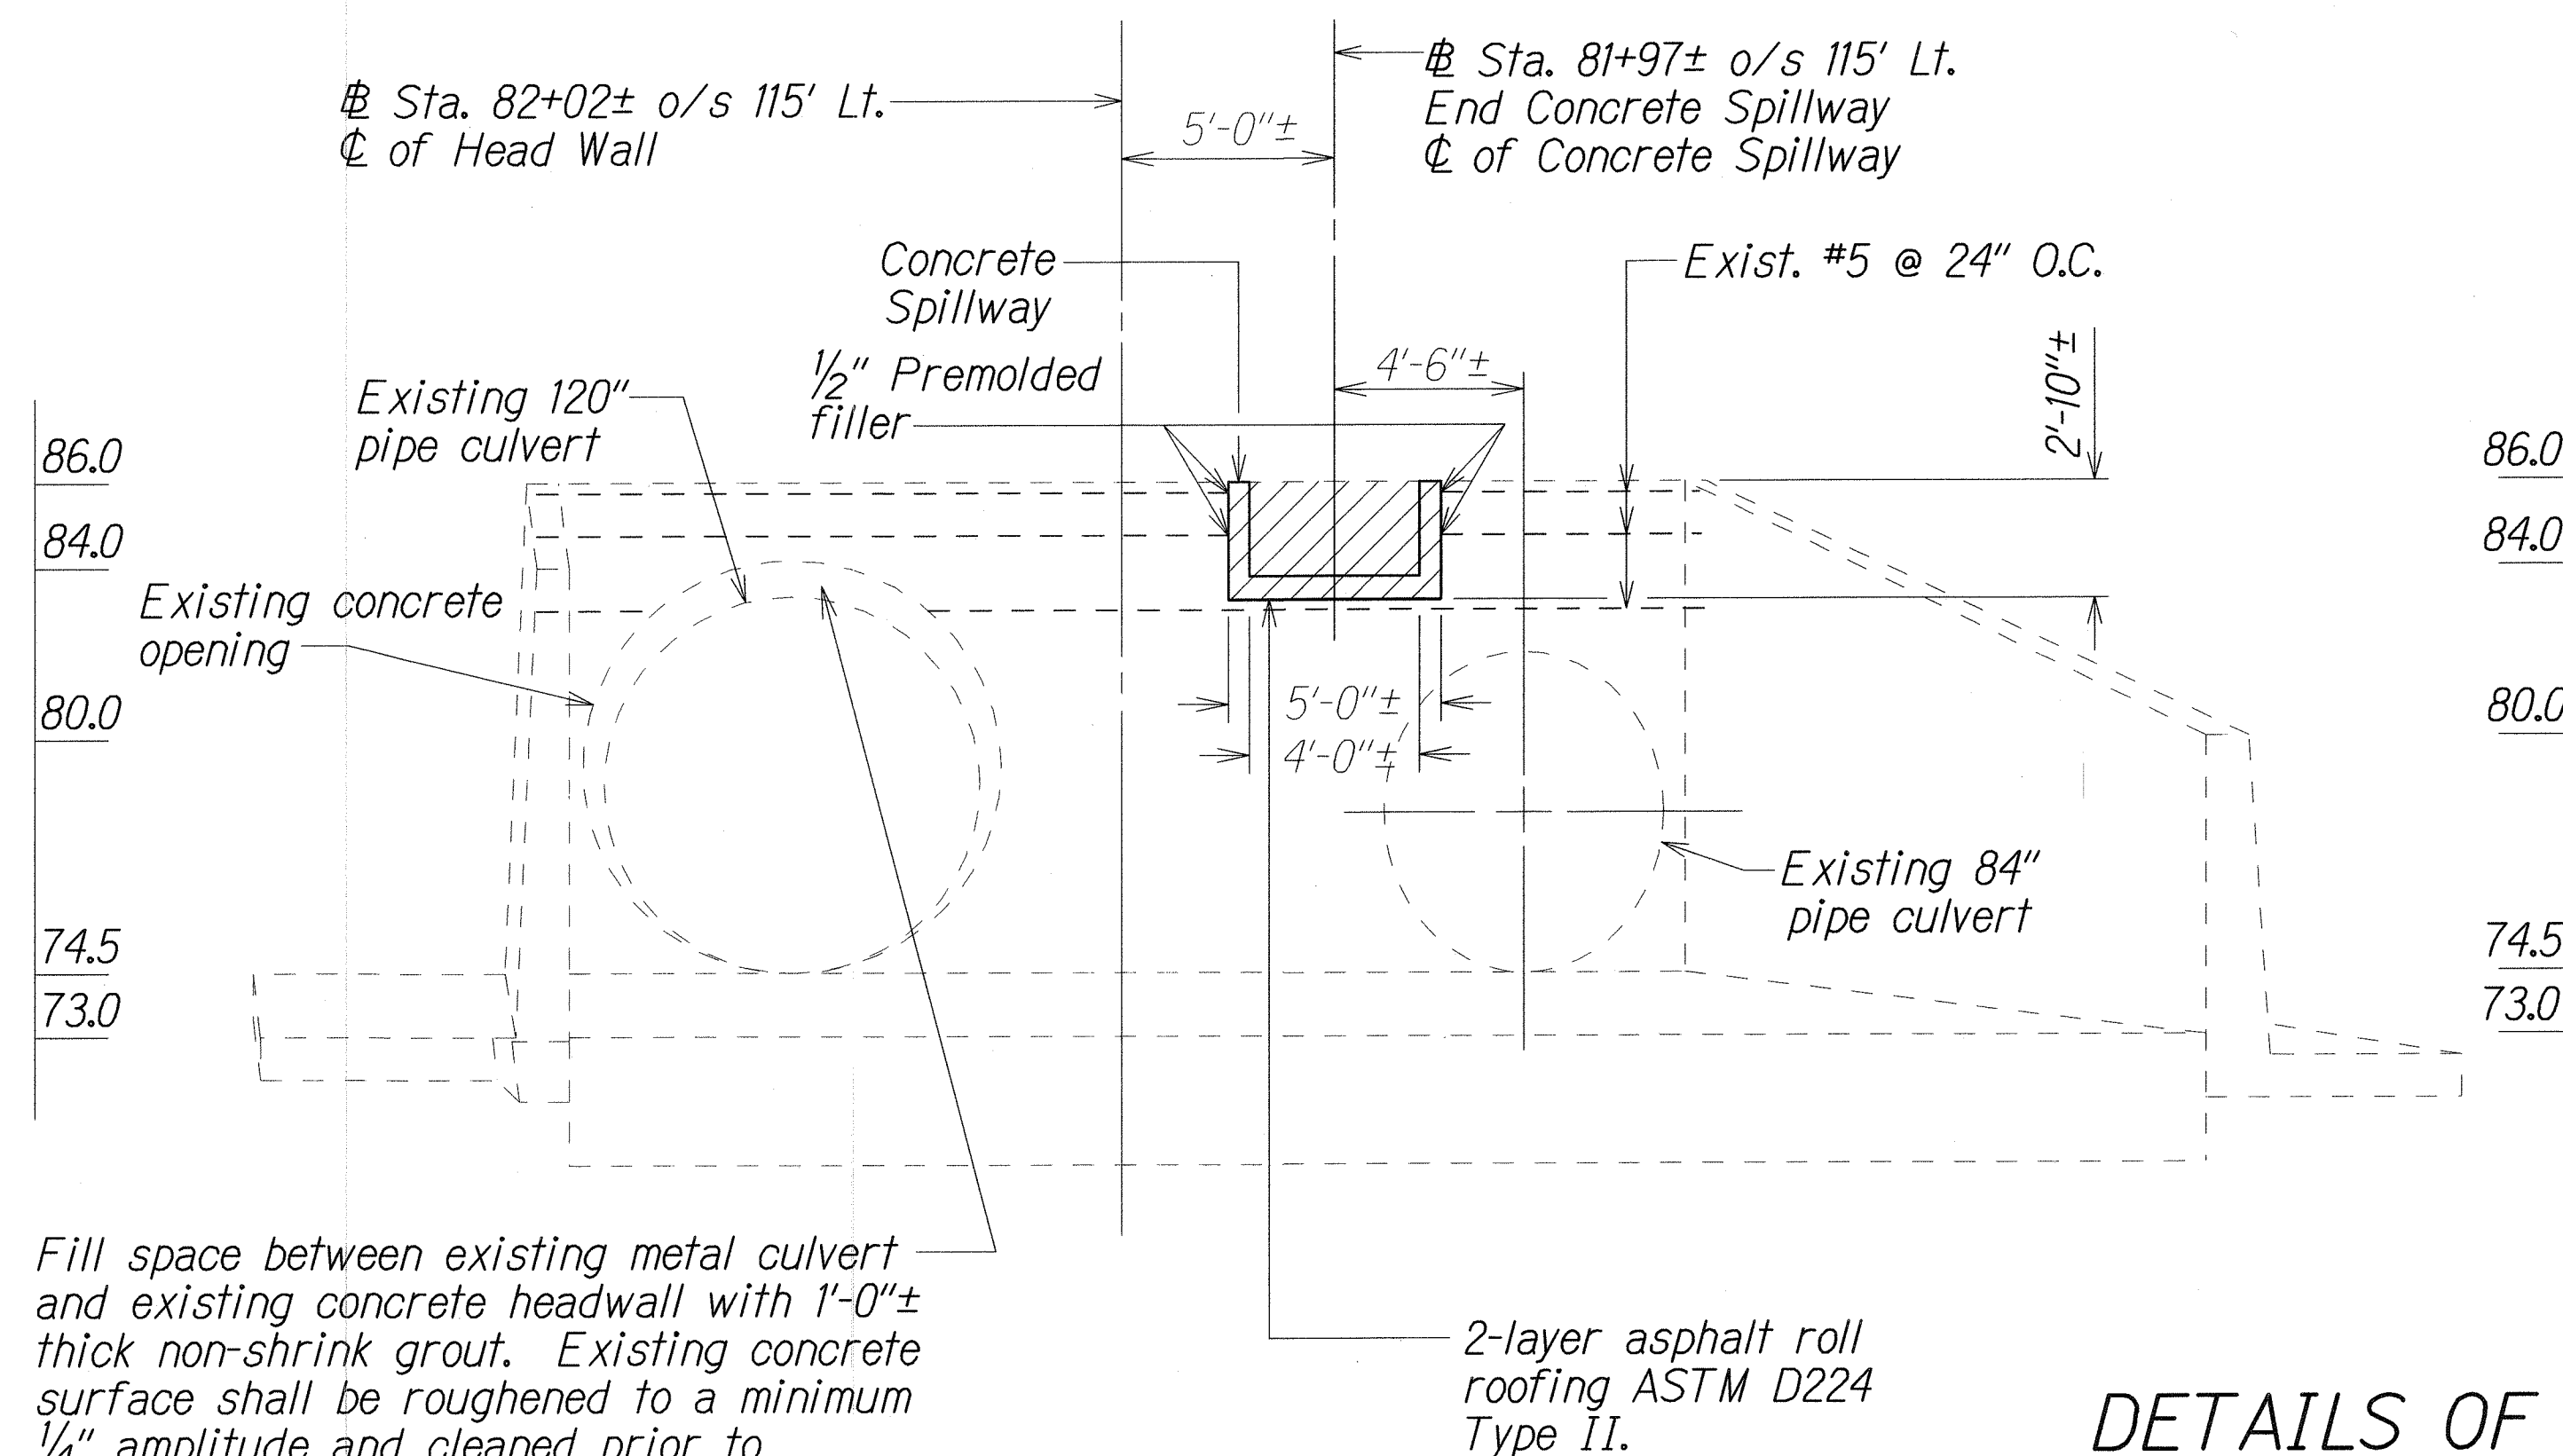

SECTION
Scale: 1/4"=1'-0"

C
H8/H9

DETAILS OF TYPE "I" OUTLET STRUCTURE AND CONCRETE SPILLWAY AT ± STA. 82+01 O/S 51' LT.

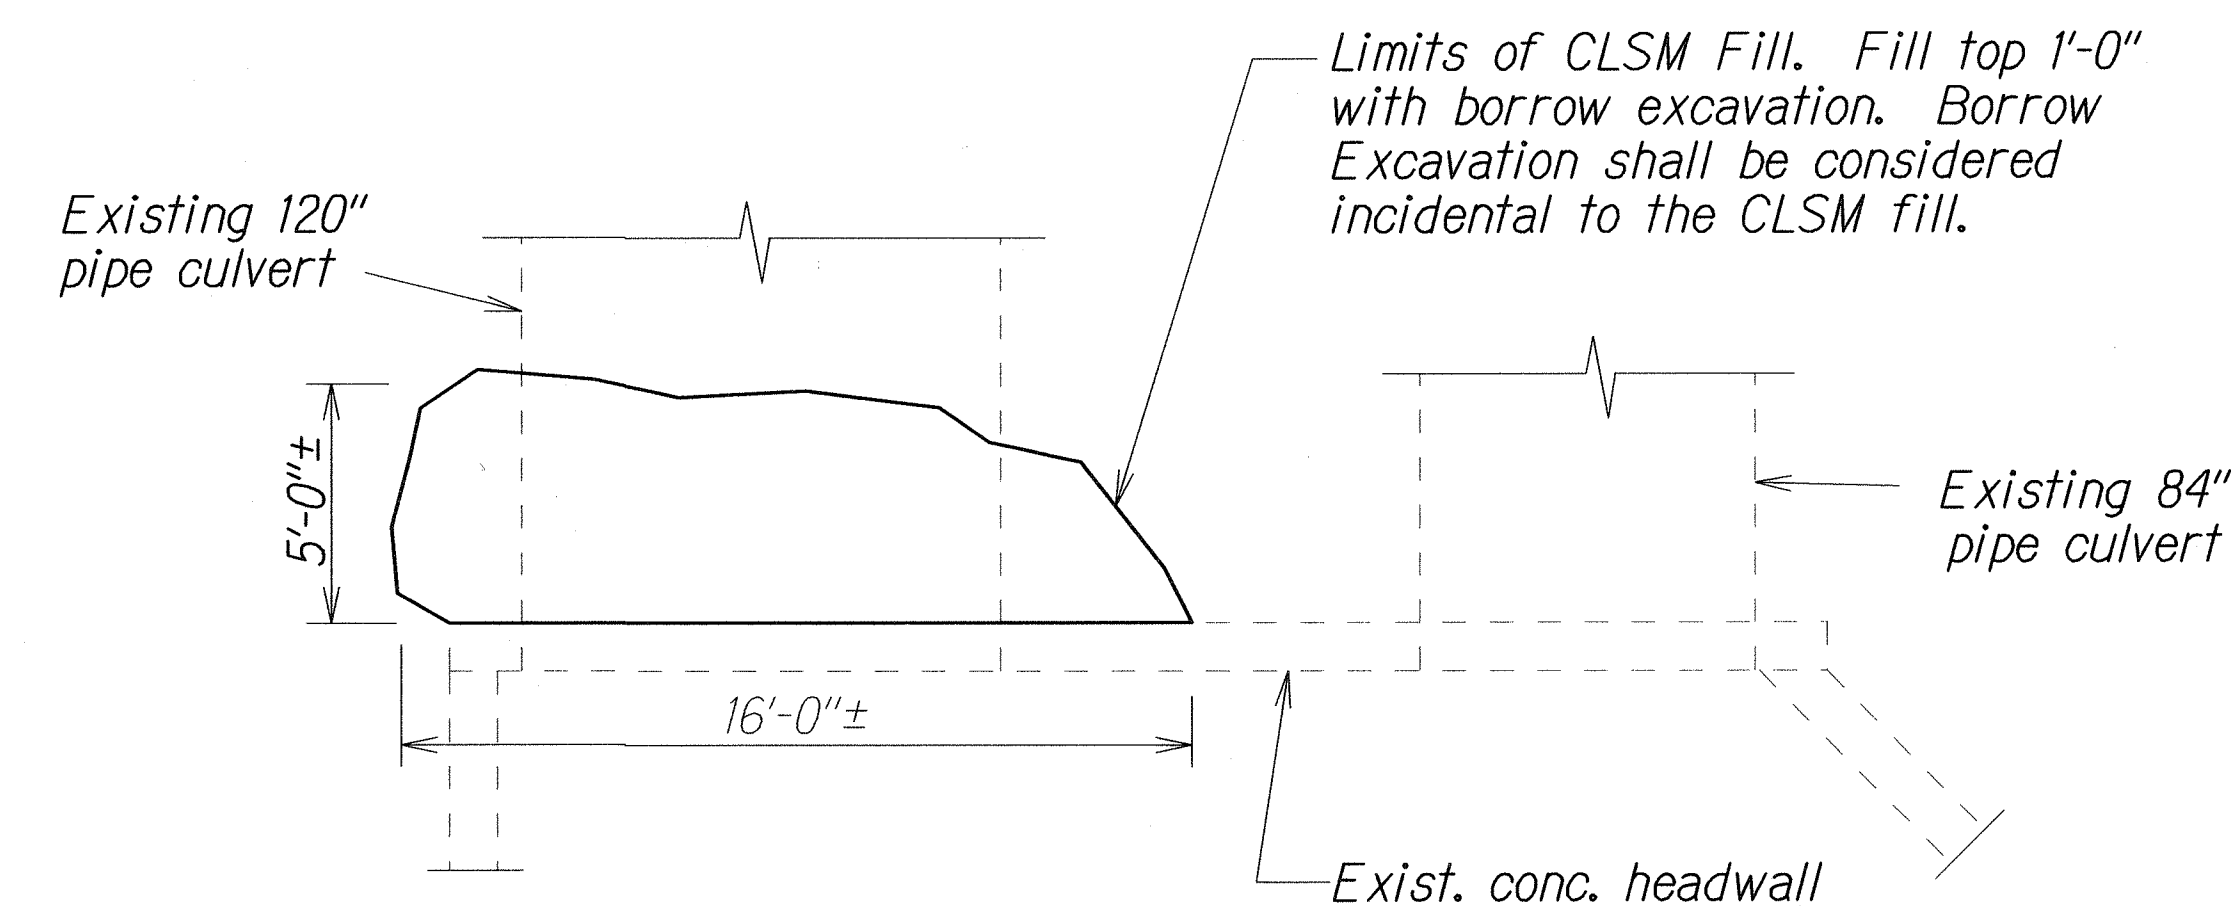

PLAN
Scale: 1/4"=1'-0"

5/11/06 Add detail of CLSM fill, Plan view
Add note to fill space with grout

DATE REVISION

STATE OF HAWAII
DEPARTMENT OF TRANSPORTATION
HIGHWAYS DIVISION

DRAINAGE DETAIL

KALANIANA'OLE HIGHWAY

DRAINAGE IMPROVEMENTS

Vicinity of Keolu Hills

Fed. Aid Project No. DE-072-1(48)R

Scale: As Shown Date: May, 2005

SHEET No. H9 OF 9 SHEETS

C.O. 14

ORIGINAL PLAN	DATE
SURVEY PLOTTED BY	7/10/03
DRAWN BY	LAG
TRACED BY	LAG
DESIGNED BY	LAG
CHECKED BY	LAG

