



FED. ROAD DIST. NO.	STATE	FED. AID PROJ. NO.	FISCAL YEAR	SHEET NO.	TOTAL SHEETS
HAWAII	HAW.	DE-072-1(48)R	2006	8	20

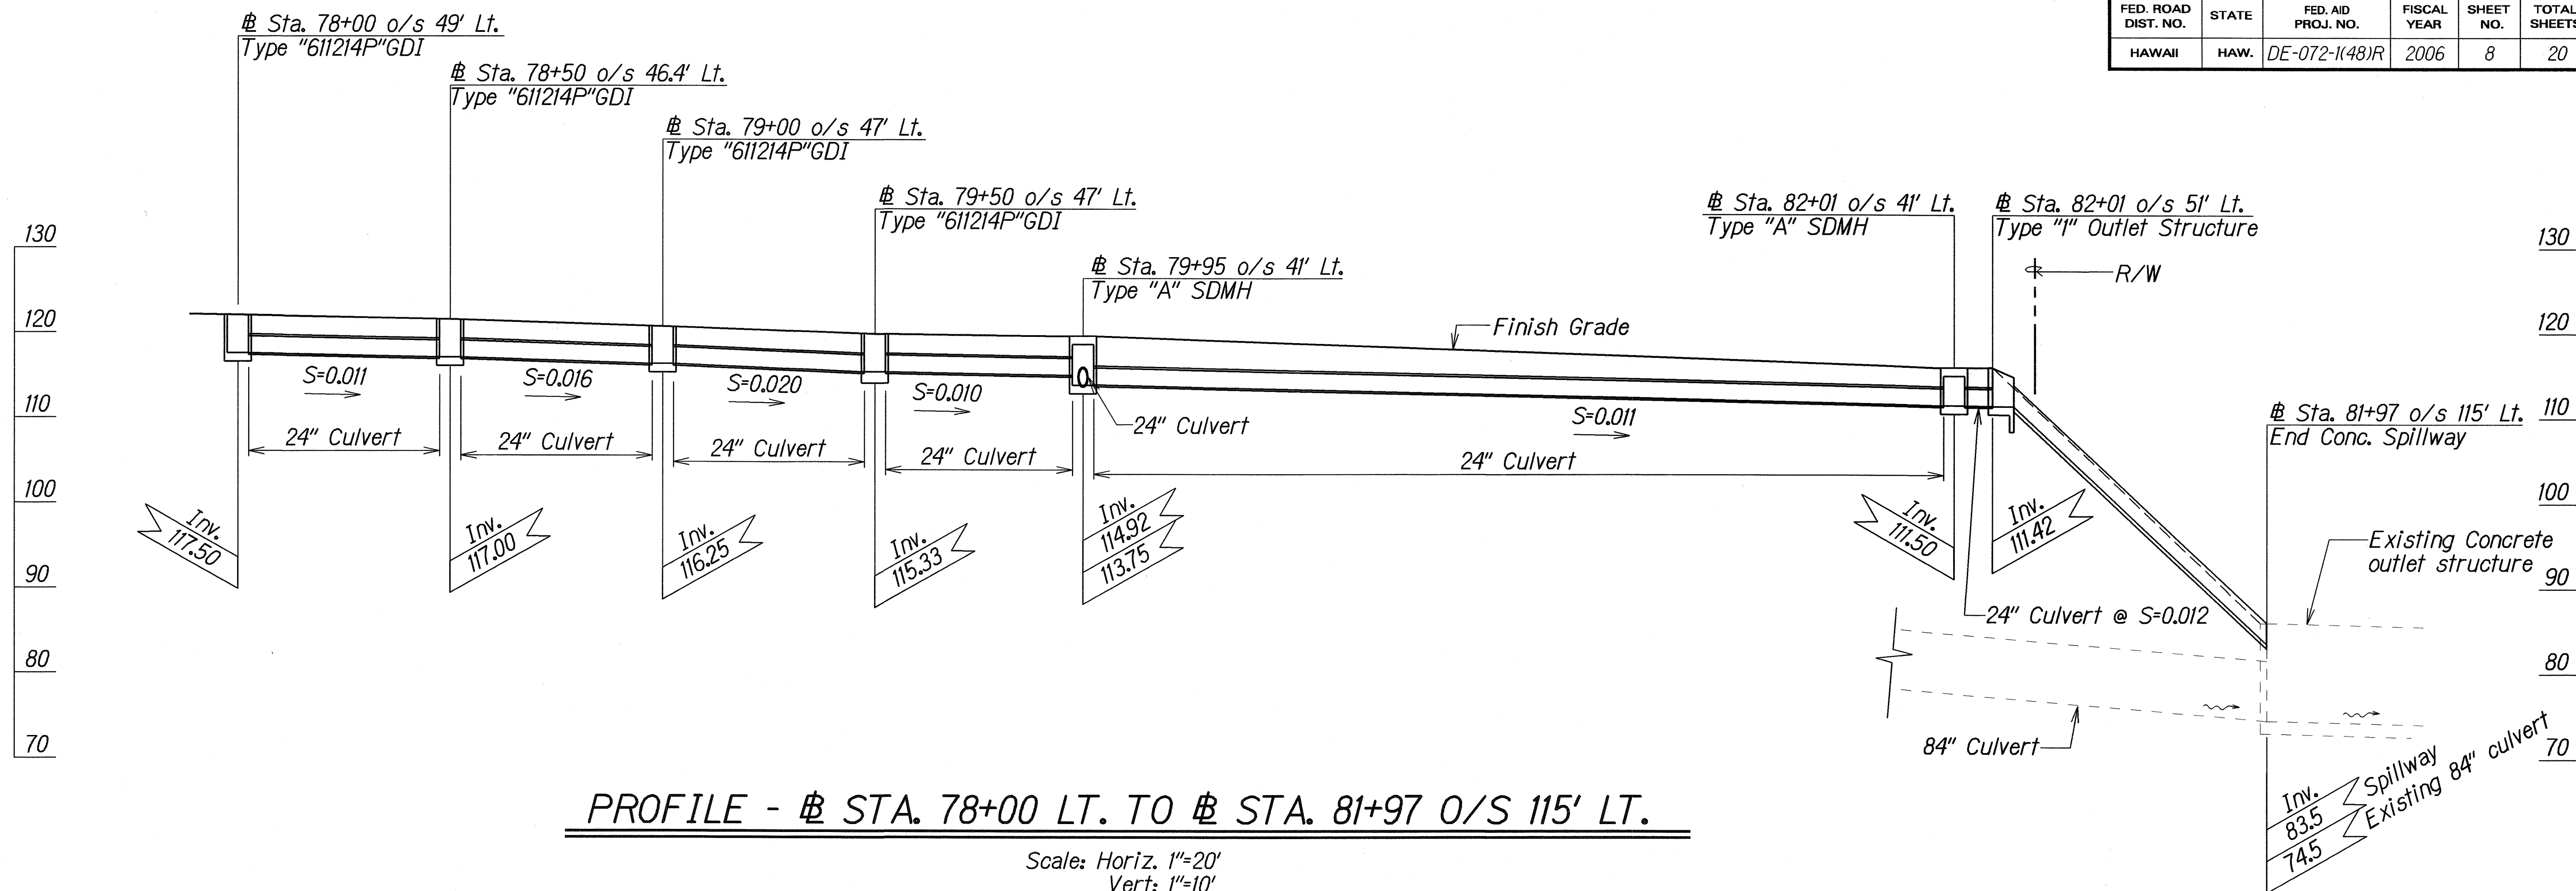

PROFILE - STA. 78+00 LT. TO STA. 81+97 O/S 115' LT.

Scale: Horiz. 1"=20'
Vert: 1"=10'

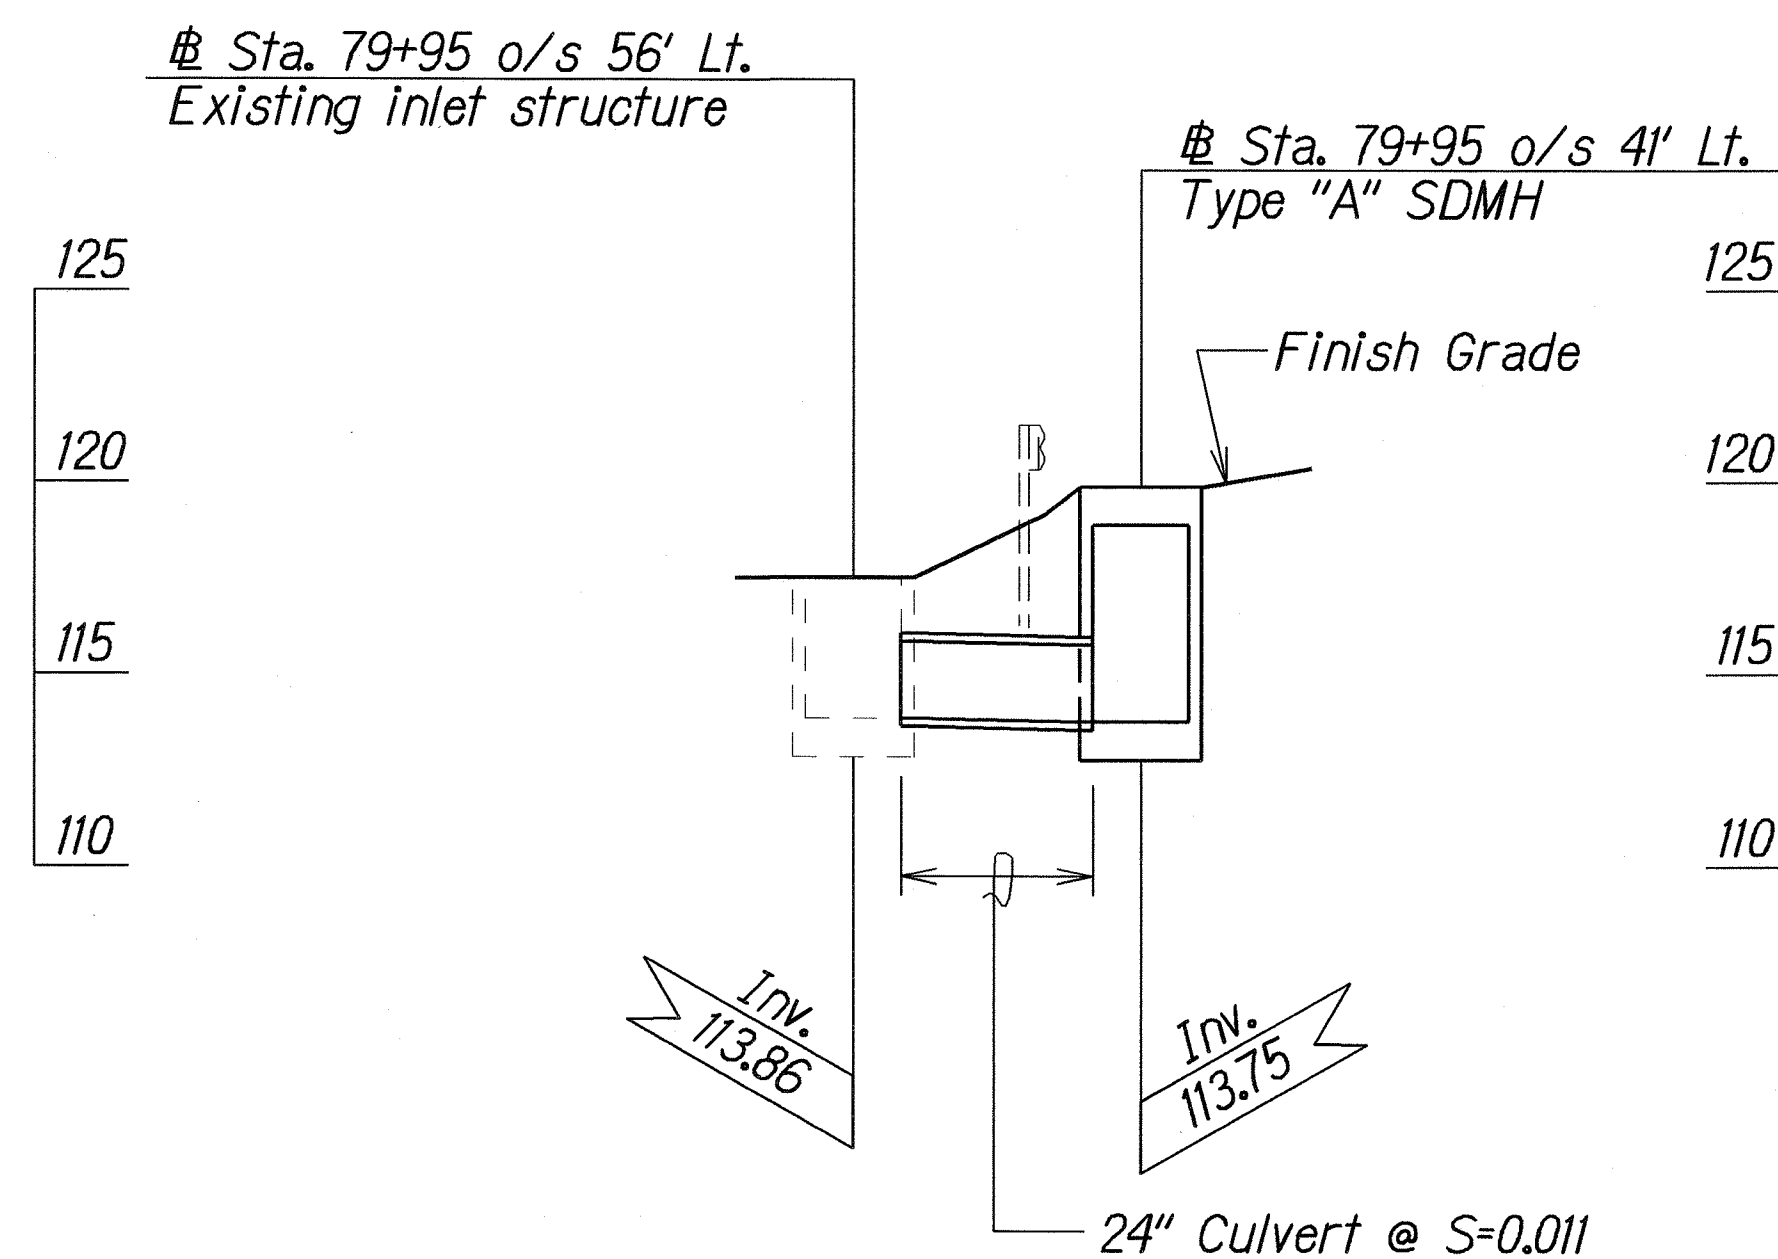

PROFILE - STA. 79+95 O/S 56' LT. TO STA. 79+95 O/S 41' LT.

Scale: Horiz. 1"=10'
Vert: 1"=5'

ORIGINAL PLAN	SURVEY PLOTTED BY	DATE
NOTE BOOK	DRAWN BY	5-09-00
QUANTITIES BY	TRACED BY	
CHECKED BY	QUANTITIES BY	

STATE OF HAWAII
DEPARTMENT OF TRANSPORTATION
HIGHWAYS DIVISION

DRAINAGE PROFILE
KALANIANA'OLE HIGHWAY
DRAINAGE IMPROVEMENTS
Vicinity of Keolu Hills
Fed. Aid Project No. DE-072-1(48)R
Scale: As shown Date: May, 2005

SHEET No. H3 OF 9 SHEETS