


FED. ROAD DIST. NO.	STATE	FED. AID PROJ. NO.	FISCAL YEAR	SHEET NO.	TOTAL SHEETS
HAWAII	HAW.	NH-072-1(50)	2007	22	24

LEGEND FOR AS-BUILT POSTINGS	
~~~~~	Squiggly line for as-built deletion
==	Double line for as-built deletion
Roadway	Text for as-built posting

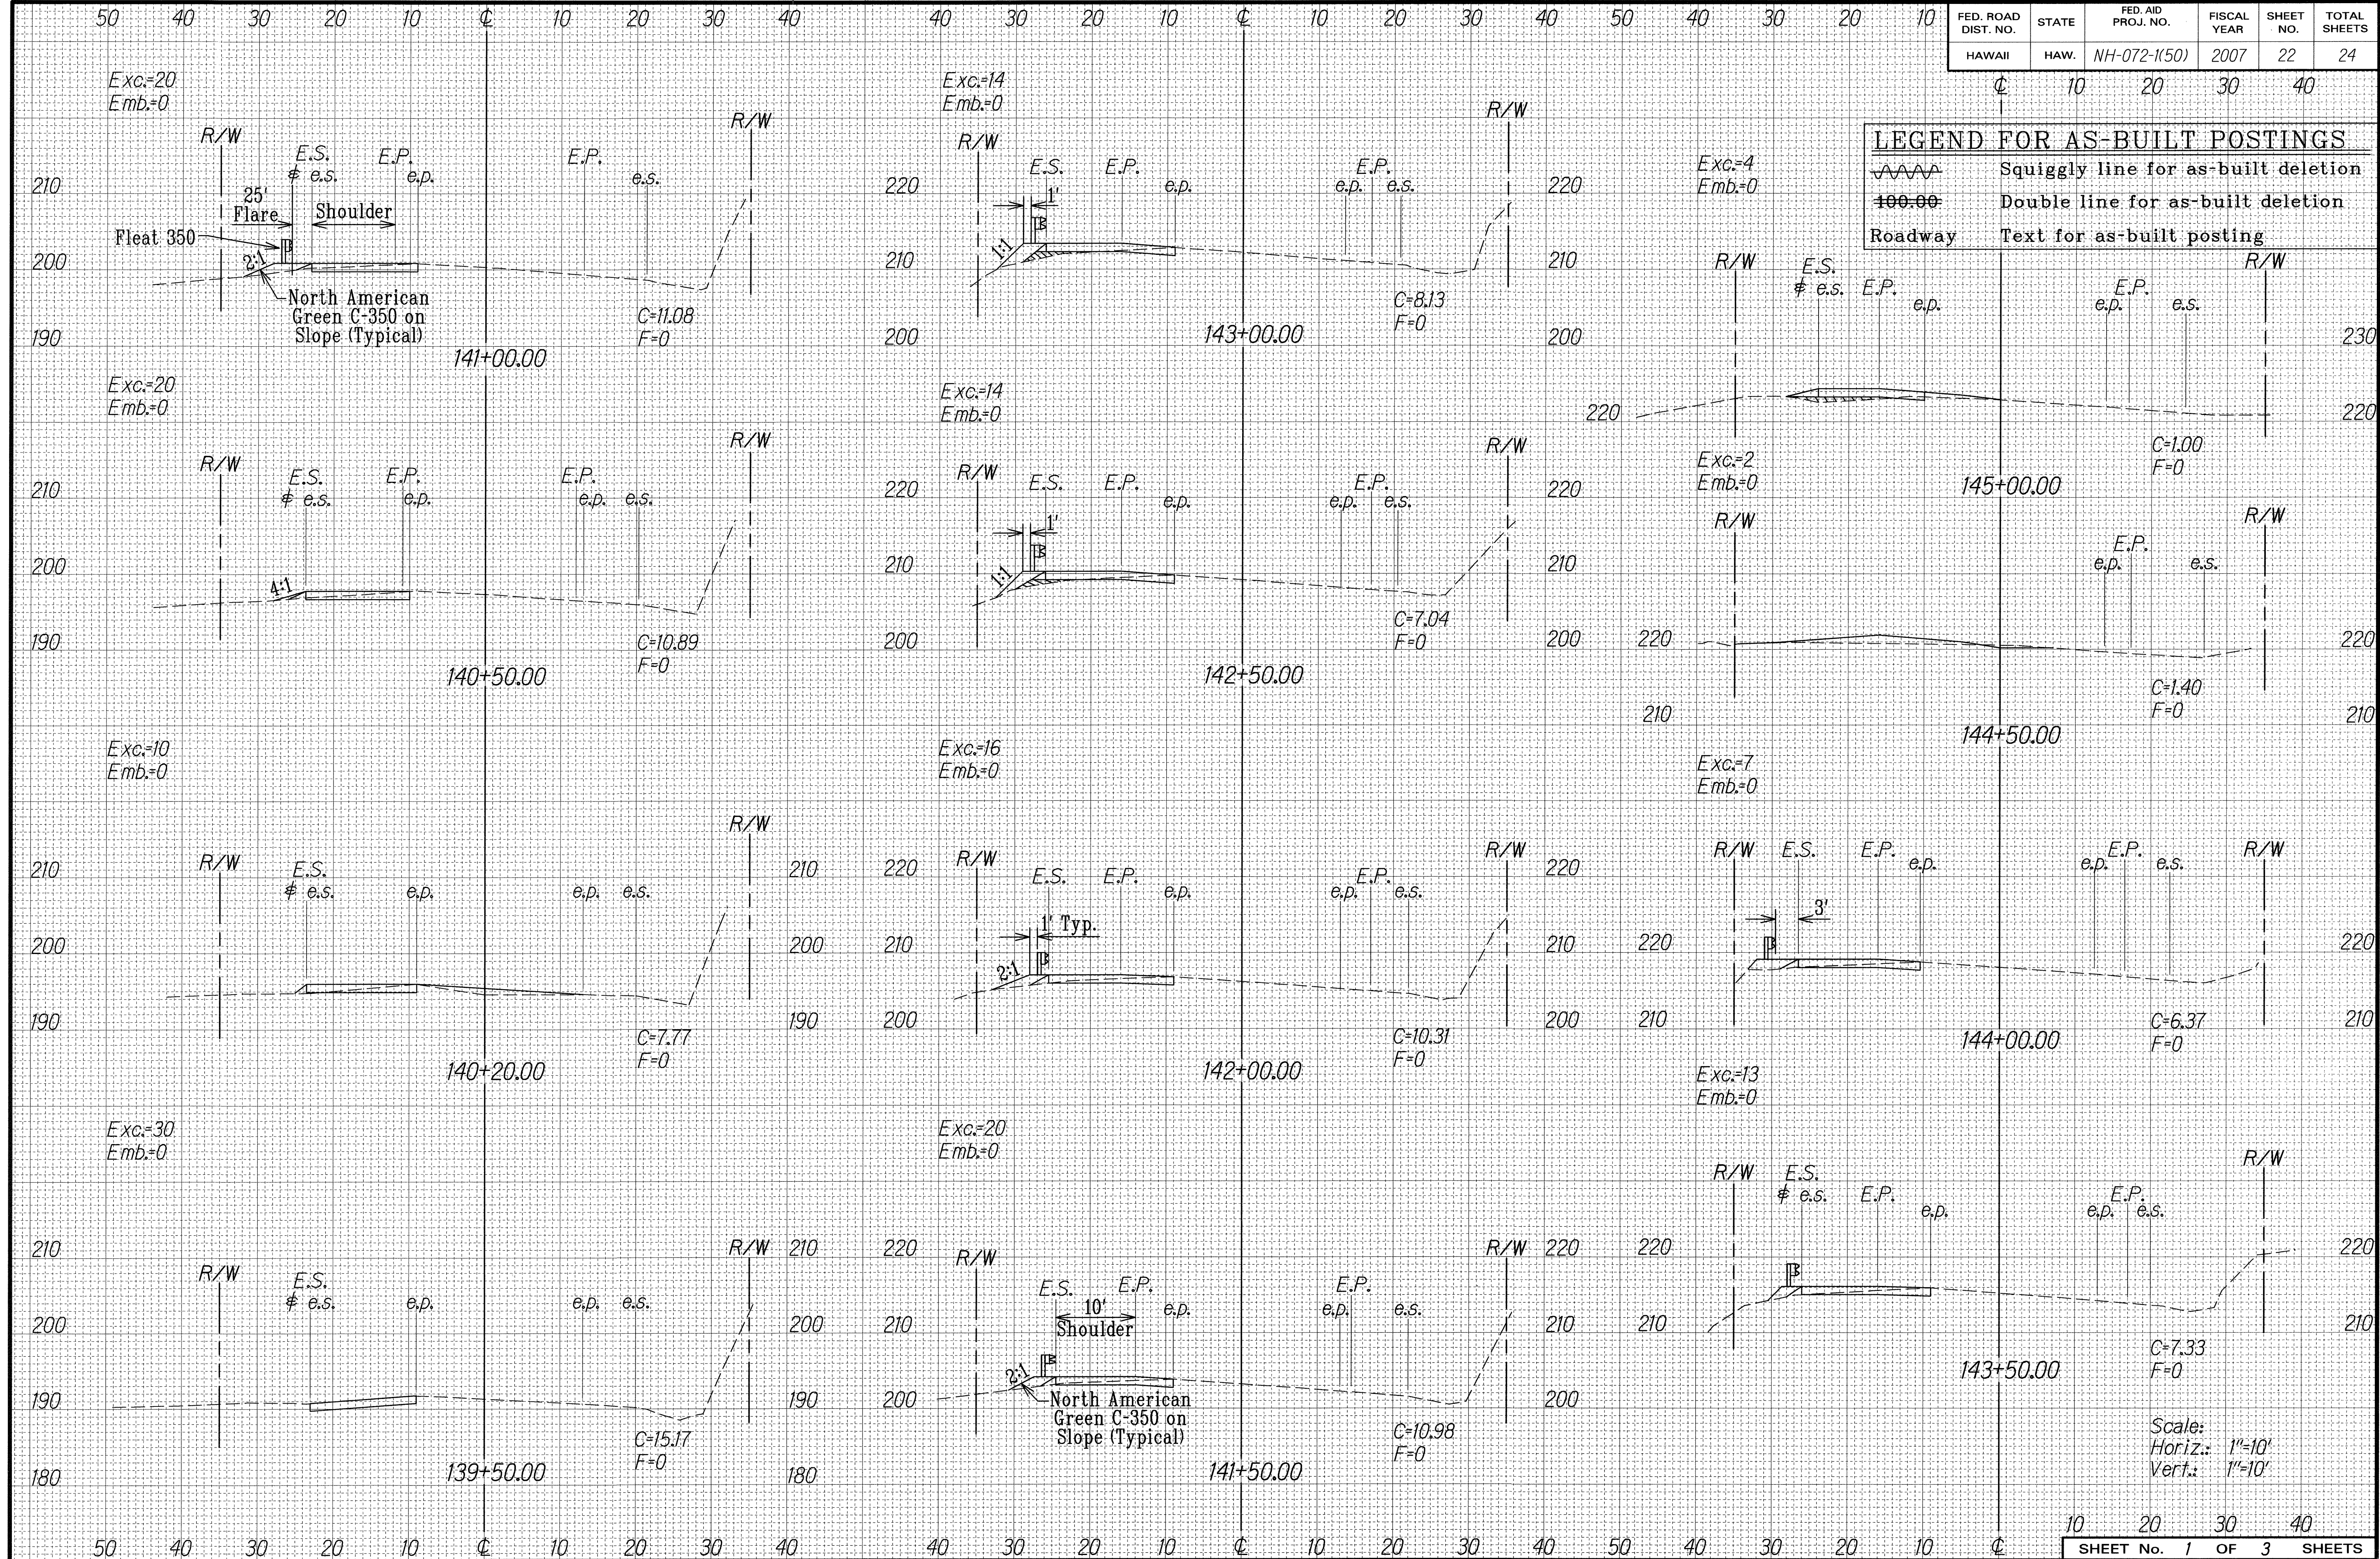


ORIGINAL PLAN	DATE
SURVEY PLOTTED BY	10/2/06
DRAWN BY	
TRACED BY	
NOTED BY	
QUANTITIES BY	
CHECKED BY	

Scale:  
 Horiz.: 1"=10'  
 Vert.: 1"=10'

"AS-BUILT"




FED. ROAD DIST. NO.	STATE	FED. AID PROJ. NO.	FISCAL YEAR	SHEET NO.	TOTAL SHEETS
HAWAII	HAW.	NH-072-1(50)	2007	23	24

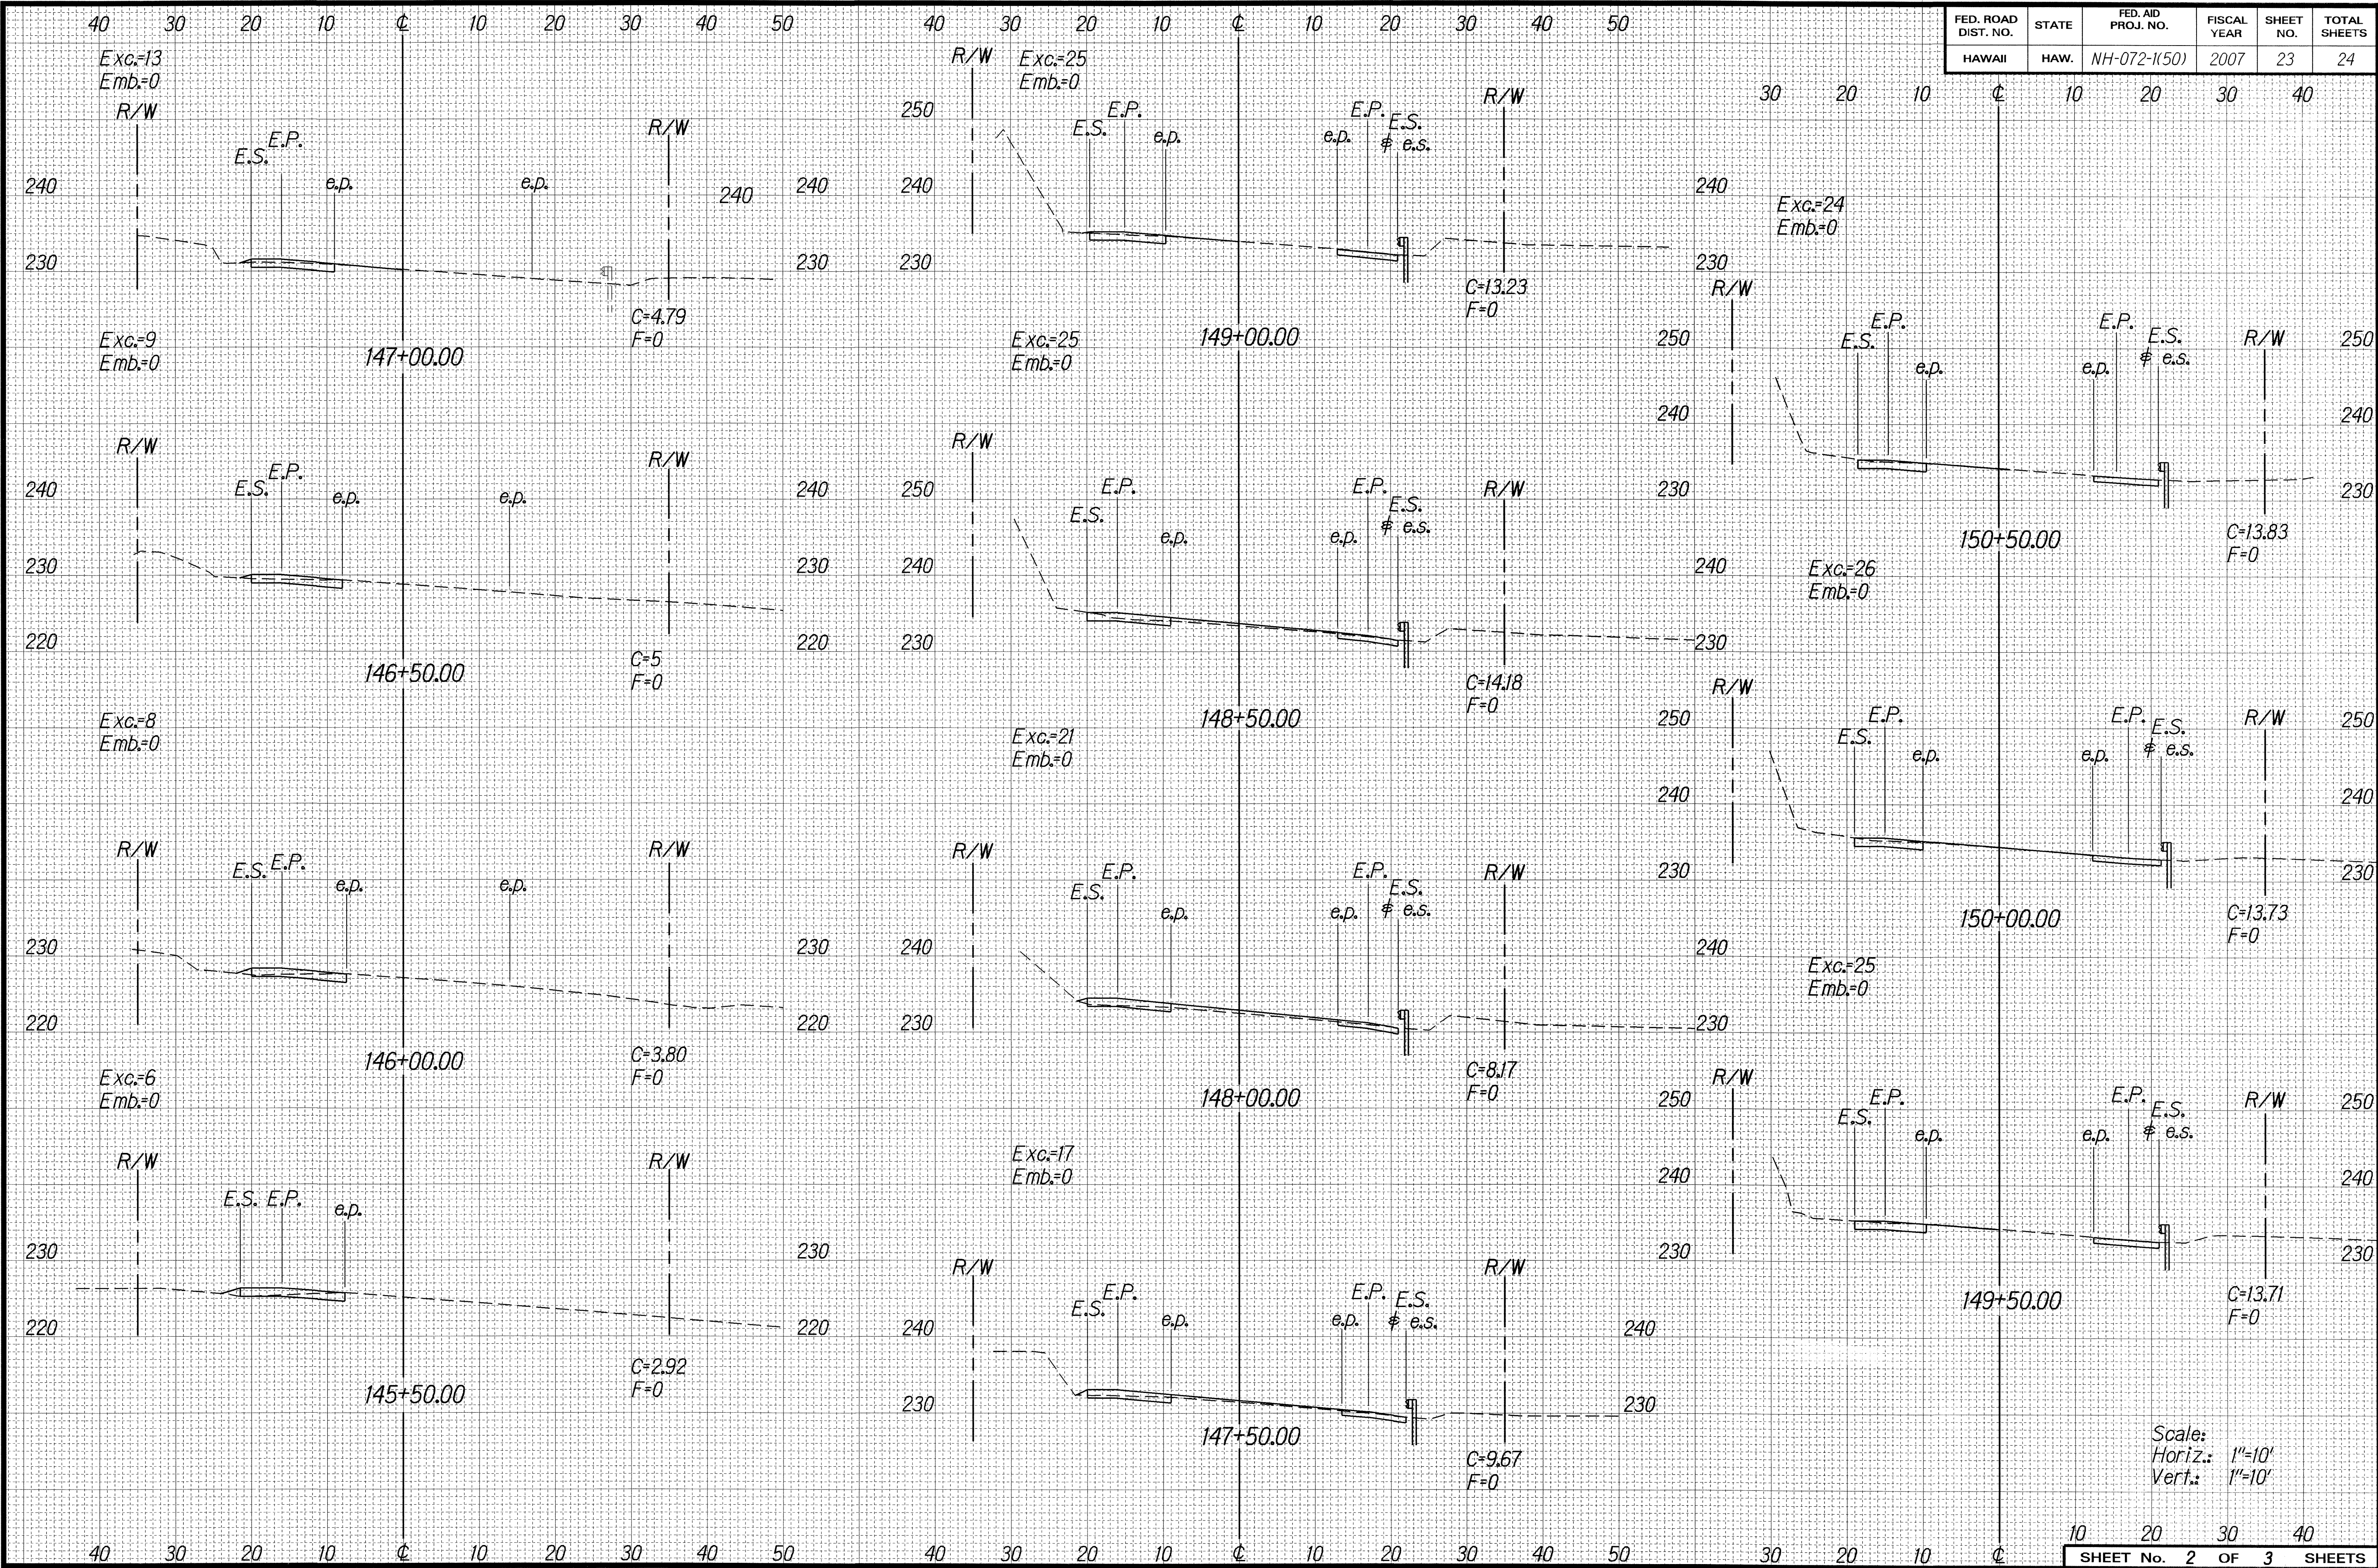

SURVEY PLANNED BY: _____ DATE: 10/1/06  
 DRAWN BY: J.H.  
 CHECKED BY: J.S.  
 NOTE BOOK DESIGNED BY: J.S.  
 QUANTITIES BY: J.S.  
 ORIGINAL PLAN: _____  
 SHEET No. 2 OF 3 SHEETS



FED. ROAD DIST. NO.	STATE	FED. AID PROJ. NO.	FISCAL YEAR	SHEET NO.	TOTAL SHEETS
HAWAII	HAW.	NH-072-1(50)	2007	24	24

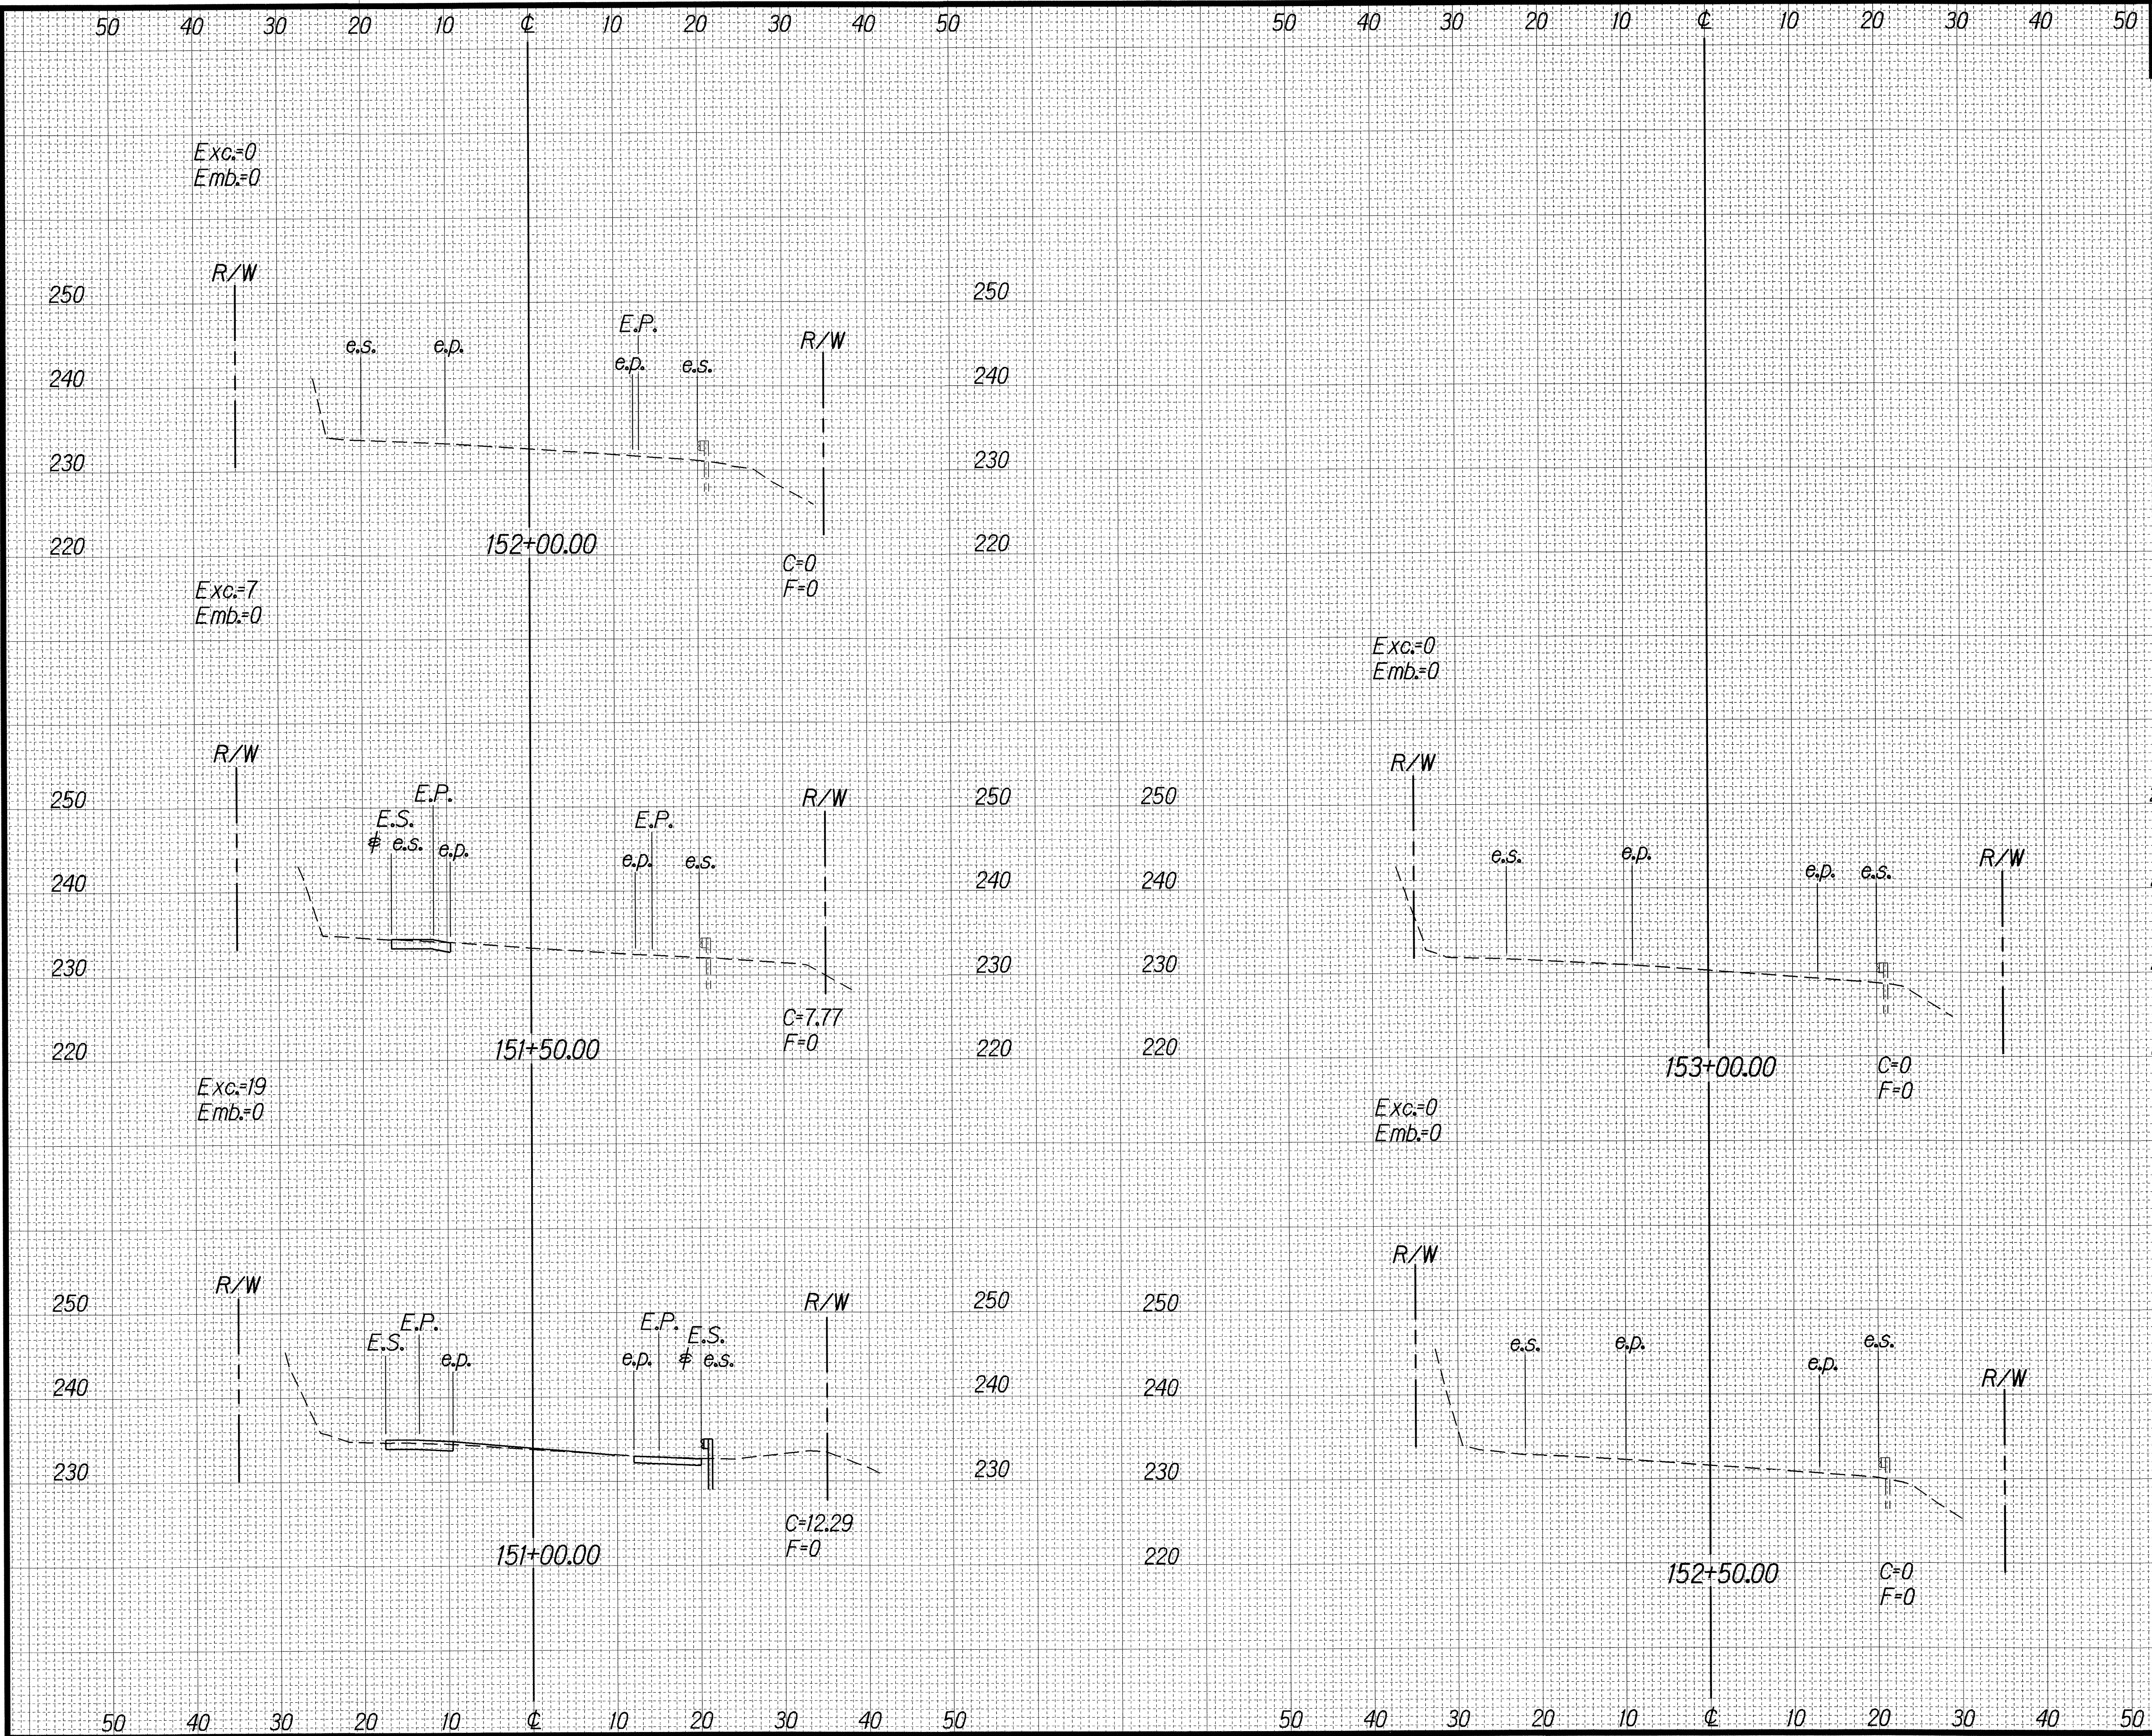

DATE	10/23/06
SURVEY PLOTTED BY	
DESIGNED BY	
TRACED BY	
NOTE BOOK	
QUANTITIES BY	
CHECKED BY	

Scale:  
Horiz.: 1"=10'  
Vert.: 1"=10'