


FED. ROAD DIST. NO.	STATE	FED. AID PROJ. NO.	FISCAL YEAR	SHEET NO.	TOTAL SHEETS
HAWAII	HAW.	NH-072-K(50)	2007	19	24

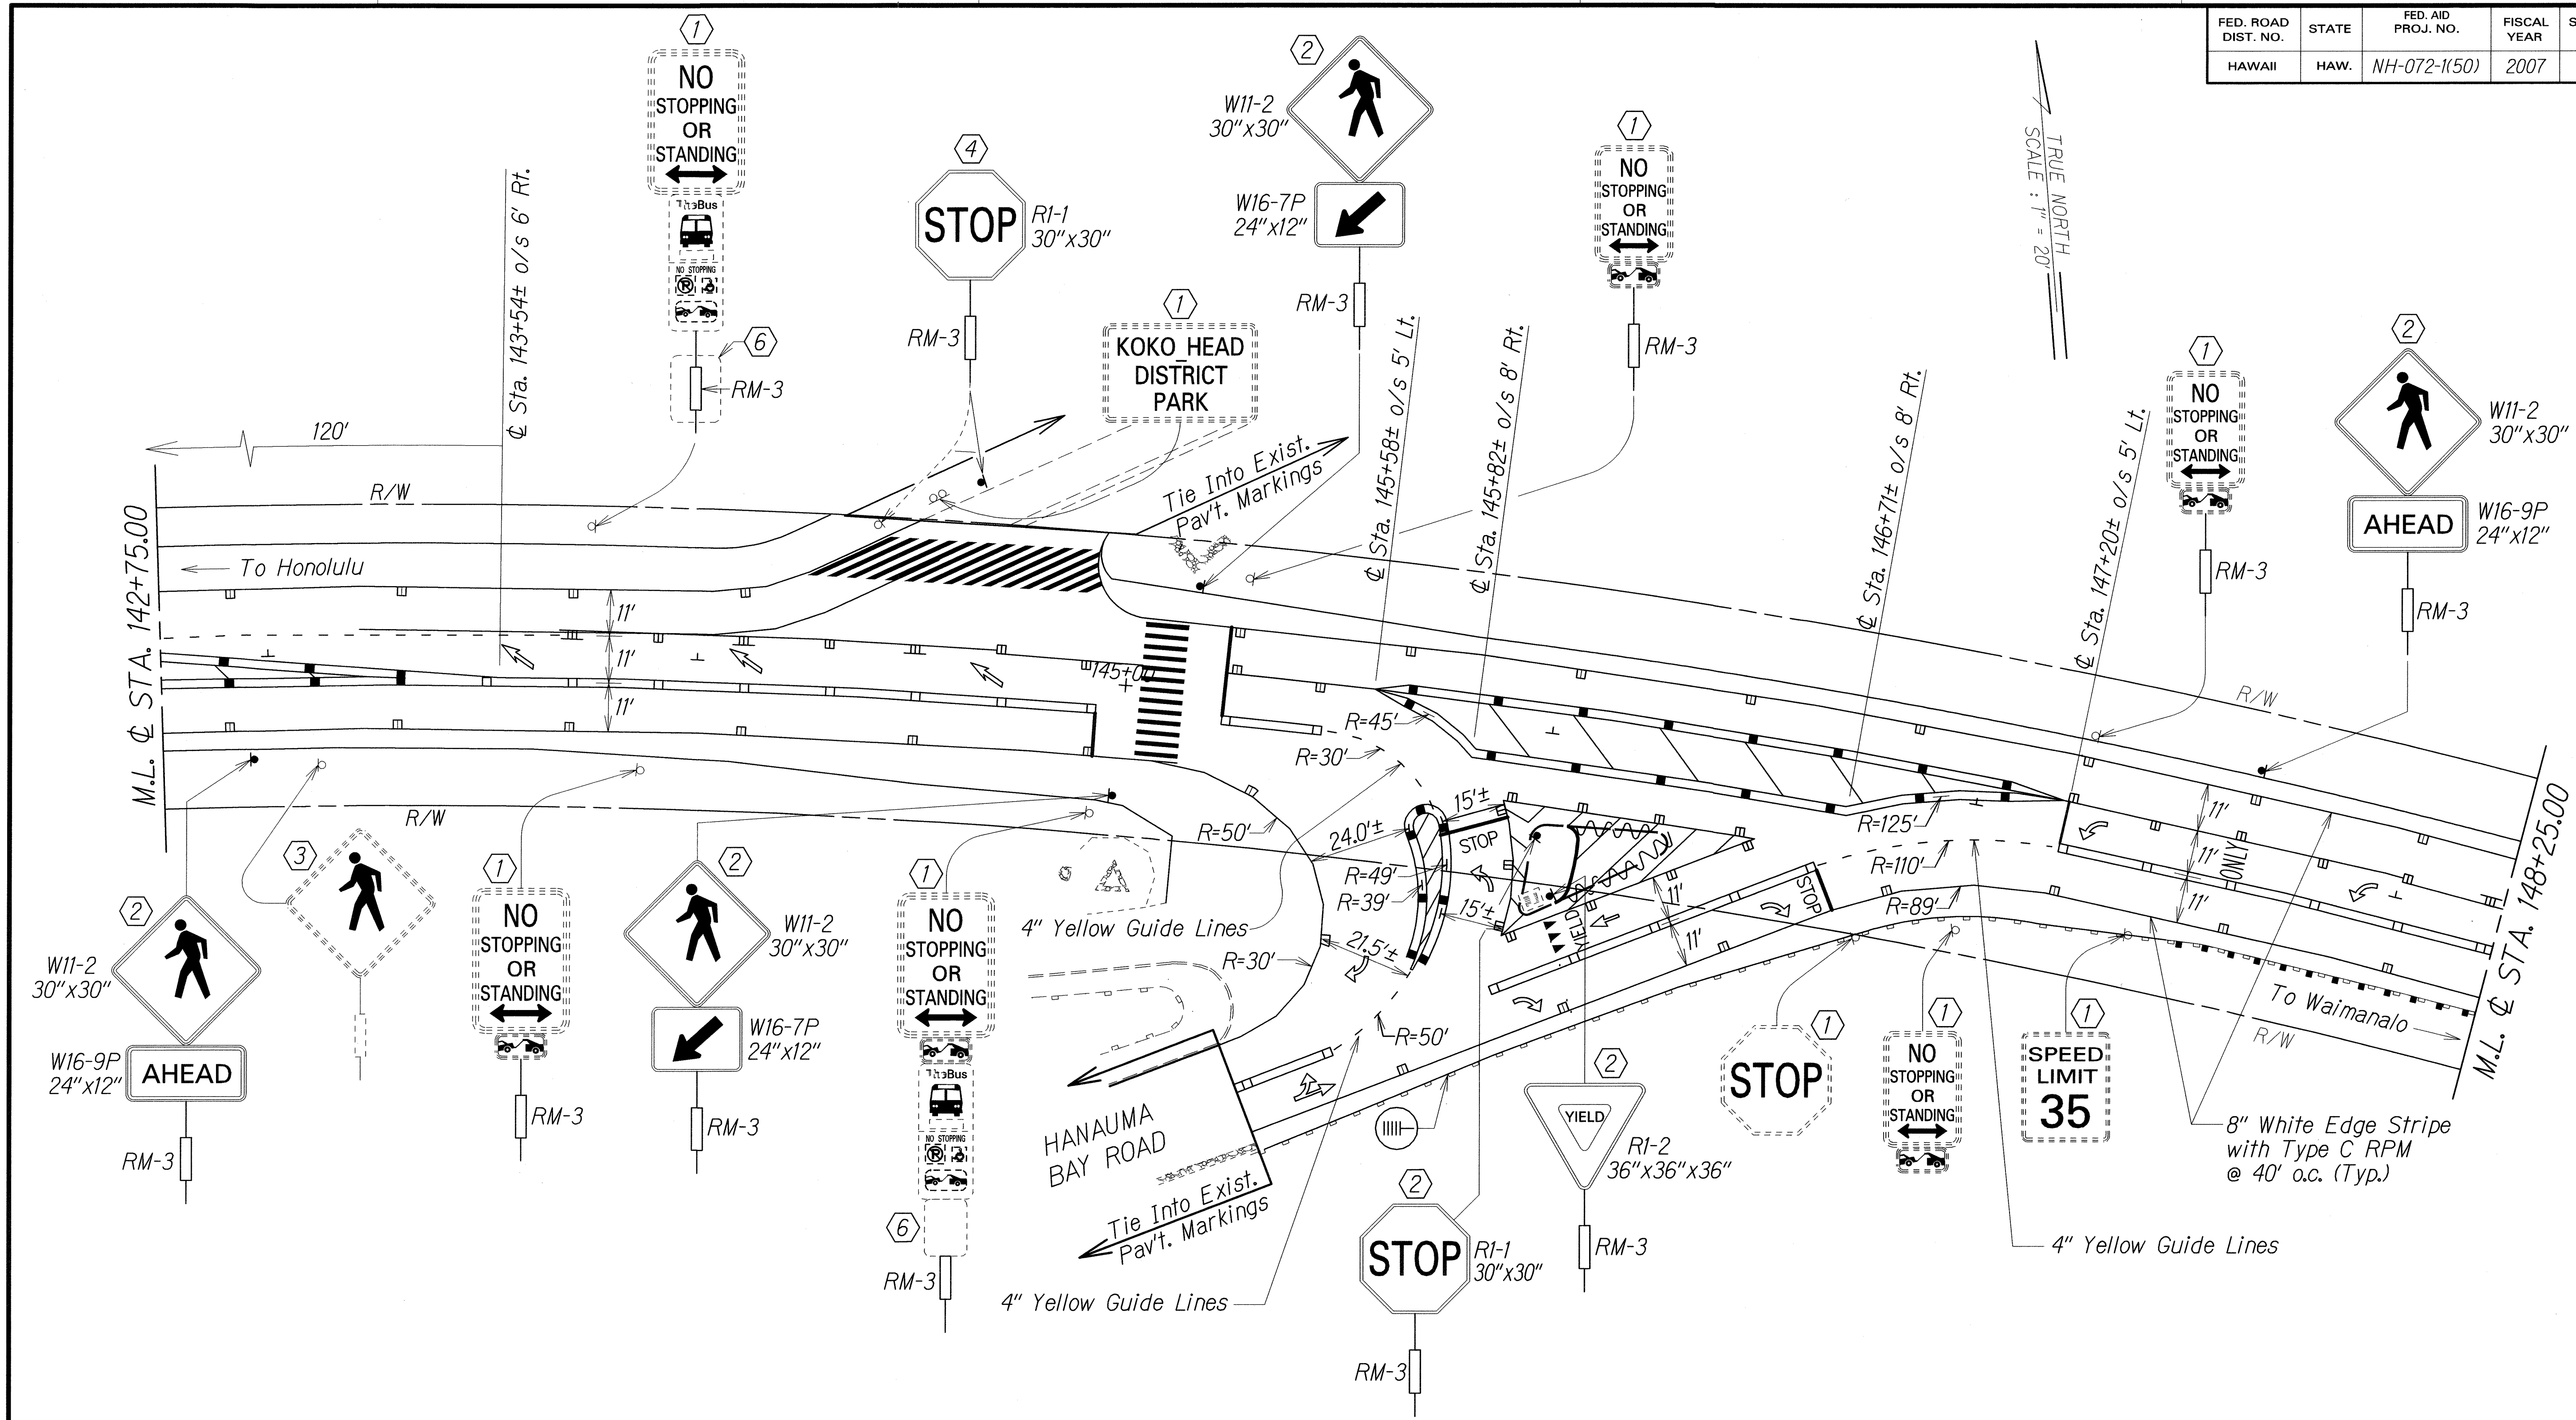

ORIGINAL PLAN	SURVEY PLOTTED BY	DATE
	DRAWN BY	
	DESIGNED BY	
	CHECKED BY	

- KEY:**
- ① Exist. Sign(s) & Post(s) to Remain
 - ② Install New Sign(s) & Post(s)
 - ③ Remove Exist. Sign & Post
 - ④ Relocate Exist. Post to New Location & Install New Sign on Exist. Post
 - ⑤ Remove Exist. Sign & Install New on Exist. Post(s)
 - ⑥ Remove Exist. Sign
- Ⓜ Reflector Markers (RM-5) shall be mounted every 25 feet on all existing metal guardrails except on terminal sections. For details, see Plan Sheet No. 8. The Contractor shall be responsible for mounting RM-5's on all existing metal guardrails even when not shown on plans.

Note:
All Locations of Stop Bars and Crosswalks on This Plan Sheet shall be scaled off.

LEGEND FOR AS-BUILT POSTINGS	
	Squiggly line for as-built deletion
	Double line for as-built deletion
Roadway	Text for as-built posting

STATE OF HAWAII
DEPARTMENT OF TRANSPORTATION
HIGHWAYS DIVISION


PAVEMENT MARKING & STRIPING PLAN

KALANIANA'OLE HIGHWAY
Intersection Improvements
at Hanauma Bay Road
Fed. Aid Project No. NH-072-K(50)

Scale: 1"=20' Date: July 2006


SHEET No. 2 OF 3 SHEETS

FED. ROAD DIST. NO.	STATE	FED. AID PROJ. NO.	FISCAL YEAR	SHEET NO.	TOTAL SHEETS
HAWAII	HAW.	NH-072-1(50)	2007	20	24

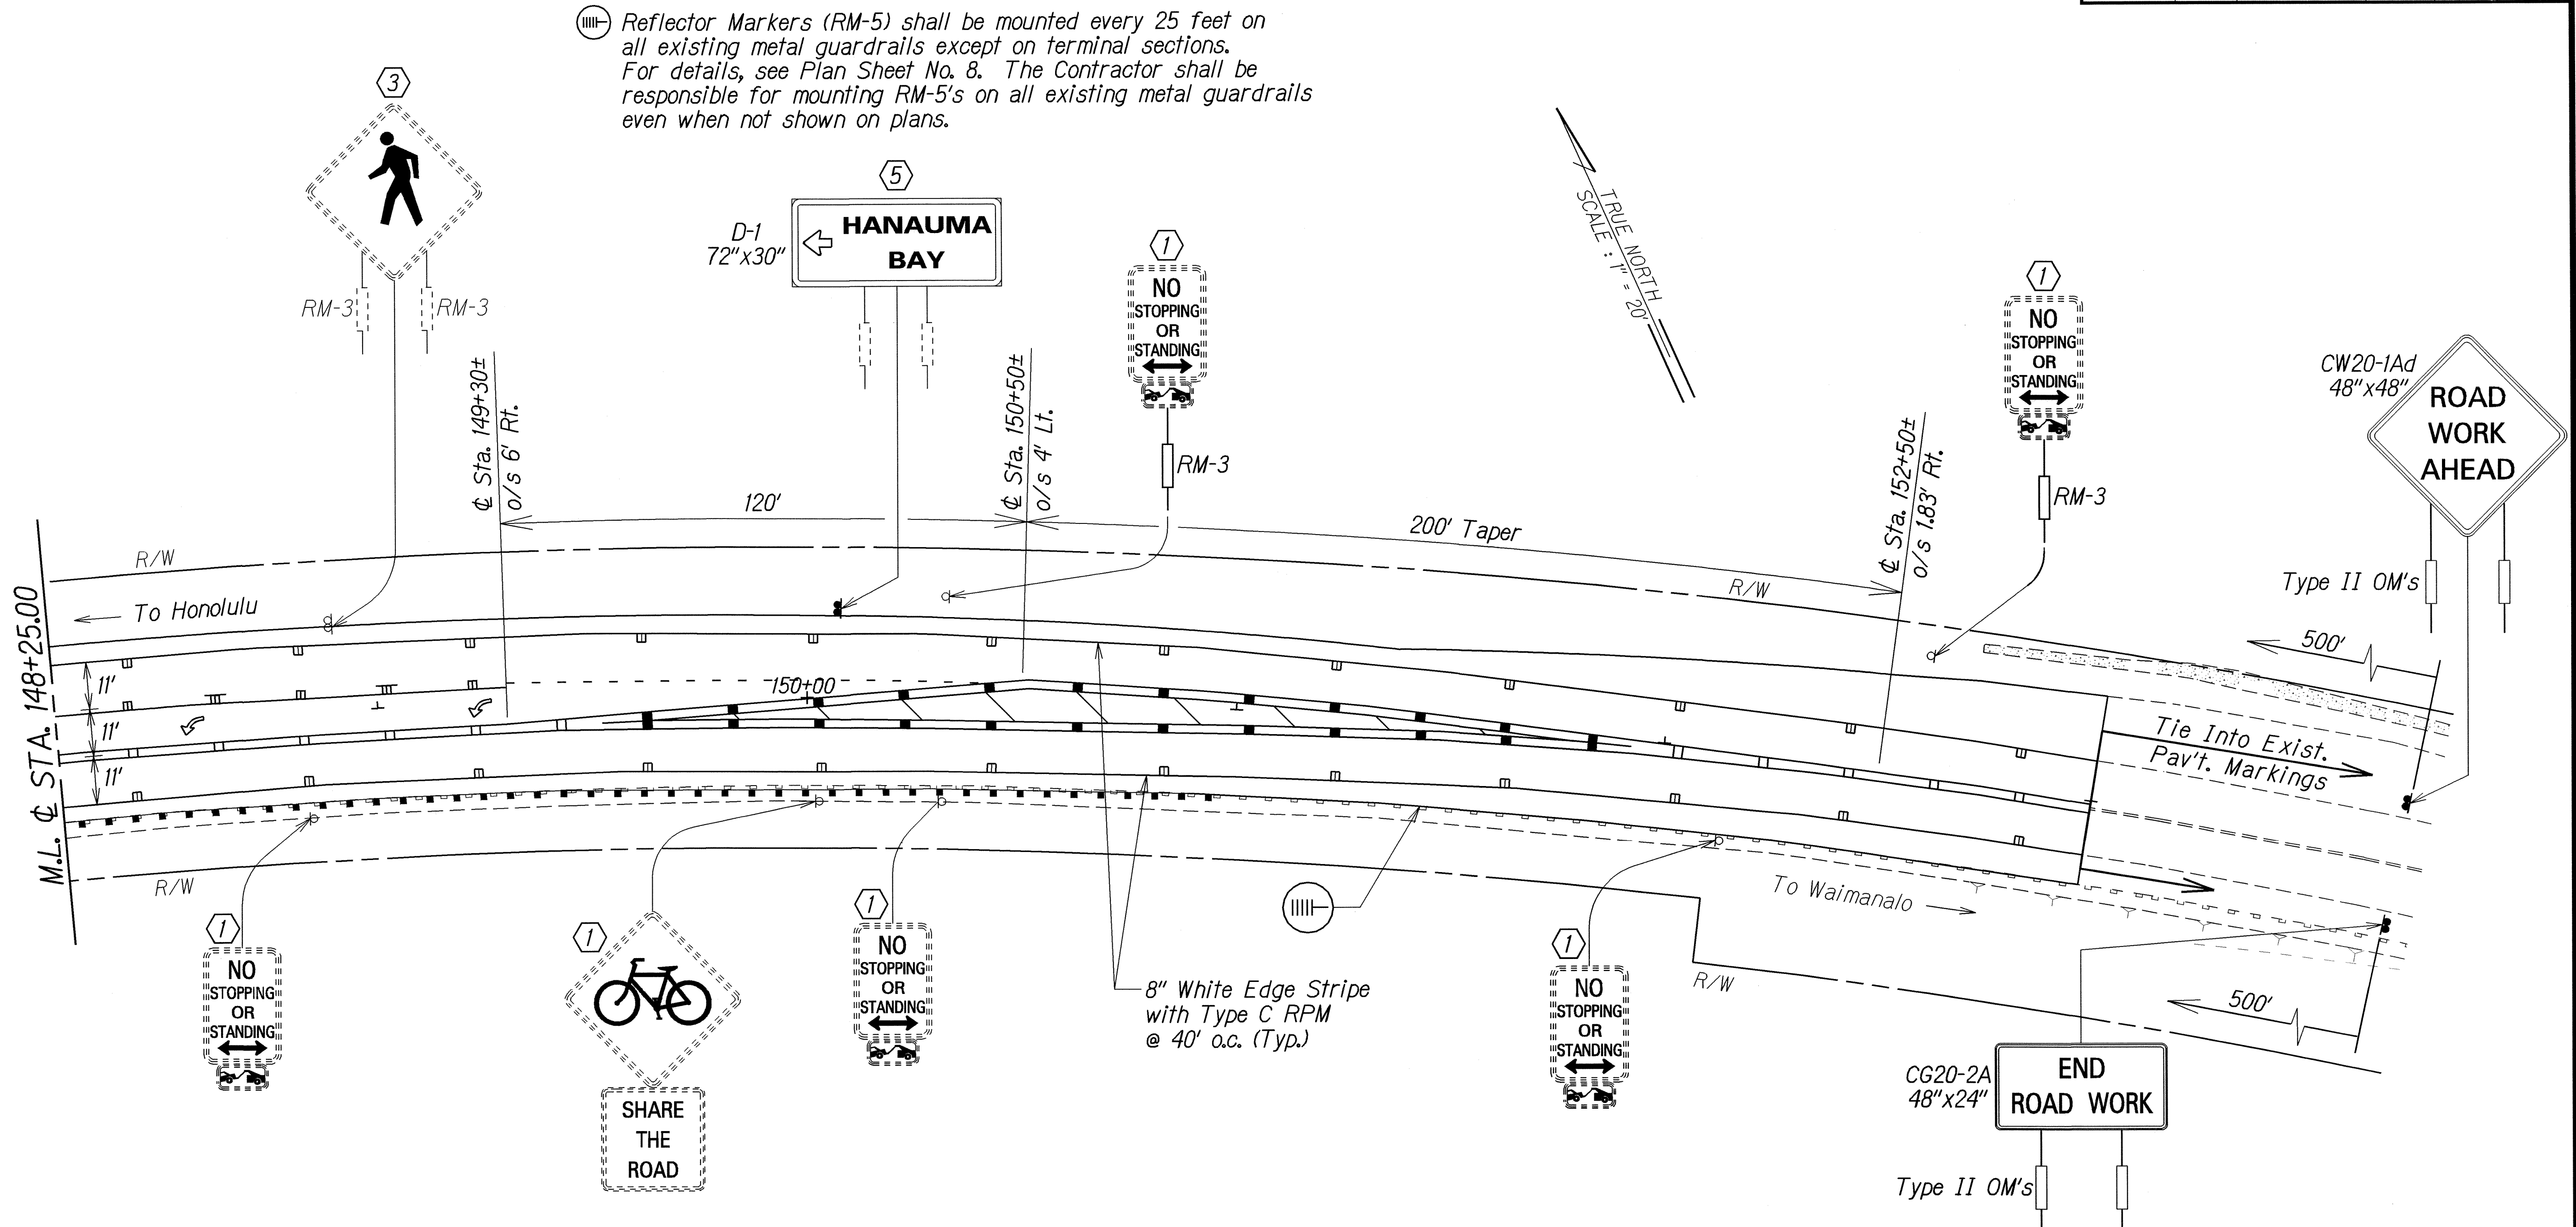

⦿ Reflecter Markers (RM-5) shall be mounted every 25 feet on all existing metal guardrails except on terminal sections. For details, see Plan Sheet No. 8. The Contractor shall be responsible for mounting RM-5's on all existing metal guardrails even when not shown on plans.

- KEY:**
- ① Exist. Sign(s) & Post(s) to Remain
 - ② Install New Sign(s) & Post(s)
 - ③ Remove Exist. Sign & Post
 - ④ Relocate Exist. Post to New Location & Install New Sign on Exist. Post
 - ⑤ Remove Exist. Sign & Install New on Exist. Post(s)
 - ⑥ Remove Exist. Sign

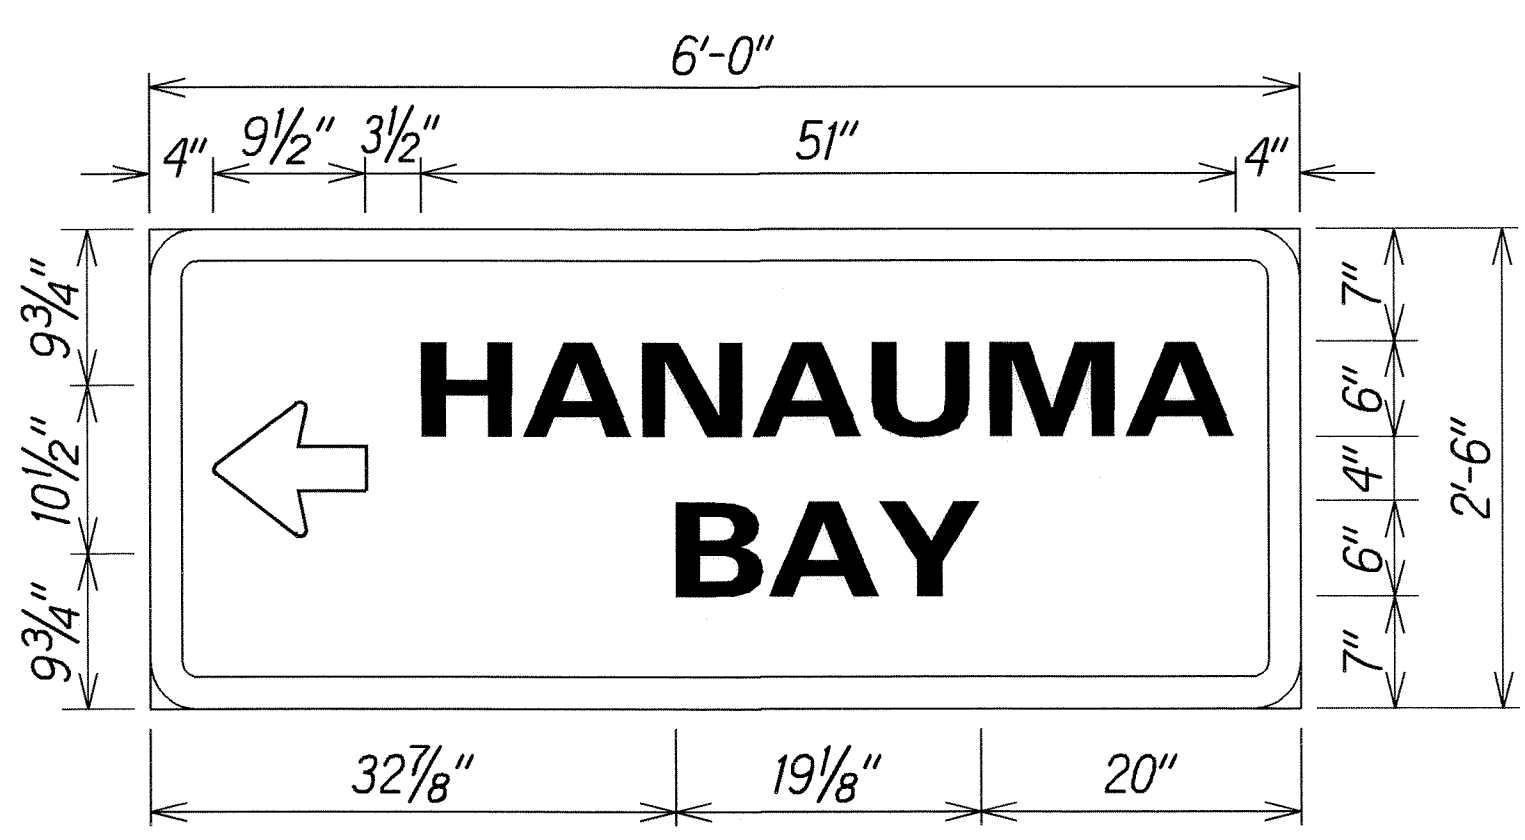

GENERAL NOTES

1. All signs shall conform to Section 621B of the Special Provisions and the latest edition amendments of the following FHWA publications:
 - a. "Manual on Uniform Traffic Control Devices for Streets and Highways" (MUTCD)
 - b. "Standard Highway Signs"
 - c. "Standard Alphabets for Highway Signs"
2. Borders, messages, arrows, symbols and shield shall conform to details as shown on the plans and as specified in the MUTCD.
3. Signs' messages shall be as indicated on the plans.
4. All panels shall be reflectorized in accordance with Section 712.20 of the Standard Specifications.

ORIGINAL PLAN	DATE: 6/15/05
DESIGNED BY: L.H.	
NOTED BY: E.L.V.S.	
CHECKED BY: N. HALL	

STATE OF HAWAII
DEPARTMENT OF TRANSPORTATION
HIGHWAYS DIVISION

PAVEMENT MARKING & STRIPING PLAN

KALANIANA'OLE HIGHWAY
Intersection Improvements
at Hanauma Bay Road

Fed. Aid Project No. NH-072-1(50)

Scale: 1"=20' Date: July 2006

SHEET No. 3 OF 3 SHEETS