


FED. ROAD DIST. NO.	STATE	FED. AID PROJ. NO.	FISCAL YEAR	SHEET NO.	TOTAL SHEETS
HAWAII	HAW.	NH-072-K(50)	2007	12	24

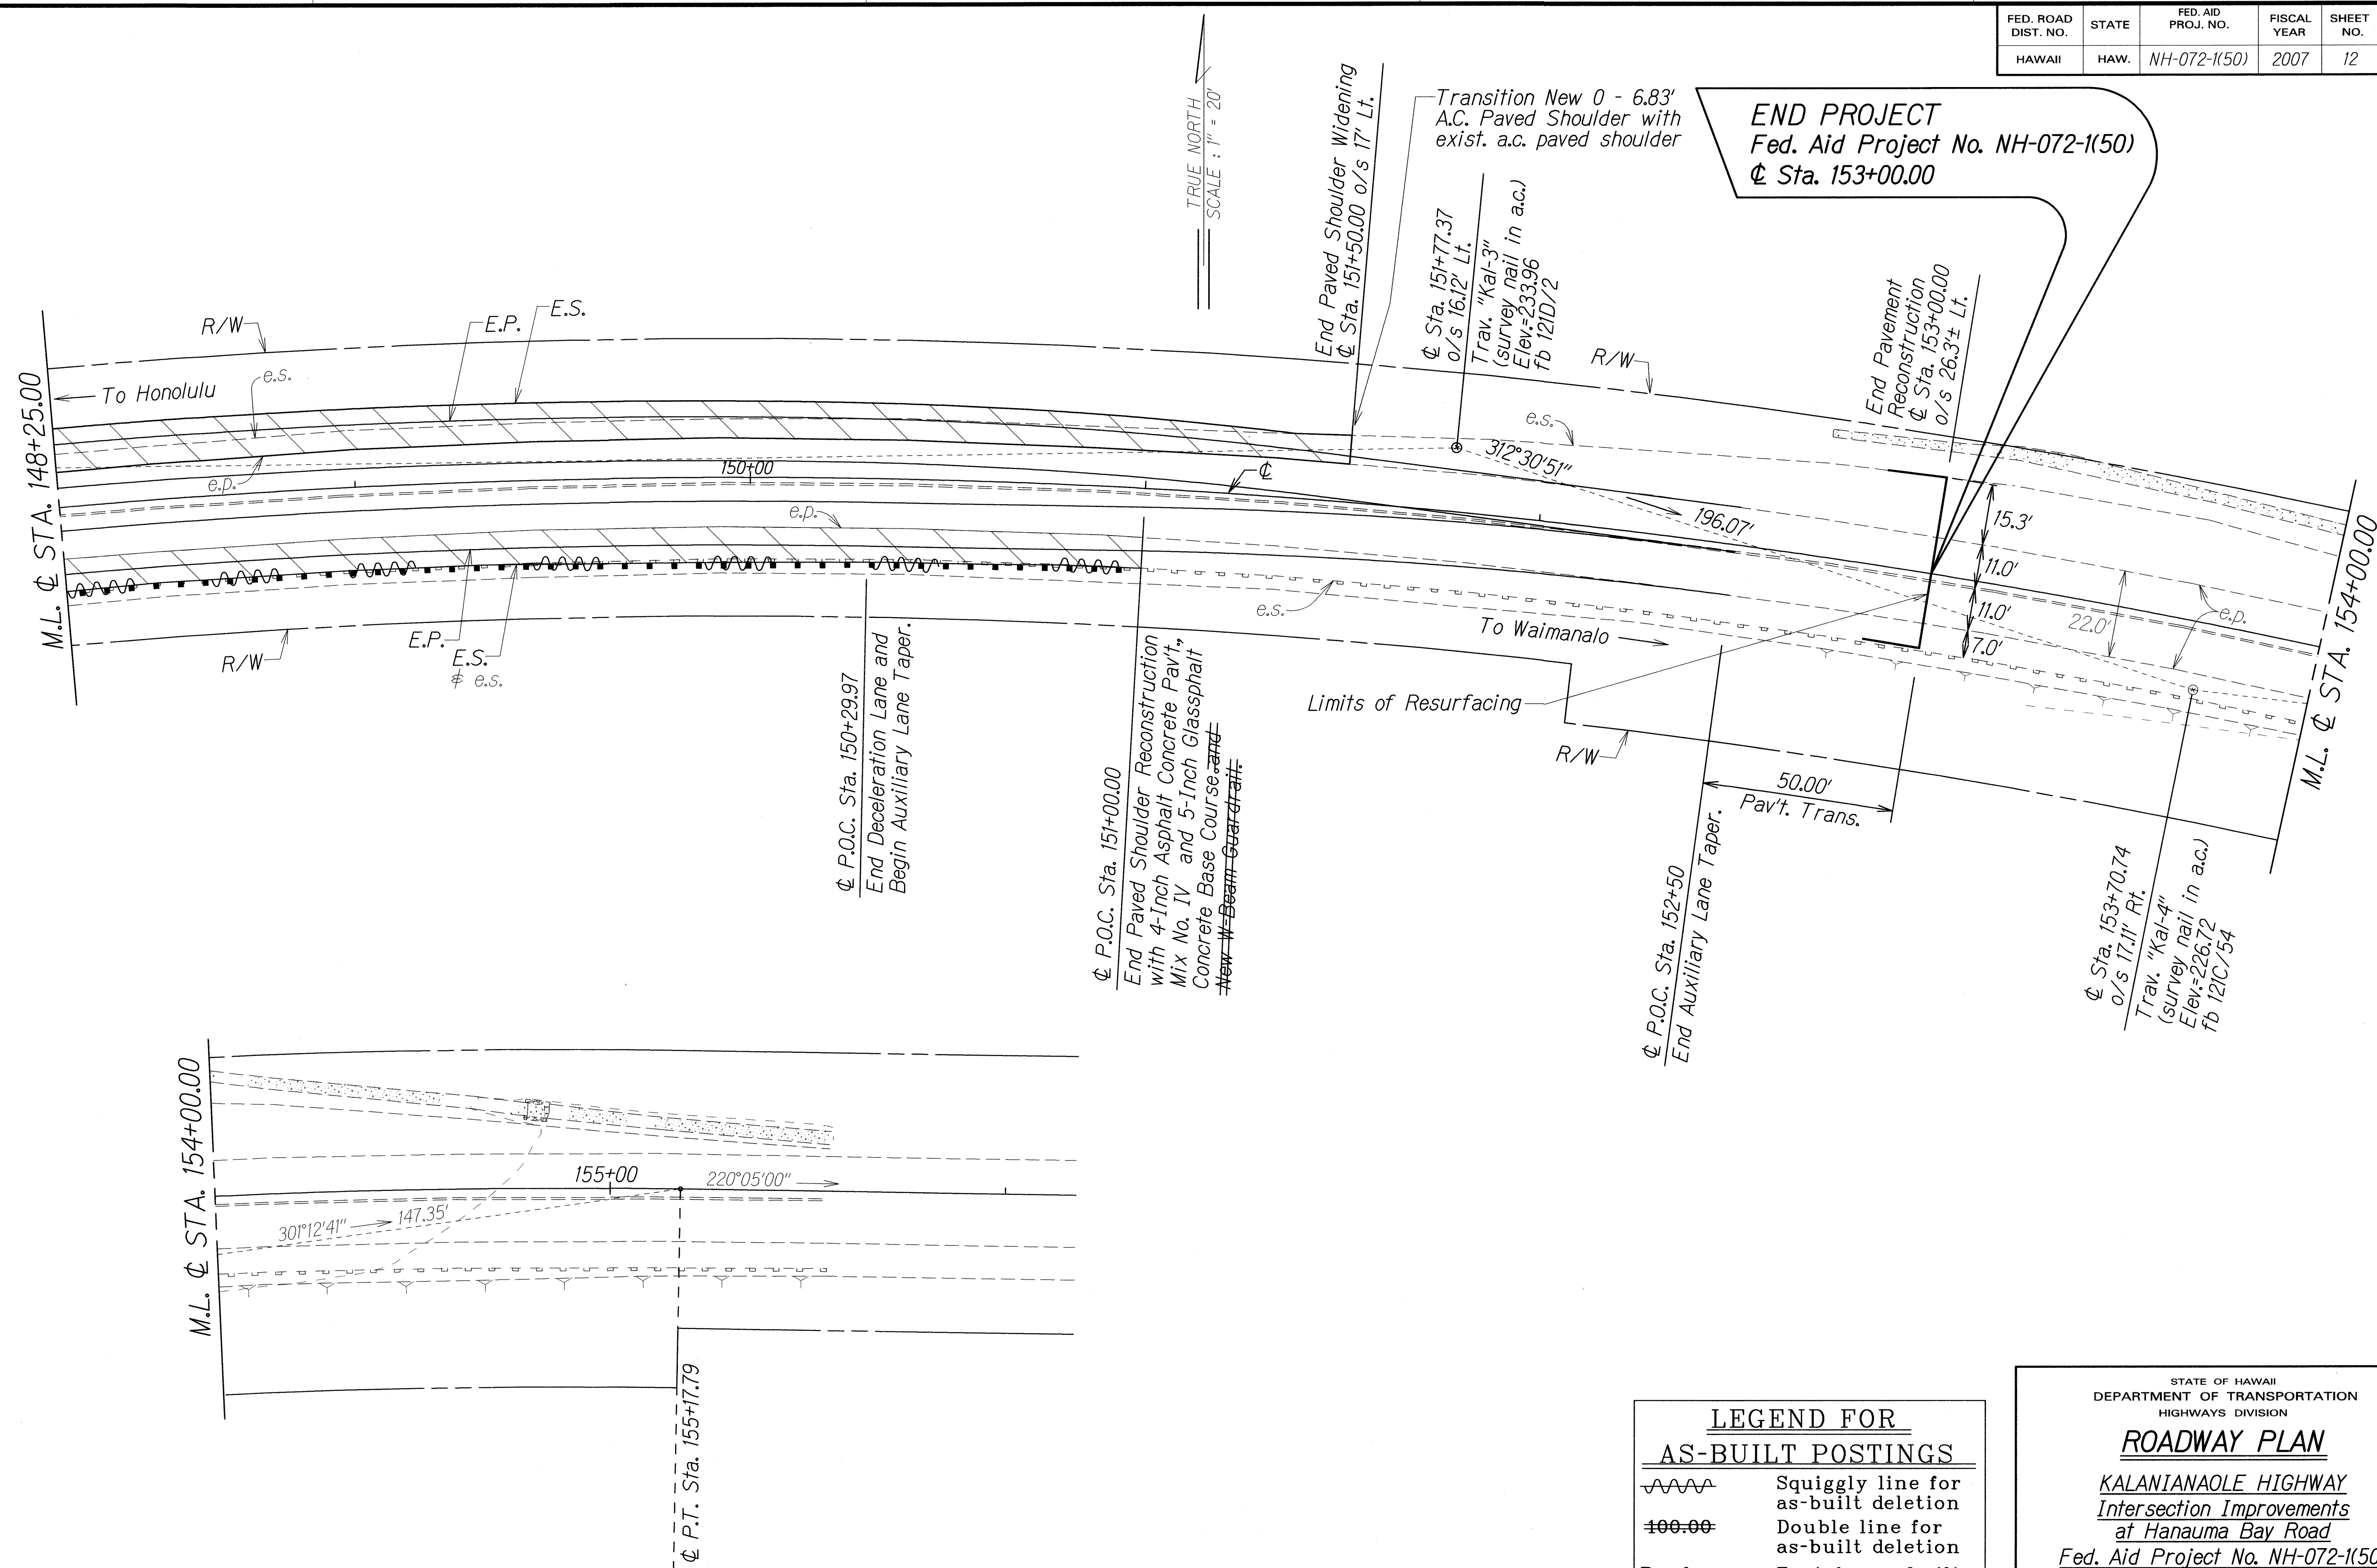

LEGEND FOR AS-BUILT POSTINGS	
	Squiggly line for as-built deletion
	Double line for as-built deletion
Roadway	Text for as-built posting

STATE OF HAWAII
DEPARTMENT OF TRANSPORTATION
HIGHWAYS DIVISION

ROADWAY PLAN

KALANIANA'OLE HIGHWAY
Intersection Improvements
at Hanauma Bay Road
Fed. Aid Project No. NH-072-1(50)

Scale: 1"=20' Date: July 2006

SHEET No. 3 OF 3 SHEETS