

INDEX TO DRAWINGS	
SHEET NO.	DESCRIPTION
1	TITLE SHEET
2	STANDARD PLANS SUMMARY
3	GENERAL NOTES AND LEGEND
4 - 5	WATER POLLUTION AND EROSION CONTROL NOTES
6	TYPICAL SECTIONS AND DETAILS
7 - 9	PORTABLE CONCRETE BARRIER, GUARDRAIL DETAILS AND NOTES
10 - 12	ROADWAY PLANS
13 - 15	PAVEMENT GRADE PLANS
16	PAVEMENT MARKING LEGEND, DETAILS AND NOTES
17	LOW SPEED UNDIVIDED HIGHWAY WORK ZONE SIGNING PLAN, NOTES & DETAILS
18 - 20	PAVEMENT MARKING AND STRIPING PLANS
21	TRAFFIC CONTROL PLAN
22 - 24	CROSS SECTIONS

STATE OF HAWAII

DEPARTMENT OF TRANSPORTATION

HIGHWAYS DIVISION

HONOLULU, HAWAII

"AS-BUILT"

PLANS FOR

KALANIANA'OLE HIGHWAY

INTERSECTION IMPROVEMENTS




AT HANAUMA BAY ROAD

FEDERAL-AID PROJECT NO. NH-072-1(50)

DISTRICT OF HONOLULU

ISLAND OF OAHU

FED. ROAD DIST. NO.	STATE	FED. AID PROJ. NO.	FISCAL YEAR	SHEET NO.	TOTAL SHEETS
HAWAII	HAW.	NH-072-1(50)	2007	1	24

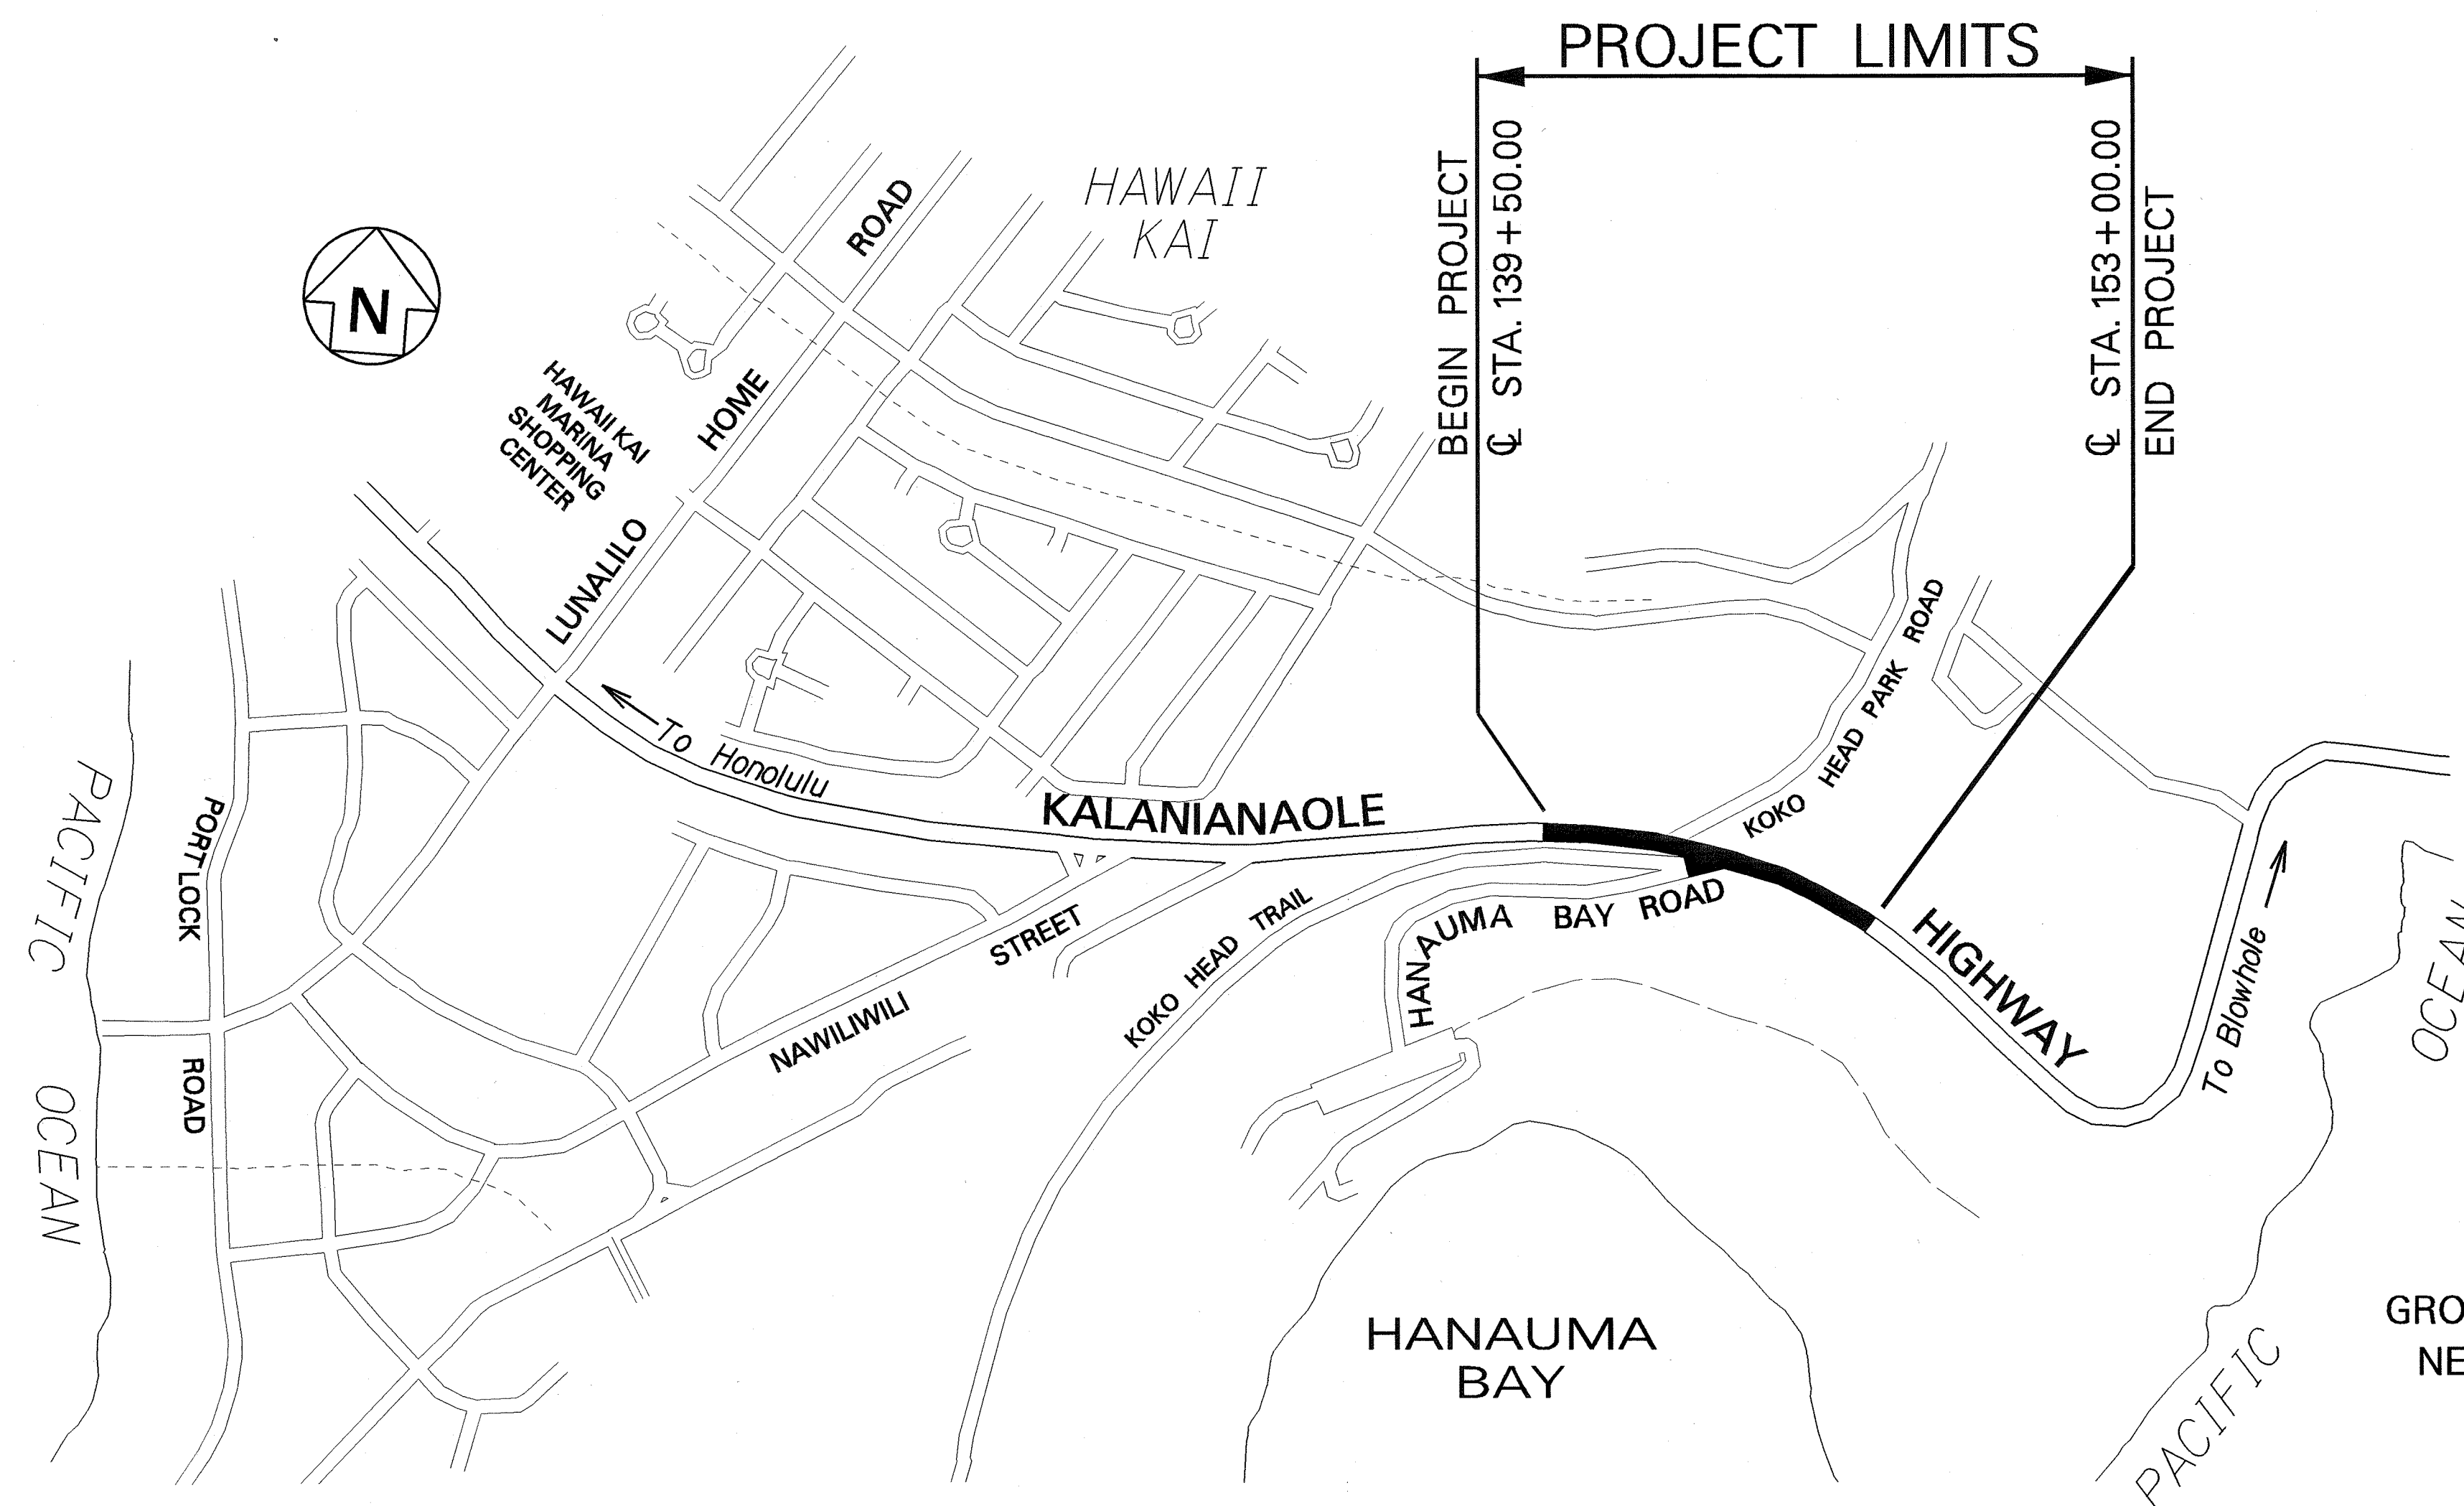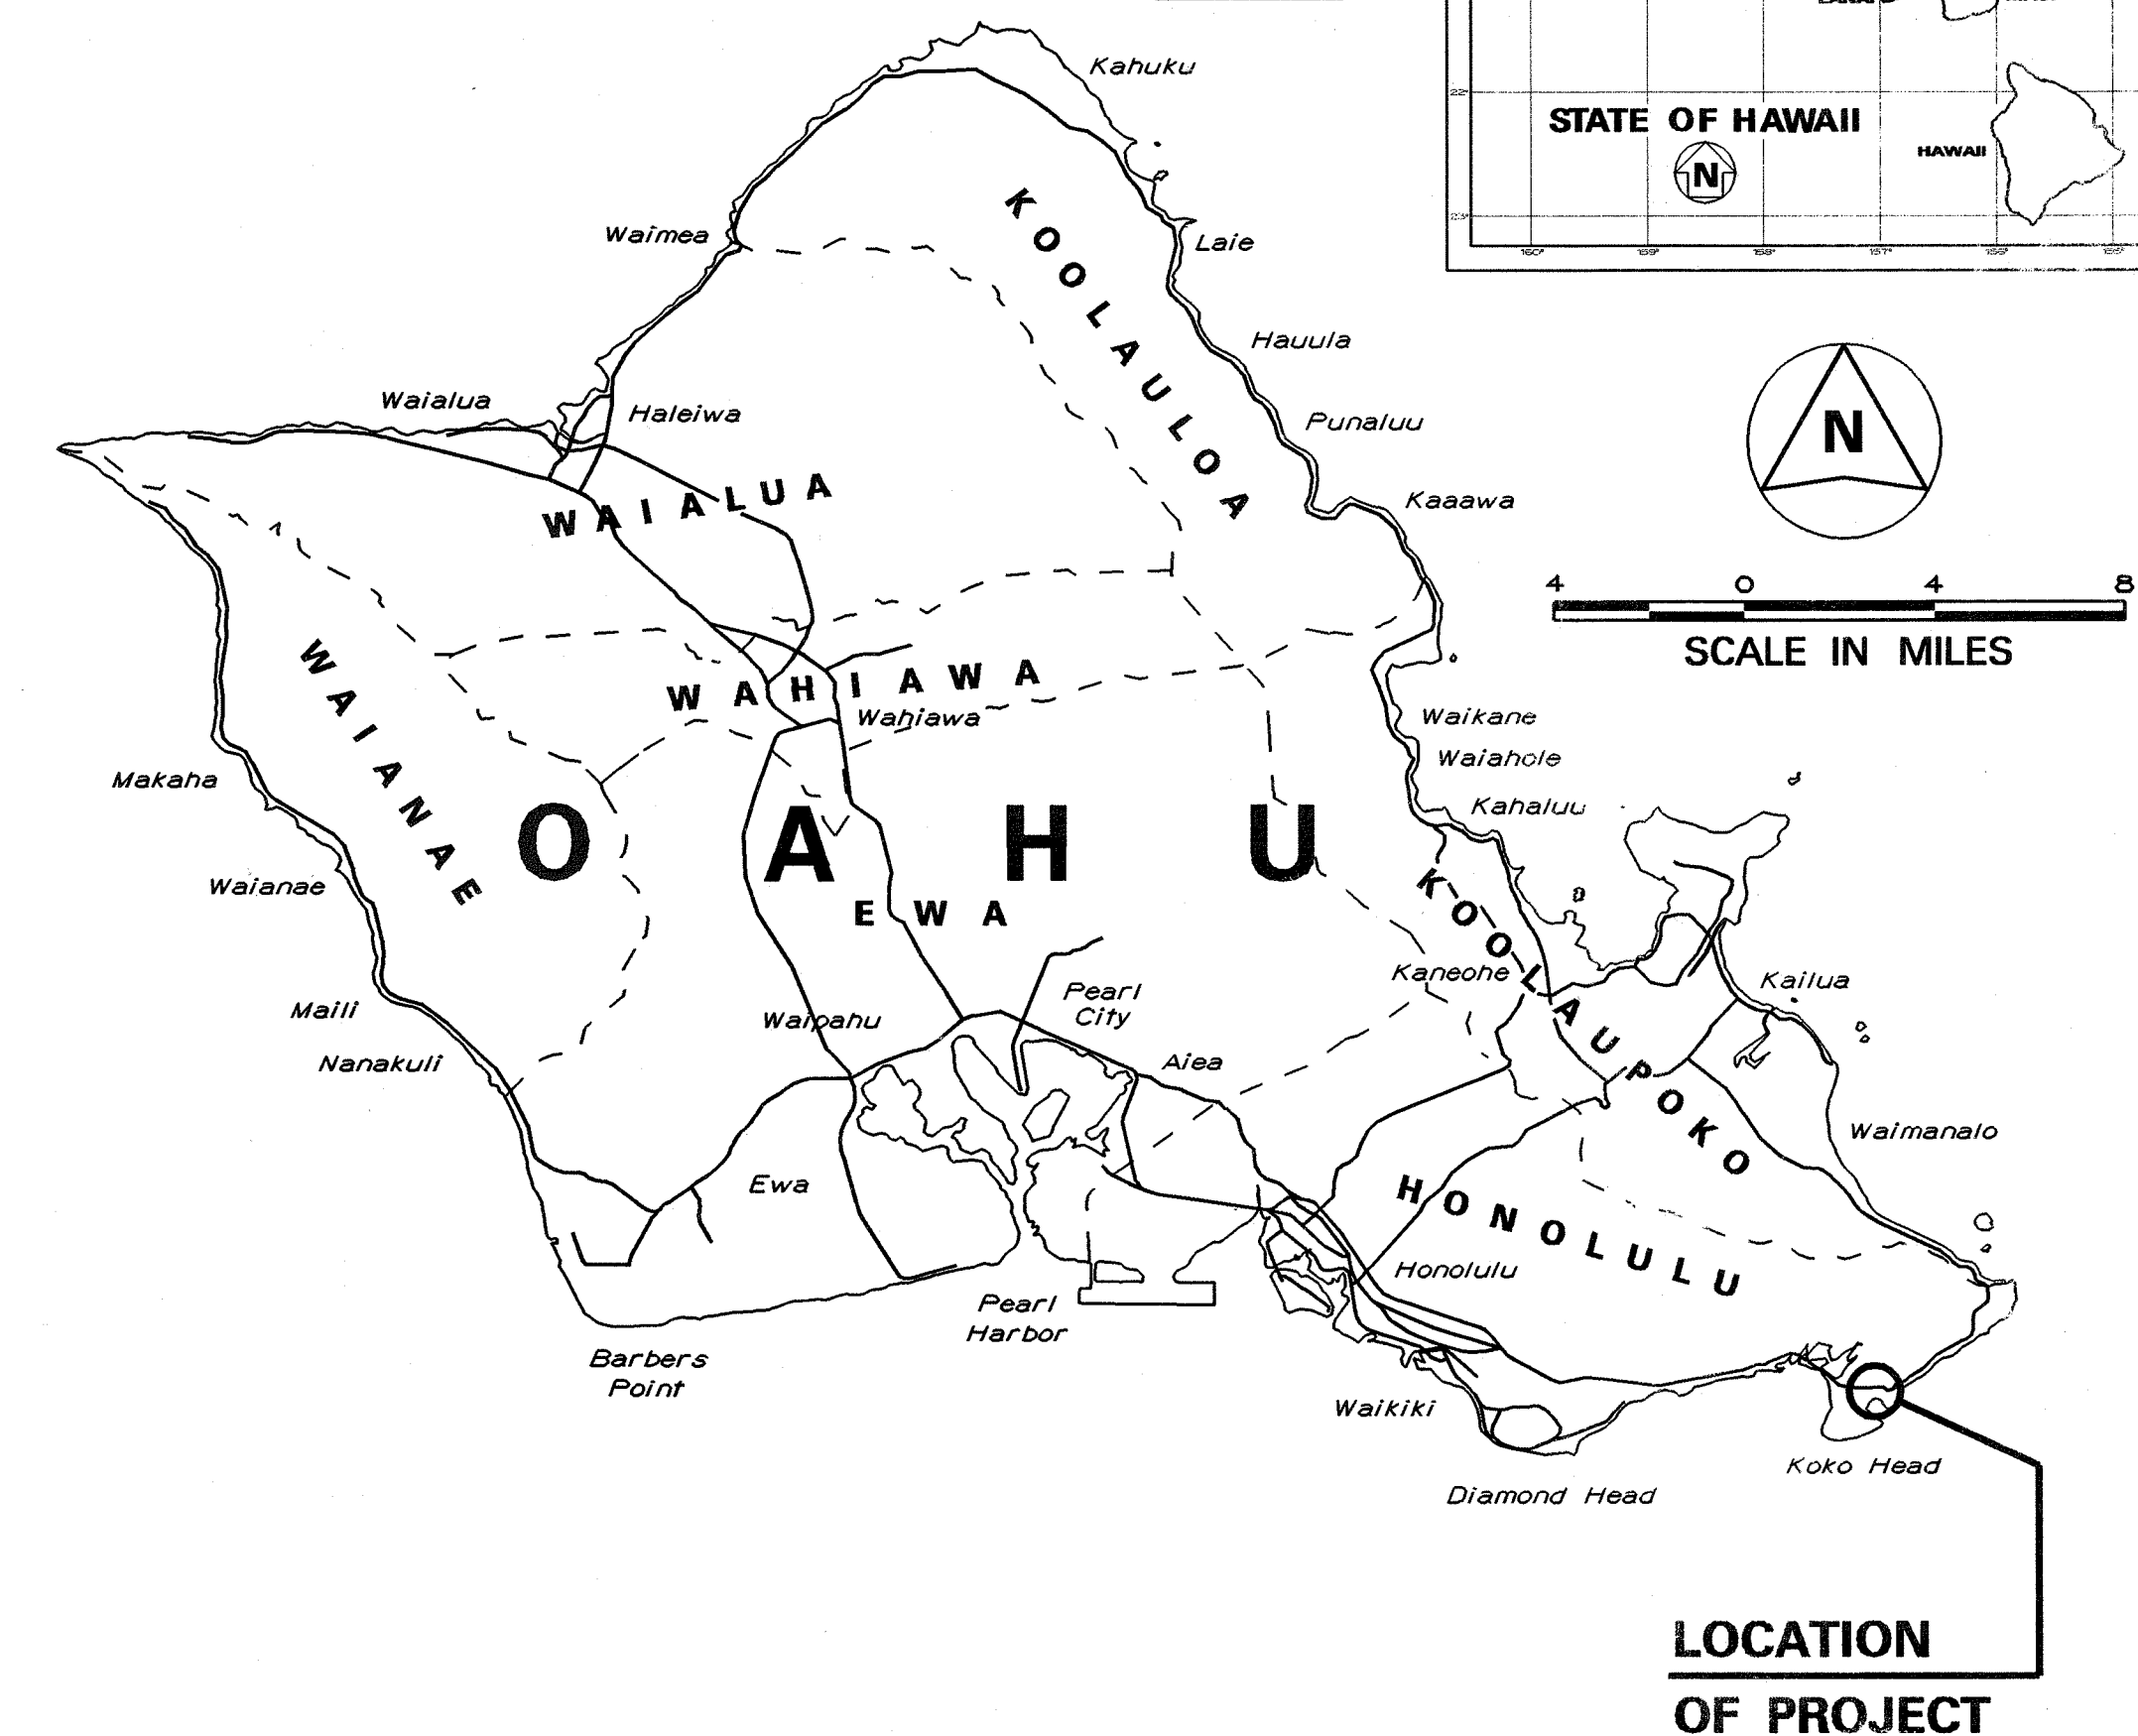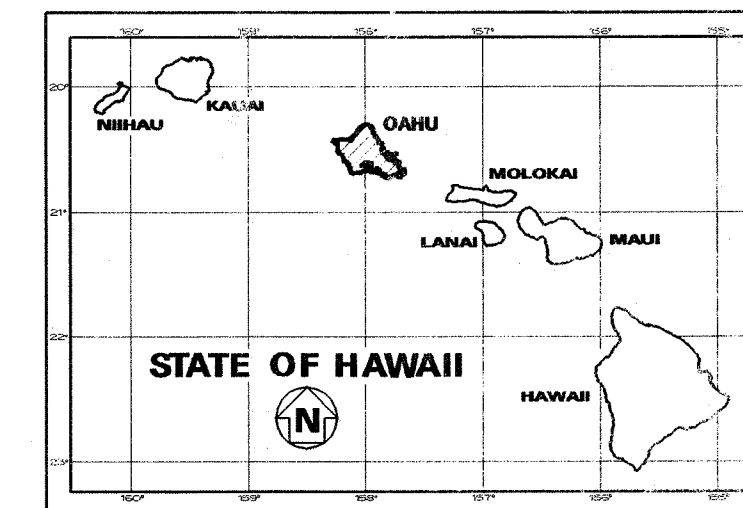

MILE POST 12.33 TO MILE POST 12.60

DESIGN DESIGNATION


ADT (2006).....	10,700
ADT (2026).....	12,600
DHV	1,010
D	60/40
T24	5.0%
VDES	40 M.P.H.

CHANGES MADE DURING CONSTRUCTION HAVE BEEN INCORPORATED ON THESE PLANS EXCEPT CHANGES IN THE ORIGINAL THEORETICAL QUANTITIES. FOR ACTUAL QUANTITIES, REFER TO PROJECT LEDGER AND/OR COMPUTATION BOOK.

Marvin C. H. J. H. 1-12-2012
RESIDENT ENGINEER DATE

LAYOUT PLAN

GROSS LENGTH OF PROJECT..... 0.27 MILES
NET LENGTH OF PROJECT..... 0.27 MILES

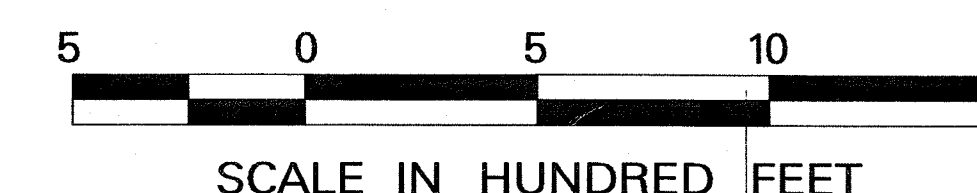

DEPARTMENT OF TRANSPORTATION STATE OF HAWAII	
APPROVED:	
<i>[Signature]</i>	5/4/07
DIR. OF TRANSPORTATION	DATE

DESIGNED BY
MANAGED BY
HWY-TD
HWY-T
JULY 2006
DATE
692-7680
PHONE