


FED. ROAD DIST. NO.	STATE	FED. AID PROJ. NO.	FISCAL YEAR	SHEET NO.	TOTAL SHEETS
HAWAII	HAW.	NH-072-1(51)	2007	14	106



Legend:
TB = Top of Barrier Elevation
BB = Bottom of Barrier Elevation
(on roadway side)

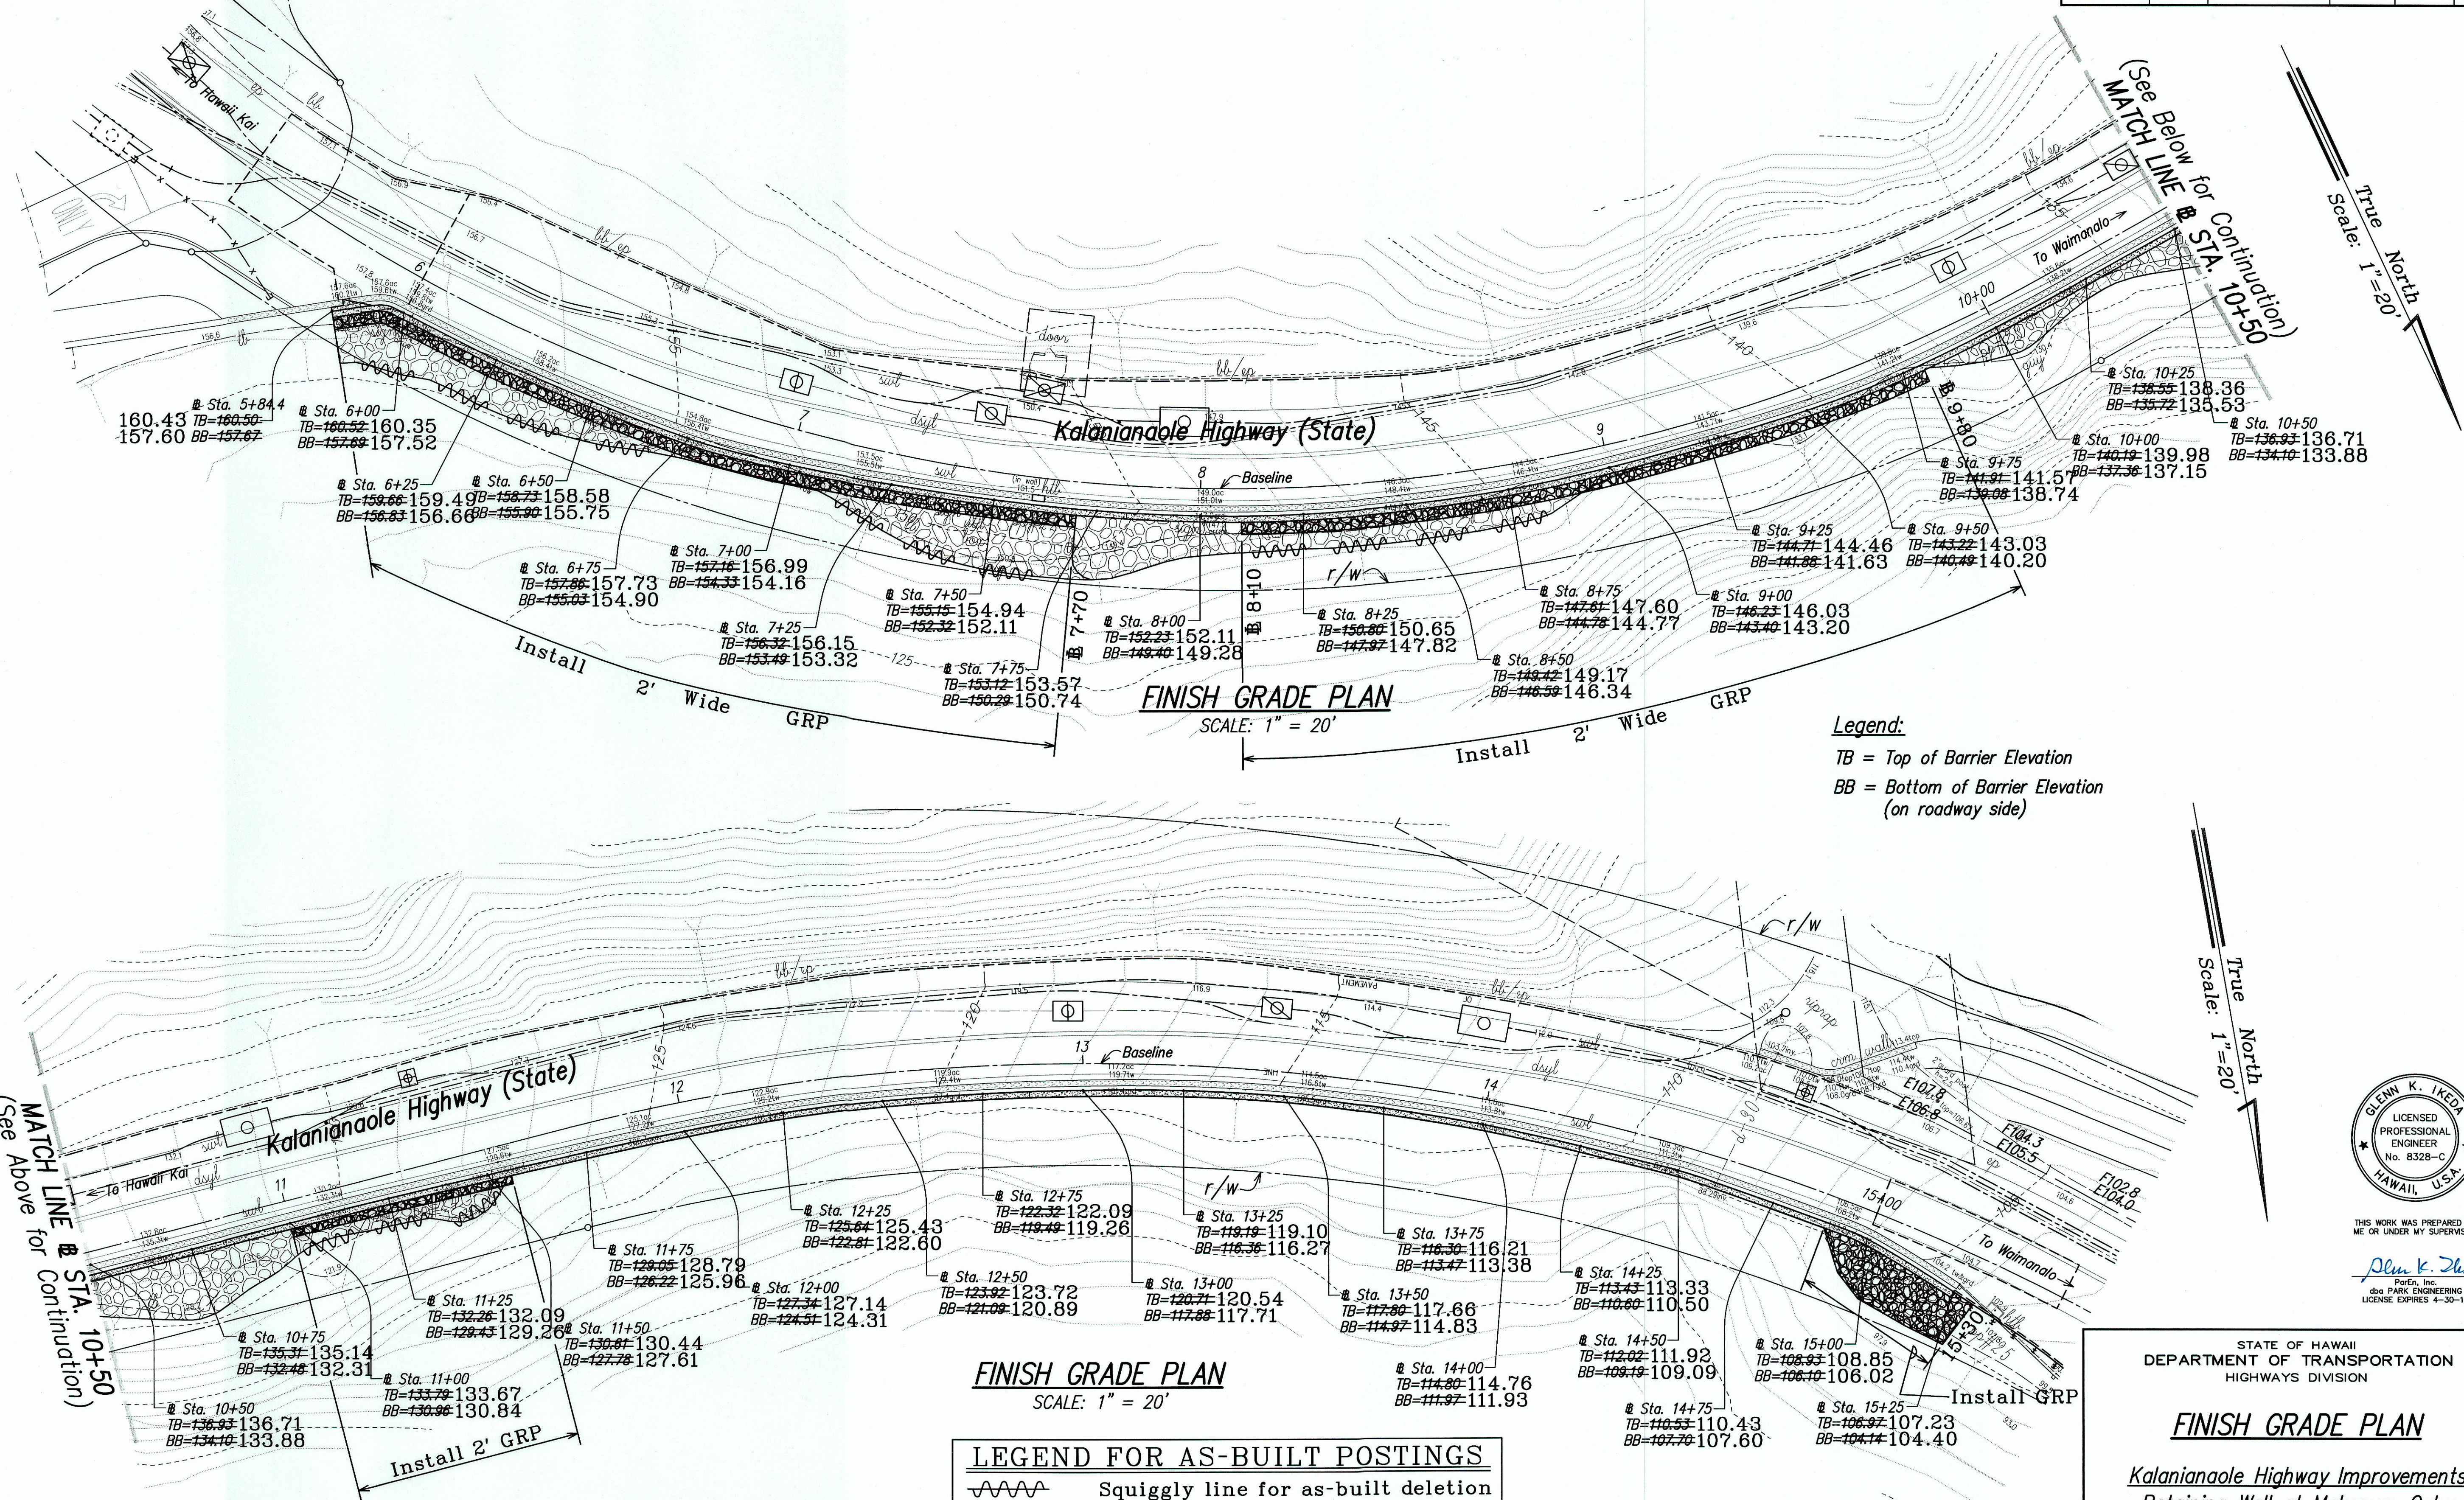

THIS WORK WAS PREPARED BY ME OR UNDER MY SUPERVISION

Glenn K. Ikeda
P.E., Inc.
d/b/a PARK ENGINEERING
LICENSE EXPIRES 4-30-14

STATE OF HAWAII
DEPARTMENT OF TRANSPORTATION
HIGHWAYS DIVISION

FINISH GRADE PLAN

*Kalanianaʻole Highway Improvements
Retaining Wall at Makapuu, Oahu
Federal-Aid Project No. NH-072-1(51)*

Scale: As Noted Date: APR. 2007
SHEET No. C7 OF C10 SHEETS

"AS-BUILT"