

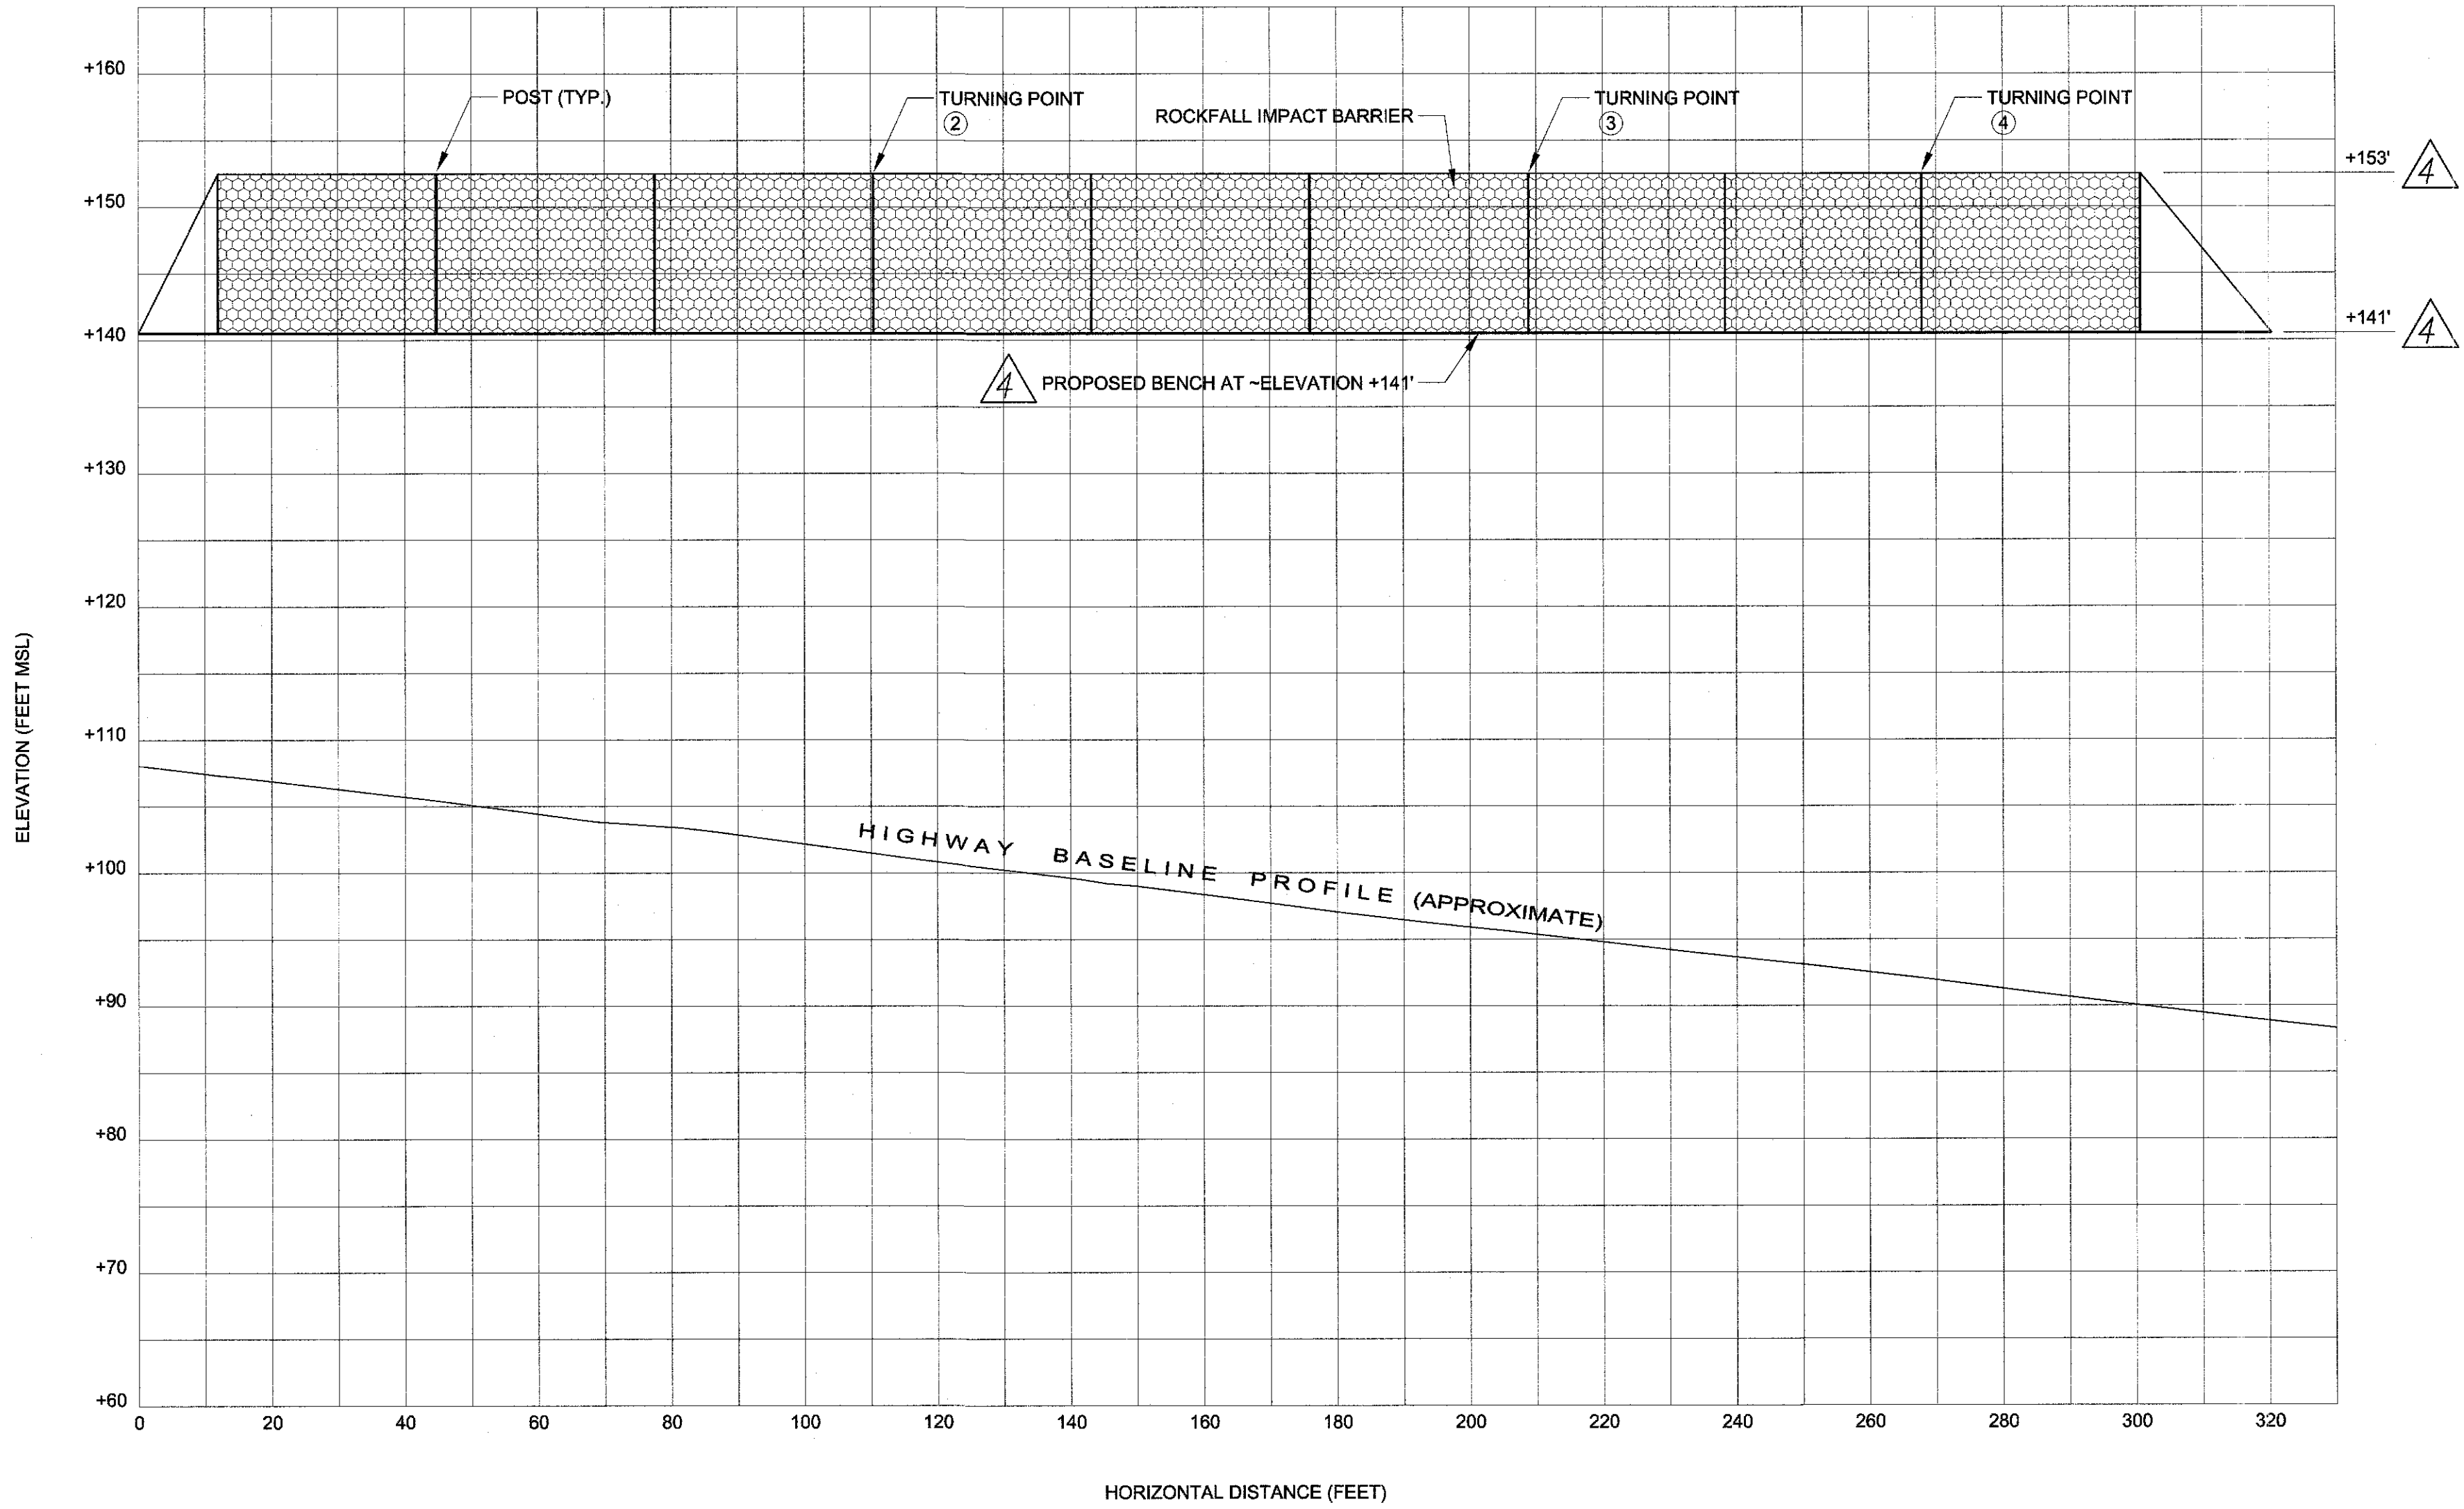


FED. ROAD DIST. NO.	STATE	FED. AID PROJ. NO.	FISCAL YEAR	SHEET NO.	TOTAL SHEETS
HAWAII	HAW.	NH-072-1(51)	2007	C.O.21	106

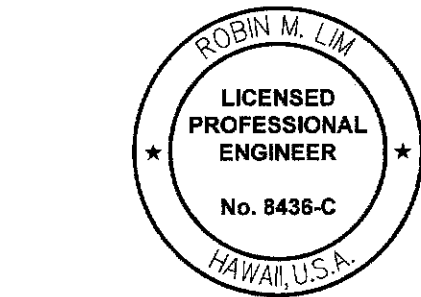

ORIGINAL PLAN	SURVEY PLOTTED BY	DATE
NOTE BOOK	DRAWN BY	
	DESIGNED BY	
	CHECKED BY	
	SUBMITTED BY	

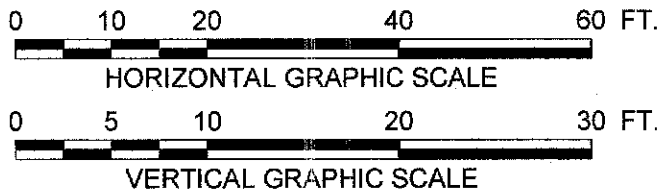

THIS WORK WAS PREPARED BY ME OR UNDER MY SUPERVISION AND CONSTRUCTION OF THIS PROJECT WILL BE UNDER MY OBSERVATION

SIGNATURE: [Signature] EXPIRATION DATE OF THE LICENSE: 4-30-12 GEOLABS, INC.

10/21/09	4 Revised Bench Elevation
DATE	REVISION
STATE OF HAWAII DEPARTMENT OF TRANSPORTATION HIGHWAYS DIVISION	
ROCKFALL IMPACT BARRIER ELEVATION	
Kalaniana'ole Highway Improvements Retaining Wall at Makapuu, Oahu Federal-Aid Project No. NH-072-1(51)	
Scale: As Noted	Date: April 2007
SHEET No. G-4 OF 8 SHEETS	