

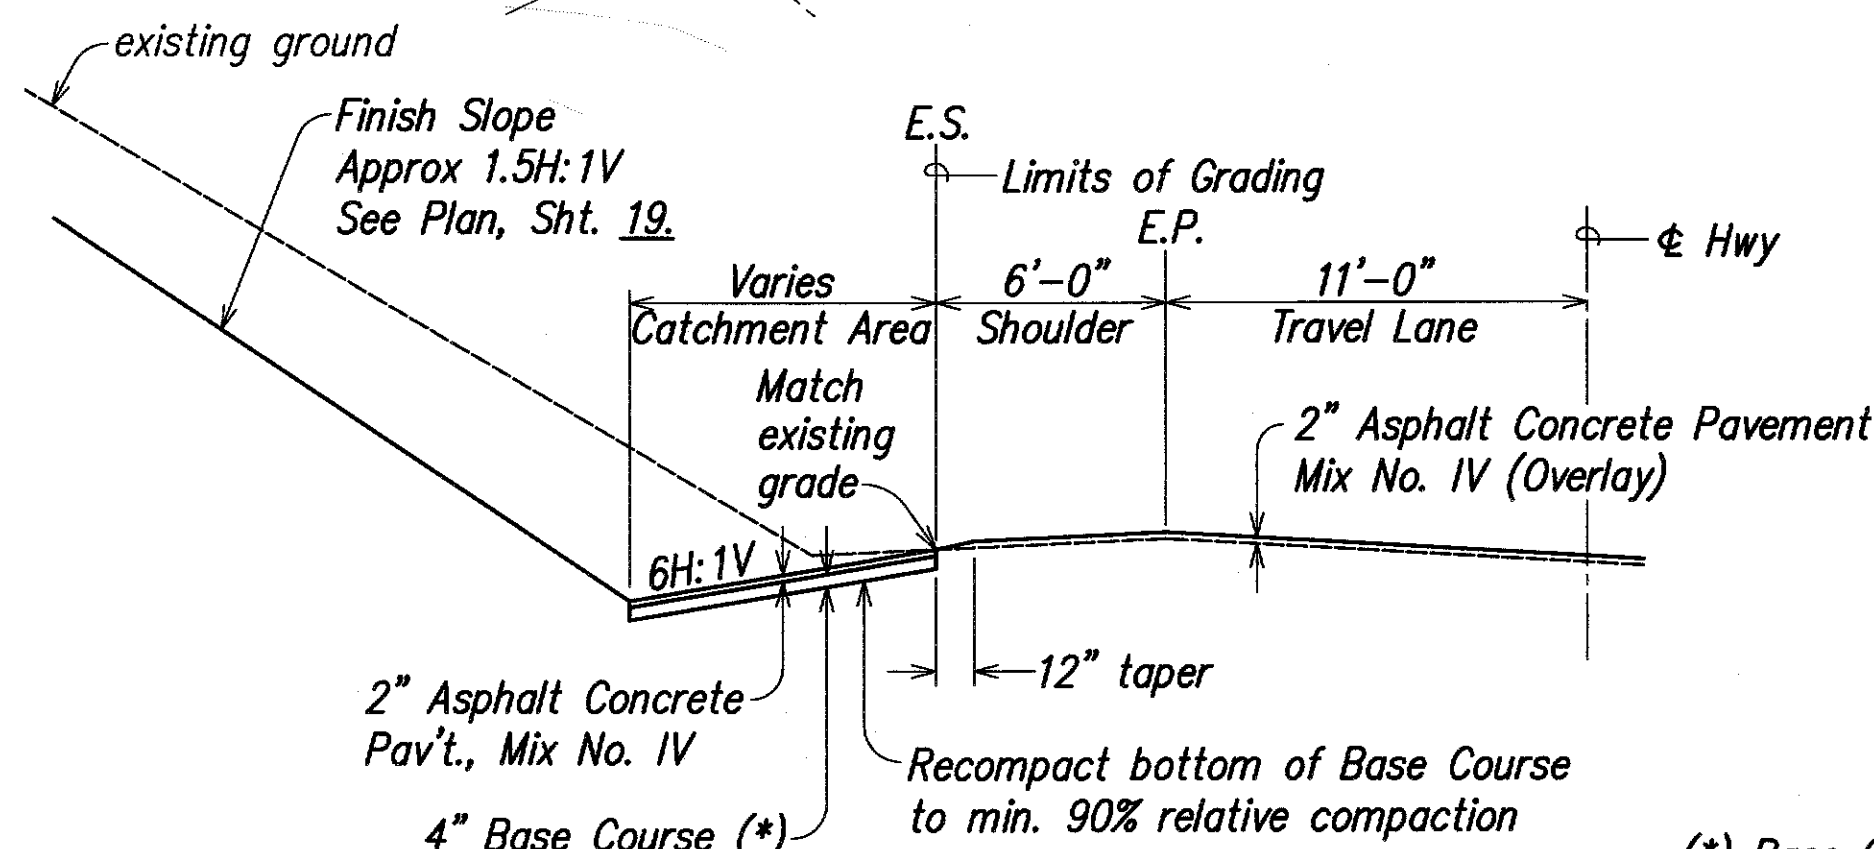


FED. ROAD DIST. NO.	STATE	FED. AID PROJ. NO.	FISCAL YEAR	SHEET NO.	TOTAL SHEETS
HAWAII	HAW.	NH-072-1(51)	2007	C.O.17	106

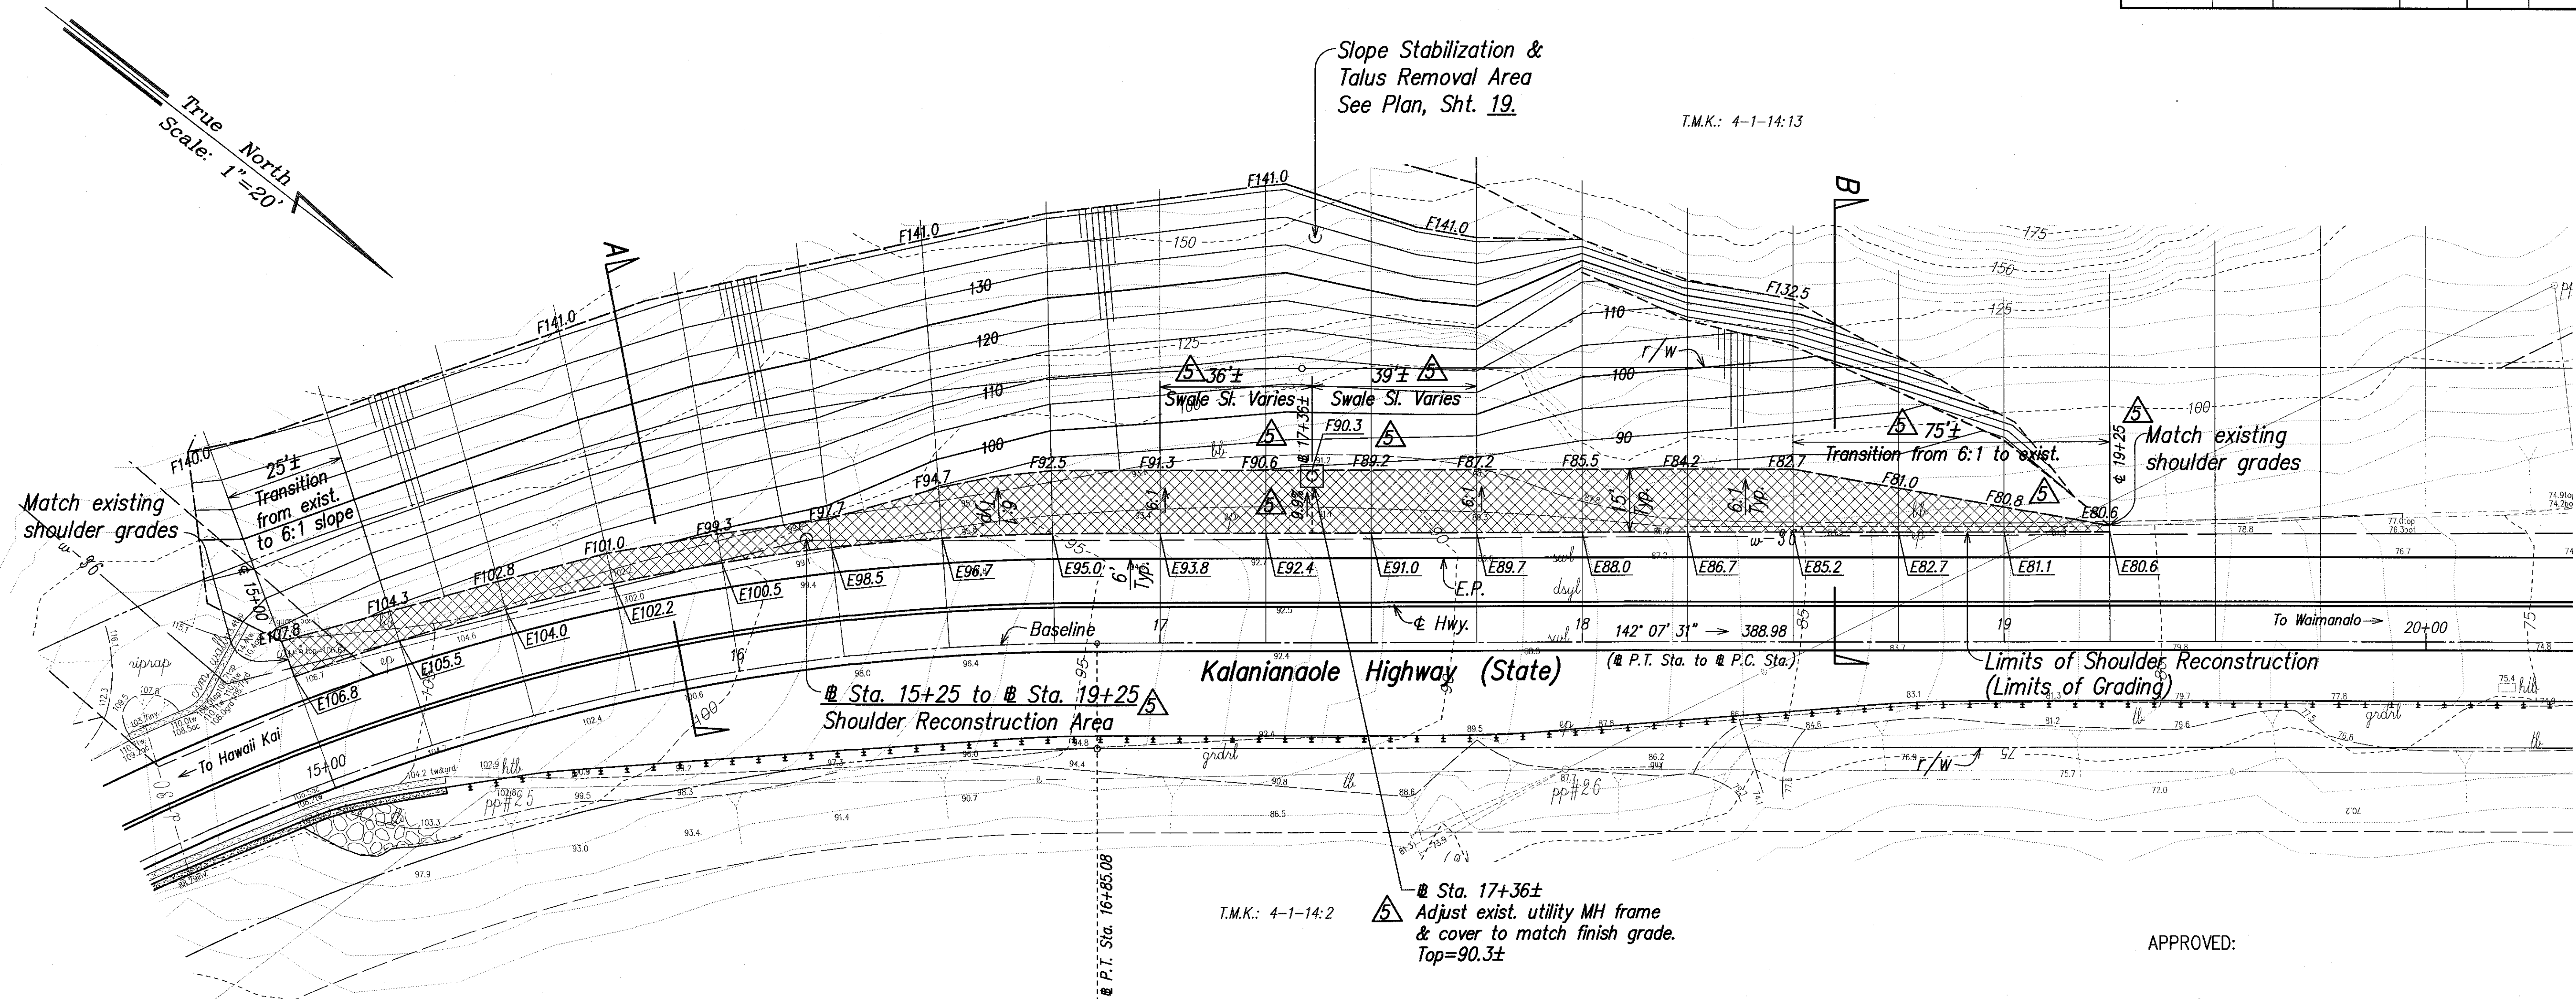

TYPICAL SECTION - A
(Sta. 15+00 to Sta. 16+75)
(Sta. 18+50 to Sta. 19+25)
SCALE: 1" = 5'

(*) Base Course Note:
Base Course to be one of the following:
1. Plant Mix Asphalt Concrete Base Course.
2. Recycled Plant Mix Asphalt Concrete Base Course
3. Plant Mix Glassphalt Concrete Base Course.

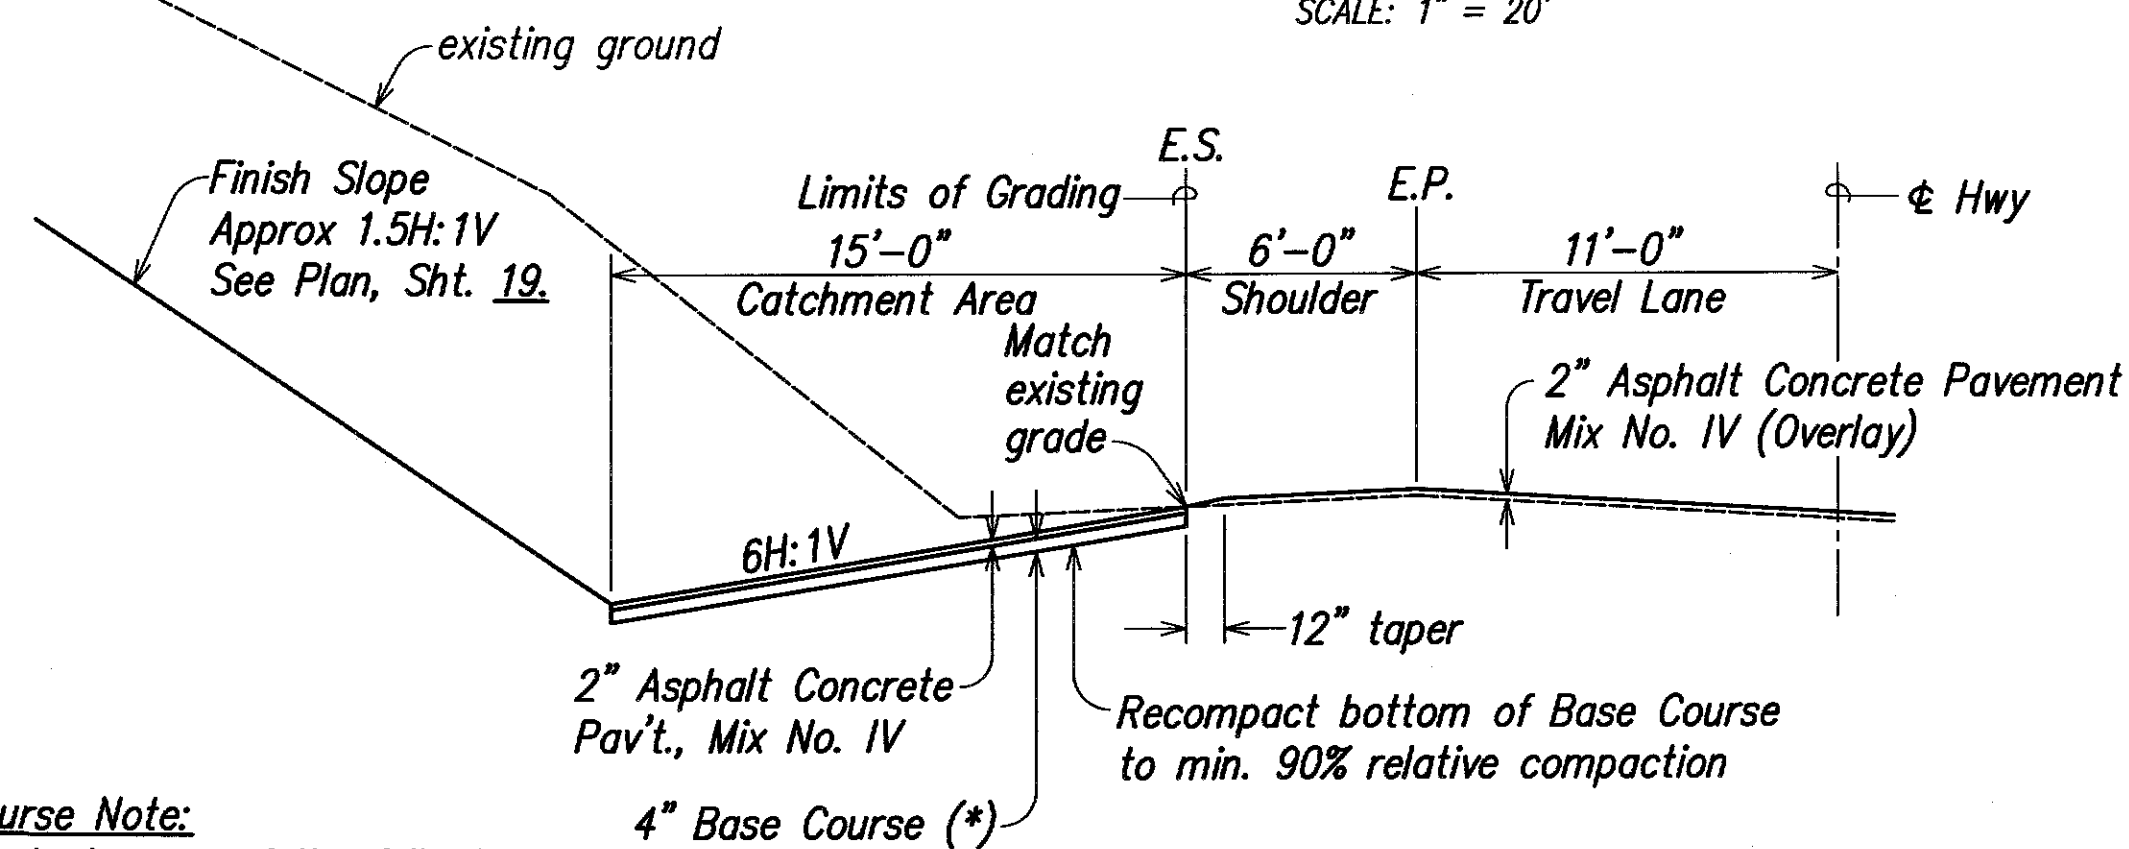

TYPICAL SECTION - B
(Sta. 16+75 to Sta. 18+50)
SCALE: 1" = 5'

LEGEND FOR AS-BUILT POSTINGS	
	Squiggly line for as-built deletion
	Double line for as-built deletion
Roadway	Text for as-built posting

1/25/11	Revised Swale Grades
9/29/09	Deleted Flexible Delineators.
DATE	REVISION



THIS WORK WAS PREPARED BY
ME OR UNDER MY SUPERVISION
ParEn, Inc.
dba: PARK ENGINEERING
LICENSE EXPIRES 4-30-14

STATE OF HAWAII DEPARTMENT OF TRANSPORTATION HIGHWAYS DIVISION	
SHOULDER RECONSTRUCTION PLAN	
Kalaniana'ole Highway Improvements Retaining Wall at Makapuu, Oahu Federal-Aid Project No. NH-072-1(51)	
Scale: As Noted	Date: APR. 2007
SHEET No. C10 OF C10 SHEETS	

"AS-BUILT"

C.O. 17