



FED. ROAD DIST. NO.	STATE	FED. AID PROJ. NO.	FISCAL YEAR	SHEET NO.	TOTAL SHEETS
HAWAII	HAW.	NH-072-1(51)	2007	C.O. 19	106

TURNING POINT	COORDINATES	
①	614,760.39 E	53,217.10 N
②	614,677.71 E	53,270.52 N
③	614,601.84 N	53,333.25 N
④	614,560.56 N	53,375.48 N
⑤	614,549.70 E	53,406.45 N

NOTE:
Contractor to compute and verify ties from the benchmarks shown on Sheets 9 and 13, to the turning points shown in the table.

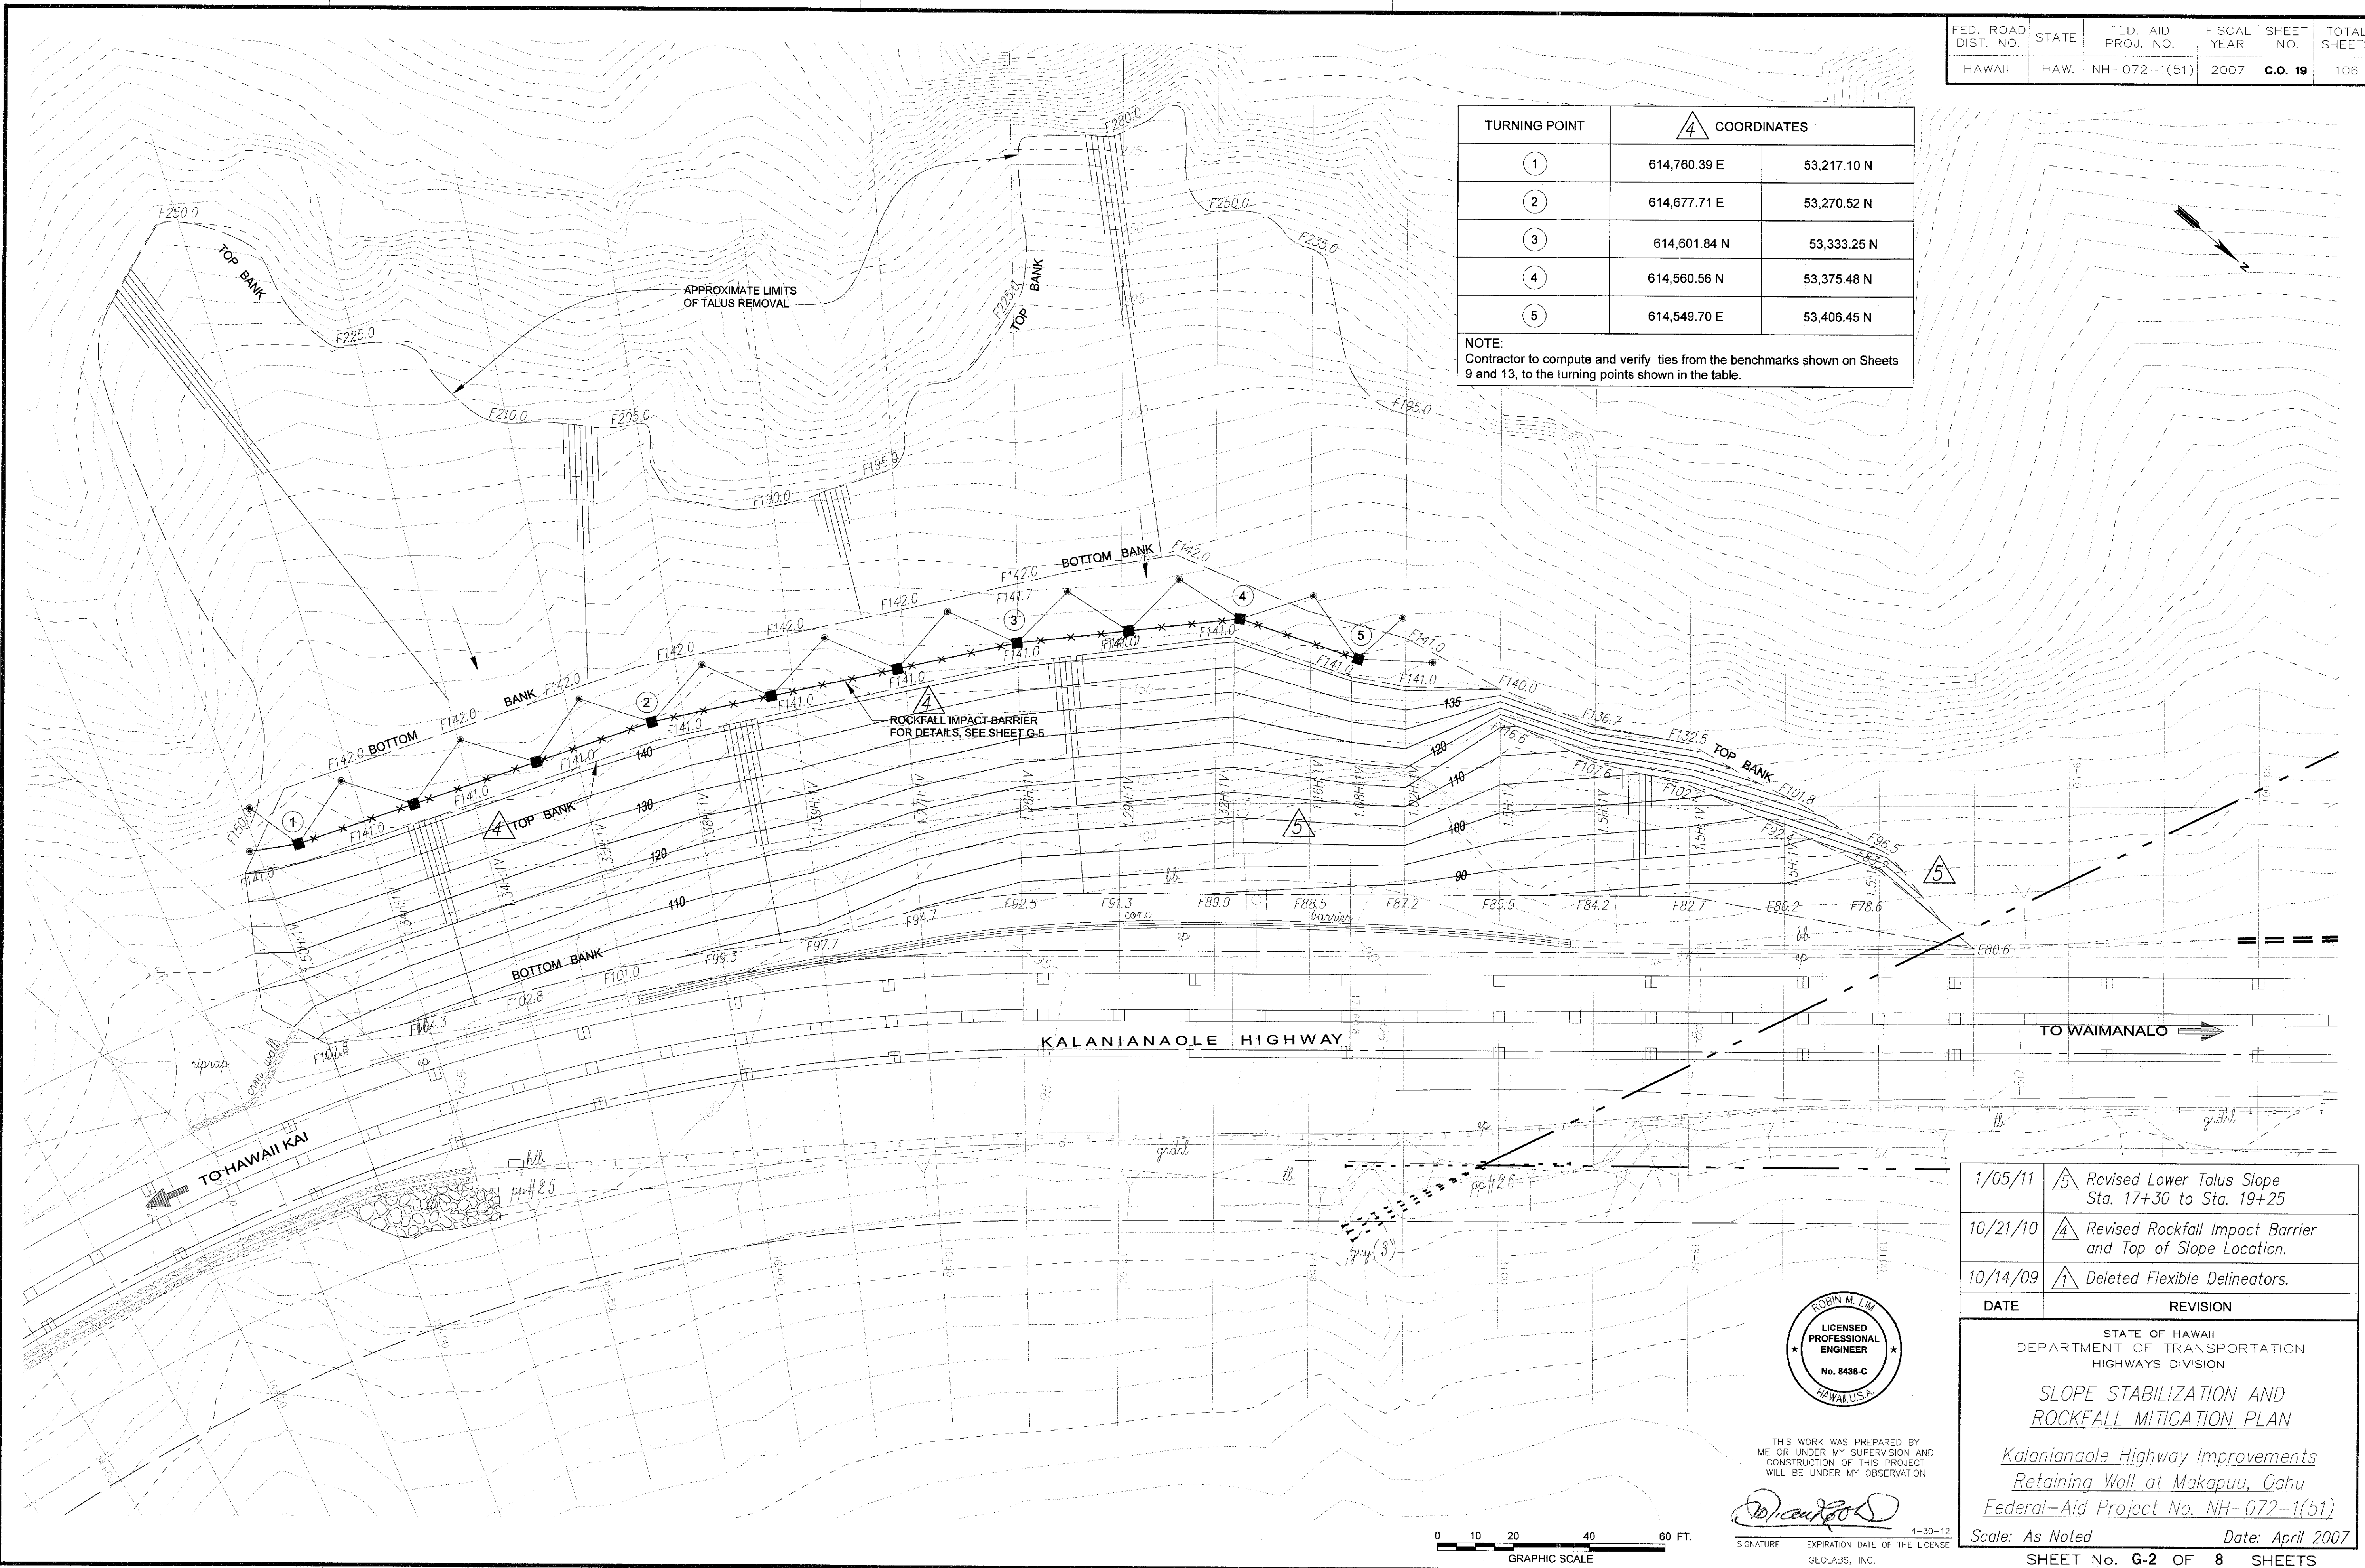

SURVEY PLOTTED BY	DATE
DRAWN BY	
TRACED BY	
NOTE BOOK	
QUANTITIES BY	
CHECKED BY	
NO.	

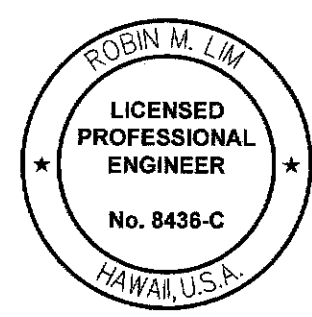

THIS WORK WAS PREPARED BY
ME OR UNDER MY SUPERVISION AND
CONSTRUCTION OF THIS PROJECT
WILL BE UNDER MY OBSERVATION

Robin M. Lim
SIGNATURE

EXPIRATION DATE OF THE LICENSE
GEO LABS, INC.

1/05/11	⑤ Revised Lower Talus Slope Sta. 17+30 to Sta. 19+25
10/21/10	④ Revised Rockfall Impact Barrier and Top of Slope Location.
10/14/09	① Deleted Flexible Delineators.
DATE	REVISION
STATE OF HAWAII DEPARTMENT OF TRANSPORTATION HIGHWAYS DIVISION	
SLOPE STABILIZATION AND ROCKFALL MITIGATION PLAN	
Kalaniana'ole Highway Improvements Retaining Wall at Makapuu, Oahu Federal-Aid Project No. NH-072-1(51)	
Scale: As Noted	Date: April 2007
SHEET No. G-2 OF 8 SHEETS	

