



FED. ROAD DIST. NO.	STATE	FED. AID PROJ. NO.	FISCAL YEAR	SHEET NO.	TOTAL SHEETS
HAWAII	HAW.	NH-072-1(51)	2007	23	106

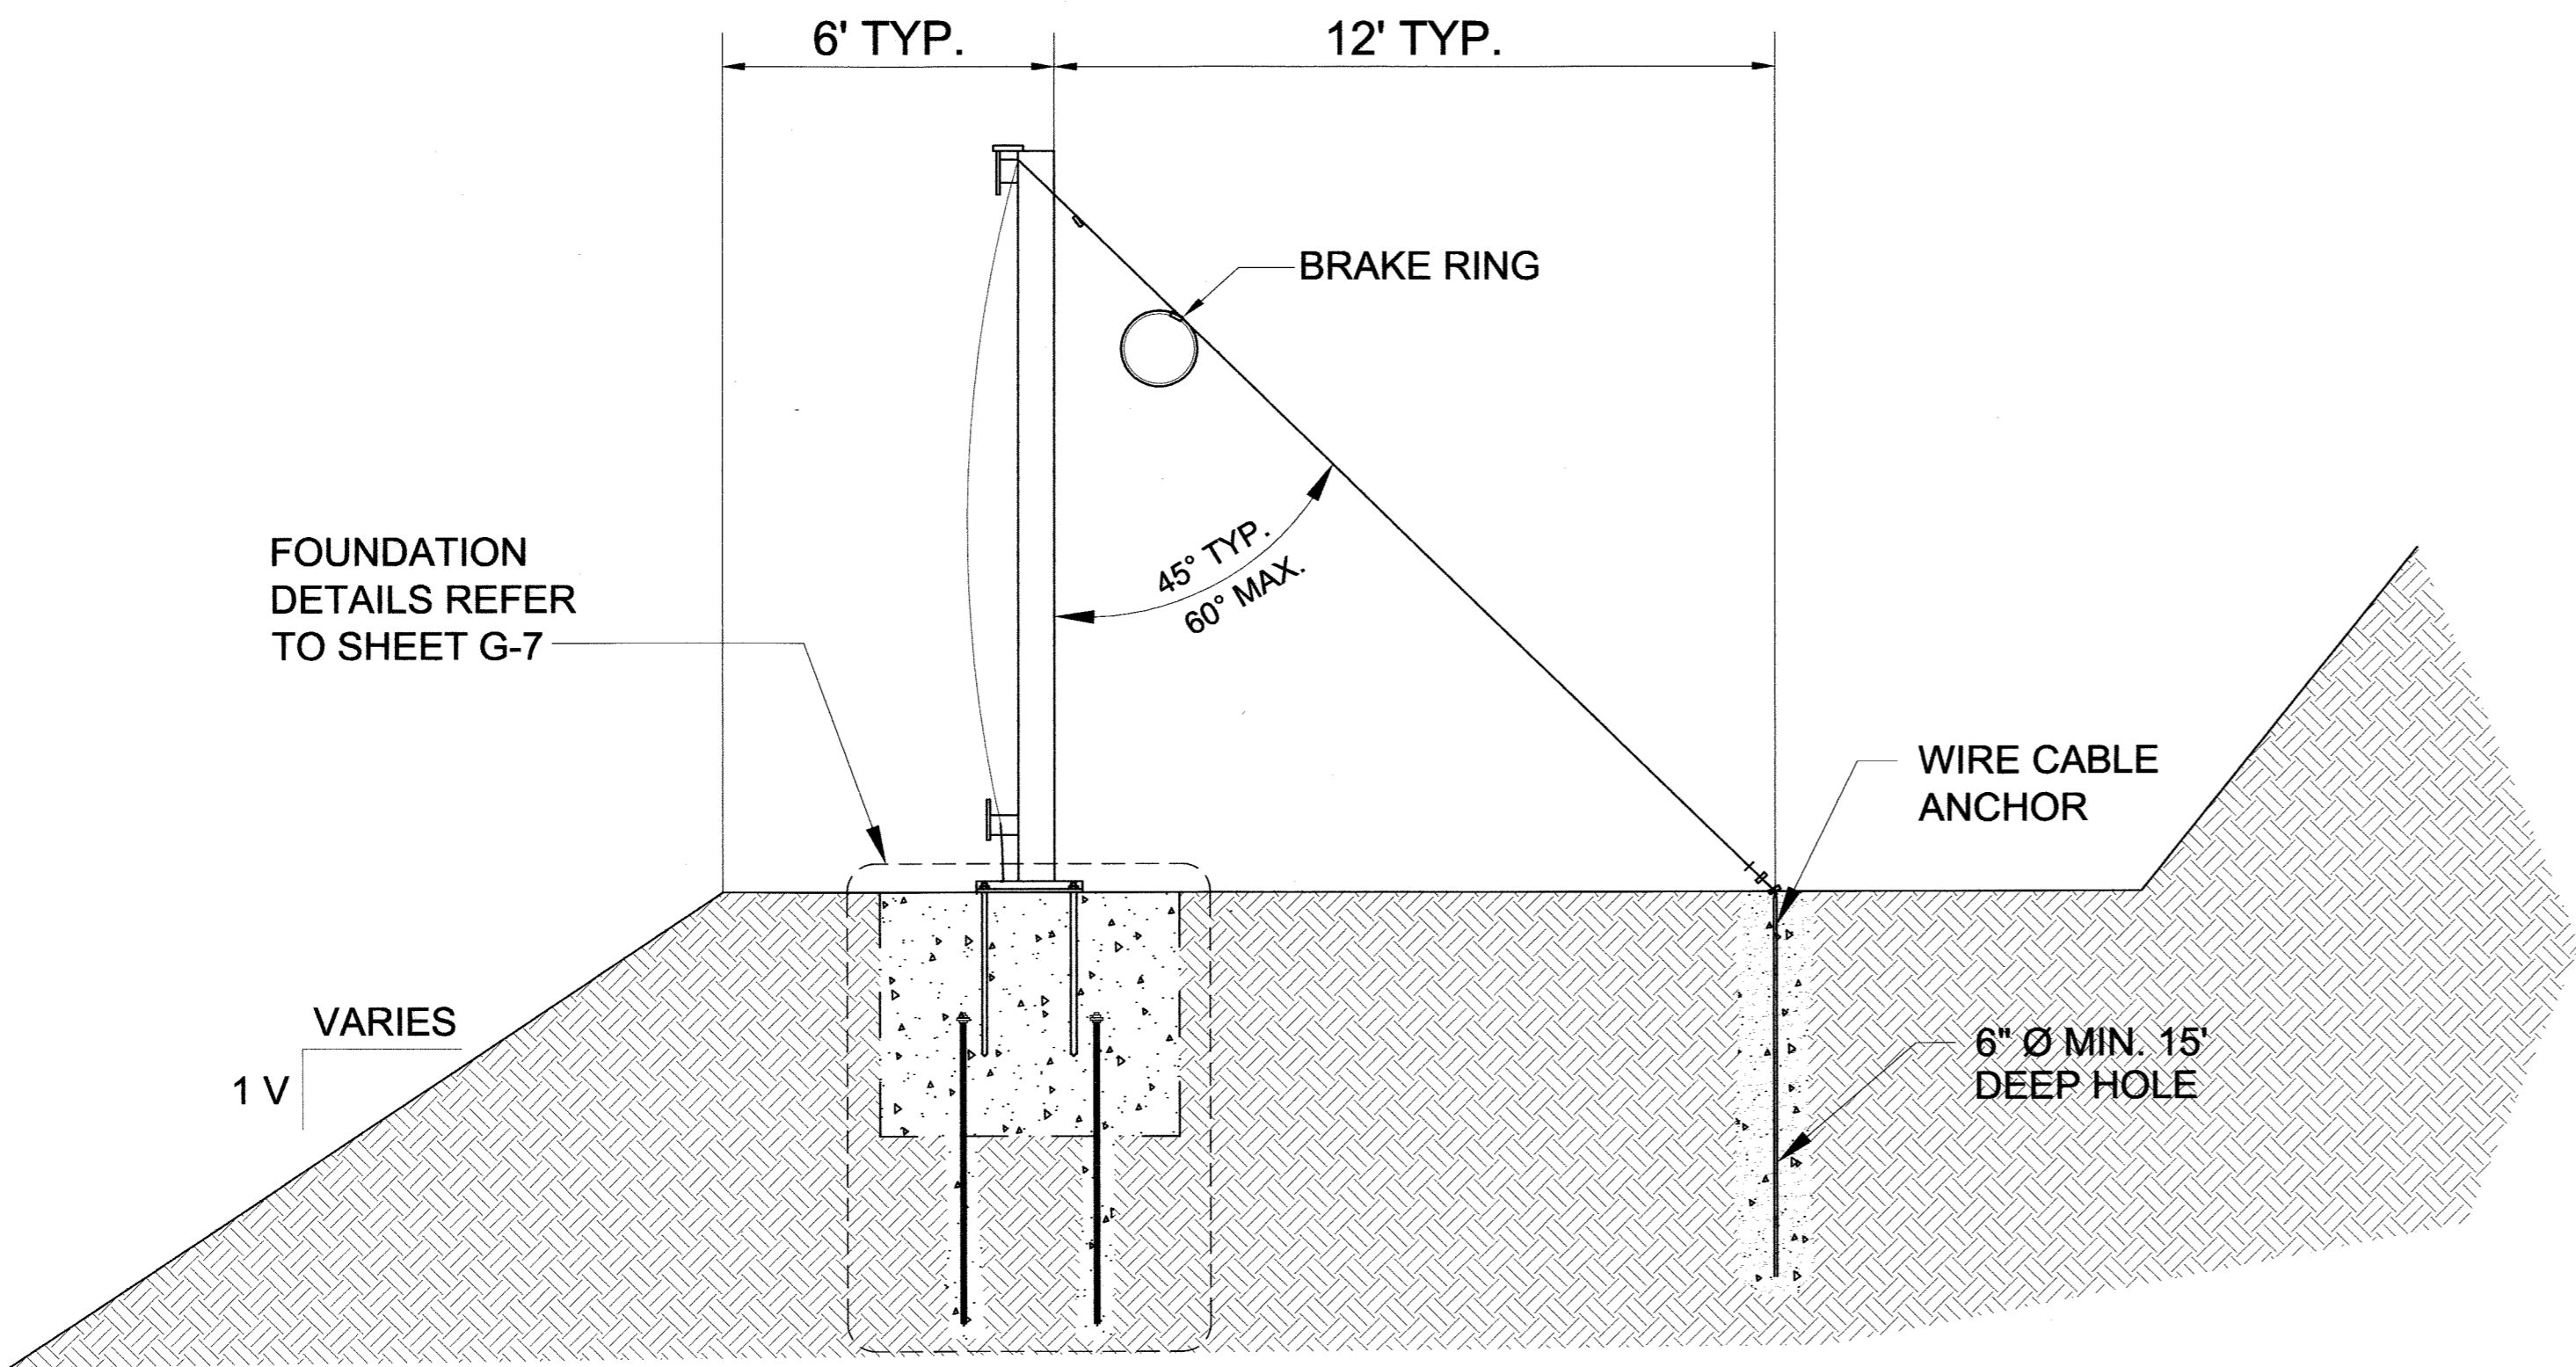


TYPICAL BARRIER CROSS-SECTION
(UPSLOPE RETAINING ANCHOR IN LEVEL BENCH)

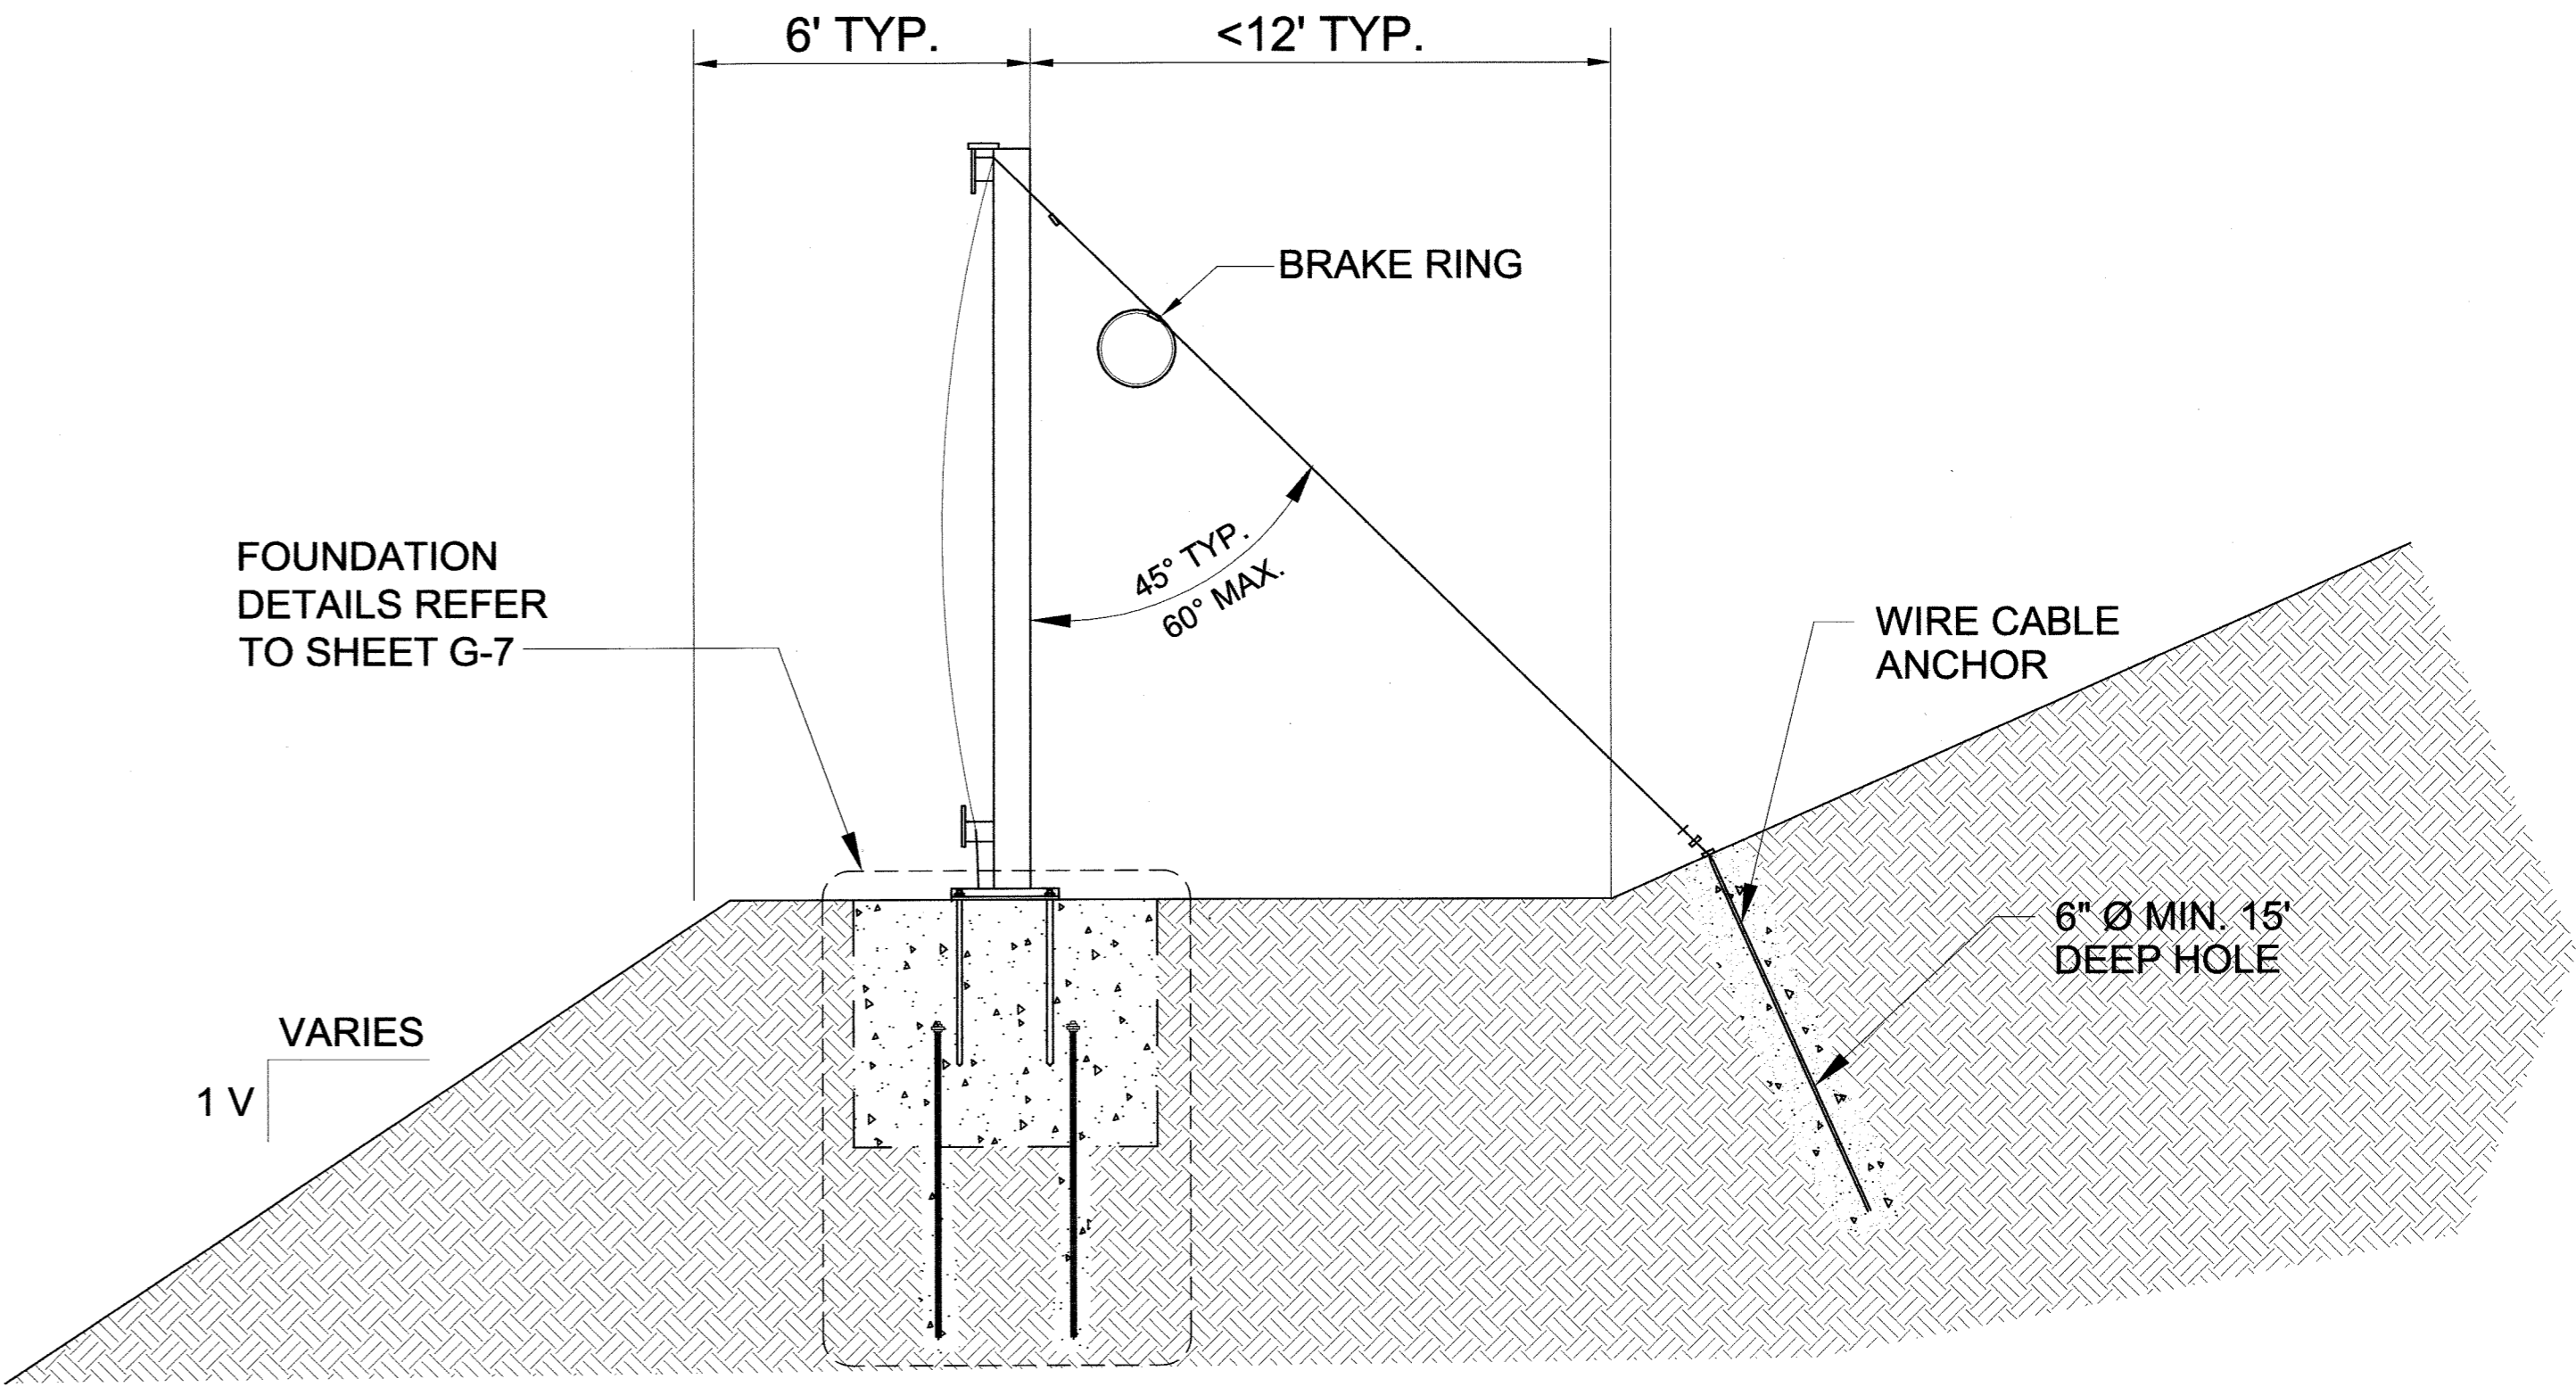

TYPICAL BARRIER CROSS-SECTION
(UPSLOPE RETAINING ANCHOR IN SLOPE)

SURVEY PLOTTED BY	DATE
DRAWN BY	
DESIGNED BY	
QUANTITIES BY	
CHECKED BY	
ORIGINAL PLAN	
NOTE BOOK	
No.	

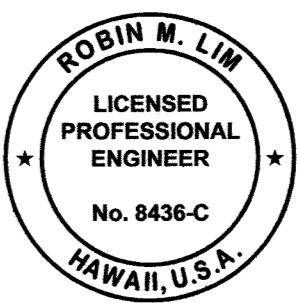

THIS WORK WAS PREPARED BY
ME OR UNDER MY SUPERVISION AND
CONSTRUCTION OF THIS PROJECT
WILL BE UNDER MY OBSERVATION

Robin M. Lim
SIGNATURE
4-30-08
EXPIRATION DATE OF THE LICENSE

STATE OF HAWAII
DEPARTMENT OF TRANSPORTATION
HIGHWAYS DIVISION
TYPICAL BARRIER CROSS-SECTION
Kalaniana'ole Highway Improvements
Retaining Wall at Makapuu, Oahu
Federal-Aid Project No. NH-072-1(51)
Scale: As Noted
Date: April 2007
SHEET No. G-6 OF 8 SHEETS