



FED. ROAD DIST. NO.	STATE	FED. AID PROJ. NO.	FISCAL YEAR	SHEET NO.	TOTAL SHEETS
HAWAII	HAW.	NH-072-1(51)	2007	6	106

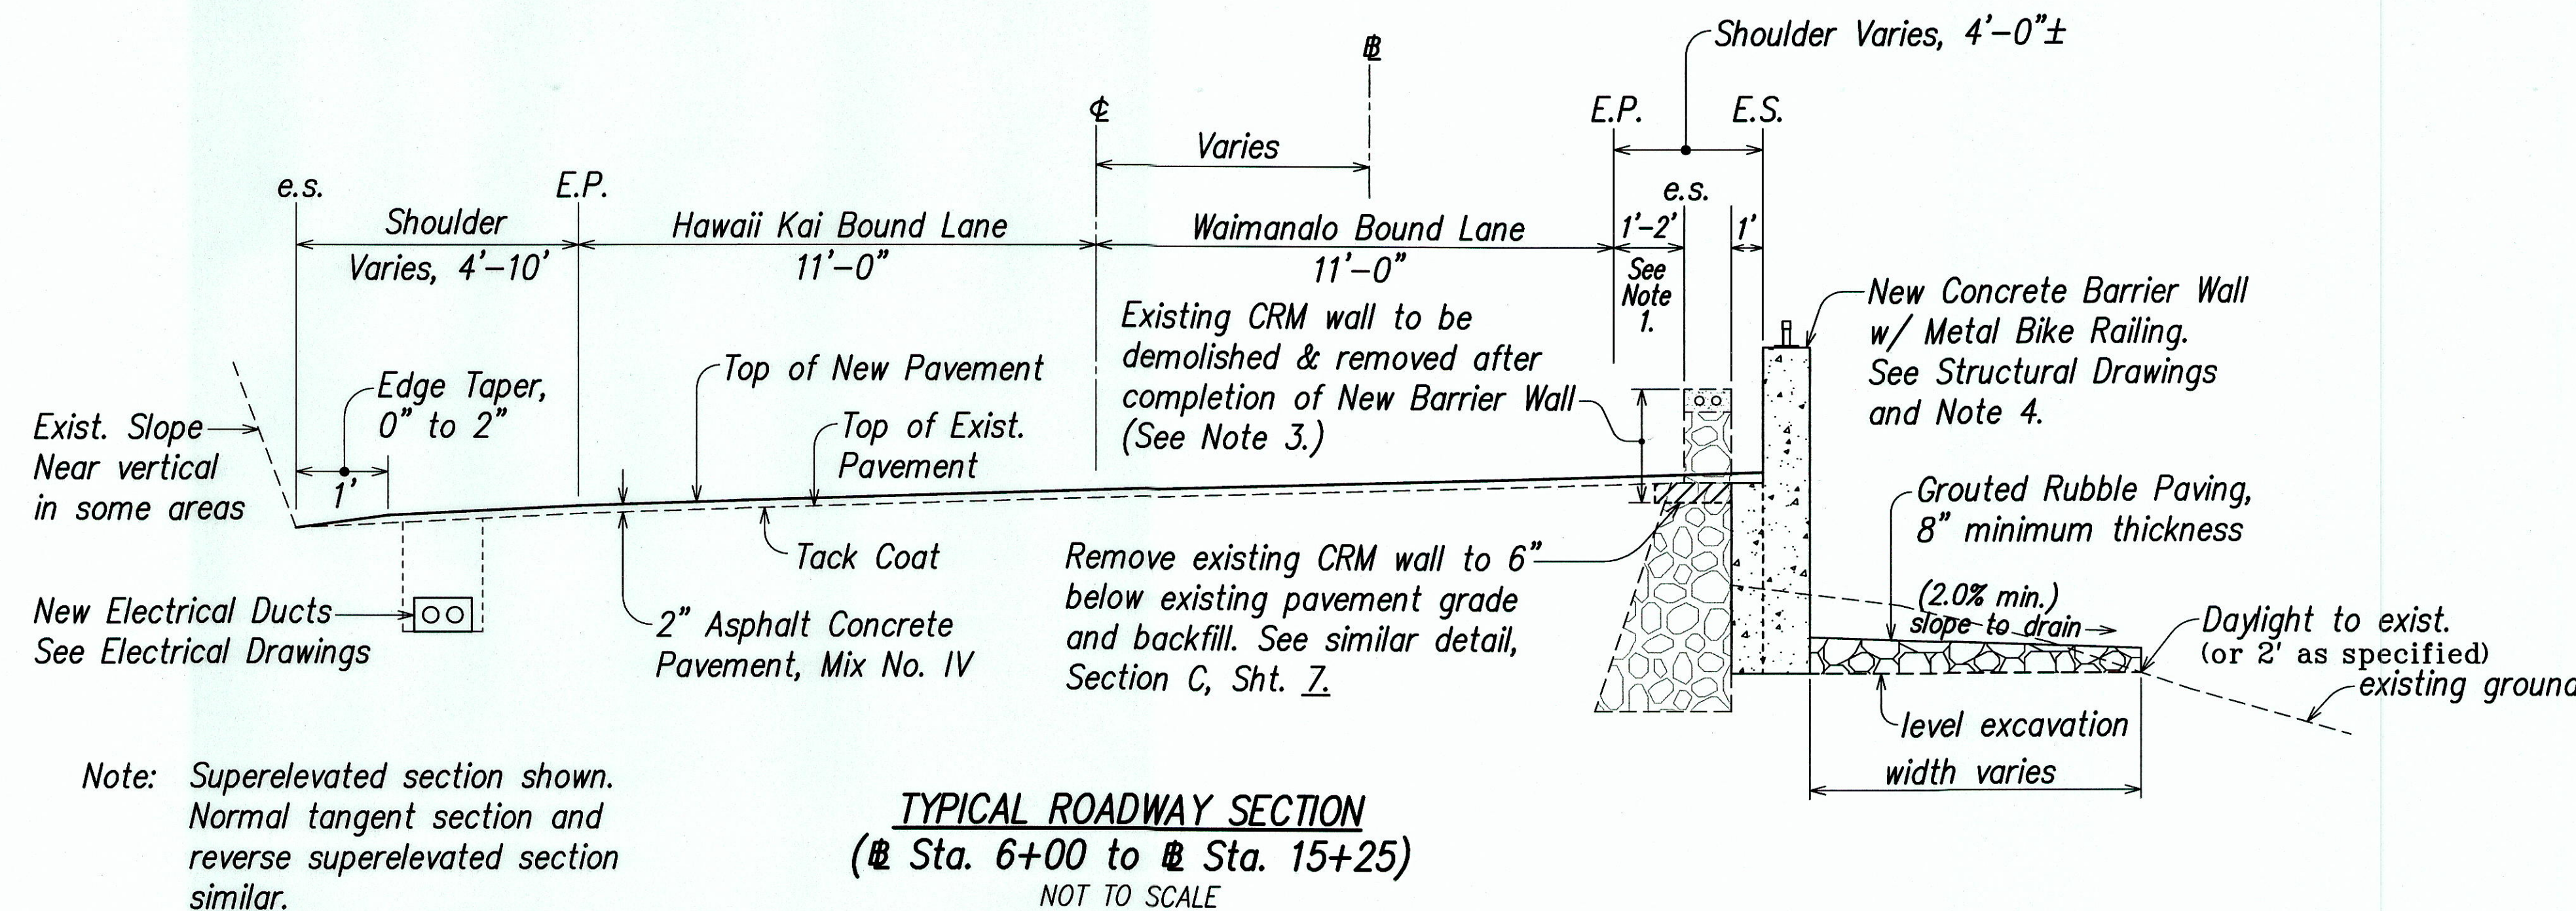

Notes:

- Existing shoulder width varies to 5' wide at Station 15+25.
- In slope reconstruction areas, remove existing guardrail prior to excavating. Contractor shall barricade the excavation until it is backfilled. Install new guardrail as soon as practicable.
- Caution:** The existing CRM barrier wall contains transite ducts (an asbestos containing material). See Special Provisions Section 202.03(E) - Removal of Hazardous Materials, for special handling requirements.
- When installing the ground anchors through the existing CRM wall, any excessive damage to the existing CRM wall, as determined by the Engineer, will be repaired prior to completing stressing block, to the satisfaction of the Engineer, at no additional cost to the State.

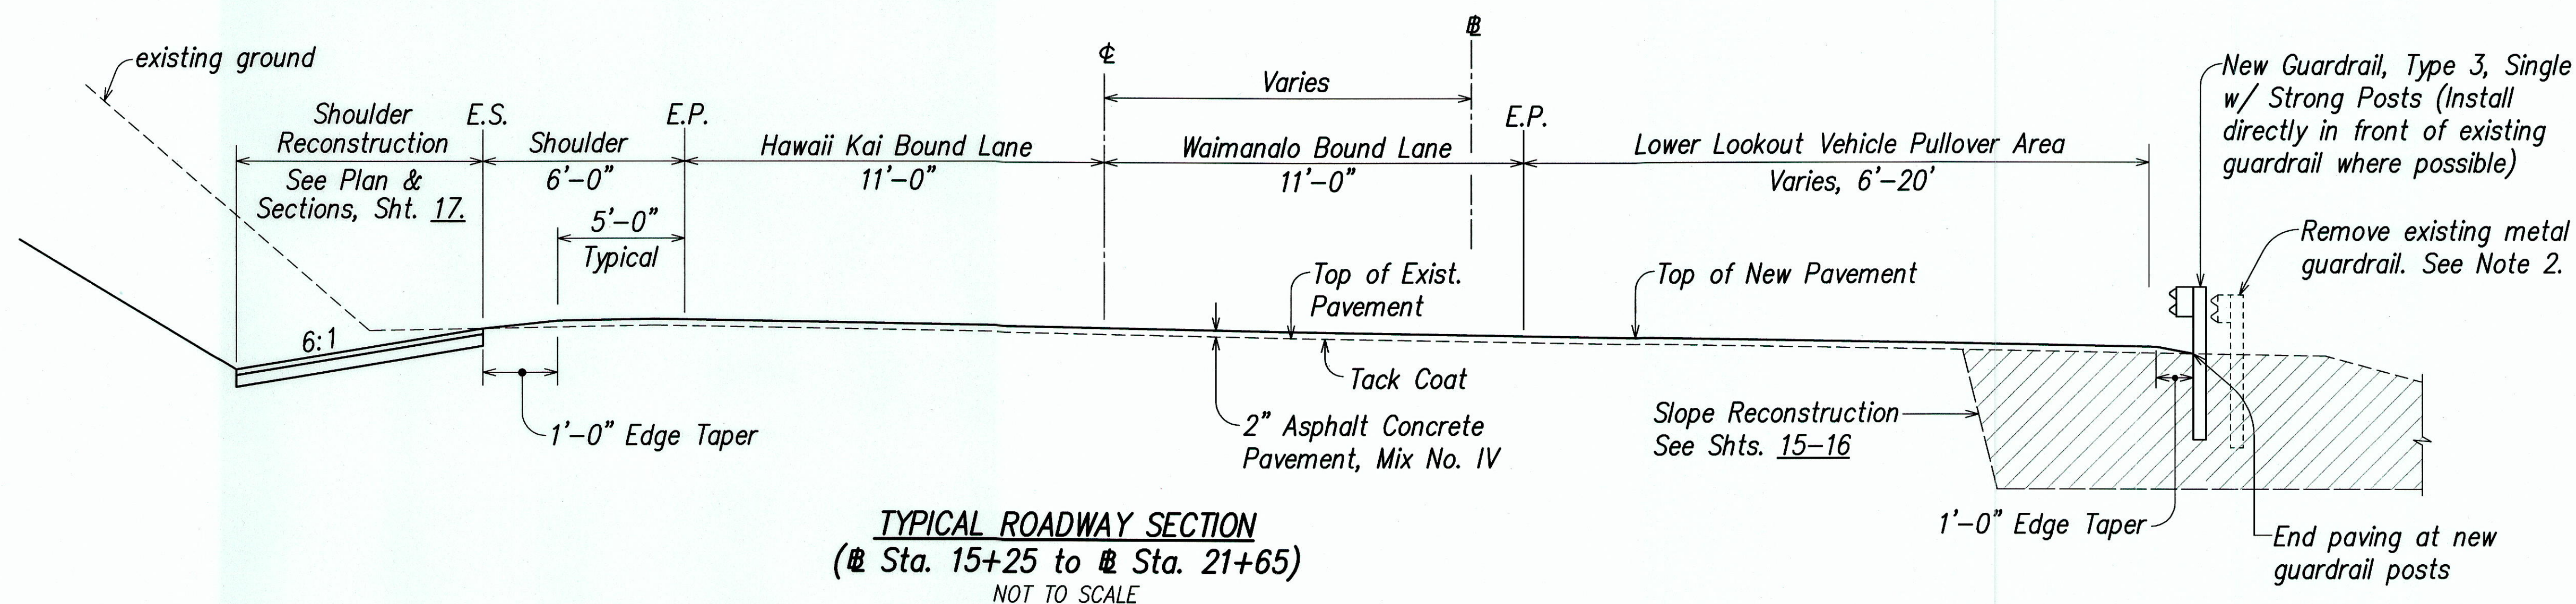


LEGEND FOR AS-BUILT POSTINGS	
	Squiggly line for as-built deletion
	Double line for as-built deletion
Roadway	Text for as-built posting



THIS WORK WAS PREPARED BY ME OR UNDER MY SUPERVISION

ParEn, Inc.
dba PARK ENGINEERING
LICENSE EXPIRES 4-30-14

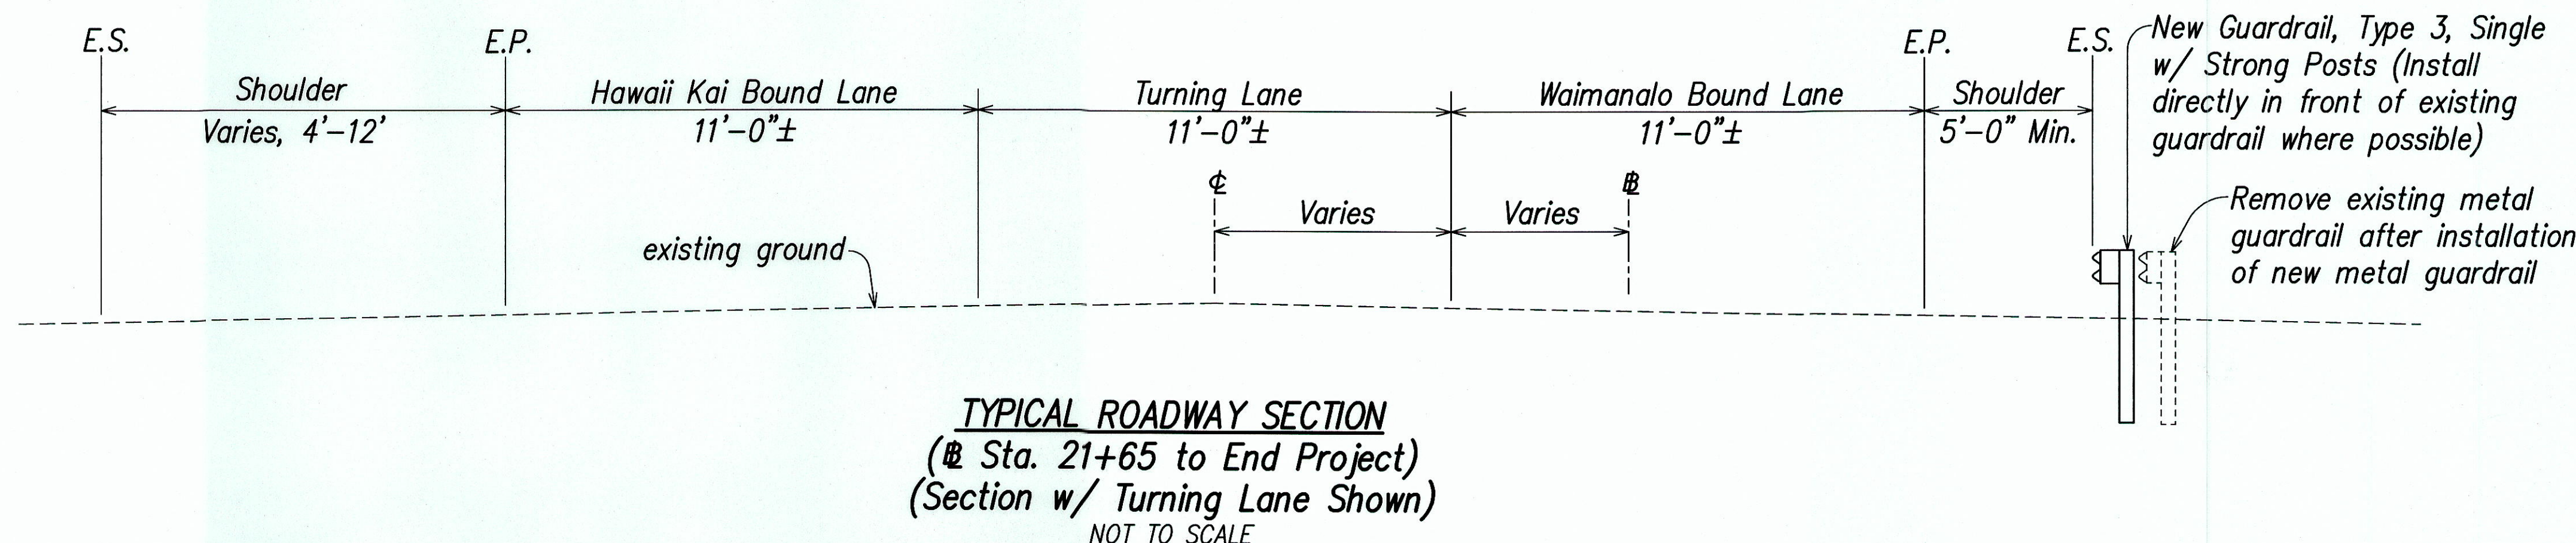

STATE OF HAWAII DEPARTMENT OF TRANSPORTATION HIGHWAYS DIVISION	
TYPICAL SECTIONS	
Kalaniana'ole Highway Improvements Retaining Wall at Makapuu, Oahu Federal-Aid Project No. NH-072-1(51)	
Scale: As Noted	Date: APR. 2007
SHEET No. 1 OF 1 SHEETS	

"AS-BUILT"