


FED. ROAD DIST. NO.	STATE	FED. AID PROJ. NO.	FISCAL YEAR	SHEET NO.	TOTAL SHEETS
HAWAII	HAW.	NH-072-(K53)	2015	108	117

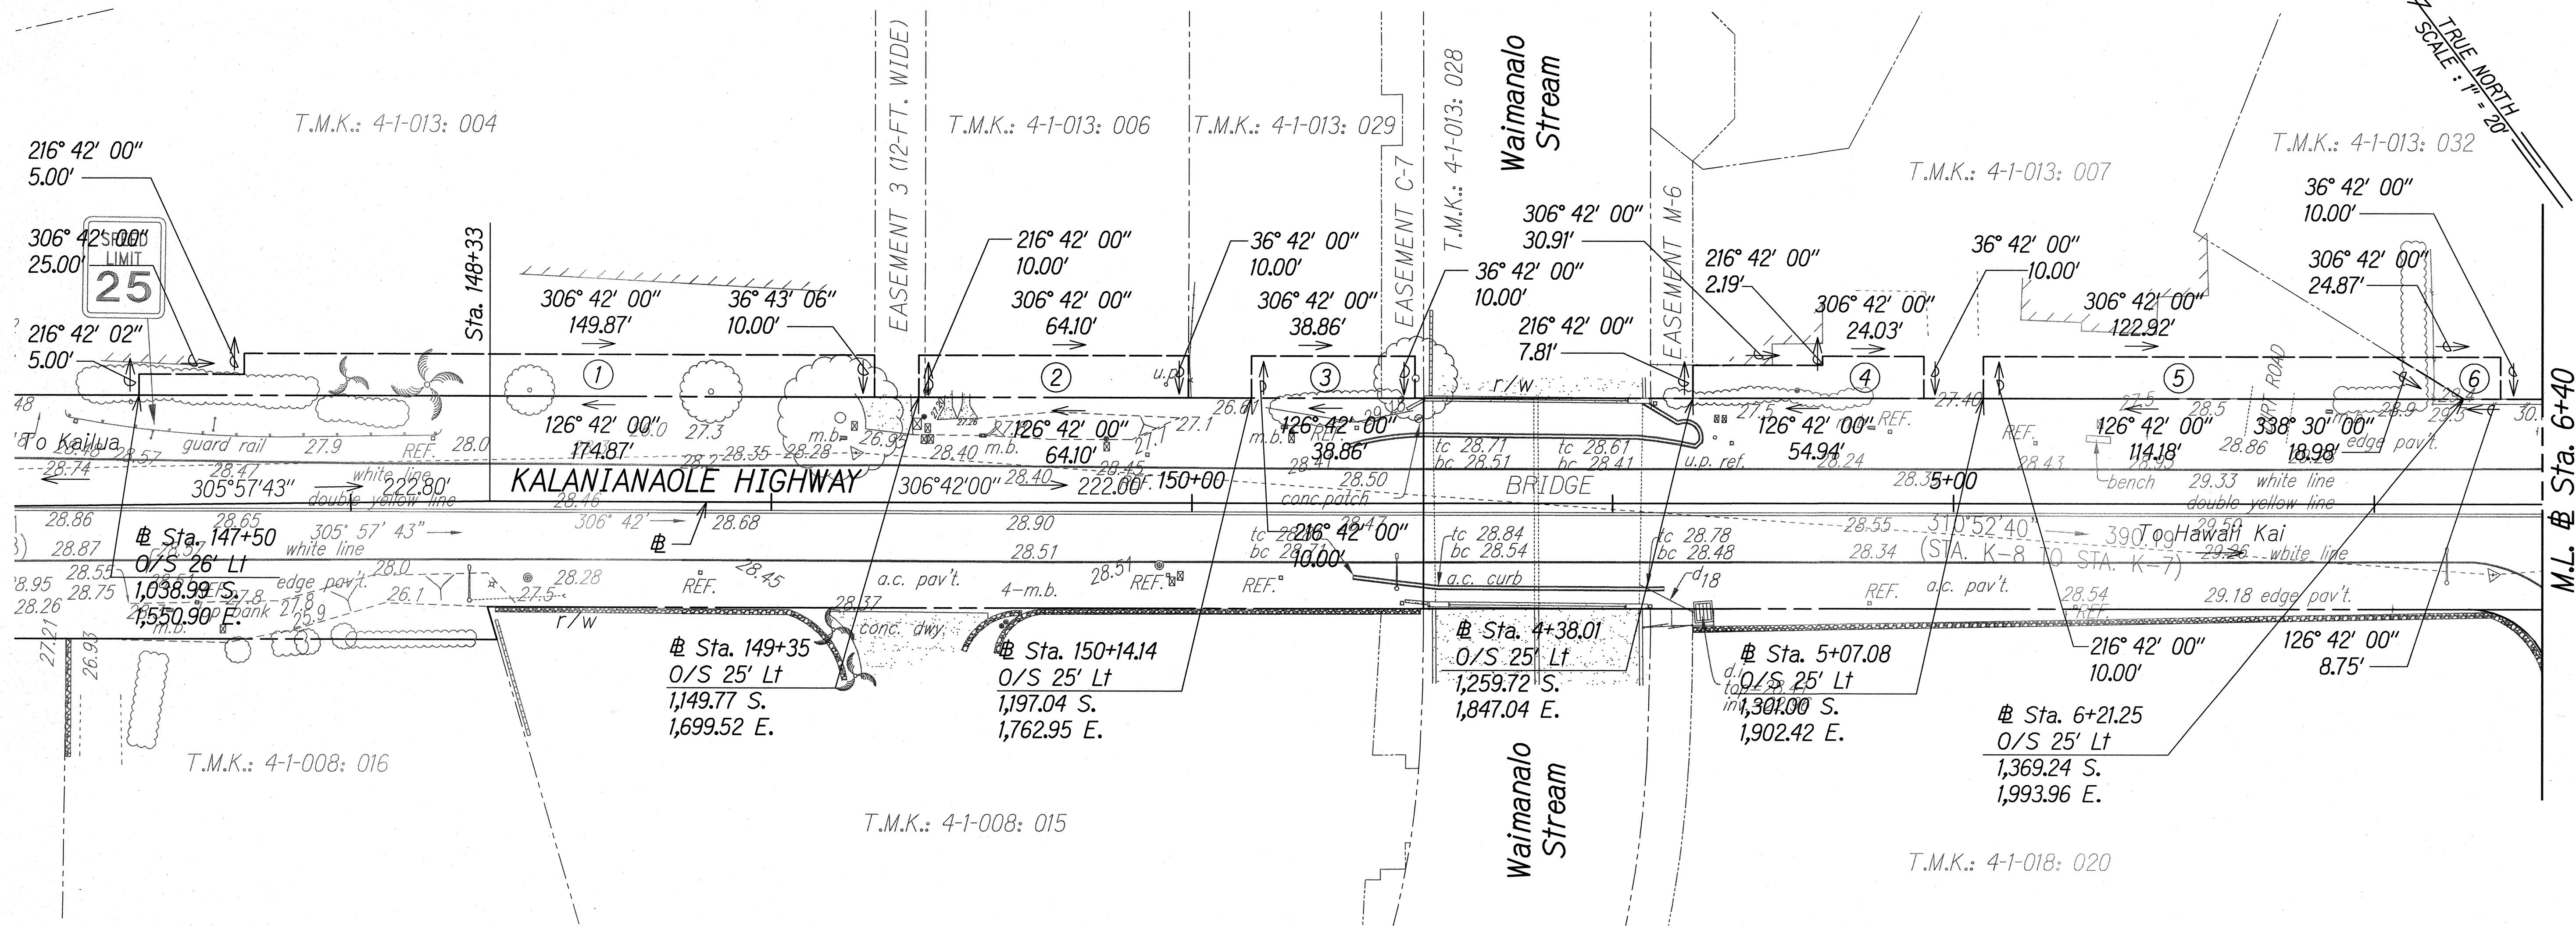



CONSTRUCTION PARCELS PLAN
SCALE: 1" = 20'

NOTE:
The Contractor will coordinate removal of materials with the homeowners and will restore area to original or better condition.

PROPERTY KEY

- | | | |
|---|--|--|
| ① Construction Parcel
T.M.K.: 4-1-013: 004
Chiyoko Kamei Trust - owner
Area: 0.037 Acre: (1,624 Sq. Ft.) | ③ Construction Parcel
T.M.K.: 4-1-013: 006
Sato Family - owner
Area: 0.015 Acre: (641 Sq. Ft.) | ⑤ Construction Parcel
T.M.K.: 4-1-013: 007
William Rivera & Lynnette Rivera - owner
Area: 0.024 Acre: (1,061 Sq. Ft.) |
| ③ Construction Parcel
T.M.K.: 4-1-013: 029
Robert M. Gibo - owner
Area: 0.009 Acre: (389 Sq. Ft.) | ③ Construction Parcel
T.M.K.: 4-1-013: 007
William Rivera & Lynnette Rivera - owner
Area: 0.011 Acre: (482 Sq. Ft.) | ⑥ Construction Parcel
T.M.K.: 4-1-013: 032
State of Hawaii - owner
Area: 0.004 Acre: (168 Sq. Ft.) |

GRAPHICAL SCALE:

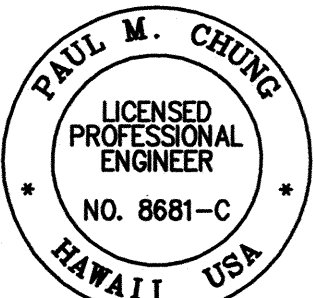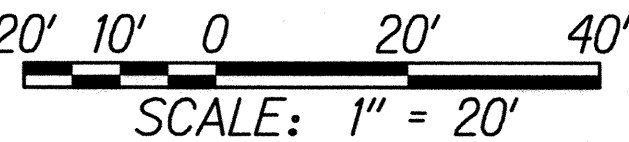

THIS WORK WAS PREPARED BY ME OR UNDER MY SUPERVISION

SIGNATURE

04/30/16
EXPIRATION DATE OF THE LICENSE

STATE OF HAWAII
DEPARTMENT OF TRANSPORTATION
HIGHWAYS DIVISION


CONSTRUCTION PARCELS PLAN

KALANIANA'OLE HIGHWAY IMPROVEMENTS, PHASE 1
Olomana Golf Course To Vicinity of Poalima St.
Federal Aid Project No. NH-072-(K53)

Scale: AS NOTED Date: Feb., 2015

SHEET No. C69 OF 71 SHEETS



FED. ROAD DIST. NO.	STATE	FED. AID PROJ. NO.	FISCAL YEAR	SHEET NO.	TOTAL SHEETS
HAWAII	HAW.	NH-072-1(53)	2015	109	117

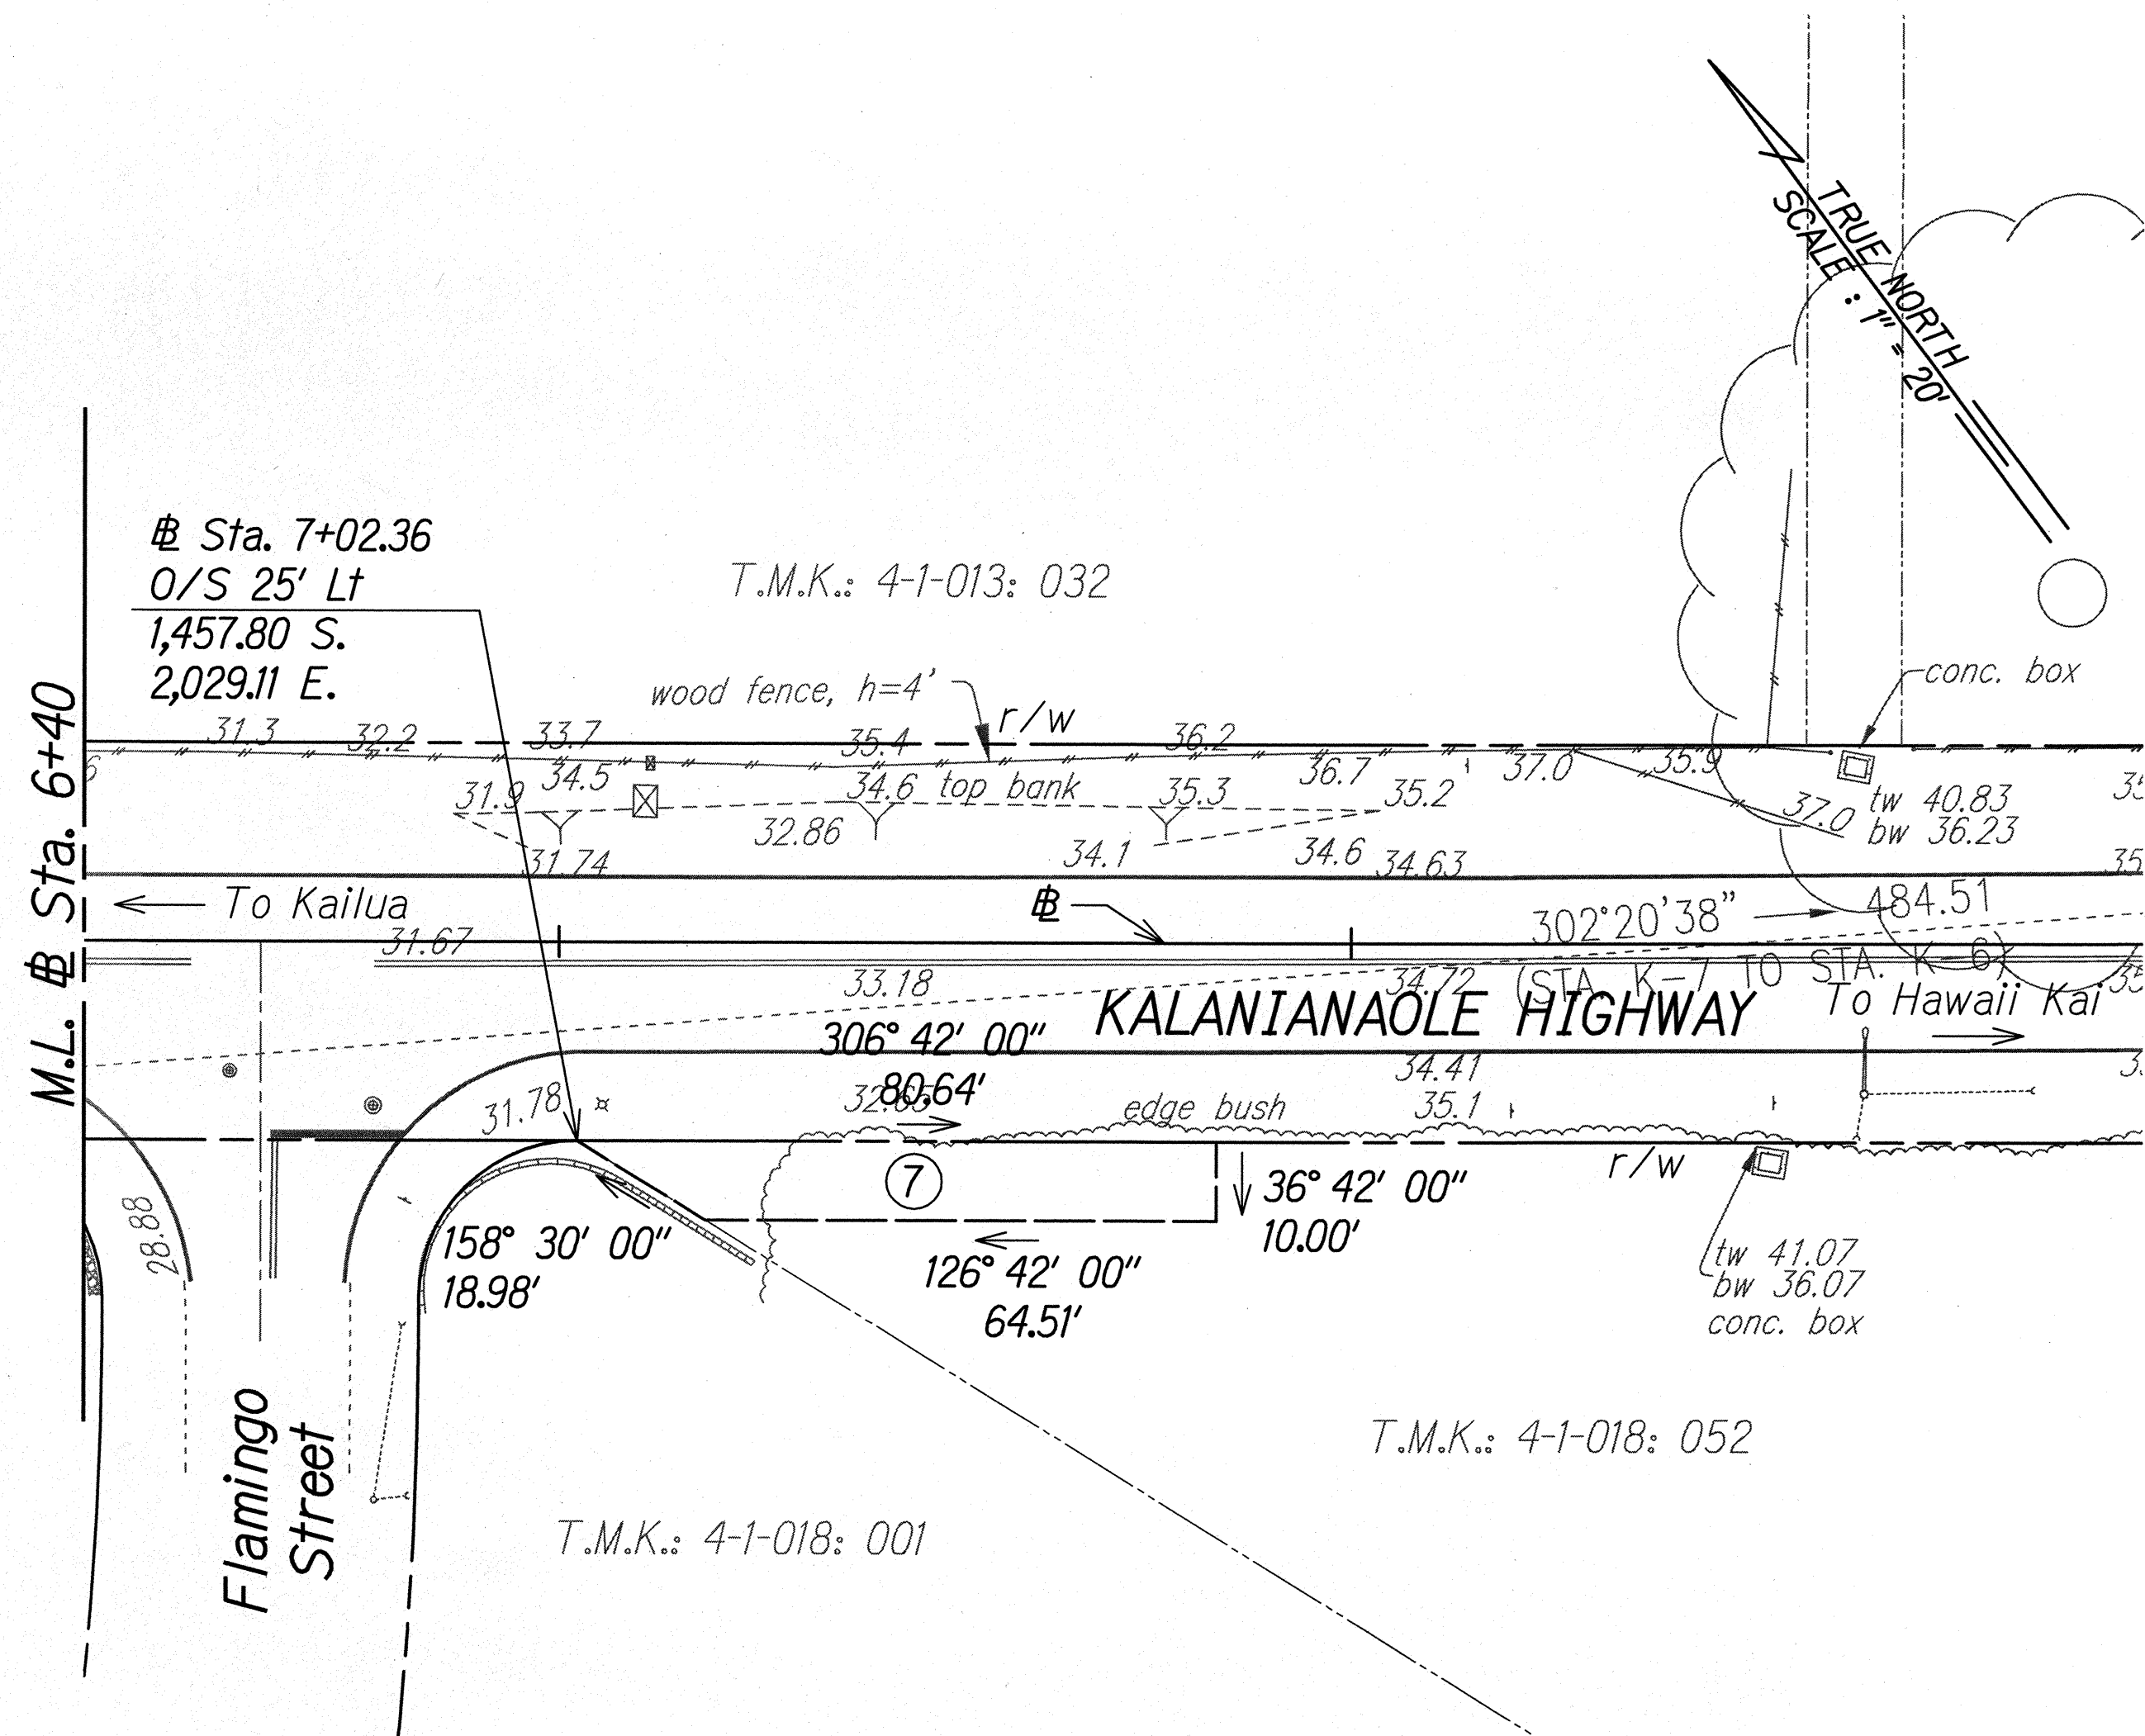

CONSTRUCTION PARCELS PLAN
SCALE: 1" = 20'

NOTE:
The Contractor will coordinate removal of materials with the homeowners and will restore area to original or better condition.

PROPERTY KEY
⑦ Construction Parcel
T.M.K.: 4-1-018: 052
State of Hawaii - owner
Area: 0.017 Acre: (726 Sq. Ft.)

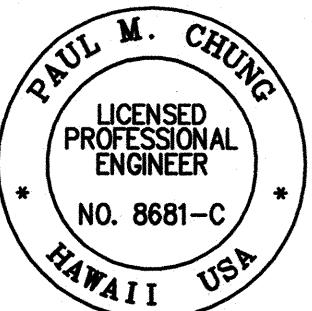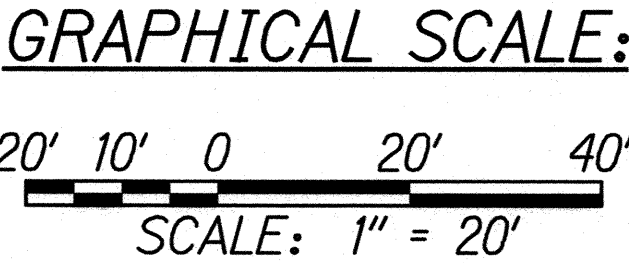

THIS WORK WAS PREPARED BY ME OR
UNDER MY SUPERVISION

SIGNATURE

04/30/16

EXPIRATION DATE
OF THE LICENSE

STATE OF HAWAII
DEPARTMENT OF TRANSPORTATION
HIGHWAYS DIVISION


CONSTRUCTION PARCELS PLAN

KALANIANA'OLE HIGHWAY IMPROVEMENTS, PHASE 1
Olomana Golf Course To Vicinity of Poalima St.
Federal Aid Project No. NH-072-1(53)

Scale: AS NOTED Date: Feb., 2015

SHEET No. C70 OF 71 SHEETS

FED. ROAD DIST. NO.	STATE	FED. AID PROJ. NO.	FISCAL YEAR	SHEET NO.	TOTAL SHEETS
HAWAII	HAW.	NH-072-1(53)	2015	110	117

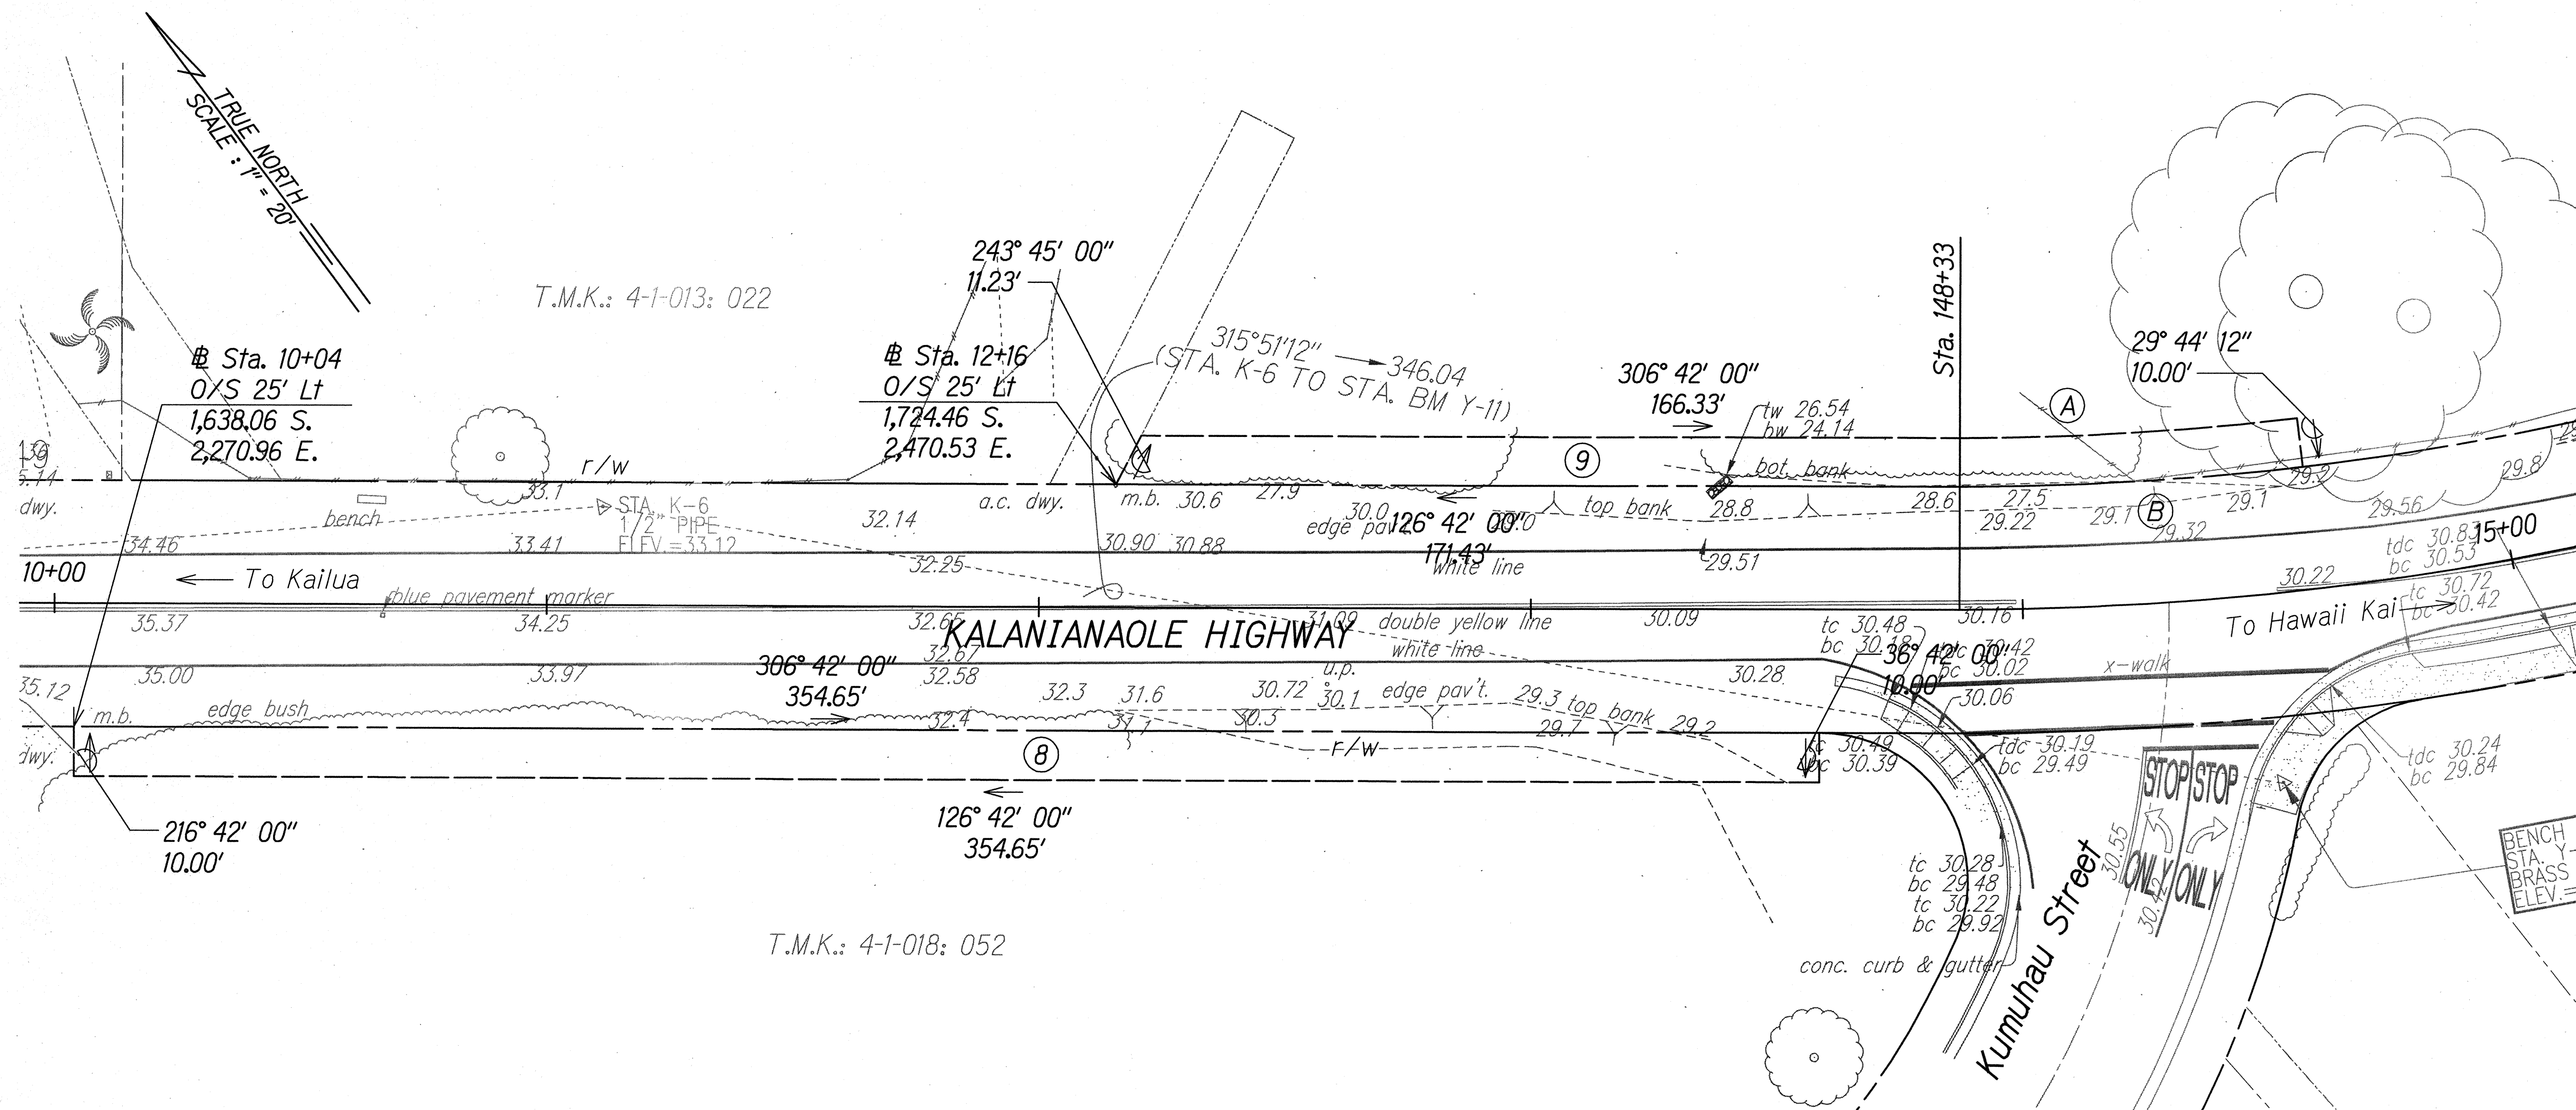

CONSTRUCTION PARCELS PLAN

SCALE: 1" = 20'

NOTE:


The Contractor will coordinate removal of materials with the homeowners and will restore area to original or better condition.

PROPERTY KEY


- ⑧ Construction Parcel
T.M.K.: 4-1-018: 052
State of Hawaii - owner
Area: 0.081 Acre: (3,547 Sq. Ft.)
- ⑨ Construction Parcel
T.M.K.: 4-1-013: 022
State of Hawaii - owner
Area: 0.055 Acre: (2,382 Sq. Ft.)

CURVE	(A)	(B)
Δ	6°57'48"	6°57'48"
$\Delta/2$	3°28'53.8"	3°28'53.8"
R	565.00'	575.00'
Tan.	34.37'	34.98'
C	68.62'	69.84'
Lc	68.67'	69.88'

GRAPHICAL SCALE:

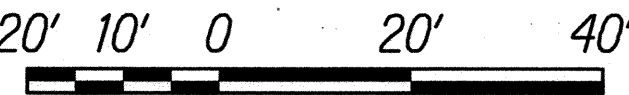

SCALE: 1" = 20'

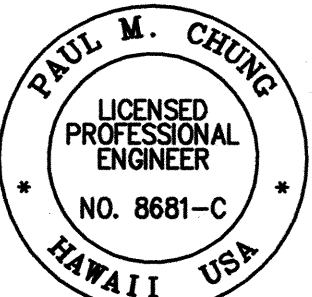

THIS WORK WAS PREPARED BY ME OR UNDER MY SUPERVISION

SIGNATURE: [Signature] EXPIRATION DATE OF THE LICENSE: 04/30/16

STATE OF HAWAII
DEPARTMENT OF TRANSPORTATION
HIGHWAYS DIVISION



CONSTRUCTION PARCELS PLAN

KALANIANA'OLE HIGHWAY IMPROVEMENTS, PHASE 1
Olomana Golf Course To Vicinity of Poalima St.
Federal Aid Project No. NH-072-1(53)

Scale: AS NOTED Date: Feb., 2015

SHEET No. C71 OF 71 SHEETS

CURVE	(A)	(B)
Δ	20°00'00"	22°32'29"
$\Delta/2$	10°00'00.0"	11°16'14.7"
R	453.00'	303.00'
$Tan.$	79.88'	60.38'
C	157.33'	118.44'
Lc	158.13'	119.21'

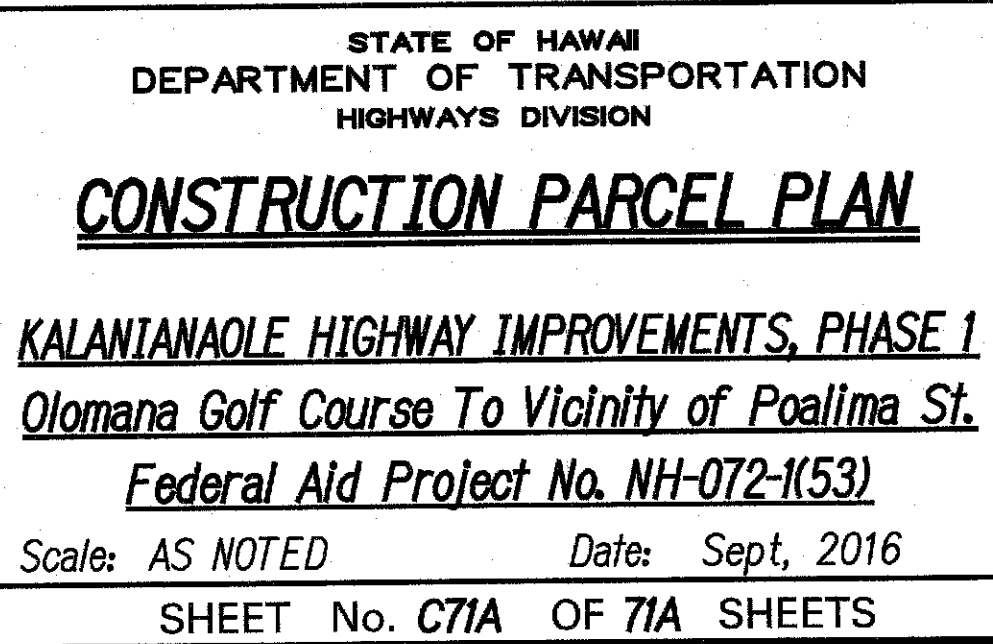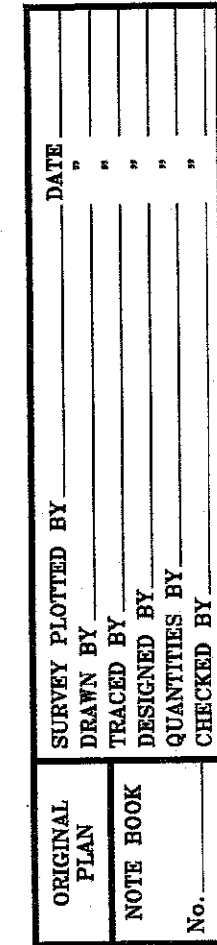

"AS-BUILT"

C.O. 110S-1