
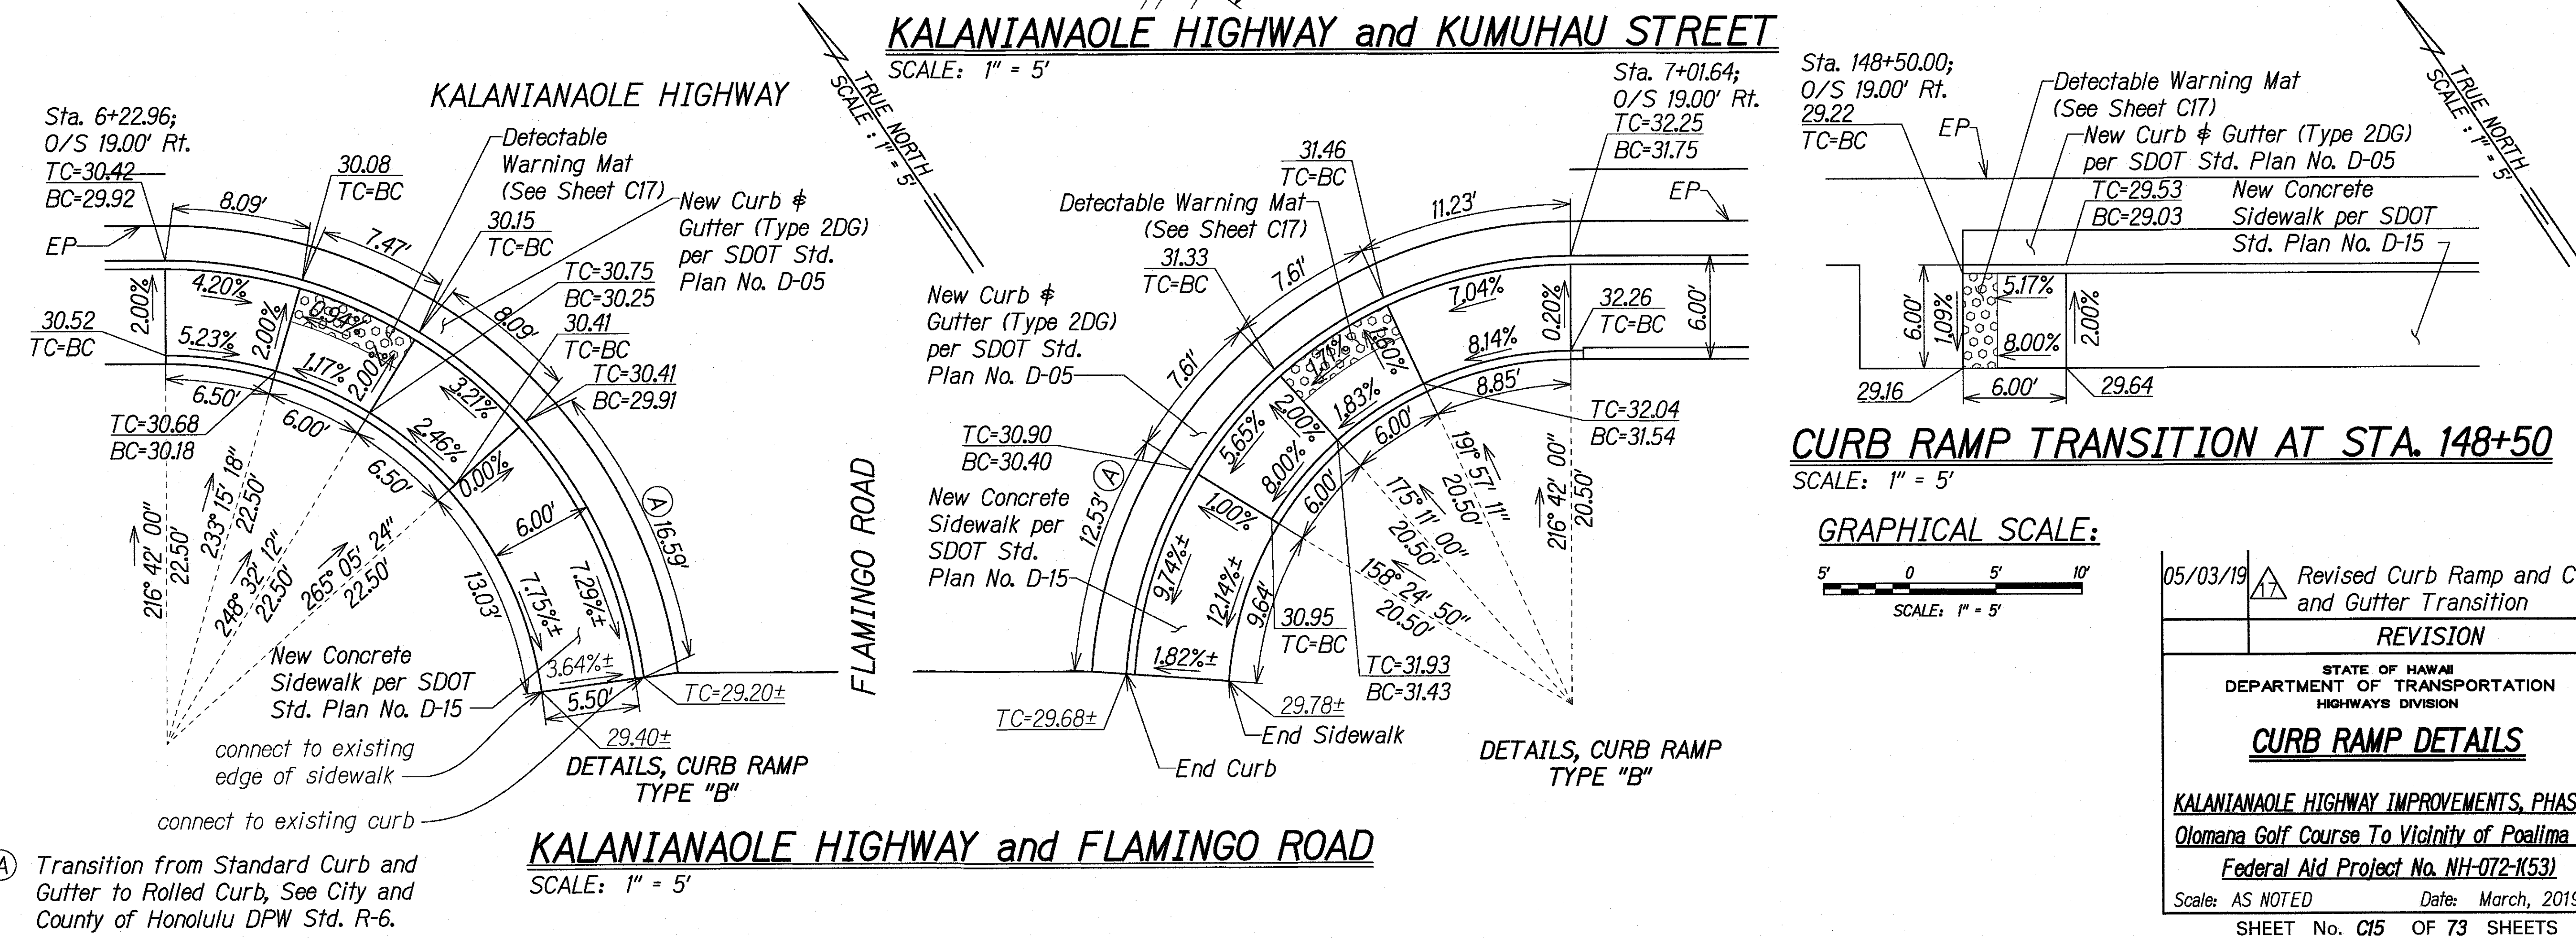


FED. ROAD DIST. NO.	STATE	FED. AID PROJ. NO.	FISCAL YEAR	SHEET NO.	TOTAL SHEETS
HAWAII	HAW.	NH-072-1(53)	2015	15	117

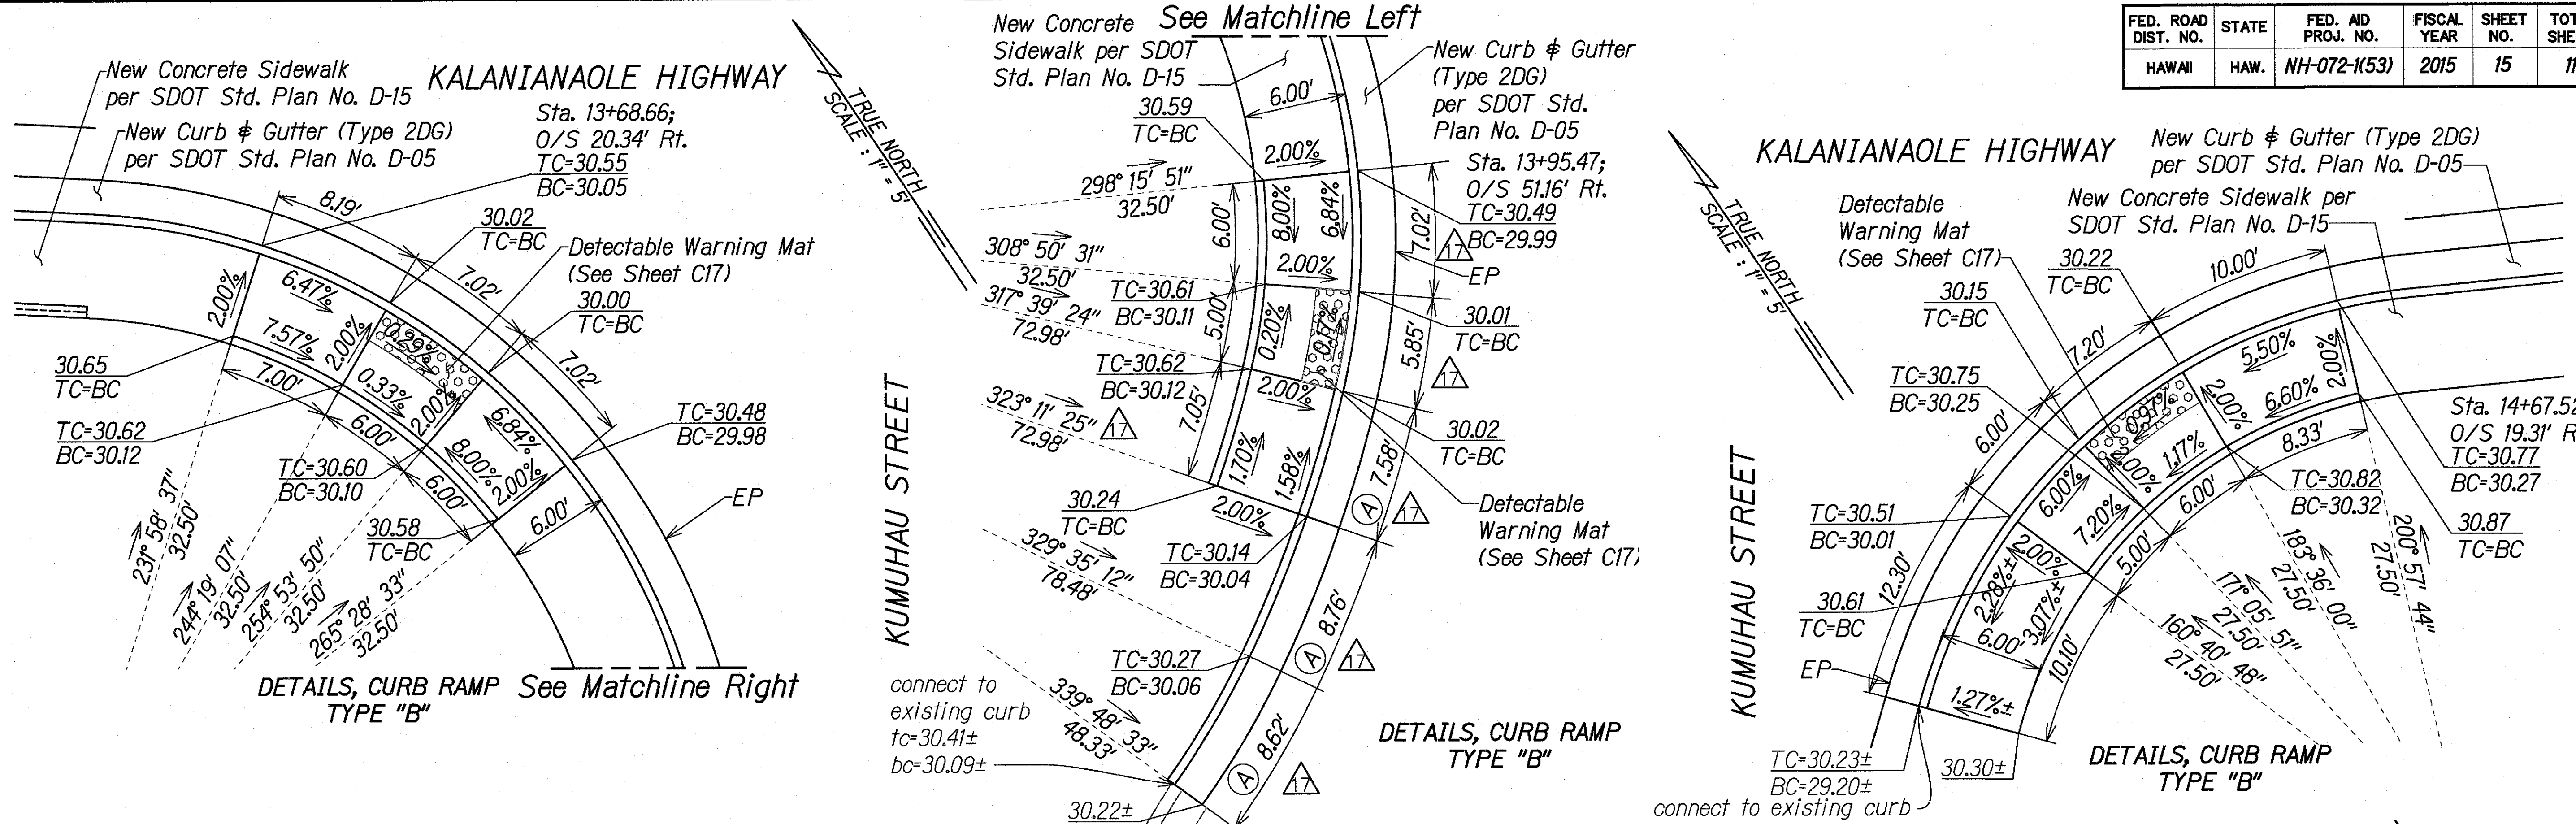

"AS-BUILT"

FED. ROAD DIST. NO.	STATE	FED. AID PROJ. NO.	FISCAL YEAR	SHEET NO.	TOTAL SHEETS
HAWAII	HAW.	NH-072-1(53)	2015	C.O. 16	117

CURVE DATA:

CURVE	①	②
Δ	90°00'00"	89°59'54"
Δ/2	45°00'00.0"	44°59'57.0"
R	5.00'	5.00'
Tan.	5.00'	5.00'
C	7.07'	7.07'
Lc	7.85'	7.85'
CURVE	③	④
Δ	90°00'00"	90°00'00"
Δ/2	45°00'00.0"	45°00'00.0"
R	5.00'	5.00'
Tan.	5.00'	5.00'
C	7.07'	7.07'
Lc	7.85'	7.85'

LINE DATA:

LINE	①	②	③	④	⑤
Az	09°06'00"	09°06'06"	09°06'00"	09°06'06"	228°46'17"
Distance	3.00'	3.00'	3.00'	3.00'	5.06'
LINE	⑥	⑦	⑧	⑨	⑩
Az	228°46'17"	155°31'34"	155°31'34"	161°19'59"	161°22'34"
Distance	5.06'	5.02'	5.02'	4.32'	4.32'

05/24/19	Updated Mekia Curb Ramp
01/08/19	Concrete Sidewalk with Curb and Gutter and ADA Curb Ramp Added
03/02/18	Updated Line Data
08/23/17	Curb ramp shifted to accomodate HECO Pole
08/25/16	Revised Curb Ramp
DATE	REVISION

STATE OF HAWAII
DEPARTMENT OF TRANSPORTATION
HIGHWAYS DIVISION

CURB RAMP DETAILS


KALANIANA'OLE HIGHWAY IMPROVEMENTS, PHASE 1
Olomana Golf Course To Vicinity of Poalima St.
Federal Aid Project No. NH-072-1(53)

Scale: AS NOTED Date: March, 2019

SHEET No. C16 OF 73 SHEETS


"AS-BUILT"

C.O. 16

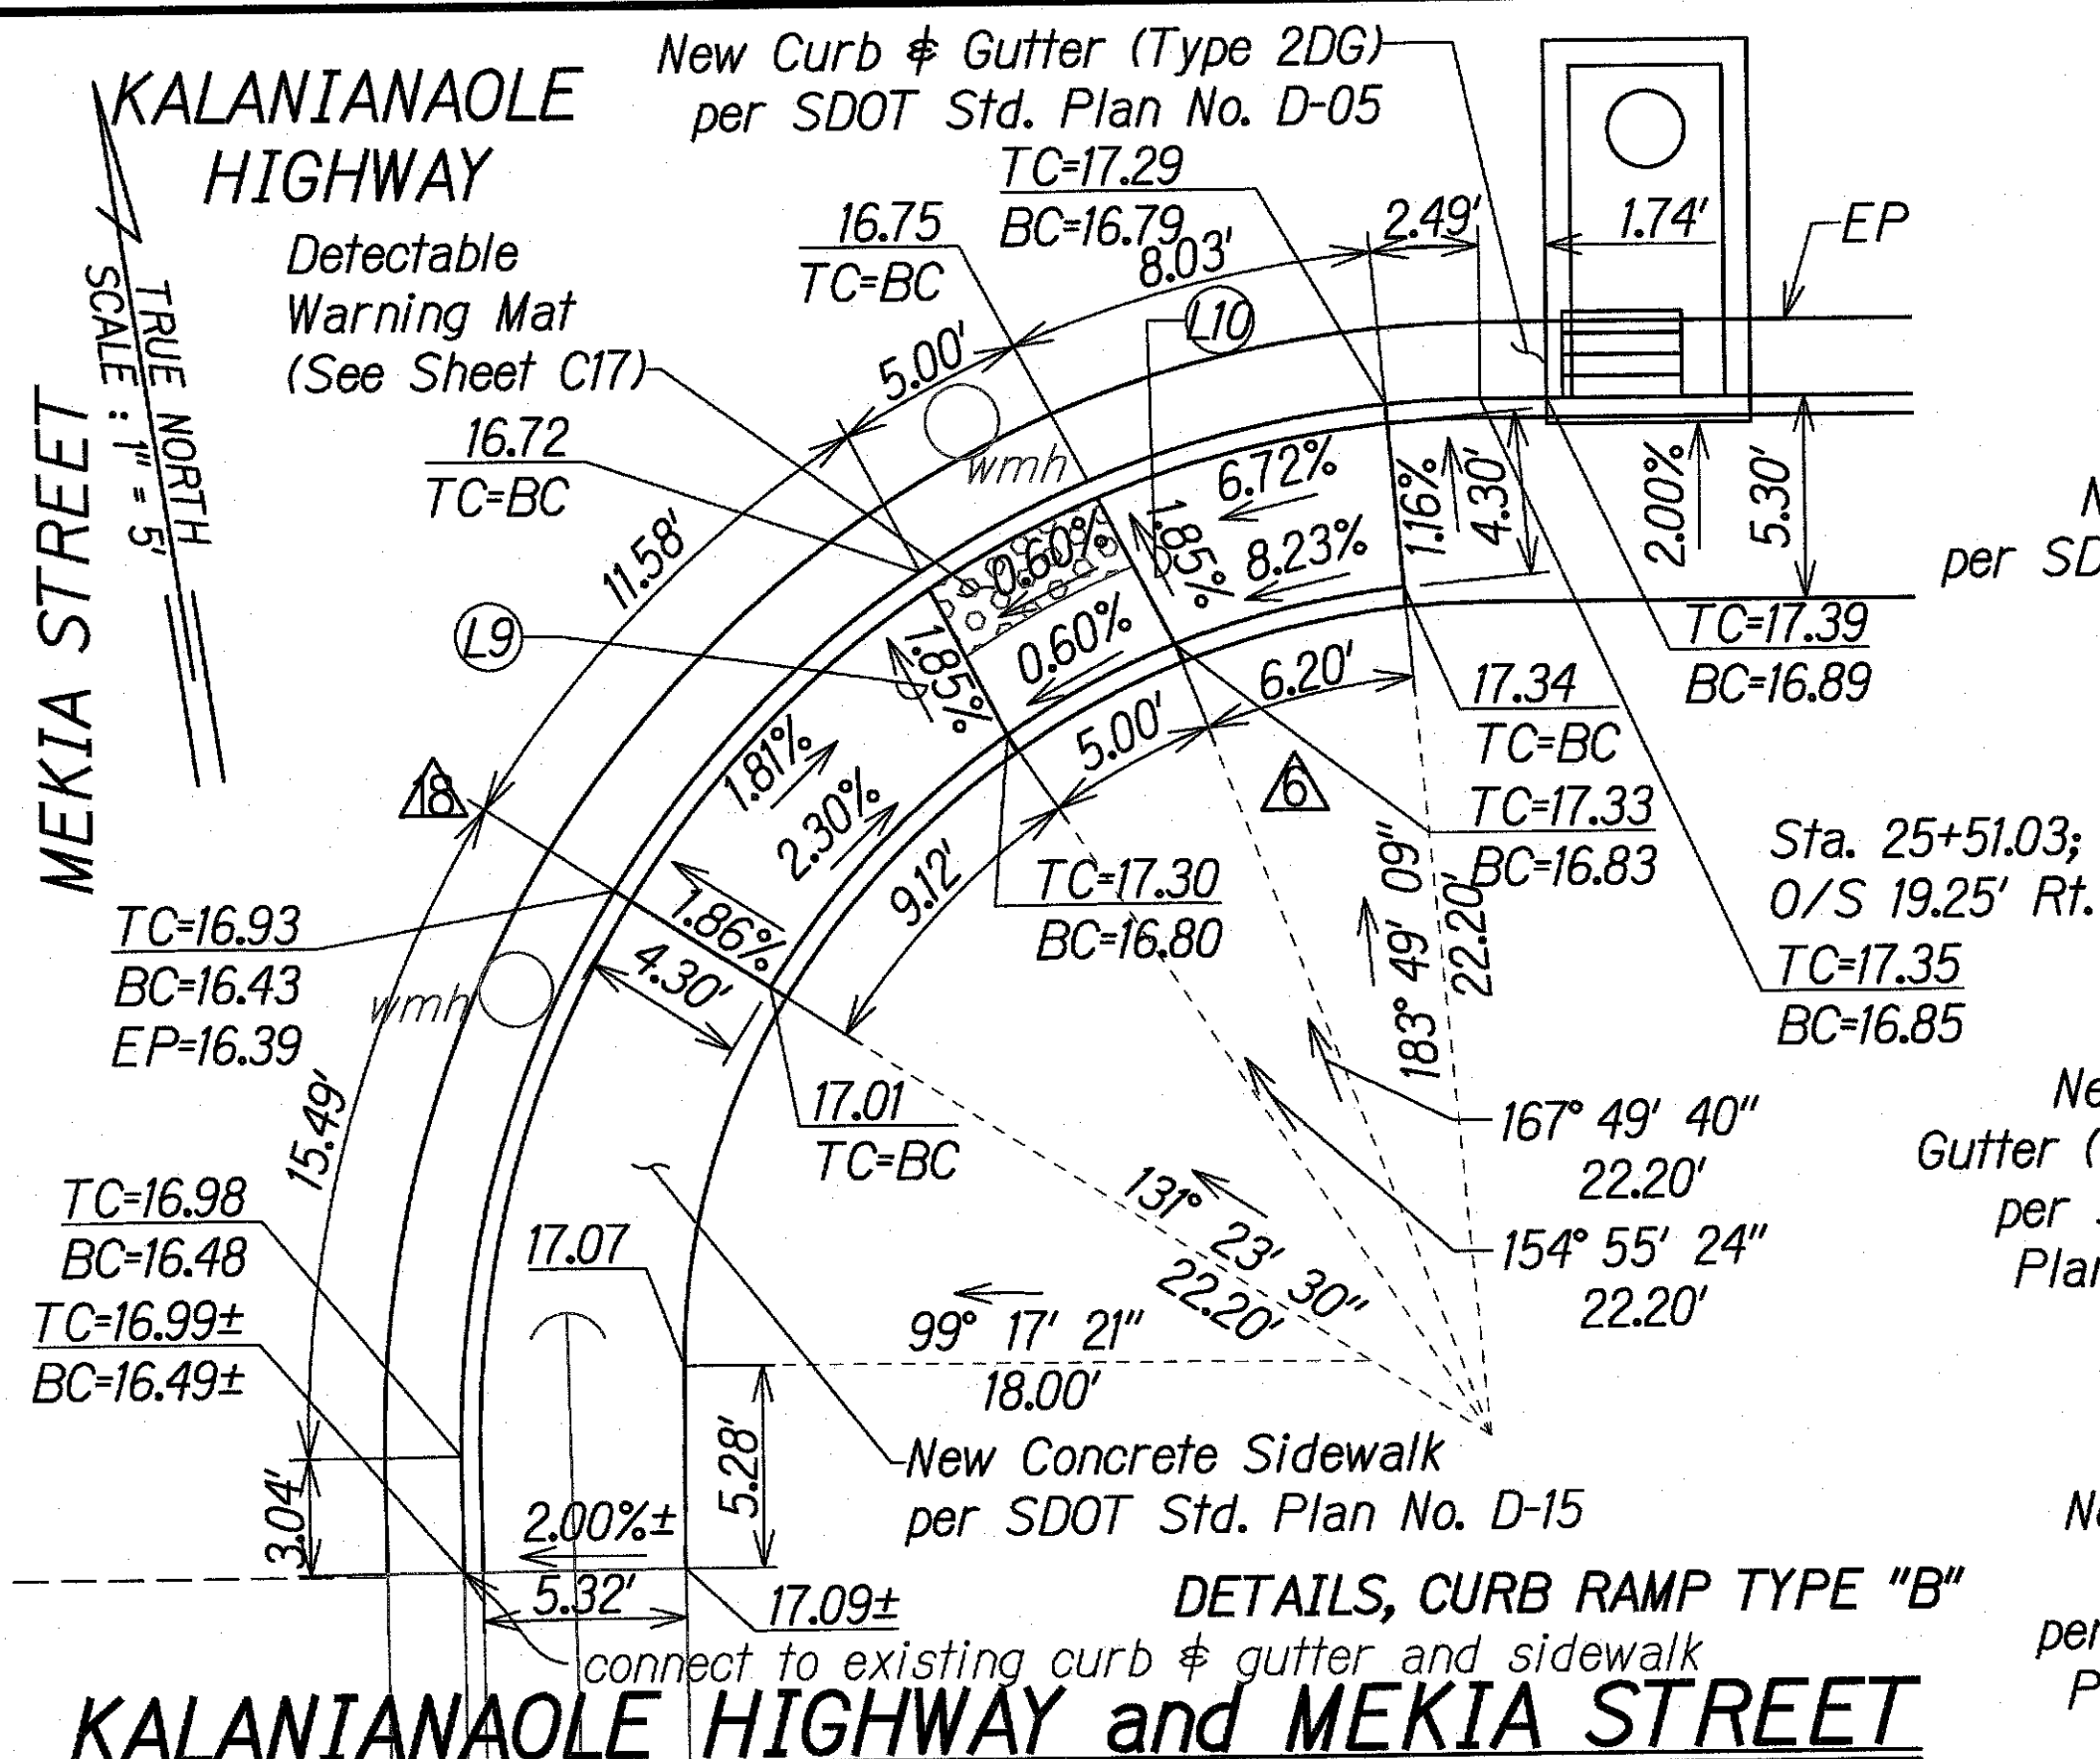


KALANIANA'OLE HIGHWAY and MEKIA STREET

SCALE: 1" = 5'

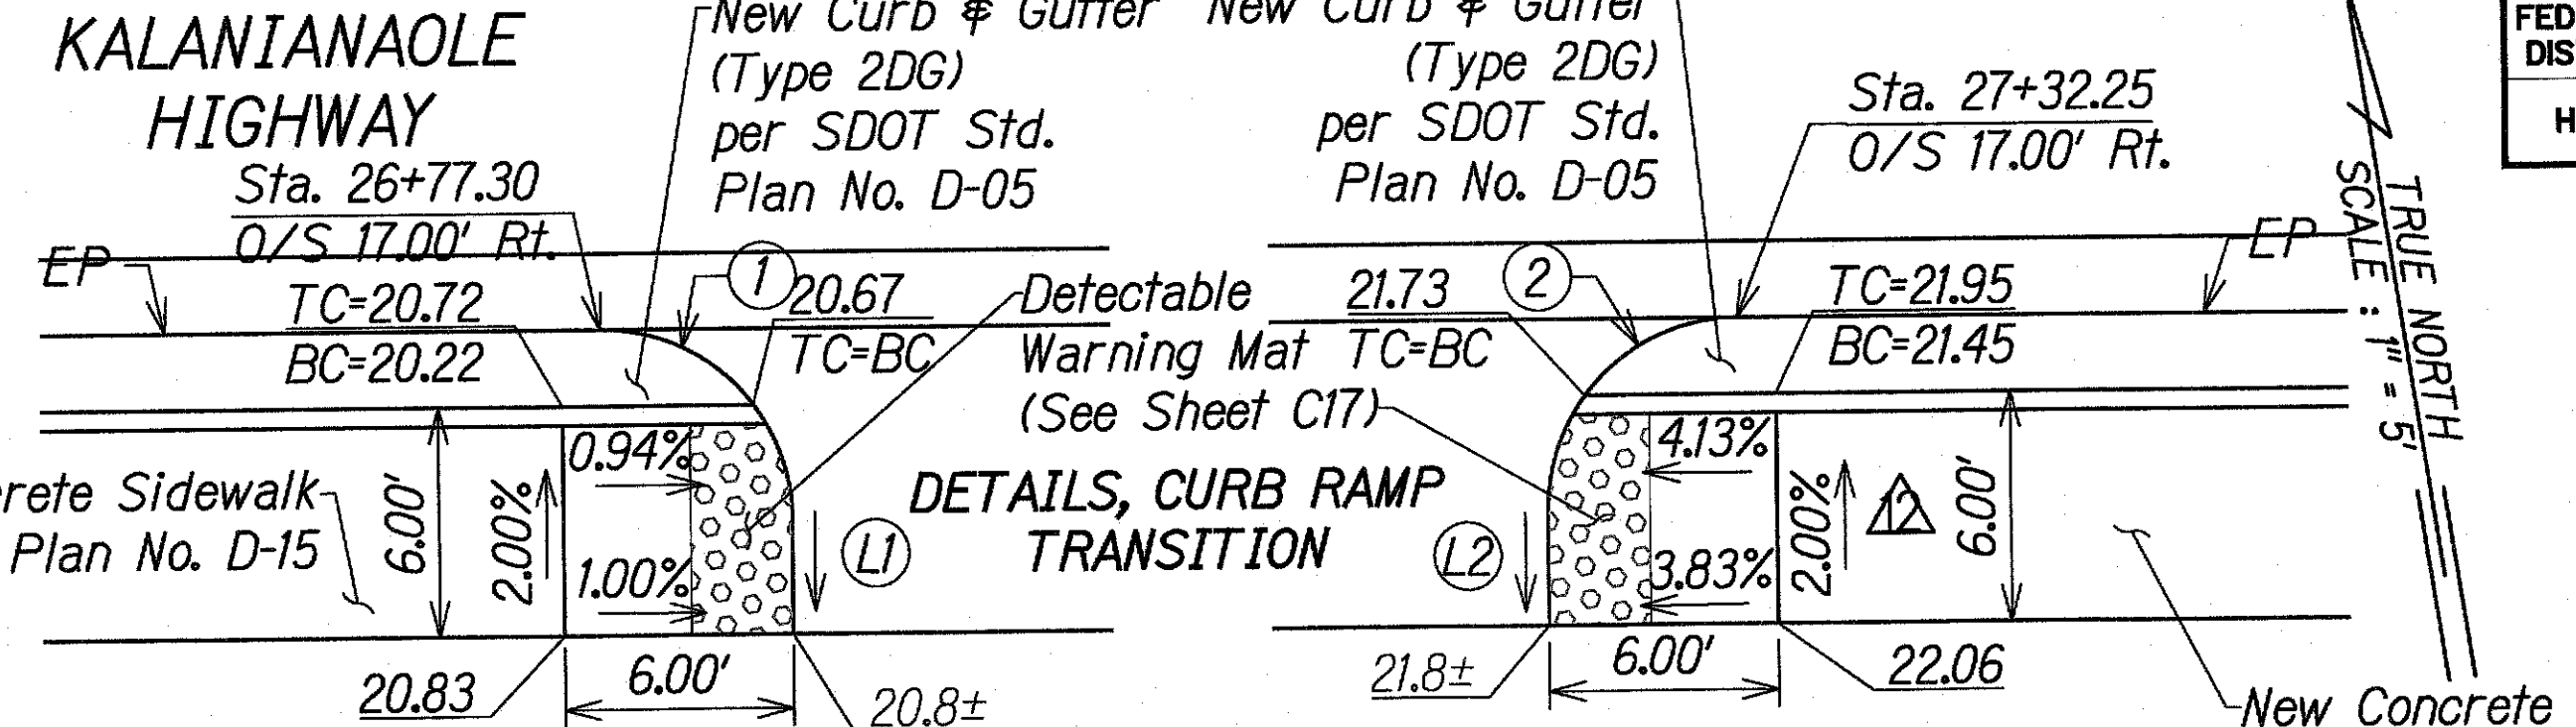


KALANIANA'OLE HIGHWAY ACCESS AT Sta 27+06± Rt.

SCALE: 1" = 5'

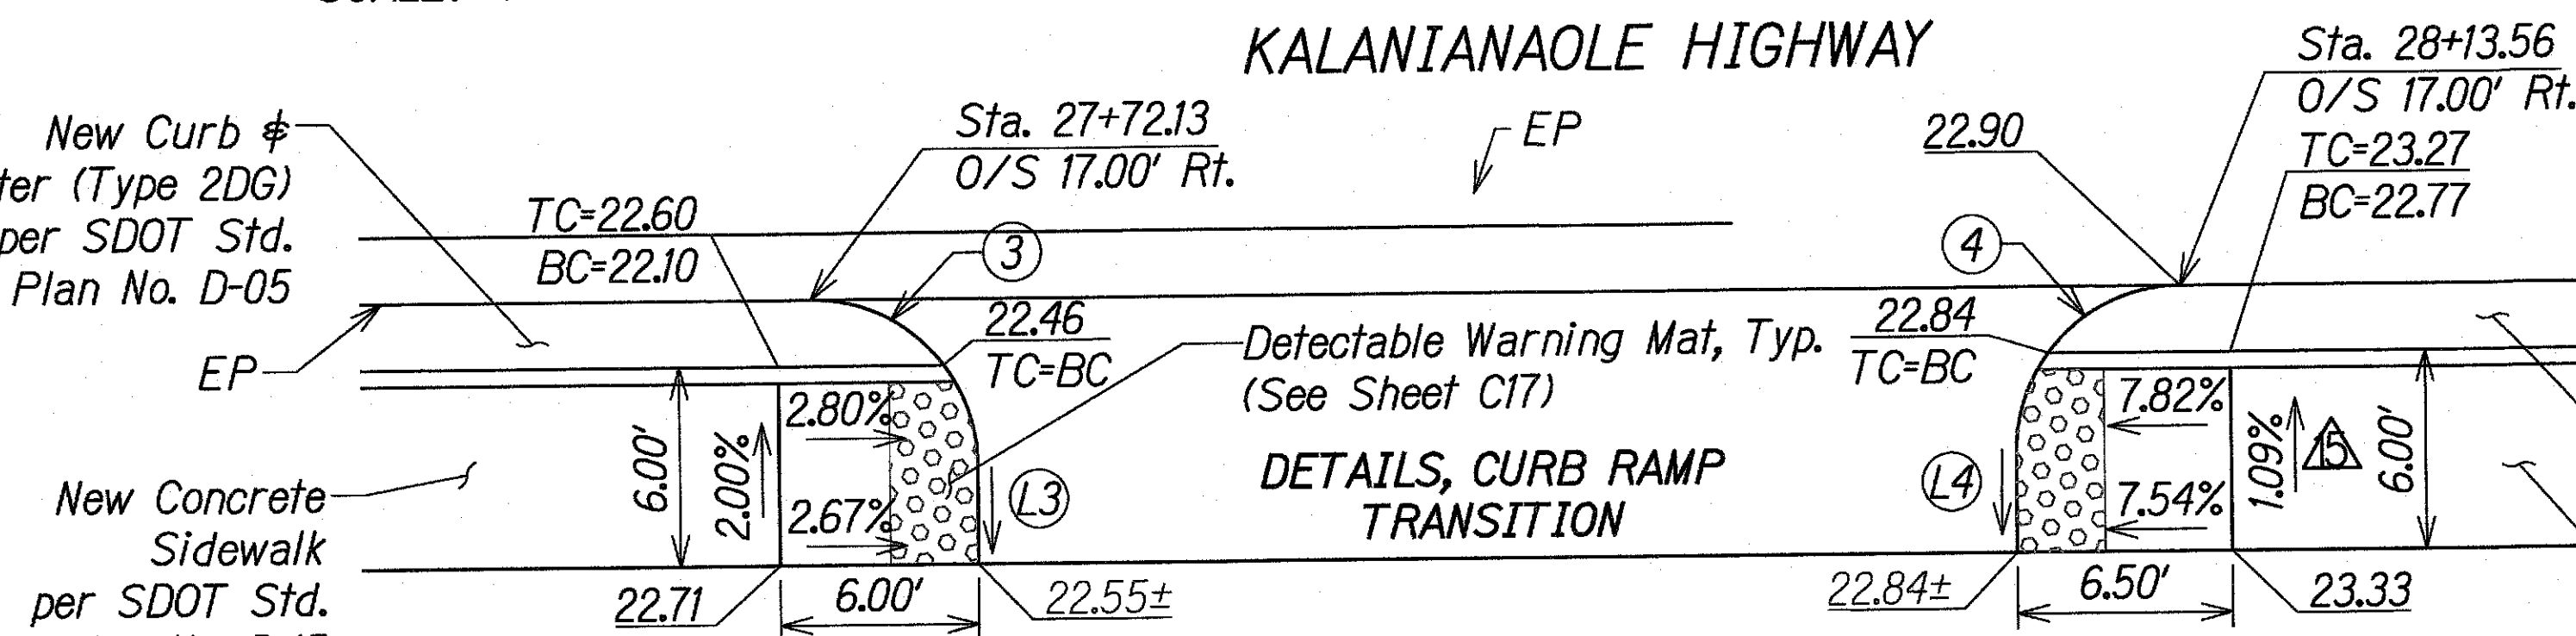

KALANIANA'OLE HIGHWAY ACCESS AT Sta 27+93± Rt.


SCALE: 1" = 5'

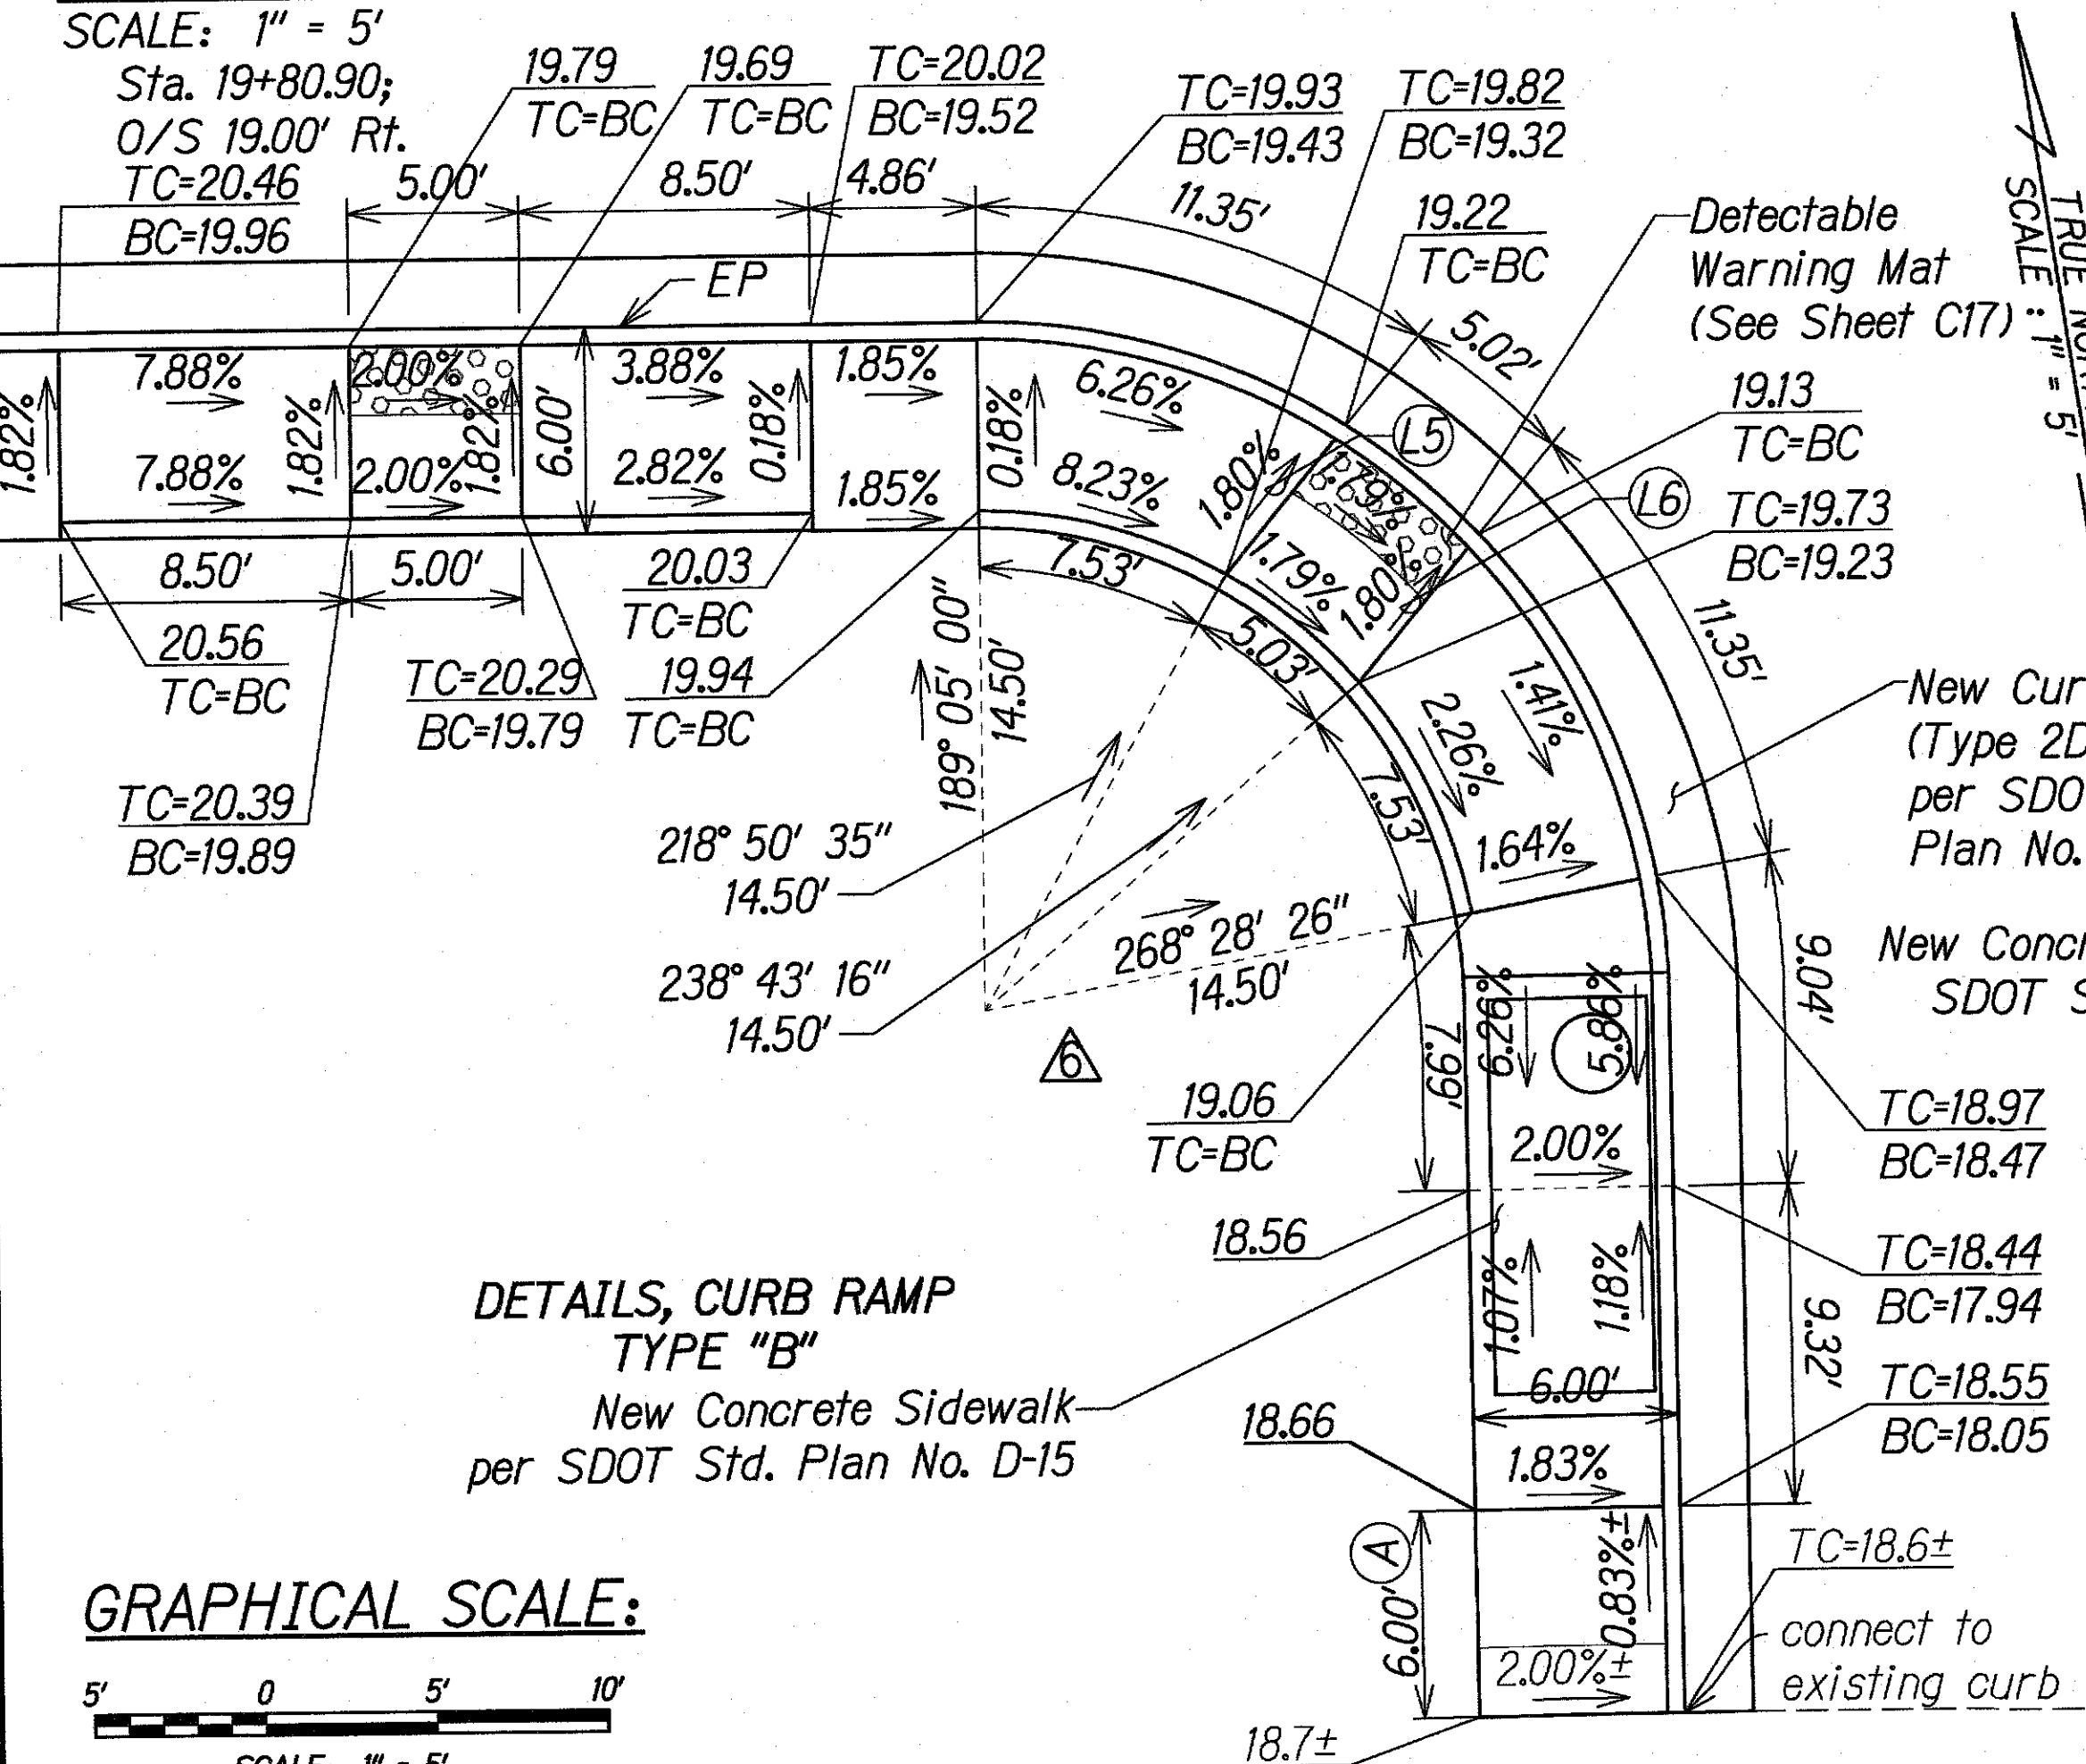

KALANIANA'OLE HIGHWAY and HUMUNIKI STREET

SCALE: 1" = 5'

GRAPHICAL SCALE:

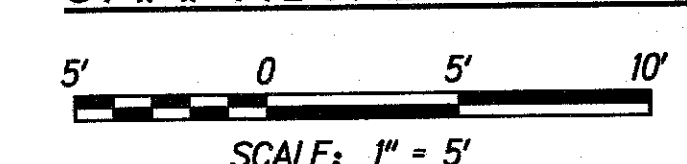

DATE	
DESIGNED BY	
DRAWN BY	
CHECKED BY	
NOTED BY	
APPROVED BY	

W:\CIVIL 3D PROJECTS\2008_008_000 DOT-HWY IMP WAINALOA PH 1\AS BUILT PLANS\CAD\C16-02 - CURB RAMP DETAILS.DWG 3/3/2020 3:40 PM

