




FED. ROAD DIST. NO.	STATE	FED. AID PROJ. NO.	FISCAL YEAR	SHEET NO.	TOTAL SHEETS
HAWAII	HAW.	NH-072-1(53)	2015	52	117

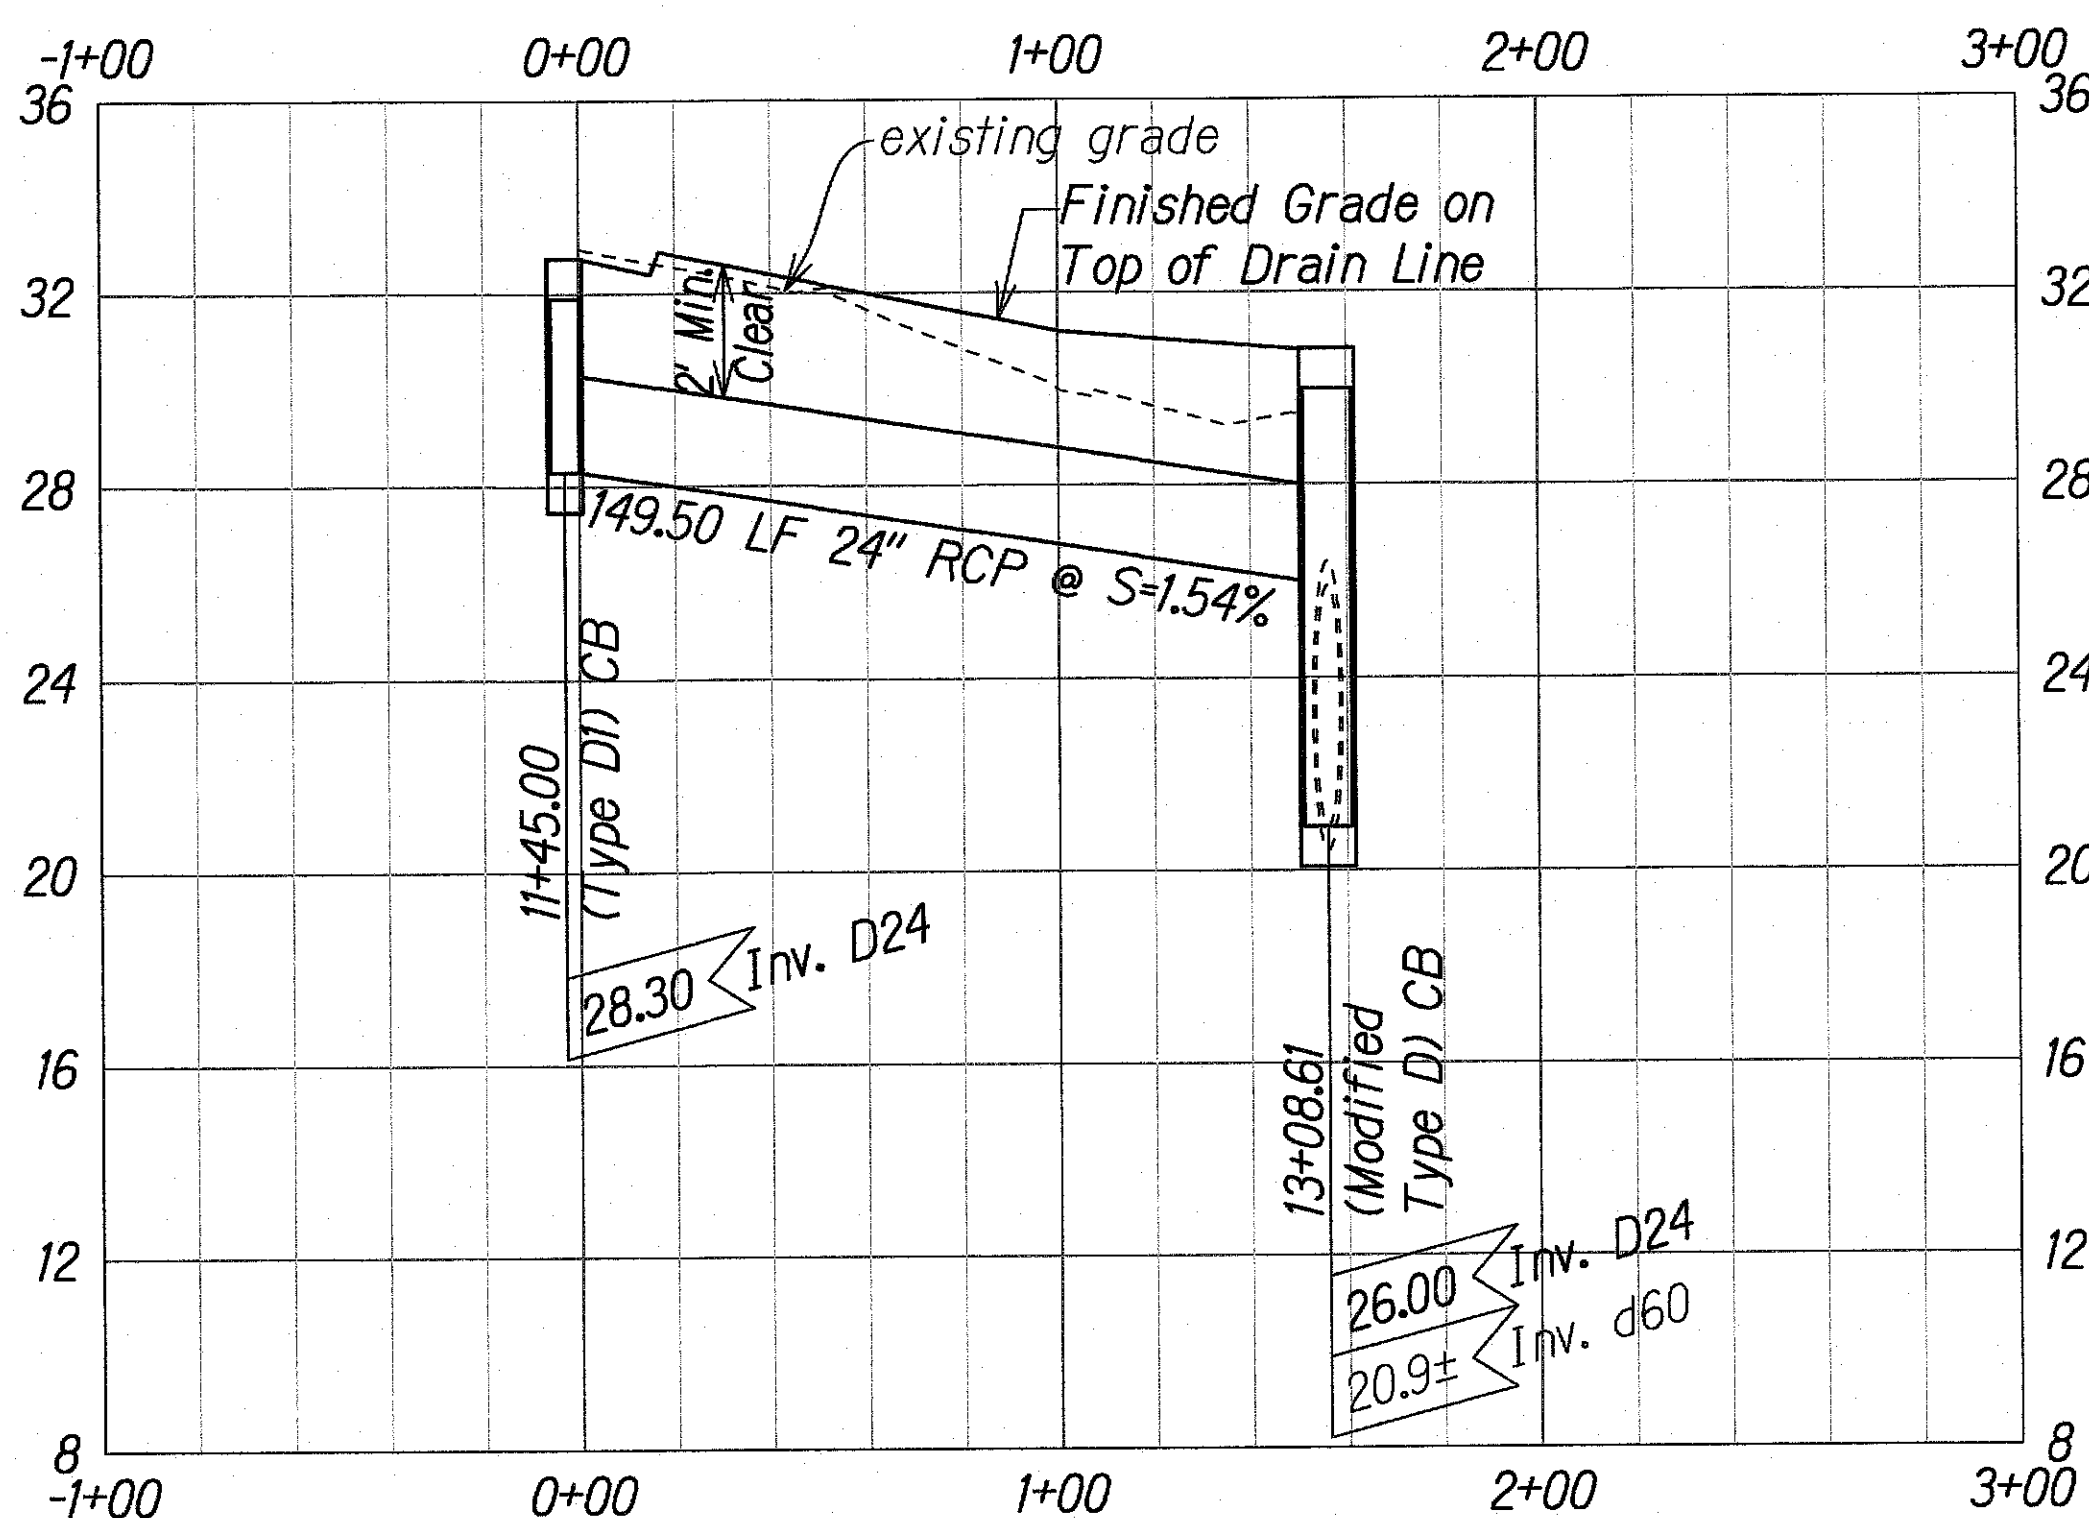

Drain Line "B"
 Scale: Horiz. 1" = 40'
 Vert. 1" = 4'

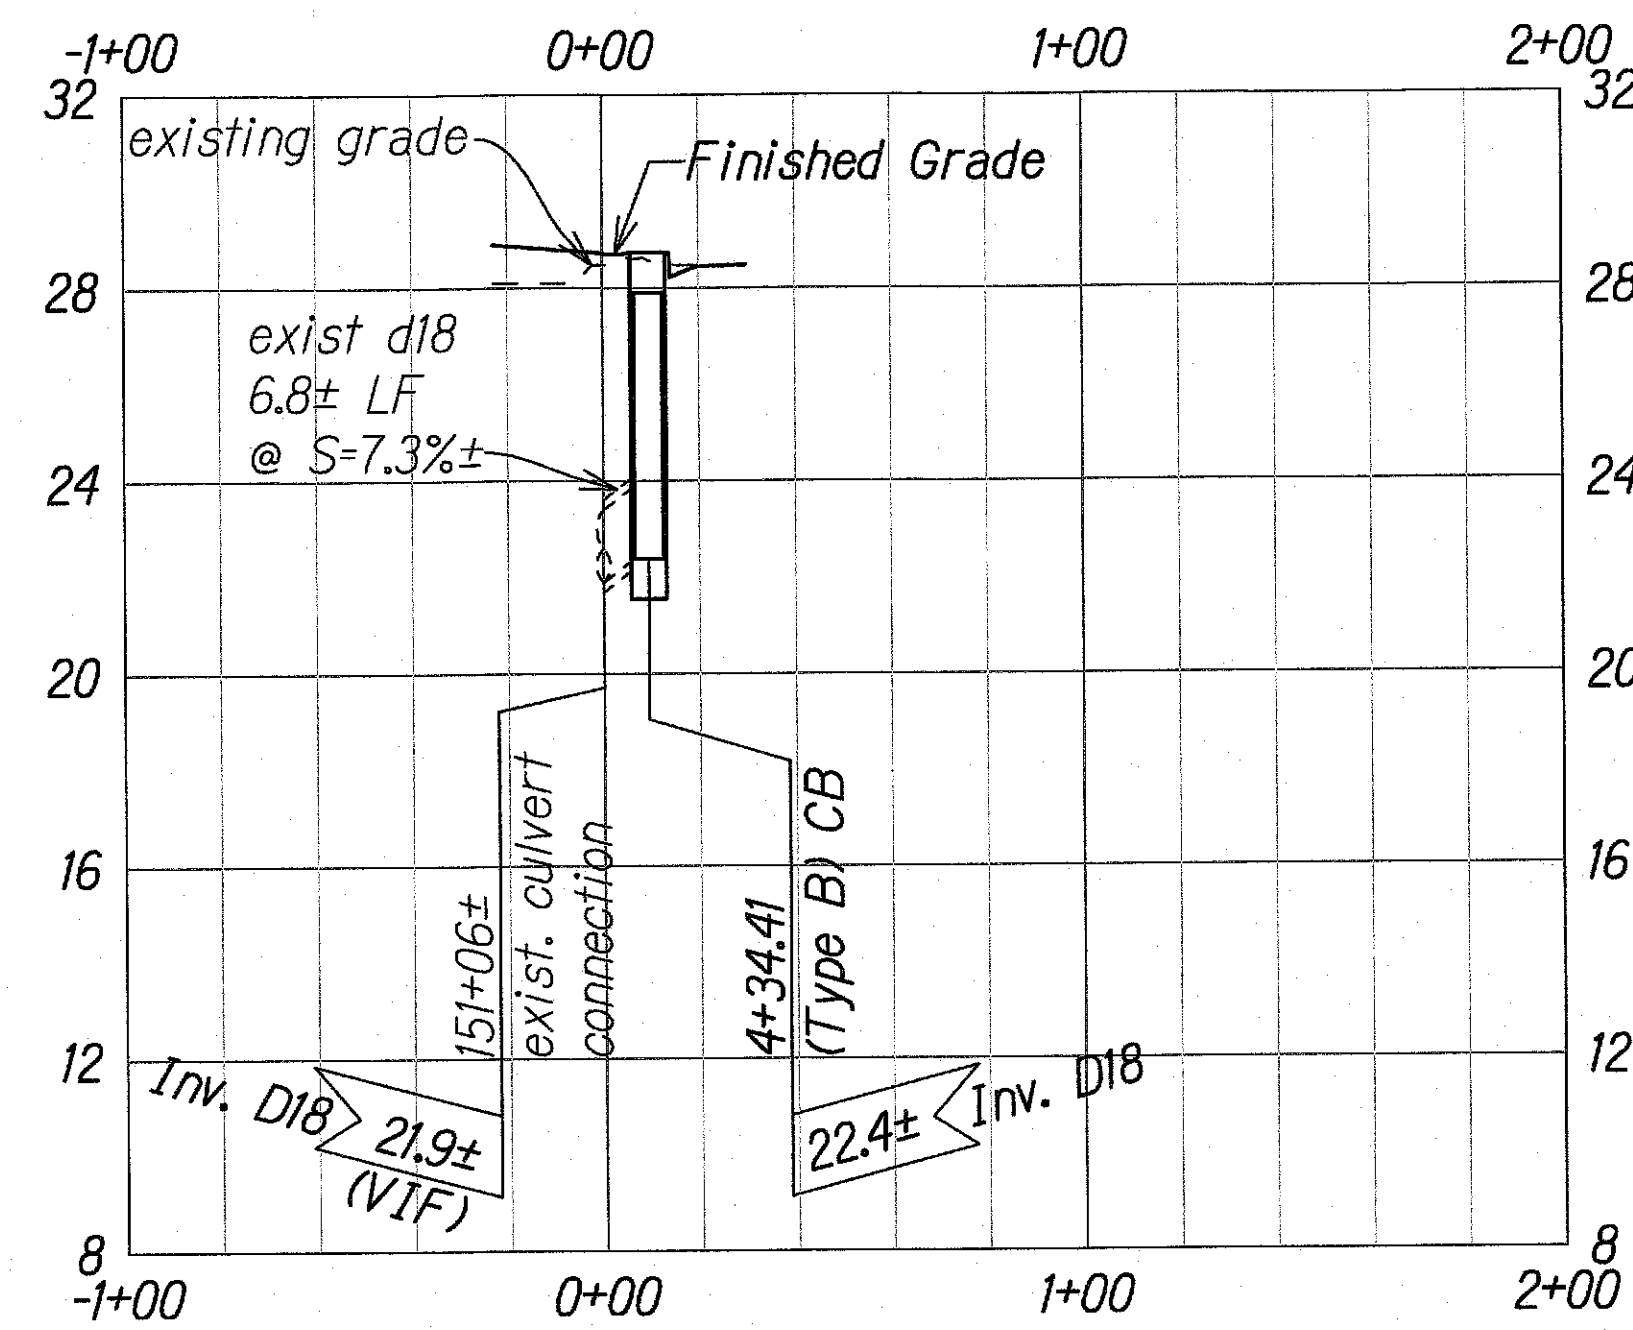


Drain Line "A"
 Scale: Horiz. 1" = 40'
 Vert. 1" = 4'

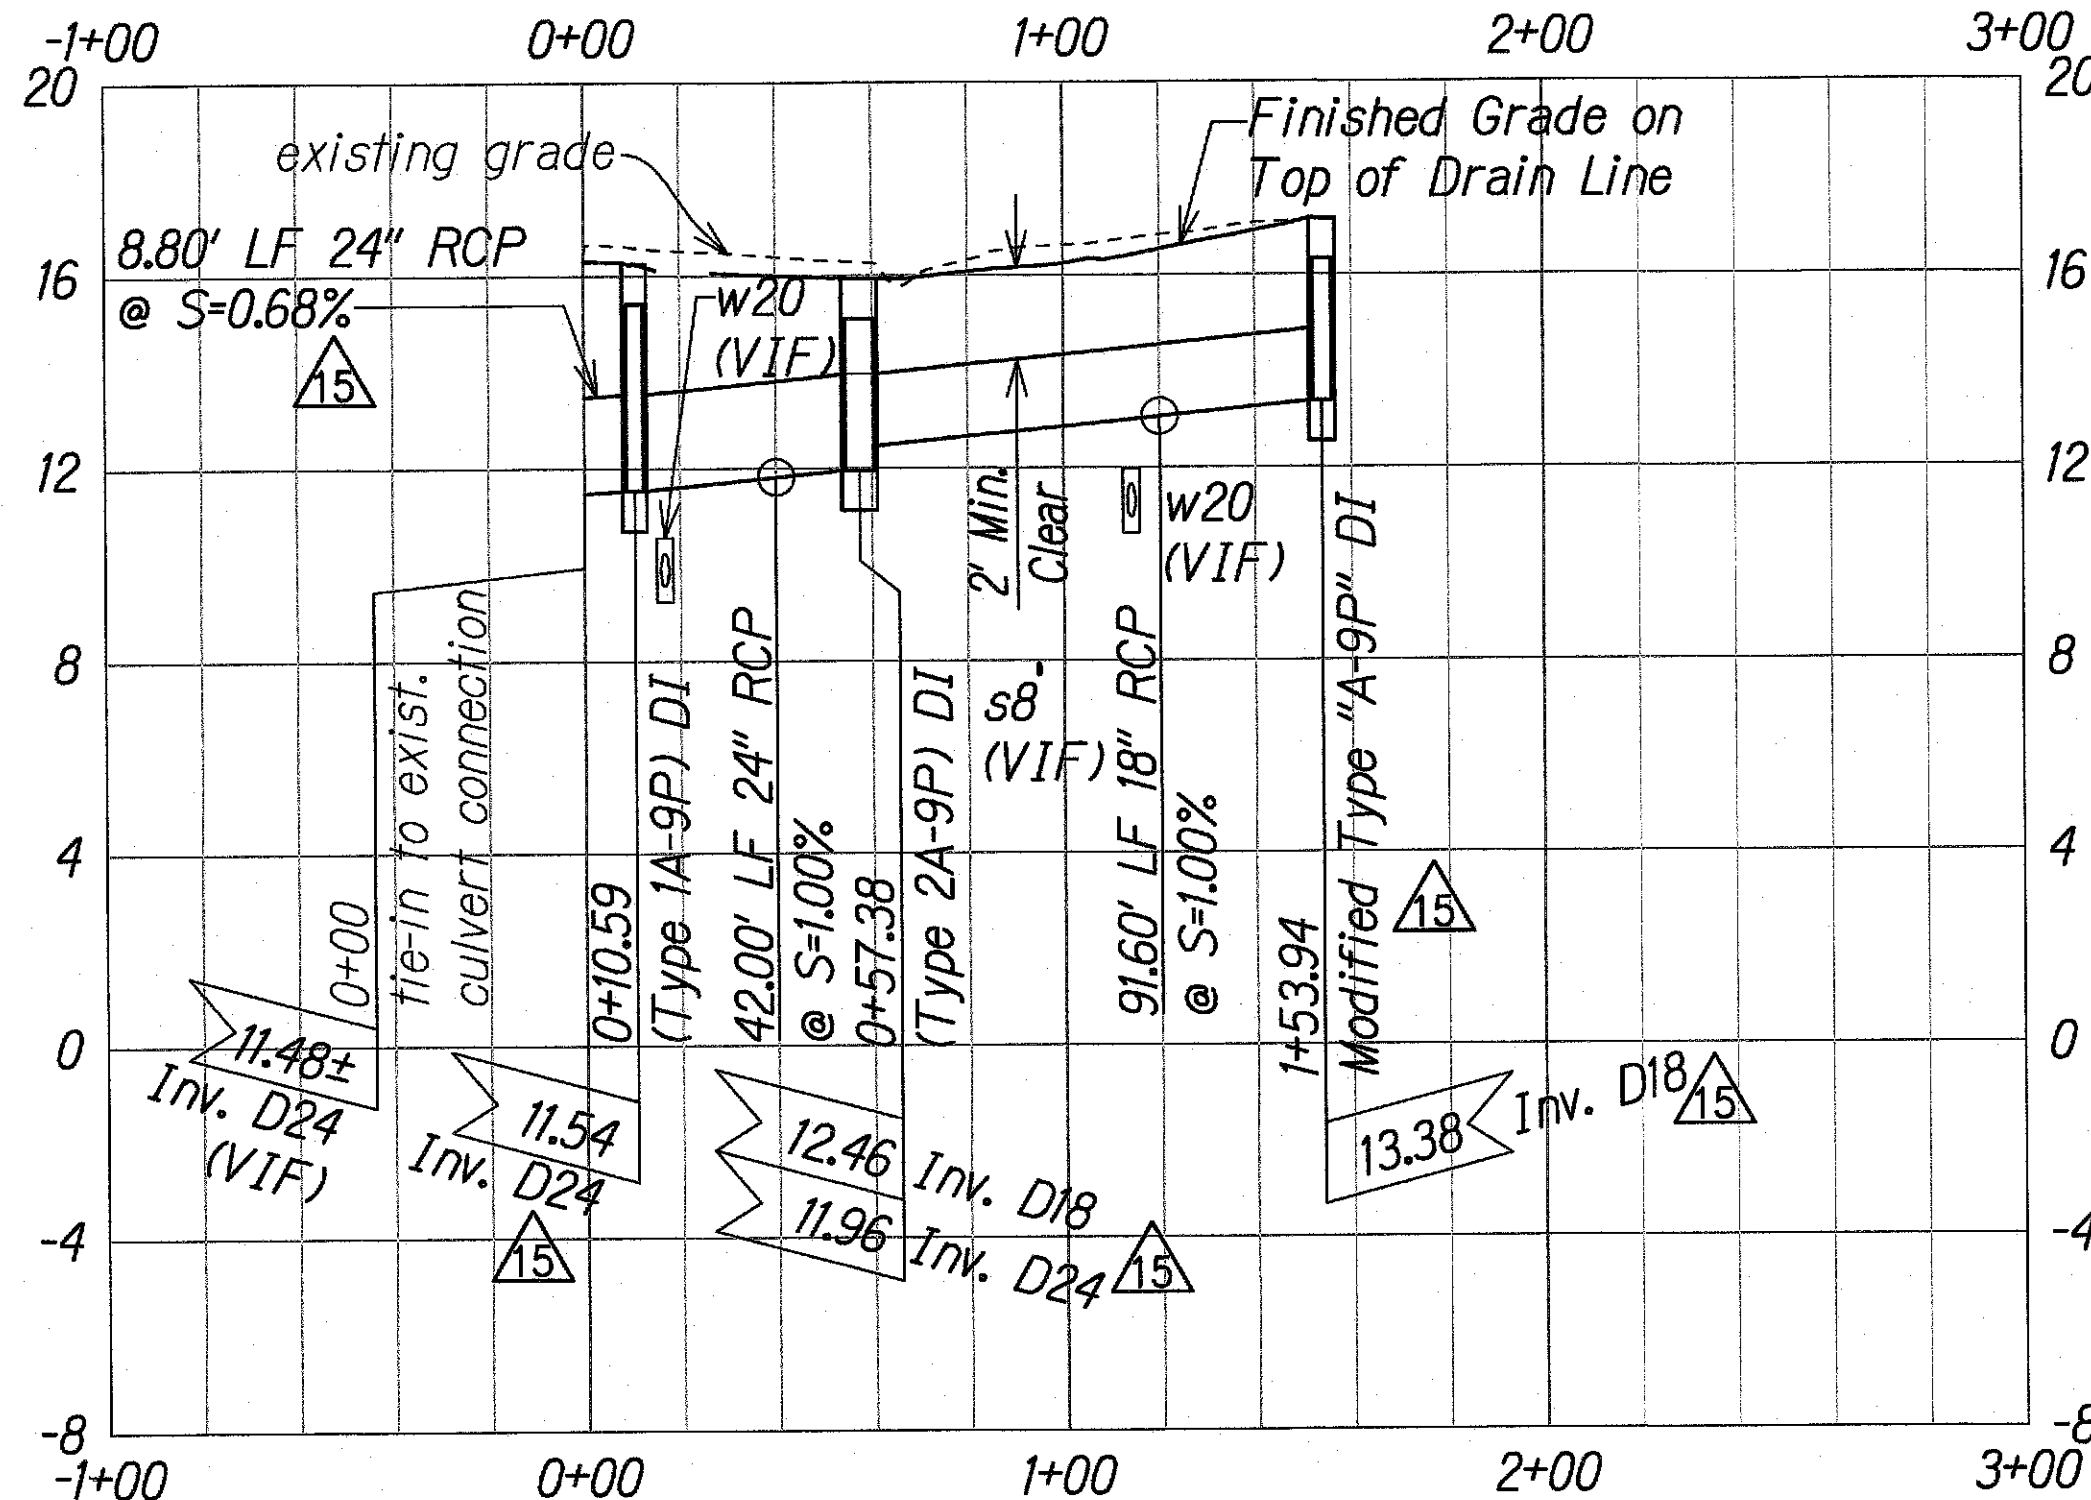

Drain Line "C"
 Scale: Horiz. 1" = 40'
 Vert. 1" = 4'

- NOTES:**
- For Drain Line "A" Layout, See Sheet C35.
 - For Drain Line "B" Layout, See Sheets C36 and C37.
 - For Drain Line "C" Layout, See Sheet C39.

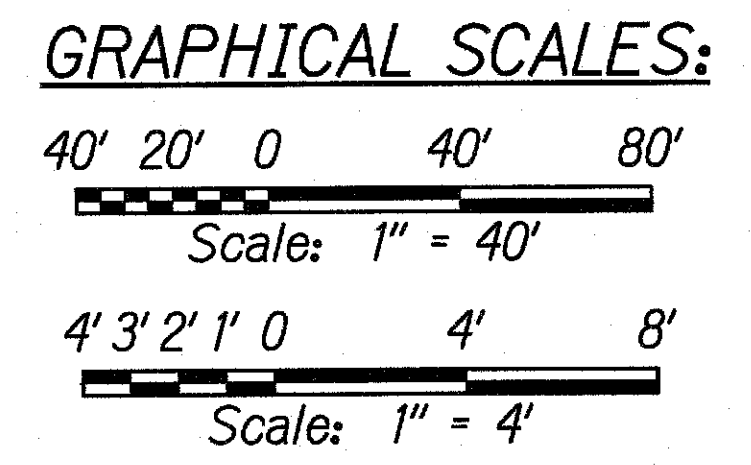

02/01/19

Revised Drop Inlets at Kahawii Stream

STATE OF HAWAII
DEPARTMENT OF TRANSPORTATION
HIGHWAYS DIVISION

Drain Line Profiles

KALANIANA'OLE HIGHWAY IMPROVEMENTS, PHASE I
Olomana Golf Course To Vicinity of Poallima St.
Federal Aid Project No. NH-072-1(53)
Scale: AS NOTED Date: March, 2019
SHEET No. C52 OF 73 SHEETS