


FED. ROAD DIST. NO.	STATE	FED. AID PROJ. NO.	FISCAL YEAR	SHEET NO.	TOTAL SHEETS
HAWAII	HAW.	NH-072-1(53)	2014	21	103

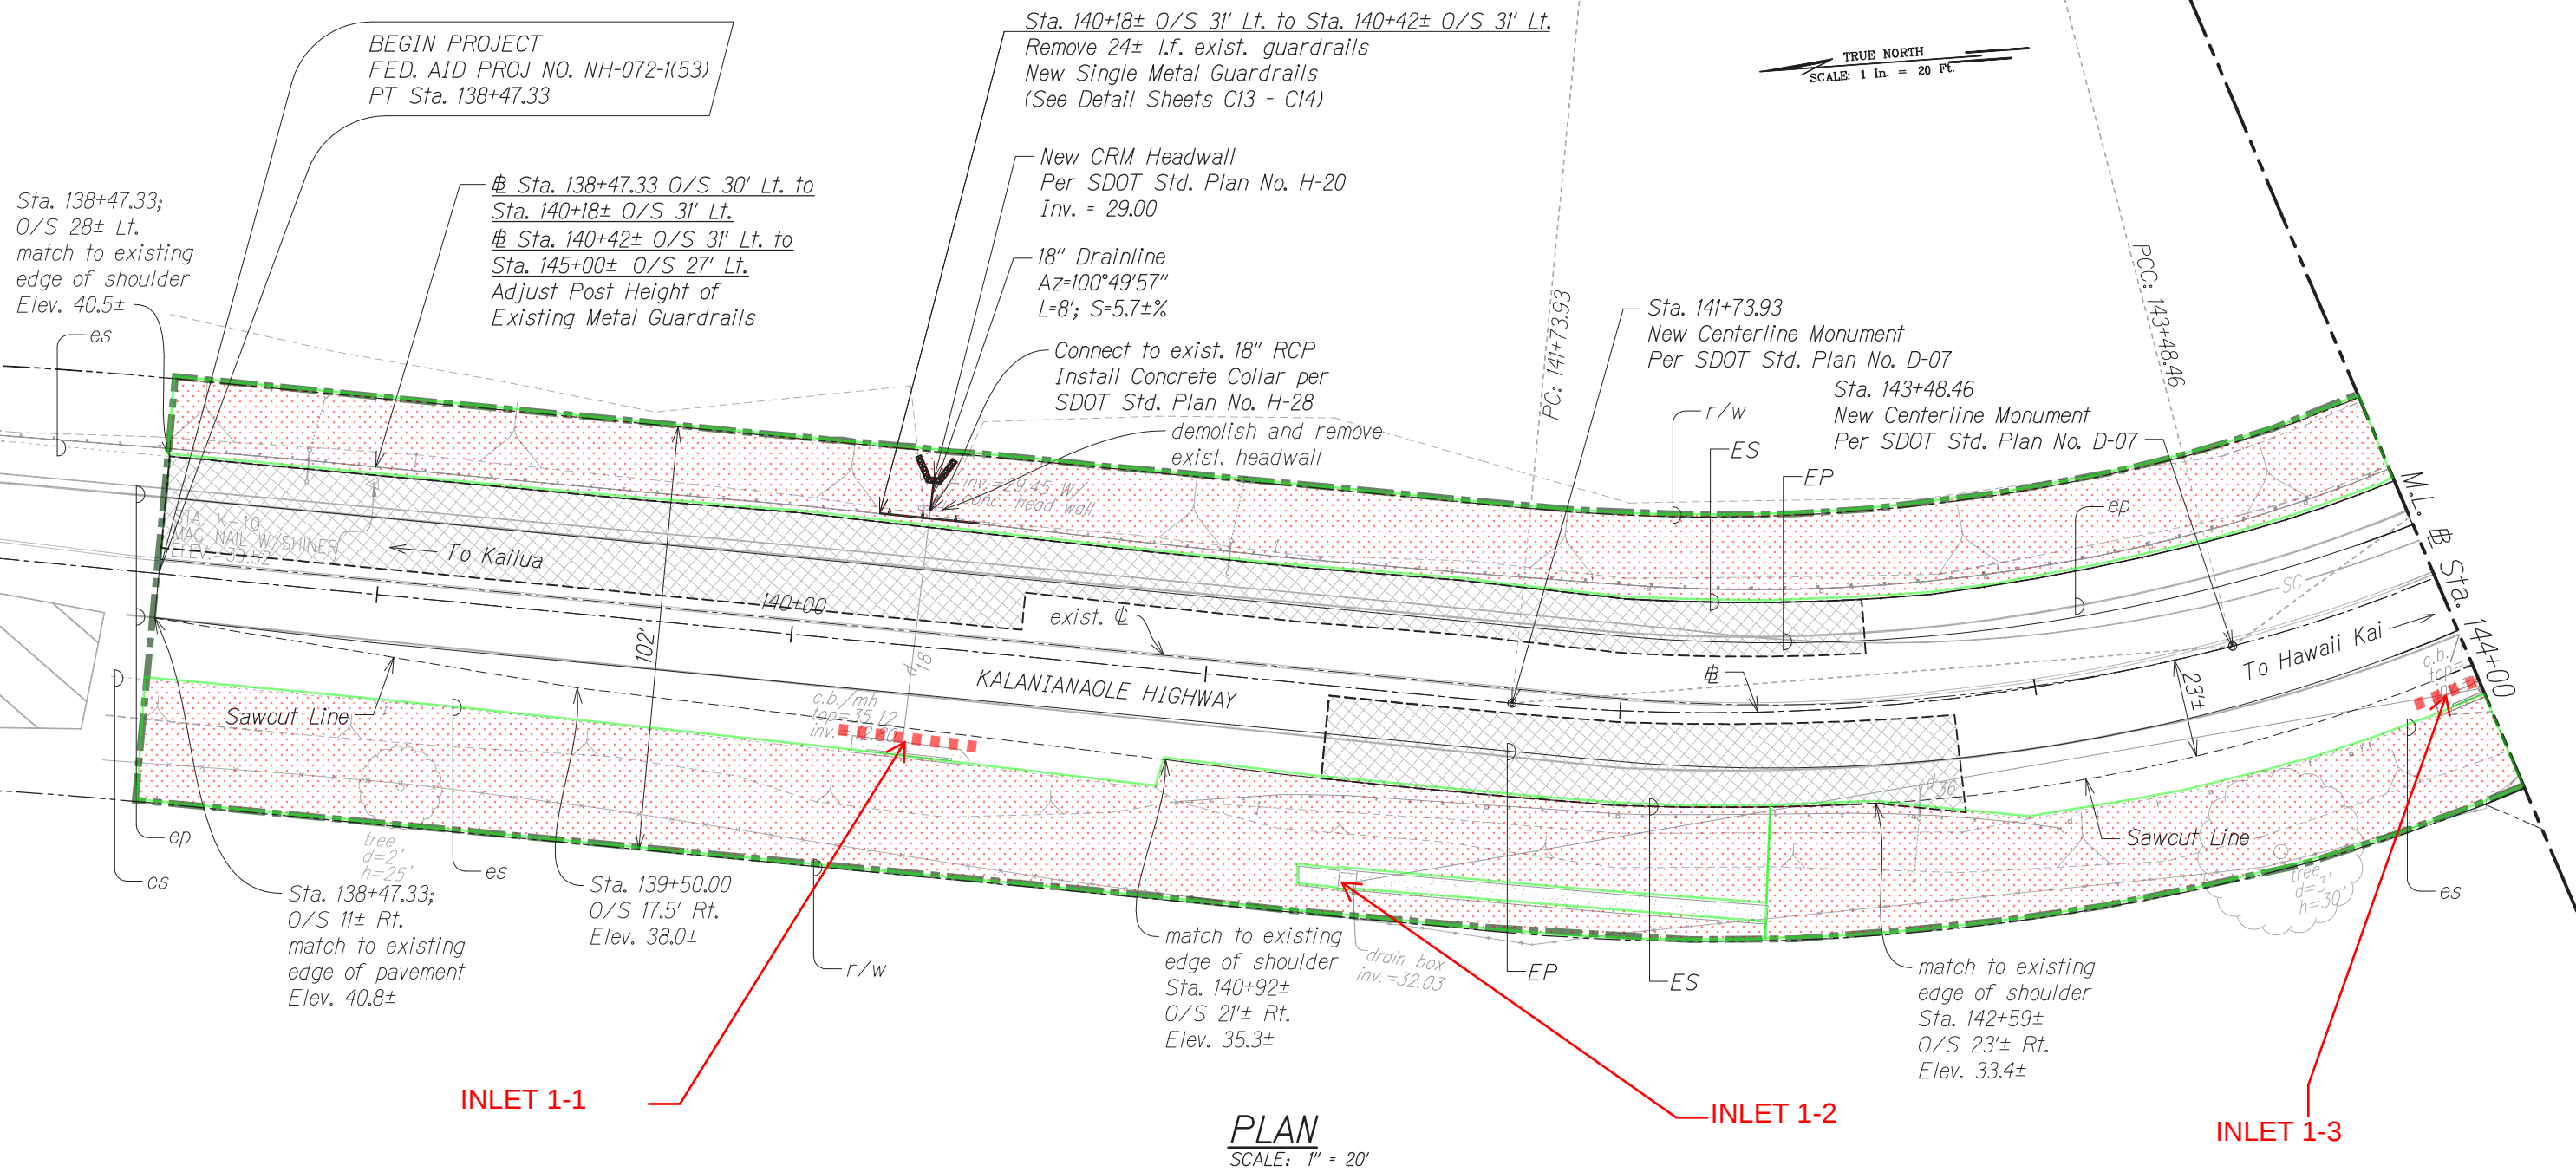


DATE	_____
DESIGNED BY	_____
TRACED BY	_____
NOTED BY	_____
CHECKED BY	_____
ORIGINAL PLAN	_____
NOTE BOOK	_____
No.	_____

BENCHMARK

Y-11 Brass Disk; Elevation=30.25
referred to The National Geodetic Survey Data Sheet

Azimuth and Coordinates referred to "Waimanalo Ridge"
Triangulation Station

GRAPHICAL SCALE:

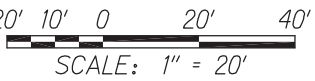

LEGEND:

Limits Pavement Reconstruction

NOTE:

For Pavement Safety Edge Detail, see Sheet C30.

BMP PLAN - LANDSCAPING

LEGEND:

- CONSTRUCTION LIMITS
- PROTECT INLET
- LANDSCAPING

THIS WORK WAS PREPARED BY ME OR
UNDER MY SUPERVISION

SIGNATURE

EXPIRATION DATE
OF THE LICENSE

STATE OF HAWAII
DEPARTMENT OF TRANSPORTATION
HIGHWAYS DIVISION

ROADWAY PLAN

KALANIANA'OLE HIGHWAY IMPROVEMENTS, PHASE 1
Olomana Golf Course To Poalima Street
Federal Aid Project No. NH-072-1(53)

Scale: AS NOTED Date: MAR, 2013

SHEET No. C21 OF 69 SHEETS

BMP PLAN - LANDSCAPING

FED. ROAD DIST. NO.	STATE	FED. AID PROJ. NO.	FISCAL YEAR	SHEET NO.	TOTAL SHEETS
HAWAII	HAW.	NH-072-1(53)	2014	22	103

LEGEND:

CONSTRUCTION LIMITS

PROTECT INLET

LANDSCAPING

INLET 1-3

Sta. 144+98± O/S 27' Lt. to Sta. 146+38± O/S 23' Lt.
Sta. 146+66± O/S 21' Lt. to Sta. 146+99± O/S 20' Lt.
Sta. 147+35± O/S 17' Lt. to Sta. 149+18± O/S 19' Lt.
New Single Metal Guardrails, See Detail Sheet C13 - C14

Sta. 146+38± O/S 23' Lt.
Sta. 146+66± O/S 21' Lt.
Sta. 146+99± O/S 21' Lt.
Sta. 147+35± O/S 17' Lt.
Modified Type "G" End Terminal
See Det. Sht. C17

Sta. 147+32± O/S 23' Lt. to
Sta. 148+22± O/S 17' Lt.
Remove 90± l.f. exist. guardrail.

Sta. 140+42± O/S 31' Lt. to
Sta. 145+00± O/S 31' Lt.
Adjust Post Height of
Existing Metal Guardrails
1'-9" to Center of W-Beam
(2"± Tolerance)

Sta. 146+37.82
O/S 22.5' Lt.
Elev. 29.25

Sta. 146+98.83
O/S 20.0' Lt.
Elev. 29.12

Sta. 147+35.00
O/S 17.0' Lt.
Elev. 29.07

New Wheelchair Ramp
See Det. Sht. C10
Sta. 148+50.00; O/S 19.00' Rt.
Begin New Conc. Curb & Gutter
(Type 2DG)
Per SDOT Std. Plan No. D-05
Sta. 148+33
New Centerline Monument
Per SDOT Std. Plan No. D-07

STA. 148+33±; O/S 20' Rt.
Hydrant Concrete Slab and
Guard Posts
(See Detail Sht. C29)
(Adjust Fire Hydrant As Required)

BENCHMARK


Y-11 Brass Disk; Elevation=30.25
referred to The National Geodetic Survey Data Sheet

Azimuth and Coordinates referred to "Waimanalo Ridge"
Triangulation Station

CURVE DATA:

CURVE	①	②	③	④	⑤	⑥	⑦	⑧	⑨	⑩	⑪
Δ	92°04'01"	89°02'06"	90°57'54"	90°00'00"	88°49'01"	86°49'13"	90°44'17"	90°30'25"	88°45'18"	180°00'00"	91°14'42"
Δ/2	46°02'00.7"	44°43'03.2"	45°28'56.8"	45°00'00.0"	44°24'30.4"	43°24'36.6"	45°22'08.5"	45°15'12.3"	44°22'39.2"	90°00'00"	45°37'20.8"
R	5.00'	5.00'	10.00'	10.00'	8.00'	8.00'	5.00'	5.00'	8.00'	2.50'	8.00'
Tan.	5.184'	4.92'	10.17'	10.00'	7.84'	7.57'	5.07'	5.04'	7.83'	INFINITY	8.18'
C	7.20'	7.01'	14.26'	14.14'	11.20'	11.00'	7.12'	7.10'	11.19'	5.00'	11.44'
Lc	8.03'	7.77'	15.88'	15.71'	12.40'	12.12'	7.92'	7.90'	12.39'	7.85'	12.74'

GRAPHICAL SCALE:

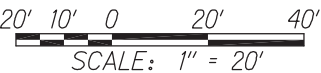

LEGEND:

Limits Pavement Reconstruction

NOTE:

For Pavement Safety Edge Detail, see Sheet C30.

PLAN

SCALE: 1" = 20'

LINE DATA:

LINE	①	②	③	④	⑤	⑥	⑦	⑧
Az	215°53'43"	215°57'43"	215°57'43"	215°57'43"	36°42'00"	36°42'00"	35°57'43"	35°57'43"
Distance	10.50'	12.49'	17.04'	20.00'	2.97'	3.05'	14.63'	13.72'

NOTE:

(A) match to existing driveway

APPROVED:

MANAGER AND CHIEF ENGINEER, BWS
(For work affecting BWS Facilities in
State R/W and BWS Easements only)

DATE

THIS WORK WAS PREPARED BY ME OR
UNDER MY SUPERVISION

SIGNATURE

EXPIRATION DATE
OF THE LICENSE

STATE OF HAWAII
DEPARTMENT OF TRANSPORTATION
HIGHWAYS DIVISION

ROADWAY PLAN

KALANIANA'OLE HIGHWAY IMPROVEMENTS, PHASE 1

Olomana Golf Course To Poalima Street

Federal Aid Project No. NH-072-1(53)

Scale: AS NOTED

Date: MAR, 2013

SHEET No. C22 OF 69 SHEETS

Sta. 149+41± O/S 19' Lt. to Sta. 149+96± O/S 19' Lt.
Sta. 150+20± O/S 19' Lt. to Sta. 150+50± O/S 22' Lt.
Sta. 4+29± O/S 23' Lt. to Sta. 4+91± O/S 22' Lt.
Sta. 5+08± O/S 22' Lt. to Sta. 6+00± O/S 22' Lt.
New Single Metal Guardrails, See Detail Sheet C13 - C14

Sta. 149+18± O/S 19' Lt.
Sta. 149+41± O/S 19' Lt.
Sta. 149+96± O/S 19' Lt.
Sta. 150+20± O/S 19' Lt.
Sta. 4+91± O/S 22' Lt.
Sta. 5+08± O/S 22' Lt.
Sta. 6+00± O/S 22' Lt.
Modified Type "G" End Terminal,
(See Detail Sheet C17)

Sta. 150+50± O/S 22' Lt.
Sta. 4+29± O/S 23' Lt.
End Guardrail Section Per
Detail Sheet C15

BMP PLAN - LANDSCAPING

LEGEND:

CONSTRUCTION LIMITS

PROTECT INLET

LANDSCAPING

SILT FENCE


NOTE:

The Contractor shall restore the existing deck drains on Waimanalo Stream Bridge to provide positive drainage from roadway.

CURVE DATA:

CURVE	①	②	③	④	⑤	⑥	⑦	⑧
Δ	89°30'15"	90°29'45"	89°30'10"	90°29'45"	89°30'15"	90°29'45"	47°14'39"	55°08'42"
$\Delta/2$	44°45'07.3"	45°14'52.7"	44°45'05.0"	45°14'52.7"	44°45'07.3"	45°14'52.7"	23°37'19.4"	27°34'21.2"
R	7.00'	7.00'	7.00'	7.00'	5.00'	5.00'	18.00'	14.53'
Tan.	6.94'	7.06'	6.94'	7.06'	4.96'	5.04'	7.87'	7.59'
C	9.86'	9.94'	9.86'	9.94'	7.04'	7.10'	14.42'	13.45'
Lc	10.93'	11.06'	10.93'	11.06'	7.81'	7.90'	14.84'	13.98'

GRAPHICAL SCALE:

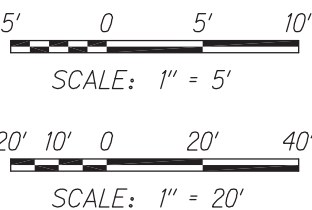

BENCHMARK

Y-11 Brass Disk; Elevation=30.25
referred to The National Geodetic Survey Data Sheet

Azimuth and Coordinates referred to "Waimanalo Ridge"
Triangulation Station


NOTE:

For Pavement Safety Edge Detail, see Sheet C30.

LINE DATA:


LINE	①	②	③	④	⑤	⑥
Az	216°42'00"	216°42'00"	216°42'00"	216°42'00"	216°42'00"	216°42'00"
Distance	21.49'	21.29'	13.81'	13.61'	14.31'	14.12'

FED. ROAD DIST. NO.	STATE	FED. AID PROJ. NO.	FISCAL YEAR	SHEET NO.	TOTAL SHEETS
HAWAII	HAW.	NH-072-1(53)	2014	23	103

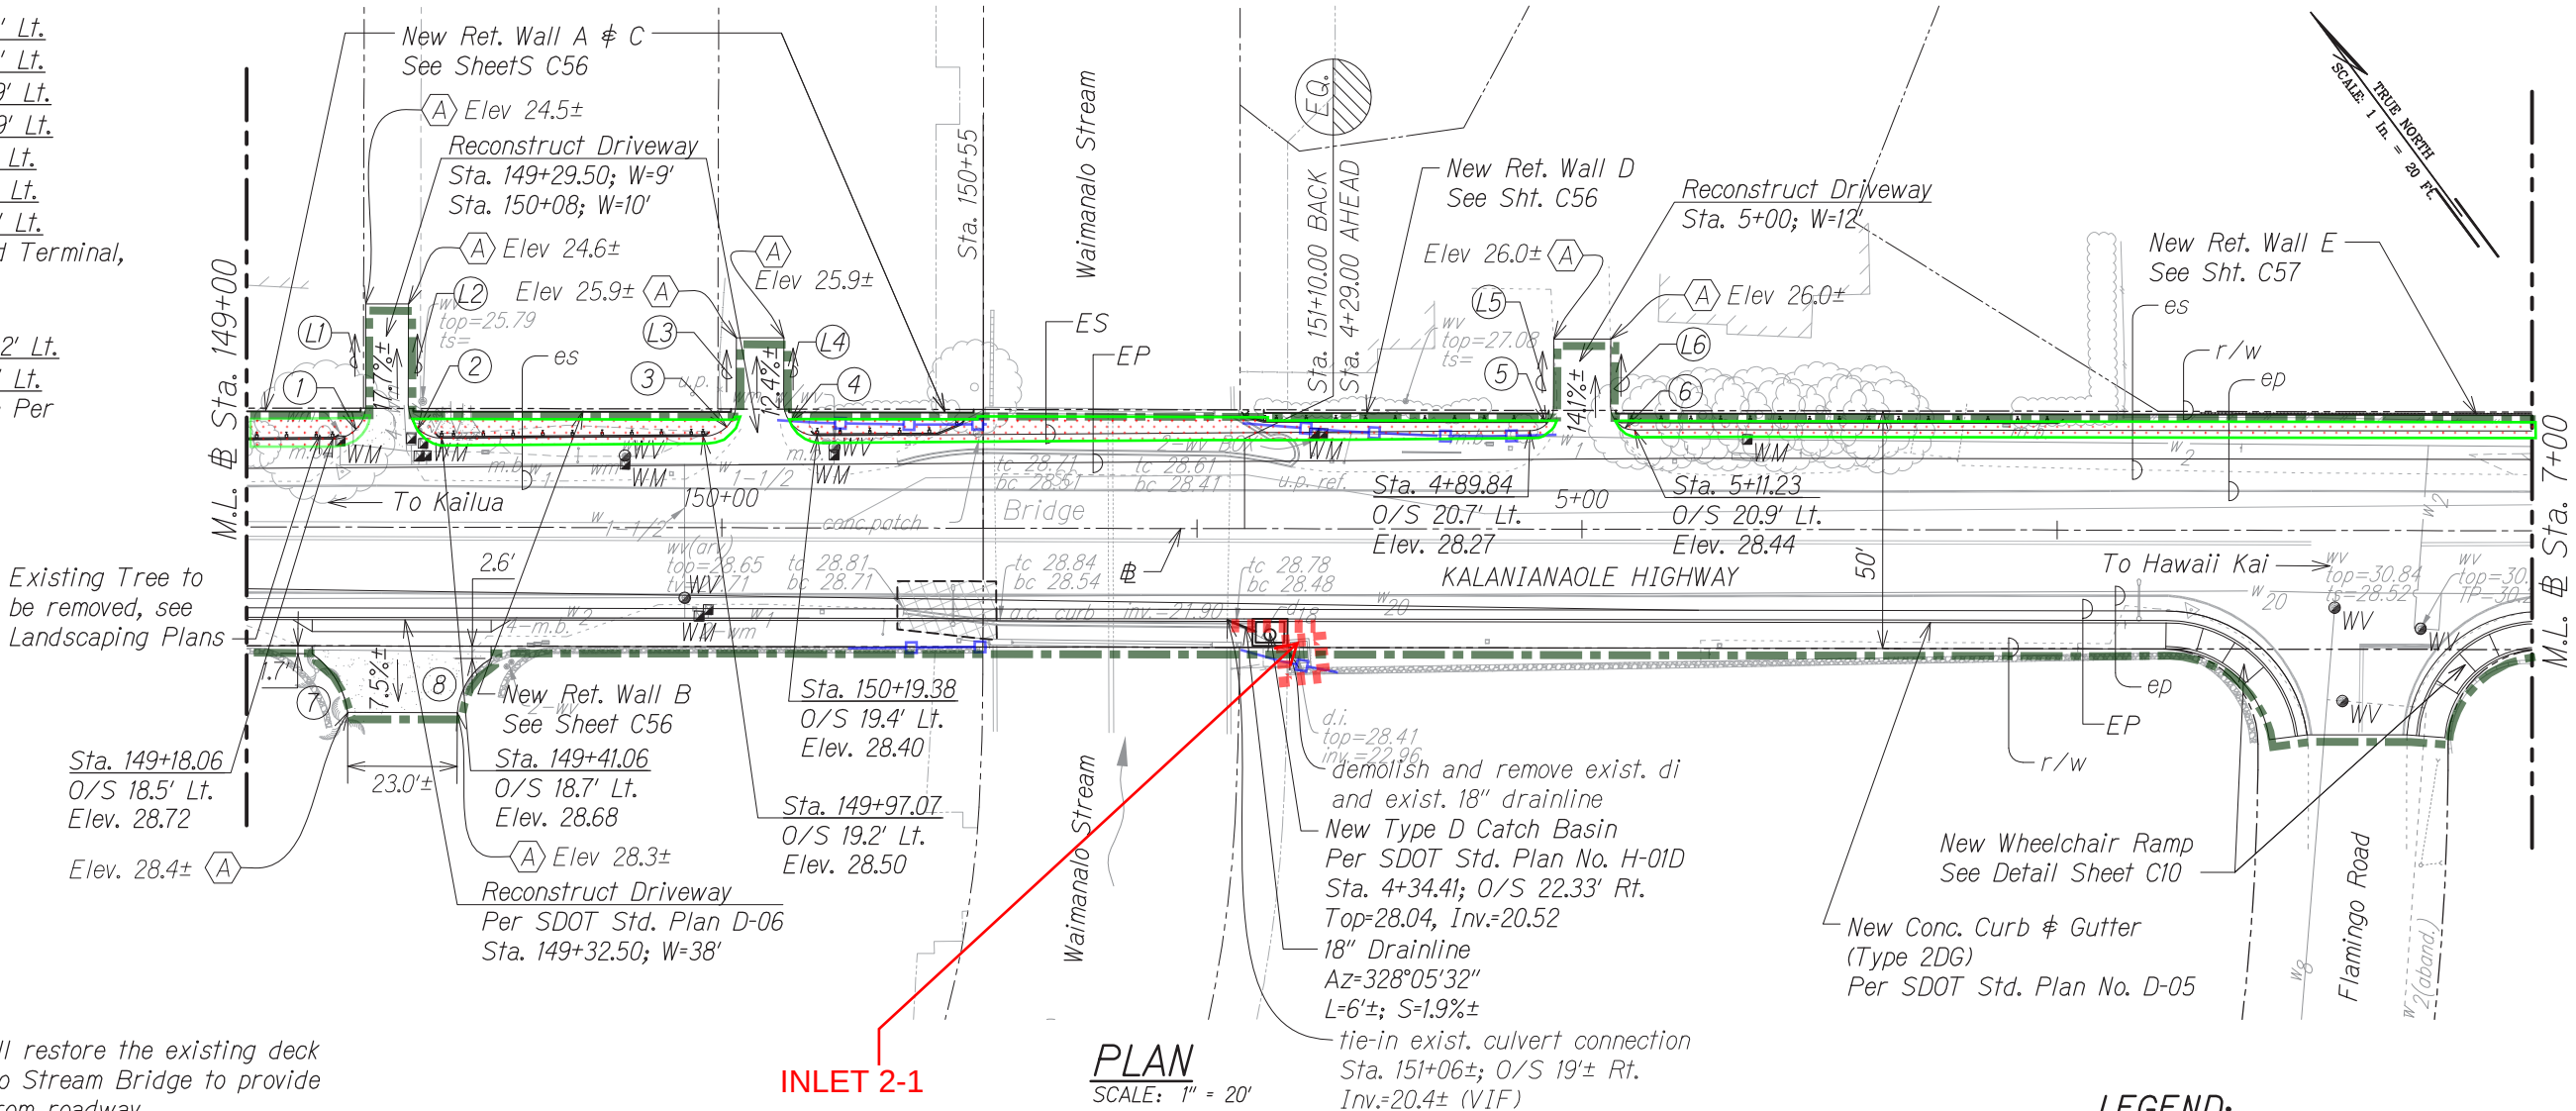

PLAN

SCALE: 1" = 20'

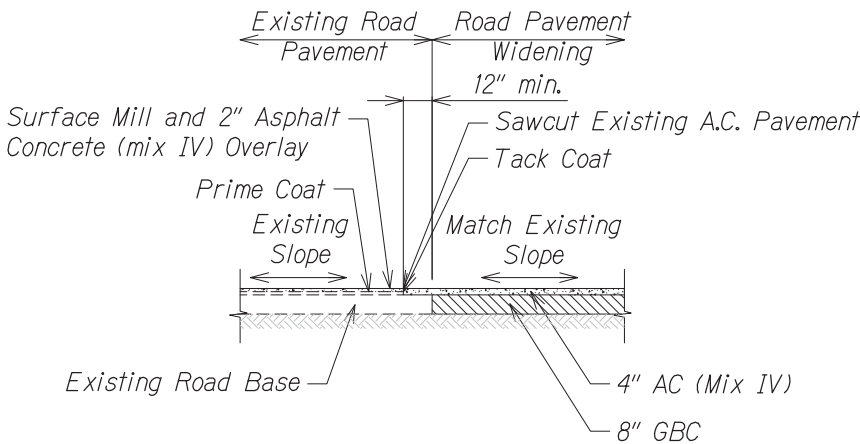

PAVEMENT CONNECTION DETAIL

SCALE: 1" = 5'

LEGEND:

Limits Pavement Reconstruction

NOTE:

match to existing driveway

STATE OF HAWAII
DEPARTMENT OF TRANSPORTATION
HIGHWAYS DIVISION

ROADWAY PLAN

KALANIANA'OLE HIGHWAY IMPROVEMENTS, PHASE 1
Olomana Golf Course To Poalima Street
Federal Aid Project No. NH-072-1(53)

Scale: AS NOTED Date: MAR, 2013

SHEET No. C23 OF 69 SHEETS

THIS WORK WAS PREPARED BY ME OR
UNDER MY SUPERVISION

SIGNATURE


EXPIRATION DATE
OF THE LICENSE

FED. ROAD DIST. NO.	STATE	FED. AID PROJ. NO.	FISCAL YEAR	SHEET NO.	TOTAL SHEETS
HAWAII	HAW.	NH-072-1(53)	2014	24	103

BMP PLAN - LANDSCAPING

LEGEND:

- CONSTRUCTION LIMITS
- PROTECT INLET
- LANDSCAPING
- SILT FENCE

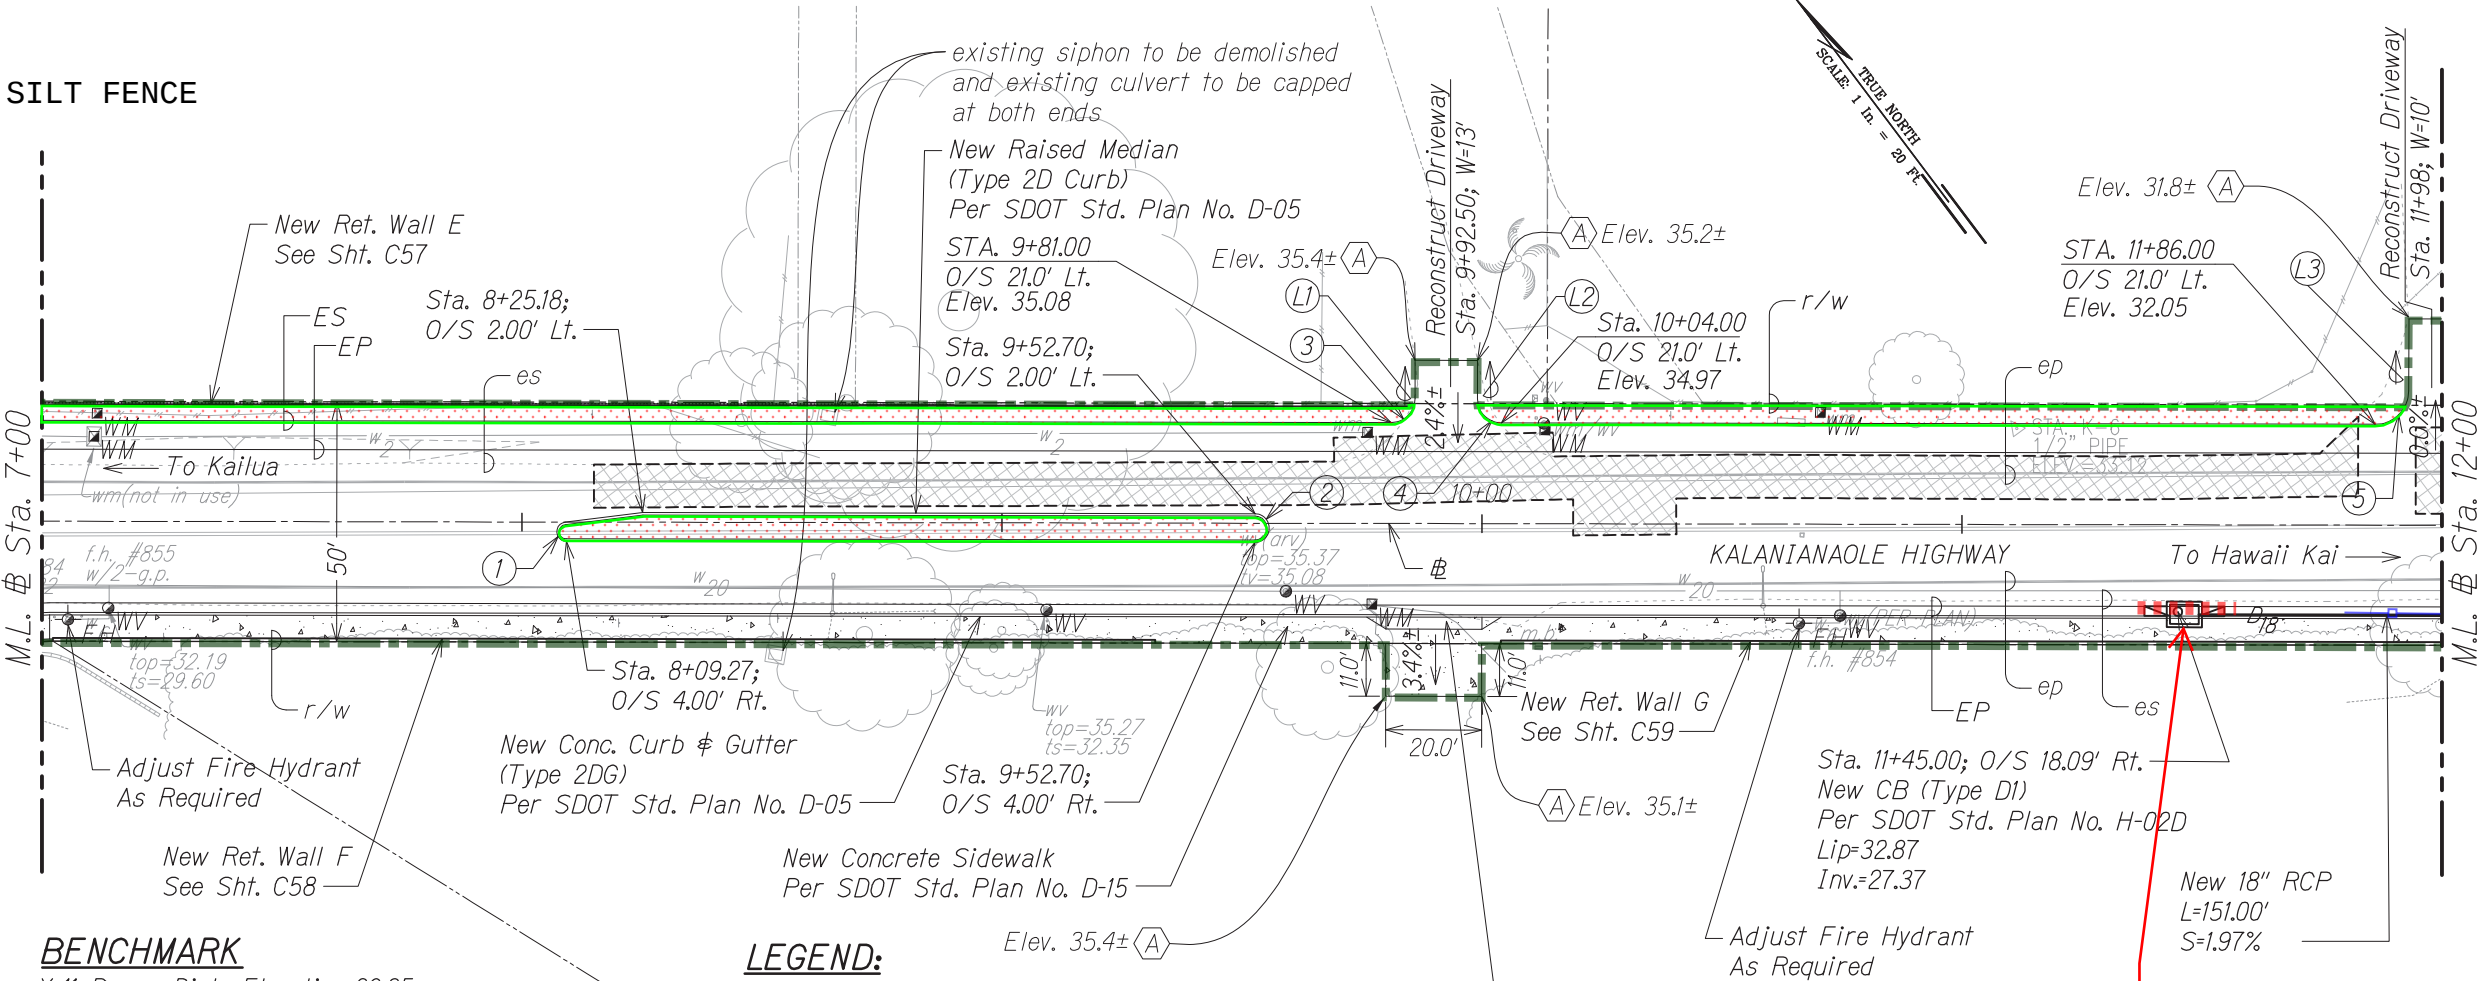

BENCHMARK

Y-11 Brass Disk; Elevation=30.25
referred to The National Geodetic Survey Data Sheet

Azimuth and Coordinates referred to "Waimanalo Ridge"
Triangulation Station

CURVE DATA:

CURVE	(1)	(2)	(3)	(4)	(5)
Δ	172°53'23"	180°00'00"	90°00'00"	90°00'00"	90°00'00"
$\Delta/2$	86°26'41.5"	90°00'00.0"	45°00'00.0"	45°00'00.0"	45°00'00.0"
R	2.00'	3.00'	5.00'	5.00'	7.00'
Tan.	32.19'	INFINITY	5.00'	5.00'	7.00'
C	3.99'	6.00'	7.07'	7.07'	9.90'
Lc	6.03'	9.42'	7.85'	7.85'	11.00'

LEGEND:

Limits Pavement Reconstruction

PLAN

SCALE: 1" = 20'

LINE DATA:

LINE	(L1)	(L2)	(L3)
Az	216°42'00"	216°42'00"	216°42'00"
Distance	8.00'	8.00'	15.00'

NOTE:

For Pavement Safety Edge Detail, see Sheet C30.

NOTE:


(A) match to existing driveway

APPROVED: INLET 3-1

MANAGER AND CHIEF ENGINEER, BWS
(For work affecting BWS Facilities in
State R/W and BWS Easements only)

DATE

GRAPHICAL SCALE:

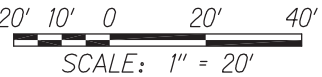

THIS WORK WAS PREPARED BY ME OR
UNDER MY SUPERVISION

SIGNATURE

EXPIRATION DATE
OF THE LICENSE

STATE OF HAWAII
DEPARTMENT OF TRANSPORTATION
HIGHWAYS DIVISION

ROADWAY PLAN


KALANIANA'OLE HIGHWAY IMPROVEMENTS, PHASE 1
Olomana Golf Course To Poalima Street
Federal Aid Project No. NH-072-1(53)

Scale: AS NOTED Date: MAR, 2013

SHEET No. C24 OF 69 SHEETS

BMP PLAN - LANDSCAPING

FED. ROAD DIST. NO.	STATE	FED. AID PROJ. NO.	FISCAL YEAR	SHEET NO.	TOTAL SHEETS
HAWAII	HAW.	NH-072-1(53)	2014	25	103

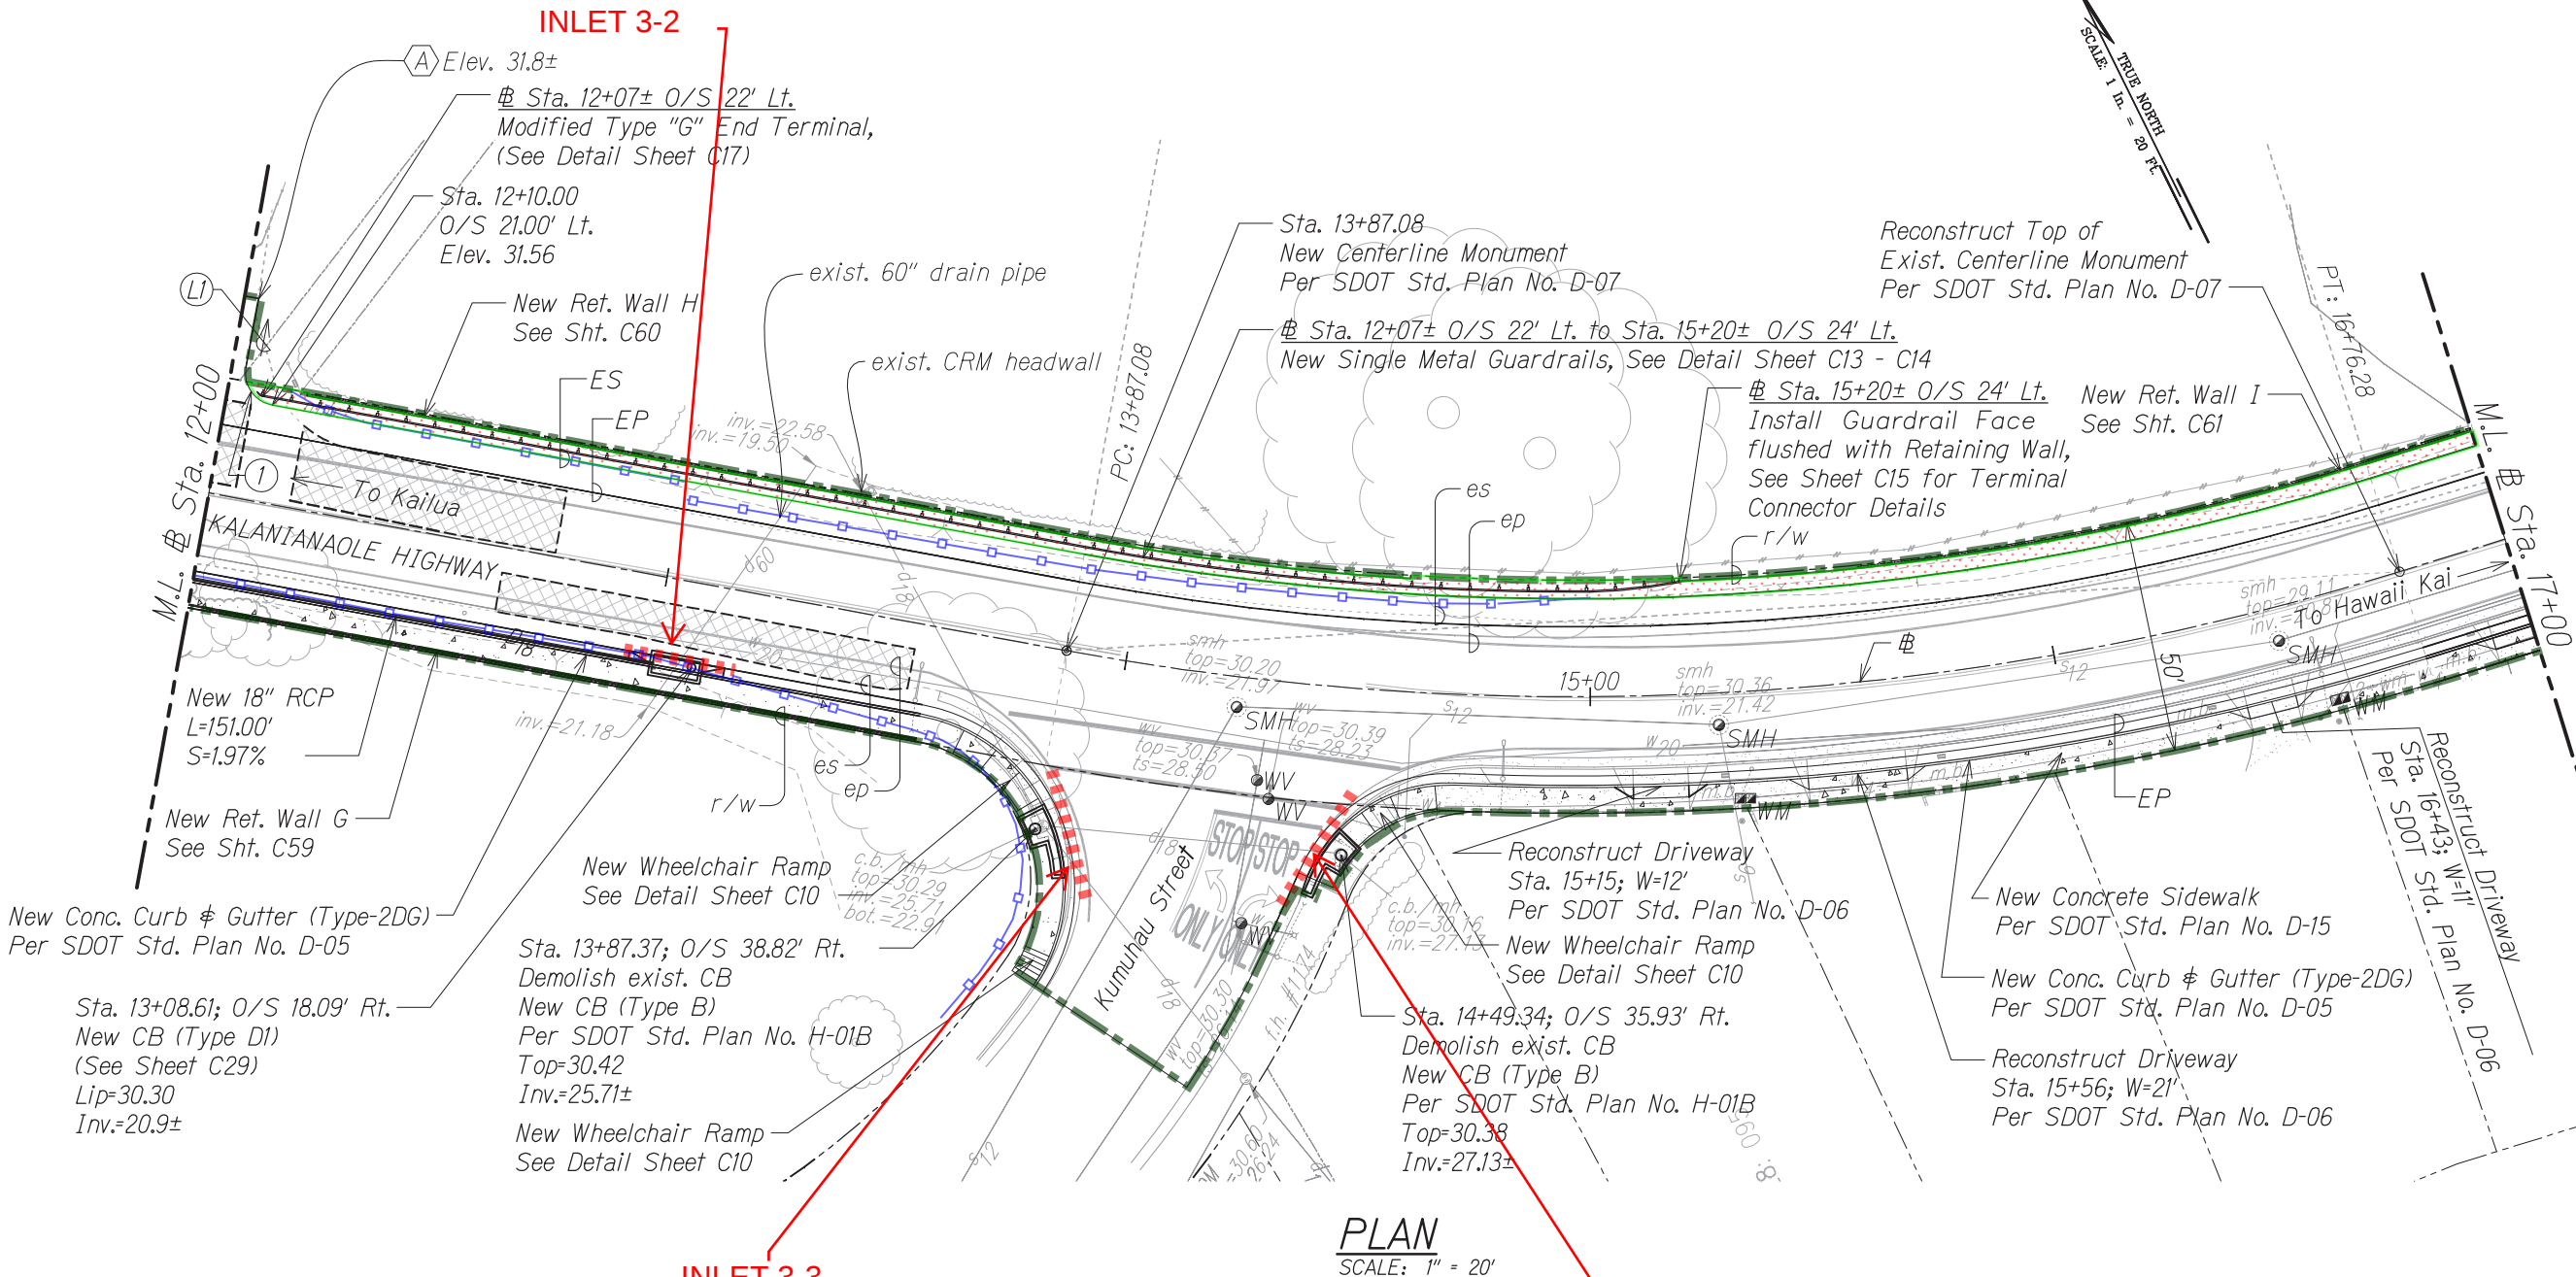

BENCHMARK

Y-11 Brass Disk; Elevation=30.25
referred to The National Geodetic Survey Data Sheet

Azimuth and Coordinates referred to "Waimanalo Ridge"
Triangulation Station

CURVE DATA:

CURVE	①
Δ	90°00'00"
$\Delta/2$	45°00'00.0"
R	7.00'
Tan.	7.00'
C	9.90'
Lc	11.00'

LINE DATA:

LINE	①
Az	216°42'00"
Distance	15.00'

NOTE:

For Pavement Safety Edge Detail, see Sheet C30.


NOTE:

Ⓐ match to existing driveway

LEGEND:

- CONSTRUCTION LIMITS
- PROTECT INLET
- LANDSCAPING
- SILT FENCE

GRAPHICAL SCALE:

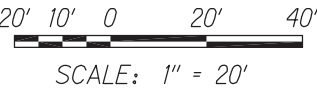

LEGEND:

- Limits Pavement Reconstruction

STATE OF HAWAII
DEPARTMENT OF TRANSPORTATION
HIGHWAYS DIVISION

ROADWAY PLAN

KALANIANA'OLE HIGHWAY IMPROVEMENTS, PHASE 1
Olomana Golf Course To Poalima Street
Federal Aid Project No. NH-072-1(53)

Scale: AS NOTED Date: MAR, 2013

SHEET No. C25 OF 69 SHEETS

LEGEND:


CONSTRUCTION LIMITS

PROTECT INLET

LANDSCAPING

BMP PLAN - LANDSCAPING

FED. ROAD DIST. NO.	STATE	FED. AID PROJ. NO.	FISCAL YEAR	SHEET NO.	TOTAL SHEETS
HAWAII	HAW.	NH-072-1(53)	2014	27	103

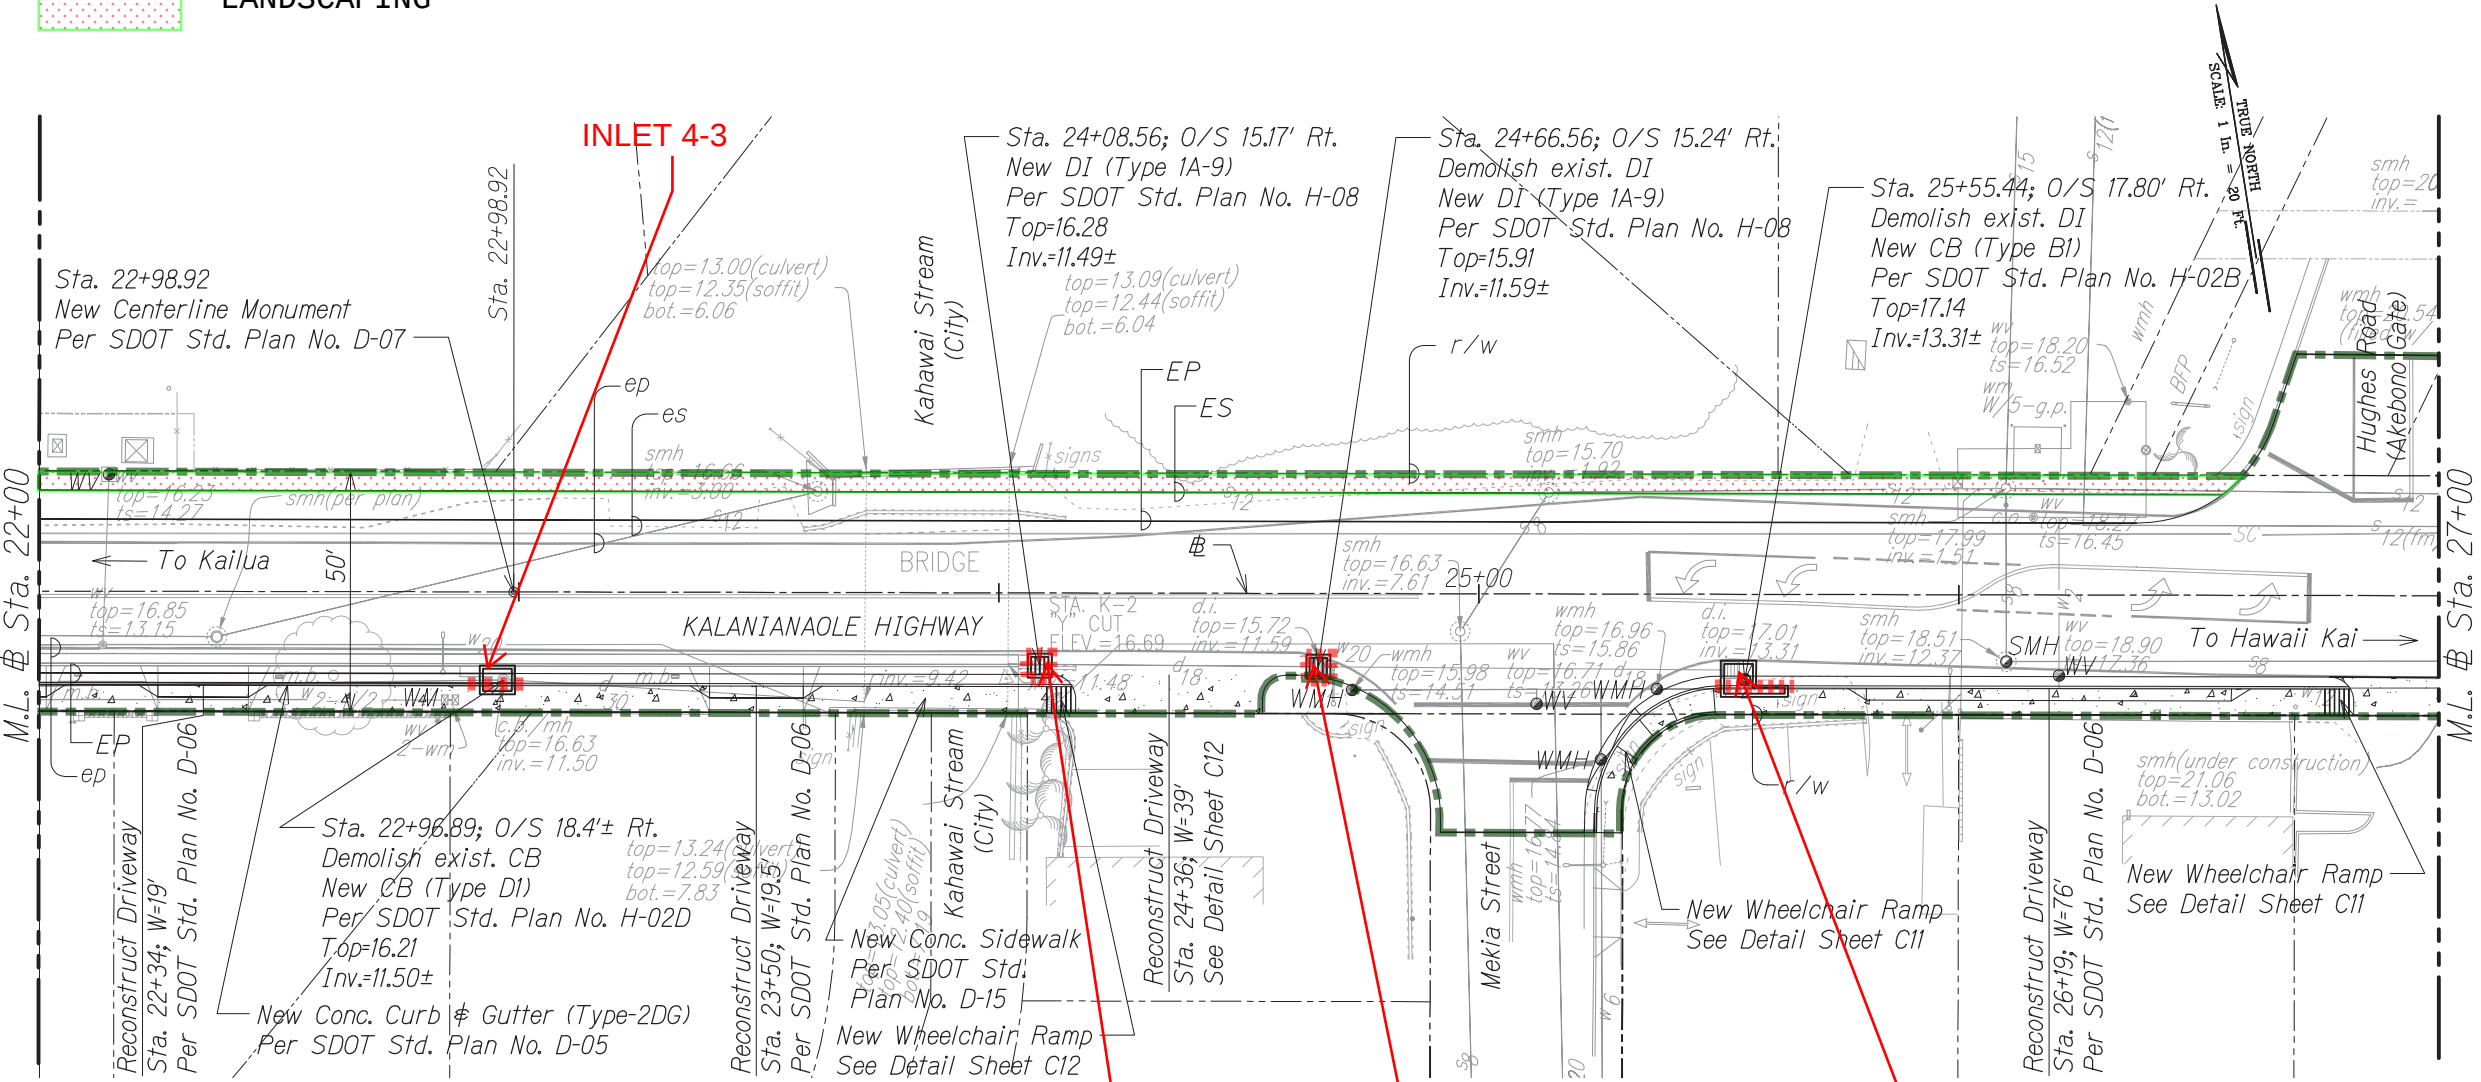

BENCHMARK


Y-11 Brass Disk; Elevation=30.25
referred to The National Geodetic Survey Data Sheet

Azimuth and Coordinates referred to "Waimanalo Ridge"
Triangulation Station

NOTES:

- The Contractor shall restore the existing deck drains on Kahawai Stream Bridge to provide positive drainage from roadway.
- For Pavement Safety Edge Detail, see Sheet C30.

GRAPHICAL SCALE:

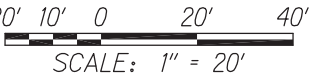

PLAN

SCALE: 1" = 20'

INLET 4-6

INLET 4-4

INLET 4-5

ORIGINAL PLAN	DATE
NOTE BOOK	DESIGNED BY
No.	CHECKED BY

W:_CIVIL_3D_PROJECTS\2008_000_DOT-HWY KAL HWY IMP WAIMANALO PH 1\C27-07 - ROADWAY PLAN.DWG 6/24/2013 6:18 PM

THIS WORK WAS PREPARED BY ME OR
UNDER MY SUPERVISION

SIGNATURE

EXPIRATION DATE
OF THE LICENSE

STATE OF HAWAII
DEPARTMENT OF TRANSPORTATION
HIGHWAYS DIVISION

ROADWAY PLAN

KALANIANAʻOLE HIGHWAY IMPROVEMENTS, PHASE 1

Olomana Golf Course To Poalima Street

Federal Aid Project No. NH-072-1(53)

Scale: AS NOTED

Date: MAR, 2013


SHEET No. C27 OF 69 SHEETS

LEGEND:

- CONSTRUCTION LIMITS
- LANDSCAPING
- SILT FENCE

BMP PLAN - LANDSCAPING

FED. ROAD DIST. NO.	STATE	FED. AID PROJ. NO.	FISCAL YEAR	SHEET NO.	TOTAL SHEETS
HAWAII	HAW.	NH-072-1(53)	2014	28	103

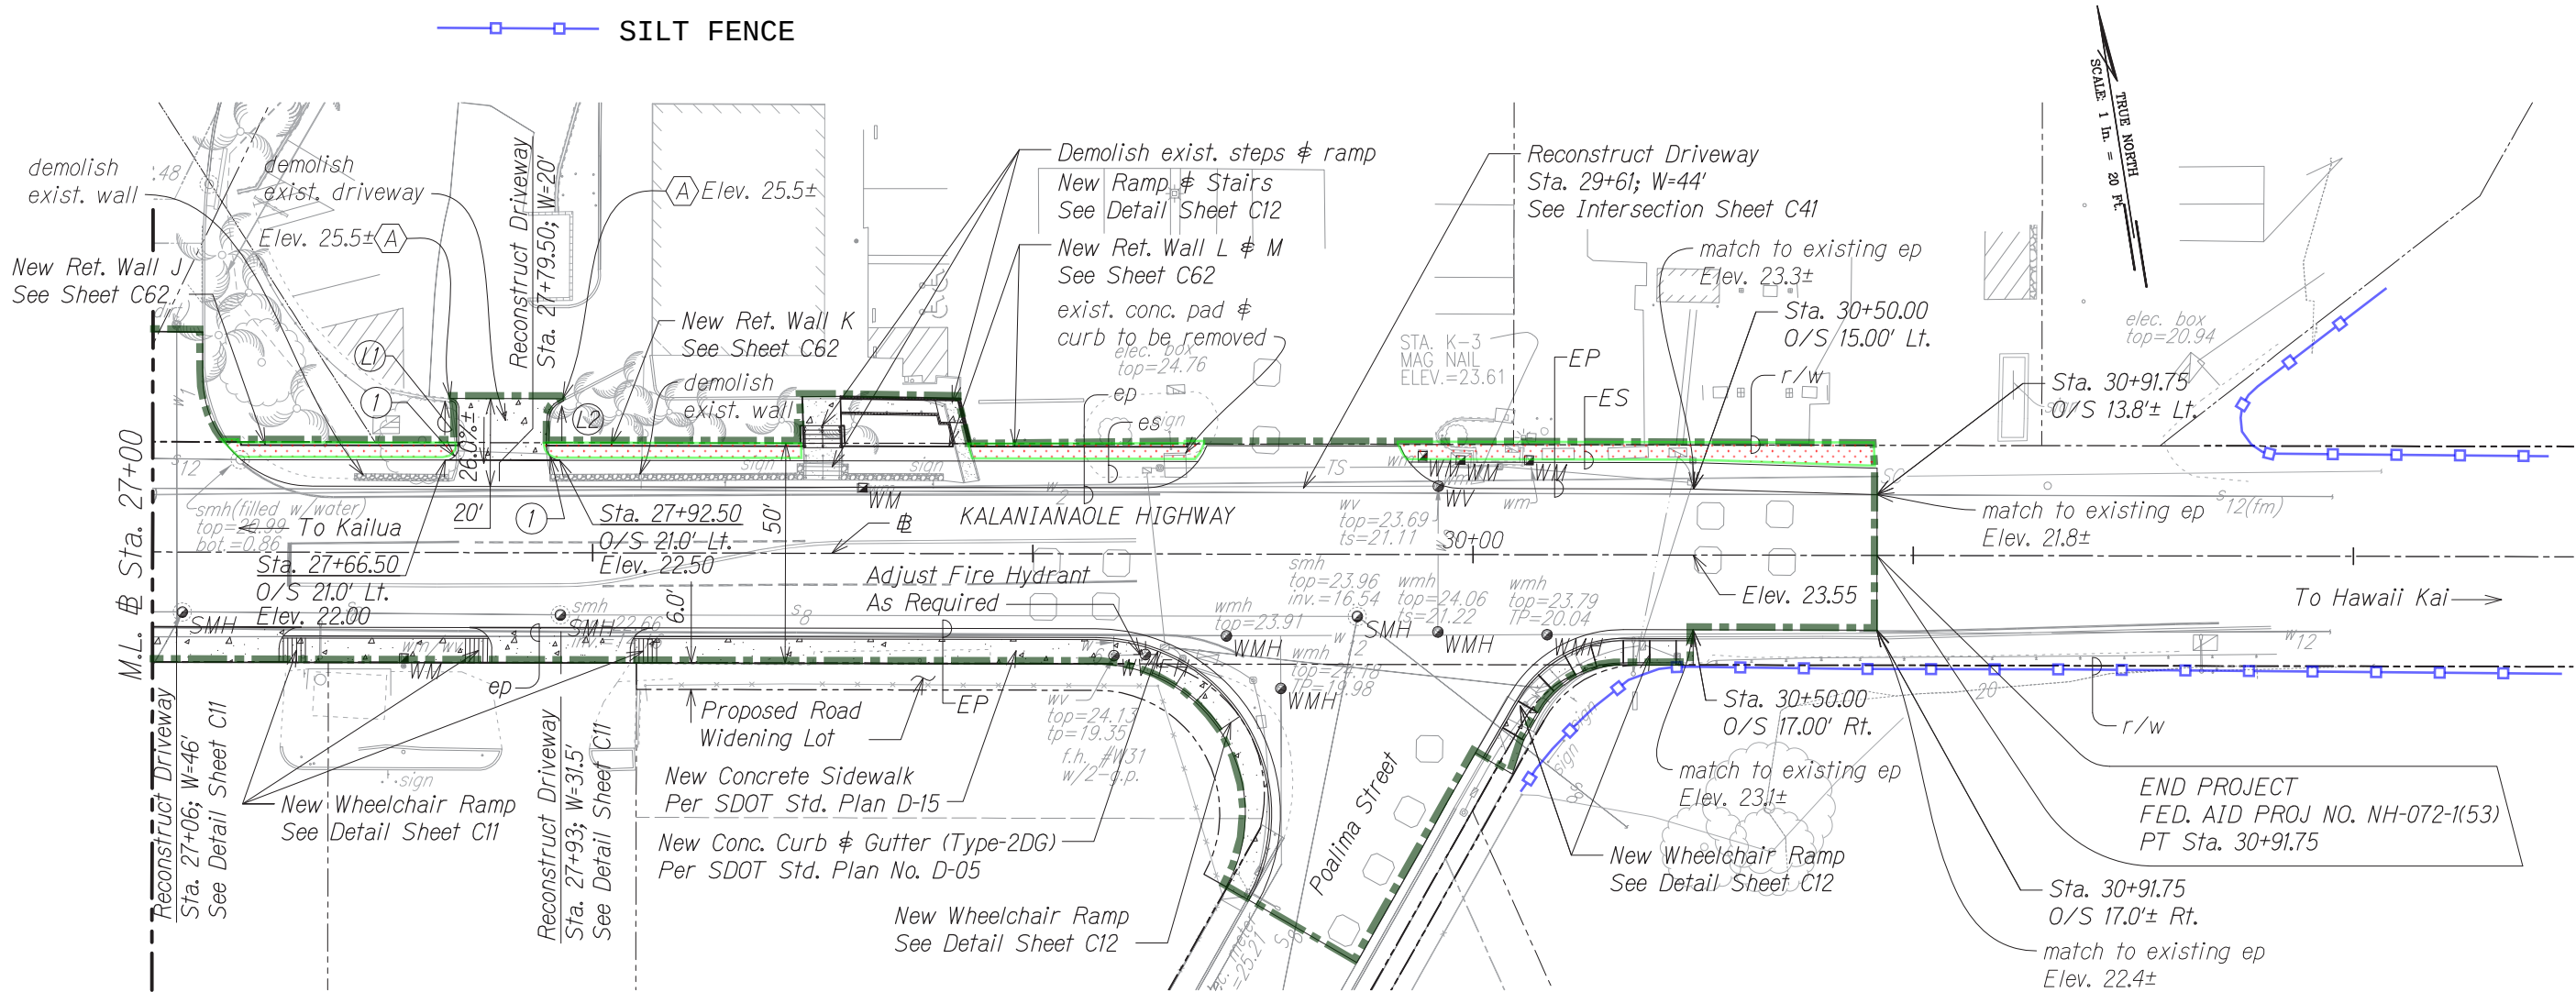

PLAN
SCALE: 1" = 20'

APPROVED:

MANAGER AND CHIEF ENGINEER, BWS
(For work affecting BWS Facilities in
State R/W and BWS Easements only)

DATE

BENCHMARK

Y-11 Brass Disk; Elevation=30.25
referred to The National Geodetic Survey Data Sheet

Azimuth and Coordinates referred to "Waimanalo Ridge"
Triangulation Station

CURVE DATA:

CURVE	①
Δ	90°00'00"
$\Delta/2$	45°00'00.0"
R	5.00'
Tan.	5.00'
C	7.07'
Lc	7.85'

LINE DATA:

LINE	①	②
Az	189°06'00"	189°06'00"
Distance	8.00'	5.09'

NOTE:

For Pavement Safety Edge Detail, see Sheet C30.

NOTE:

Ⓐ match to existing driveway

THIS WORK WAS PREPARED BY ME OR
UNDER MY SUPERVISION

SIGNATURE

EXPIRATION DATE
OF THE LICENSE

GRAPHICAL SCALE:



STATE OF HAWAII
DEPARTMENT OF TRANSPORTATION
HIGHWAYS DIVISION

ROADWAY PLAN

KALANIANAʻOLE HIGHWAY IMPROVEMENTS, PHASE 1
Olomana Golf Course To Poalima Street
Federal Aid Project No. NH-072-1(53)

Scale: AS NOTED Date: MAR, 2013

SHEET No. C28 OF 69 SHEETS