




FED. ROAD DIST. NO.	STATE	FED. AID PROJ. NO.	FISCAL YEAR	SHEET NO.	TOTAL SHEETS
HAWAII	HAW.	NH-072-1(53)	2015	53	117

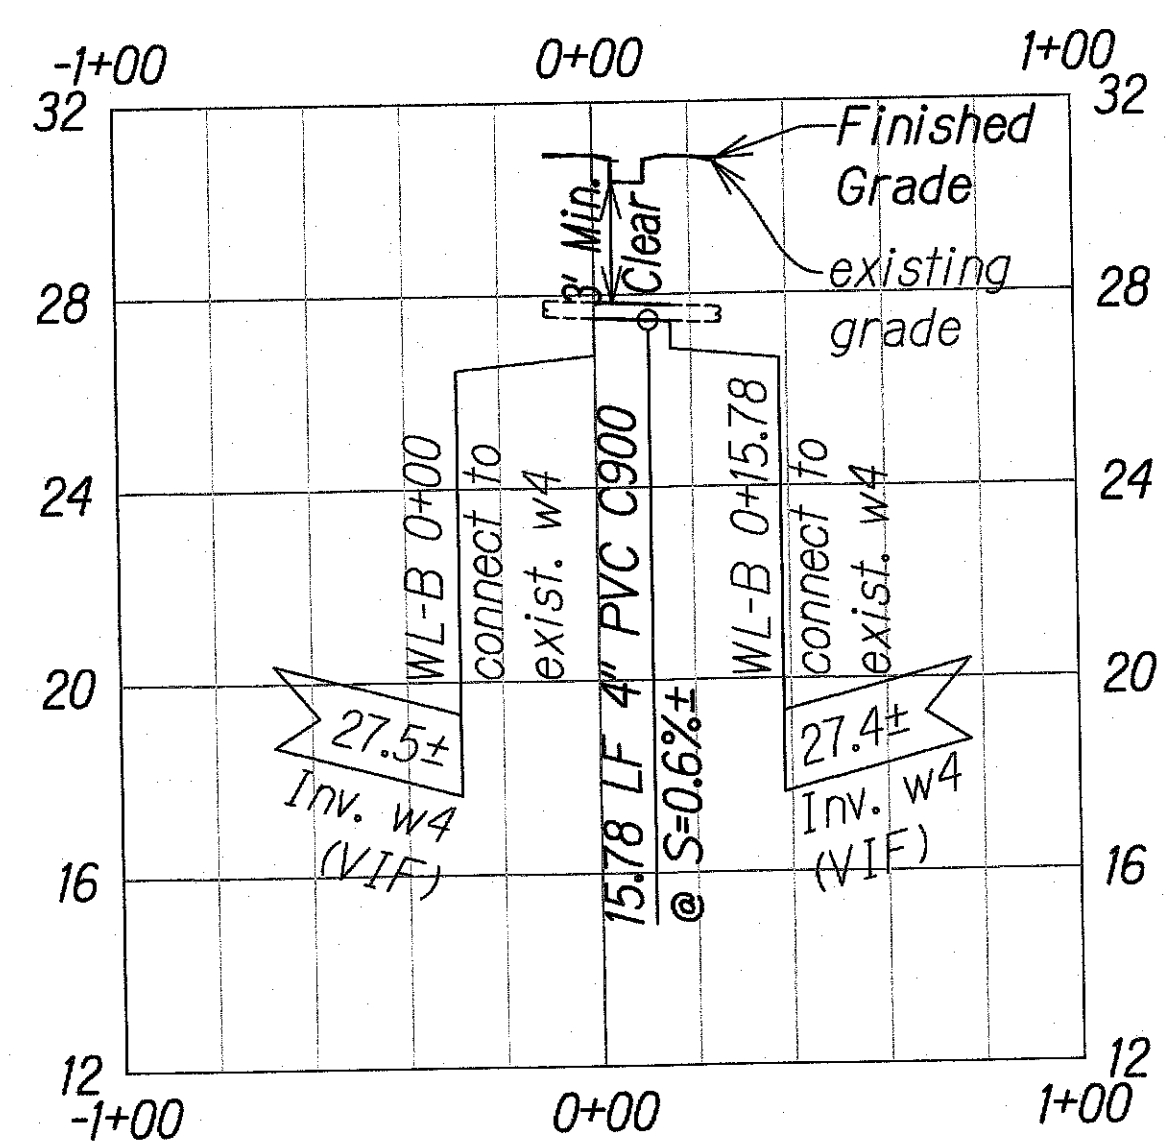

Water Line "B"
Scale: Horiz. 1" = 40'
Vert. 1" = 4'

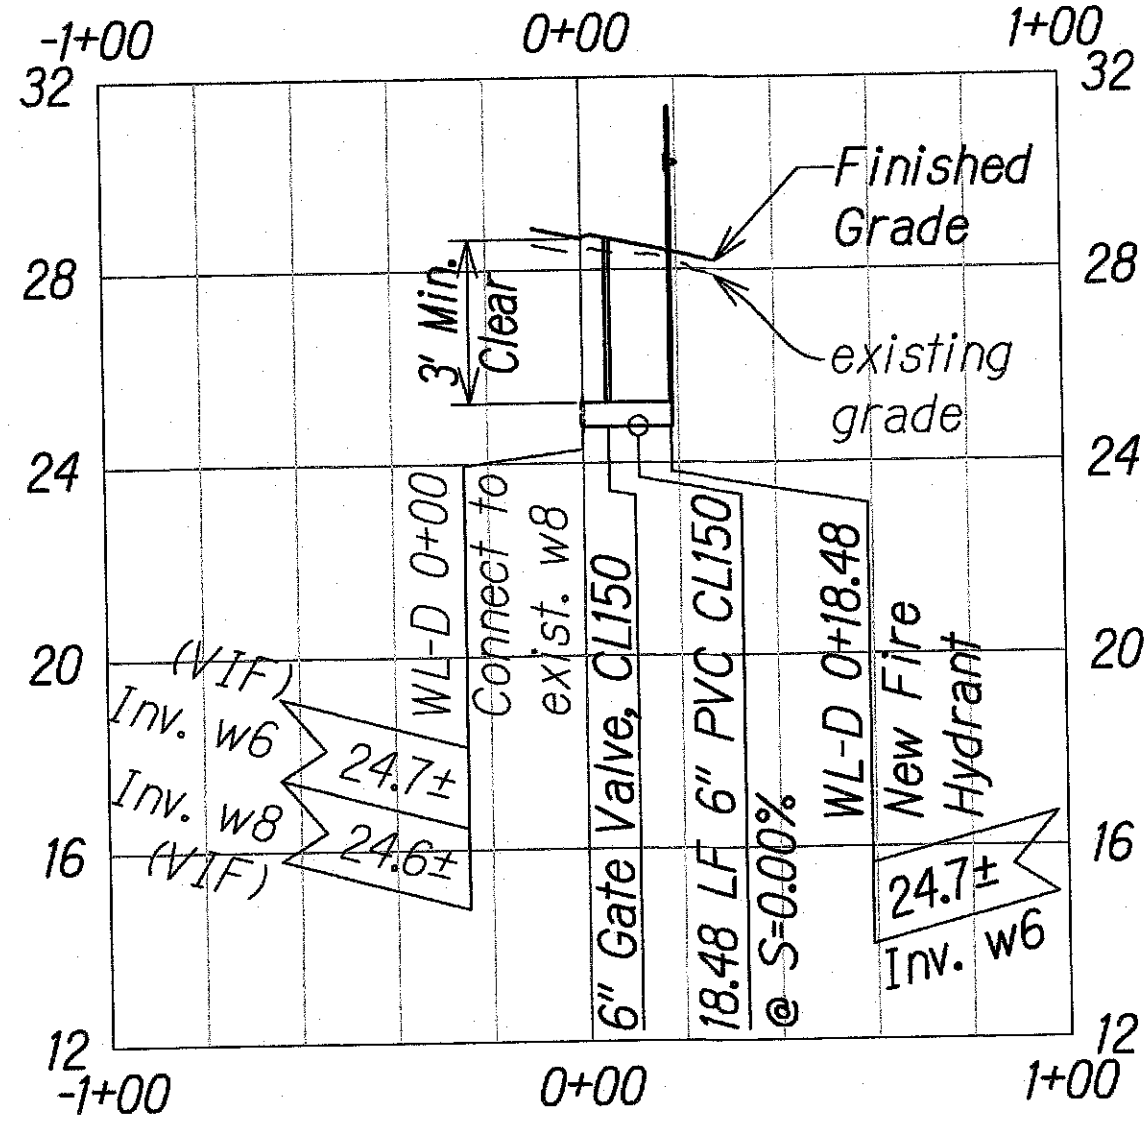

Water Line "D"
Scale: Horiz. 1" = 40'
Vert. 1" = 4'

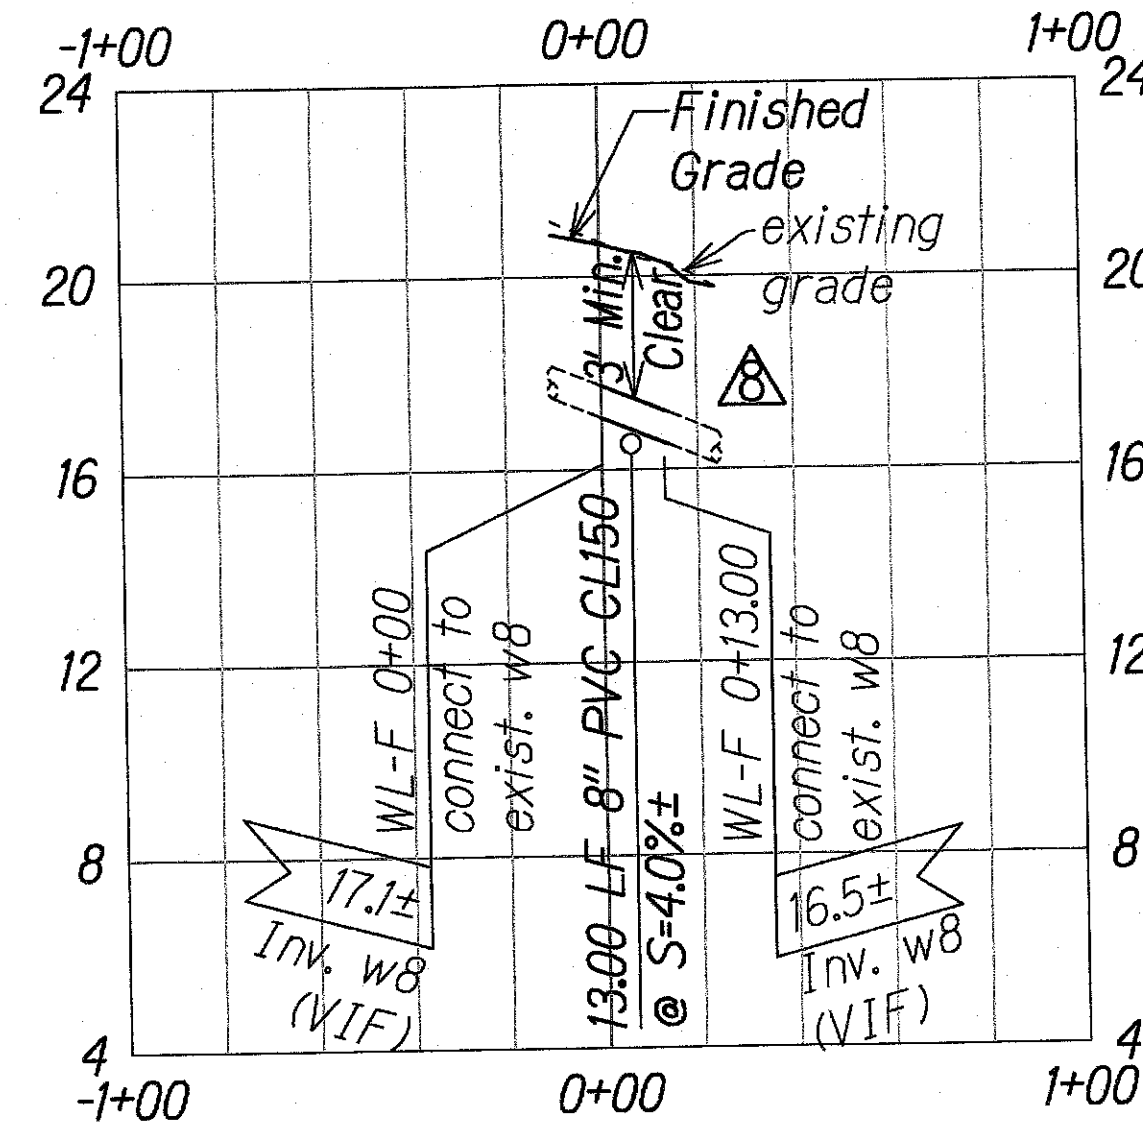


Water Line "F"
Scale: Horiz. 1" = 40'
Vert. 1" = 4'


APPROVED:

MANAGER AND CHIEF ENGINEER, BWS
(For work affecting BWS Facilities in
State R/W and BWS Easements only)


DATE

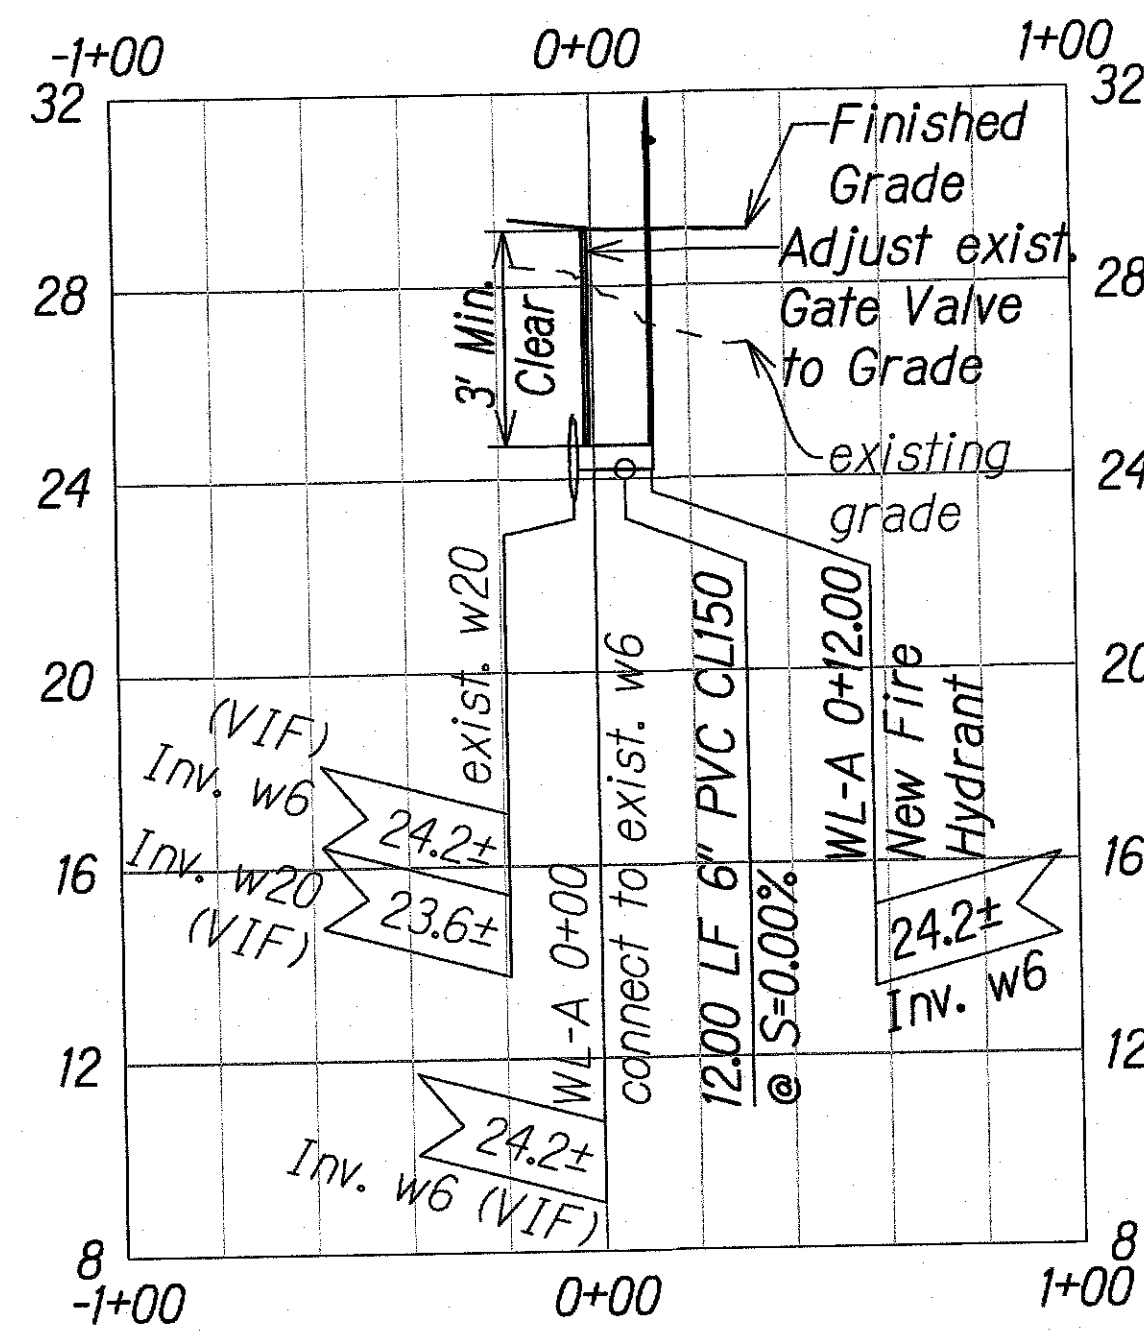

Water Line "A"
Scale: Horiz. 1" = 40'
Vert. 1" = 4'

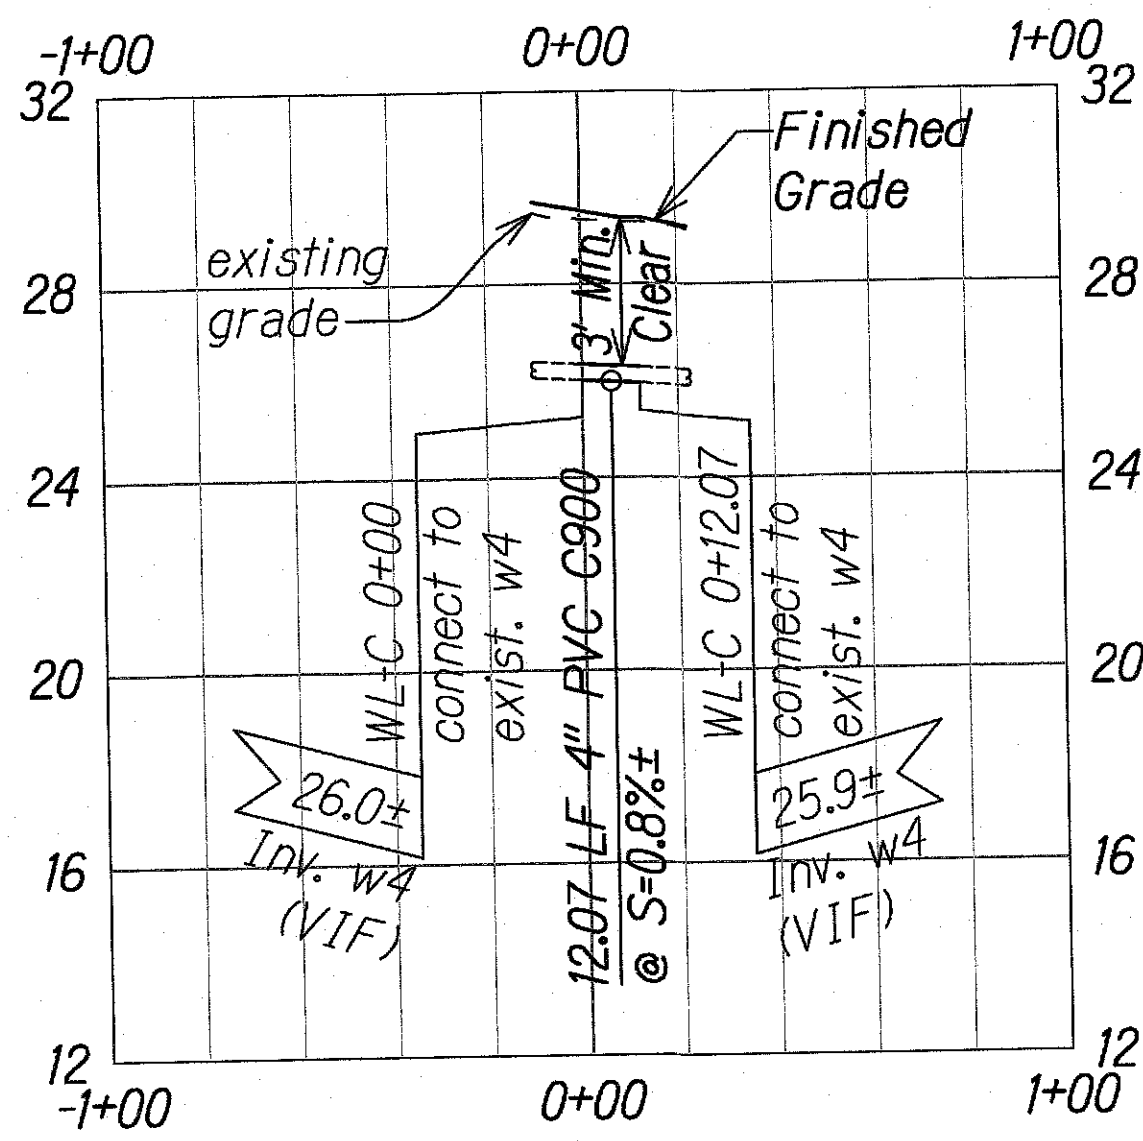

Water Line "C"
Scale: Horiz. 1" = 40'
Vert. 1" = 4'

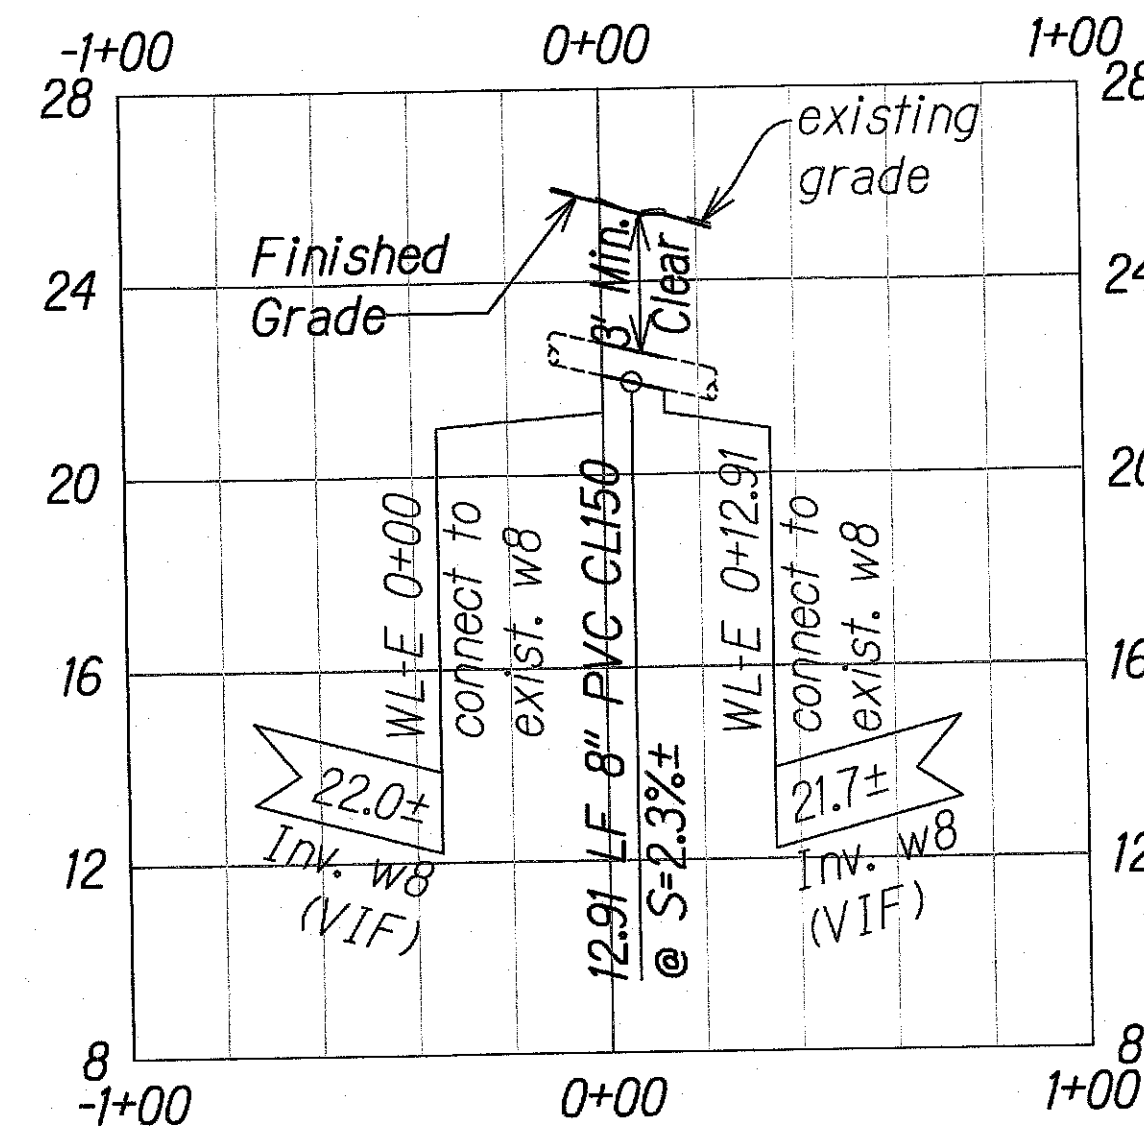


Water Line "E"
Scale: Horiz. 1" = 40'
Vert. 1" = 4'

NOTE:

For Water Line Layout, See Roadway Plan
Sheets C34 to C38.

GRAPHICAL SCALES:

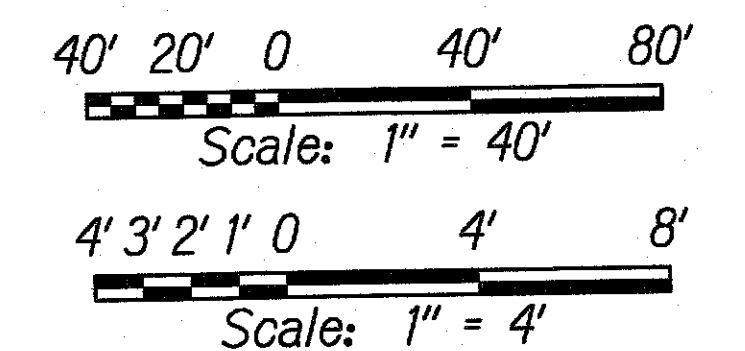

02/28/17 Relocated Street Light
Pole (P59)

DATE REVISION

STATE OF HAWAII
DEPARTMENT OF TRANSPORTATION
HIGHWAYS DIVISION

WATER LINE PROFILES

KALANIANA'OLE HIGHWAY IMPROVEMENTS, PHASE 1
Olomana Golf Course To Vicinity of Poalima St.
Federal Aid Project No. NH-072-1(53)

Scale: AS NOTED Date: March, 2019

SHEET No. C53 OF 73 SHEETS

"AS-BUILT"

ORIGINAL PLAN	DATE
SURVEY PLOTTED BY	
DRAWN BY	
CHECKED BY	
NOTED BY	
NO.	