




FED. ROAD DIST. NO.	STATE	FED-AID PROJ. NO.	FISCAL YEAR	SHEET NO.	TOTAL SHEETS
HAWAII	HAW.	NH-072-1(059)	2021	CO. ADD. 134	243

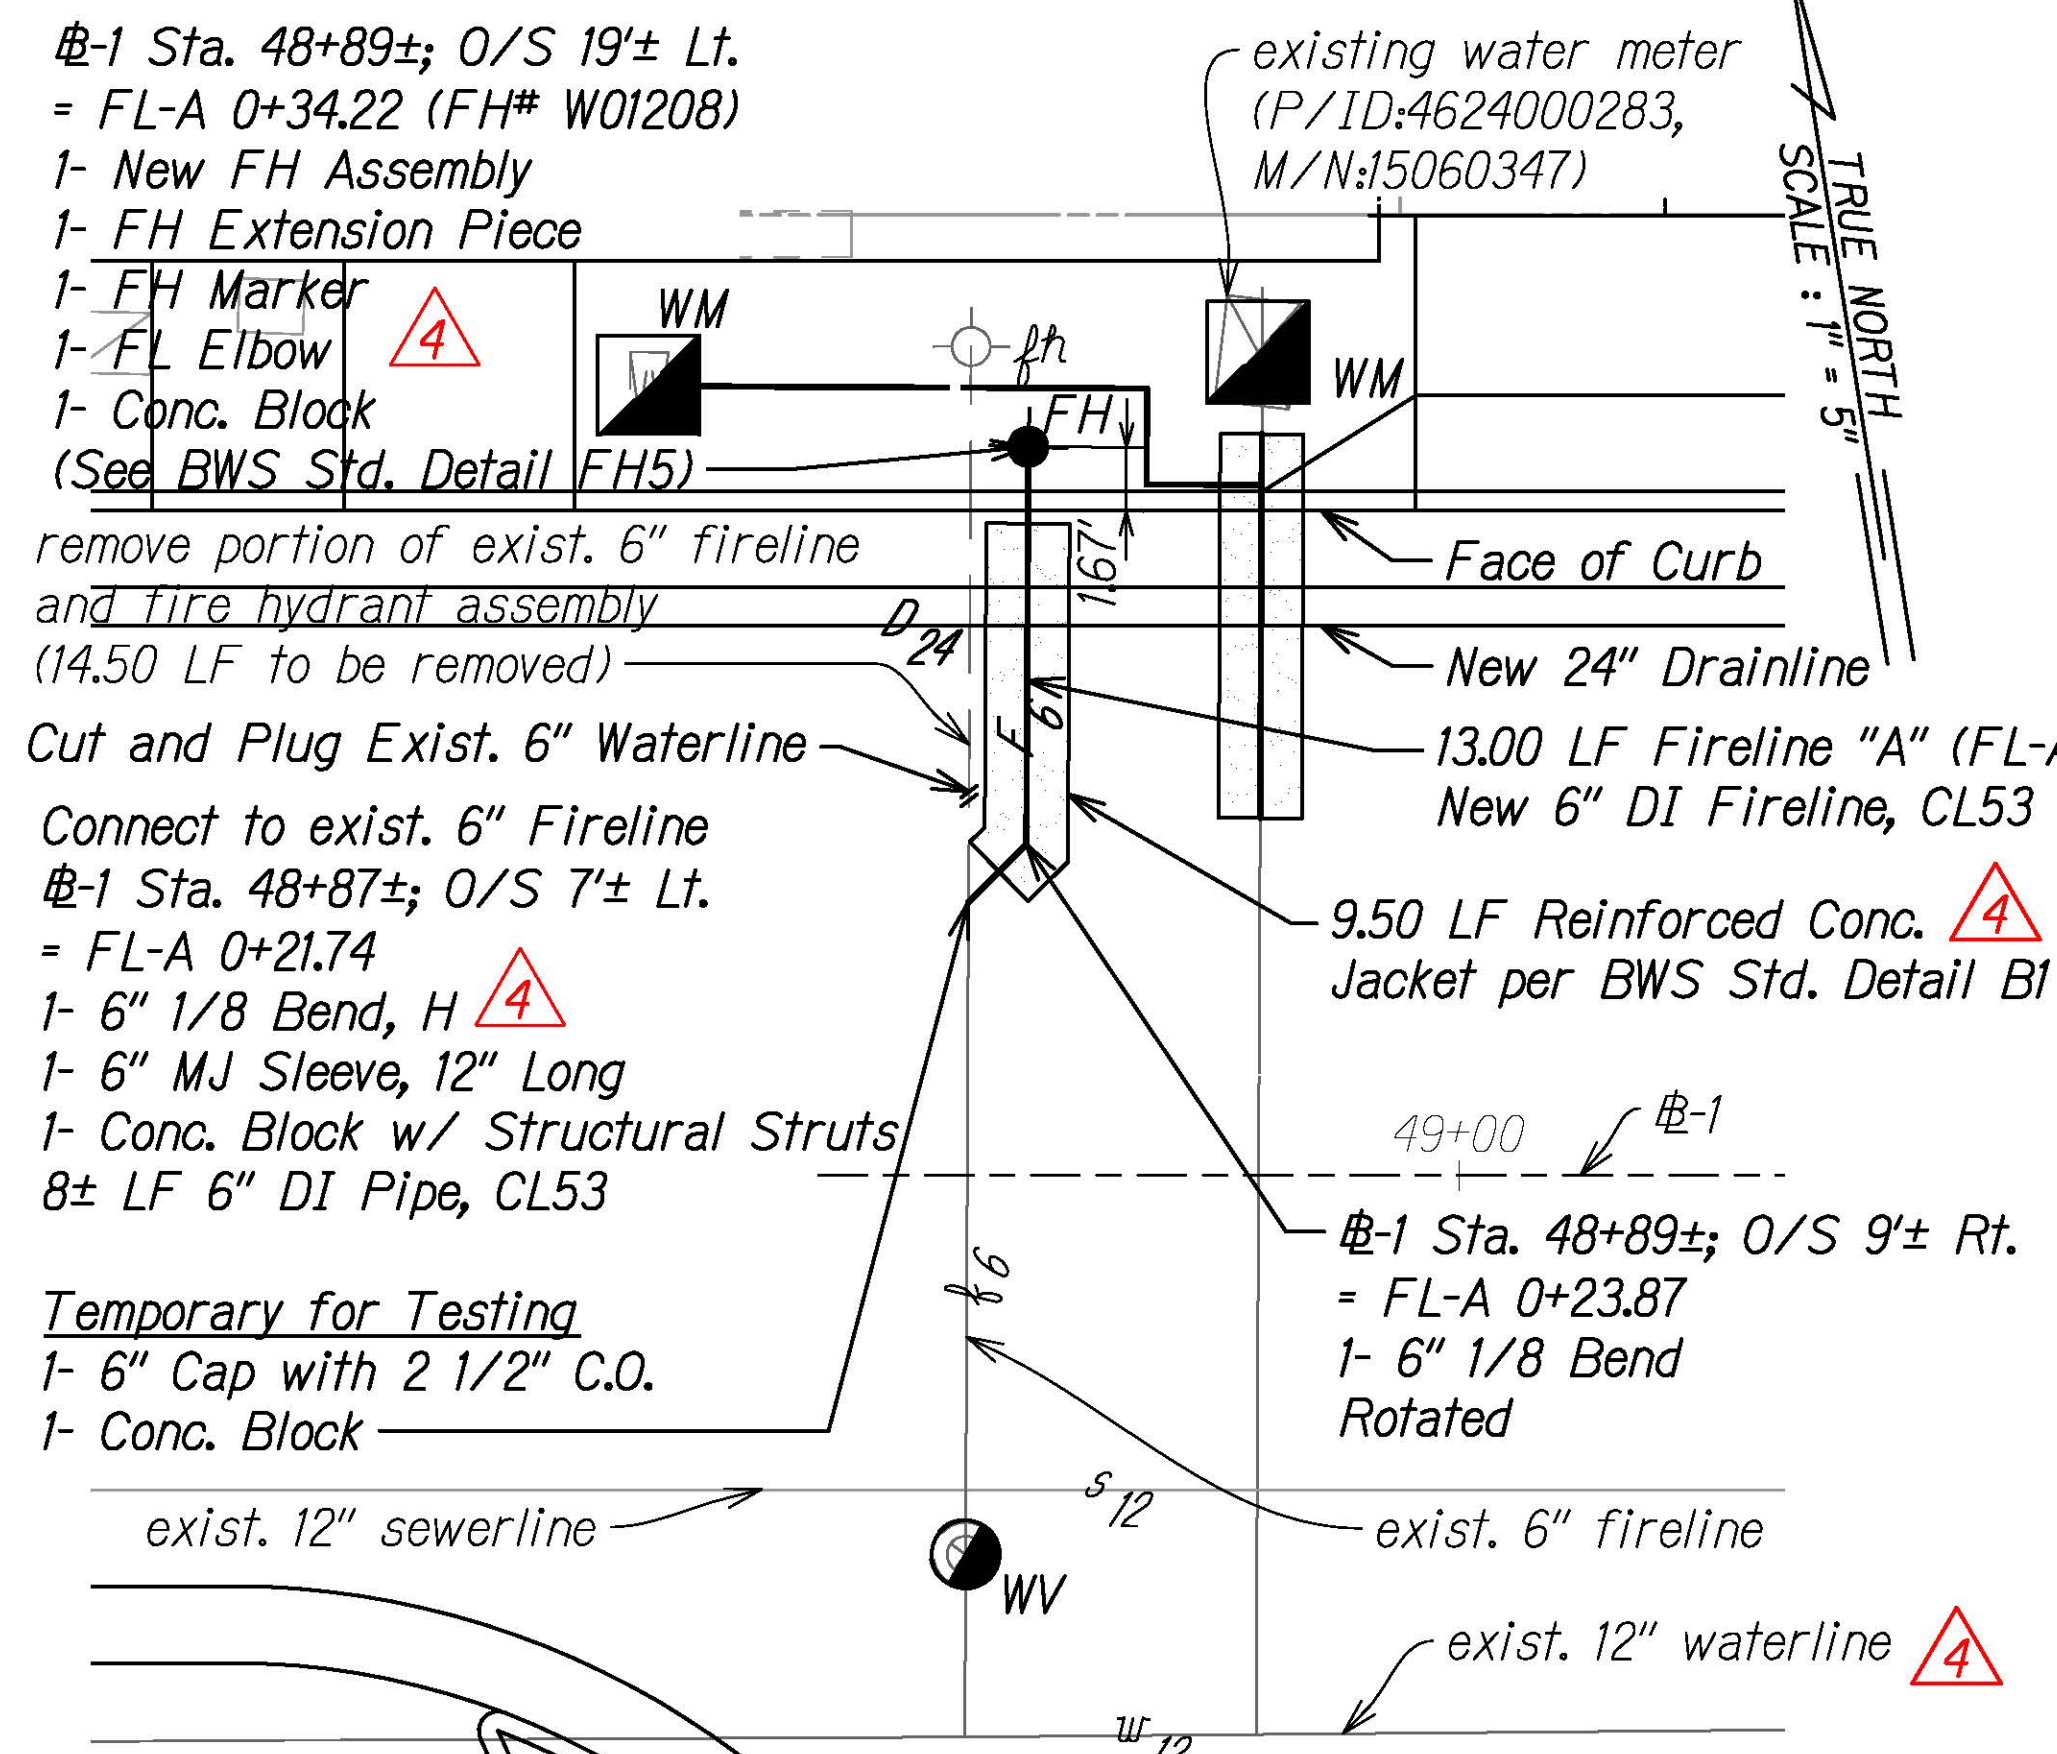


PLAN - FIRELINE "A"

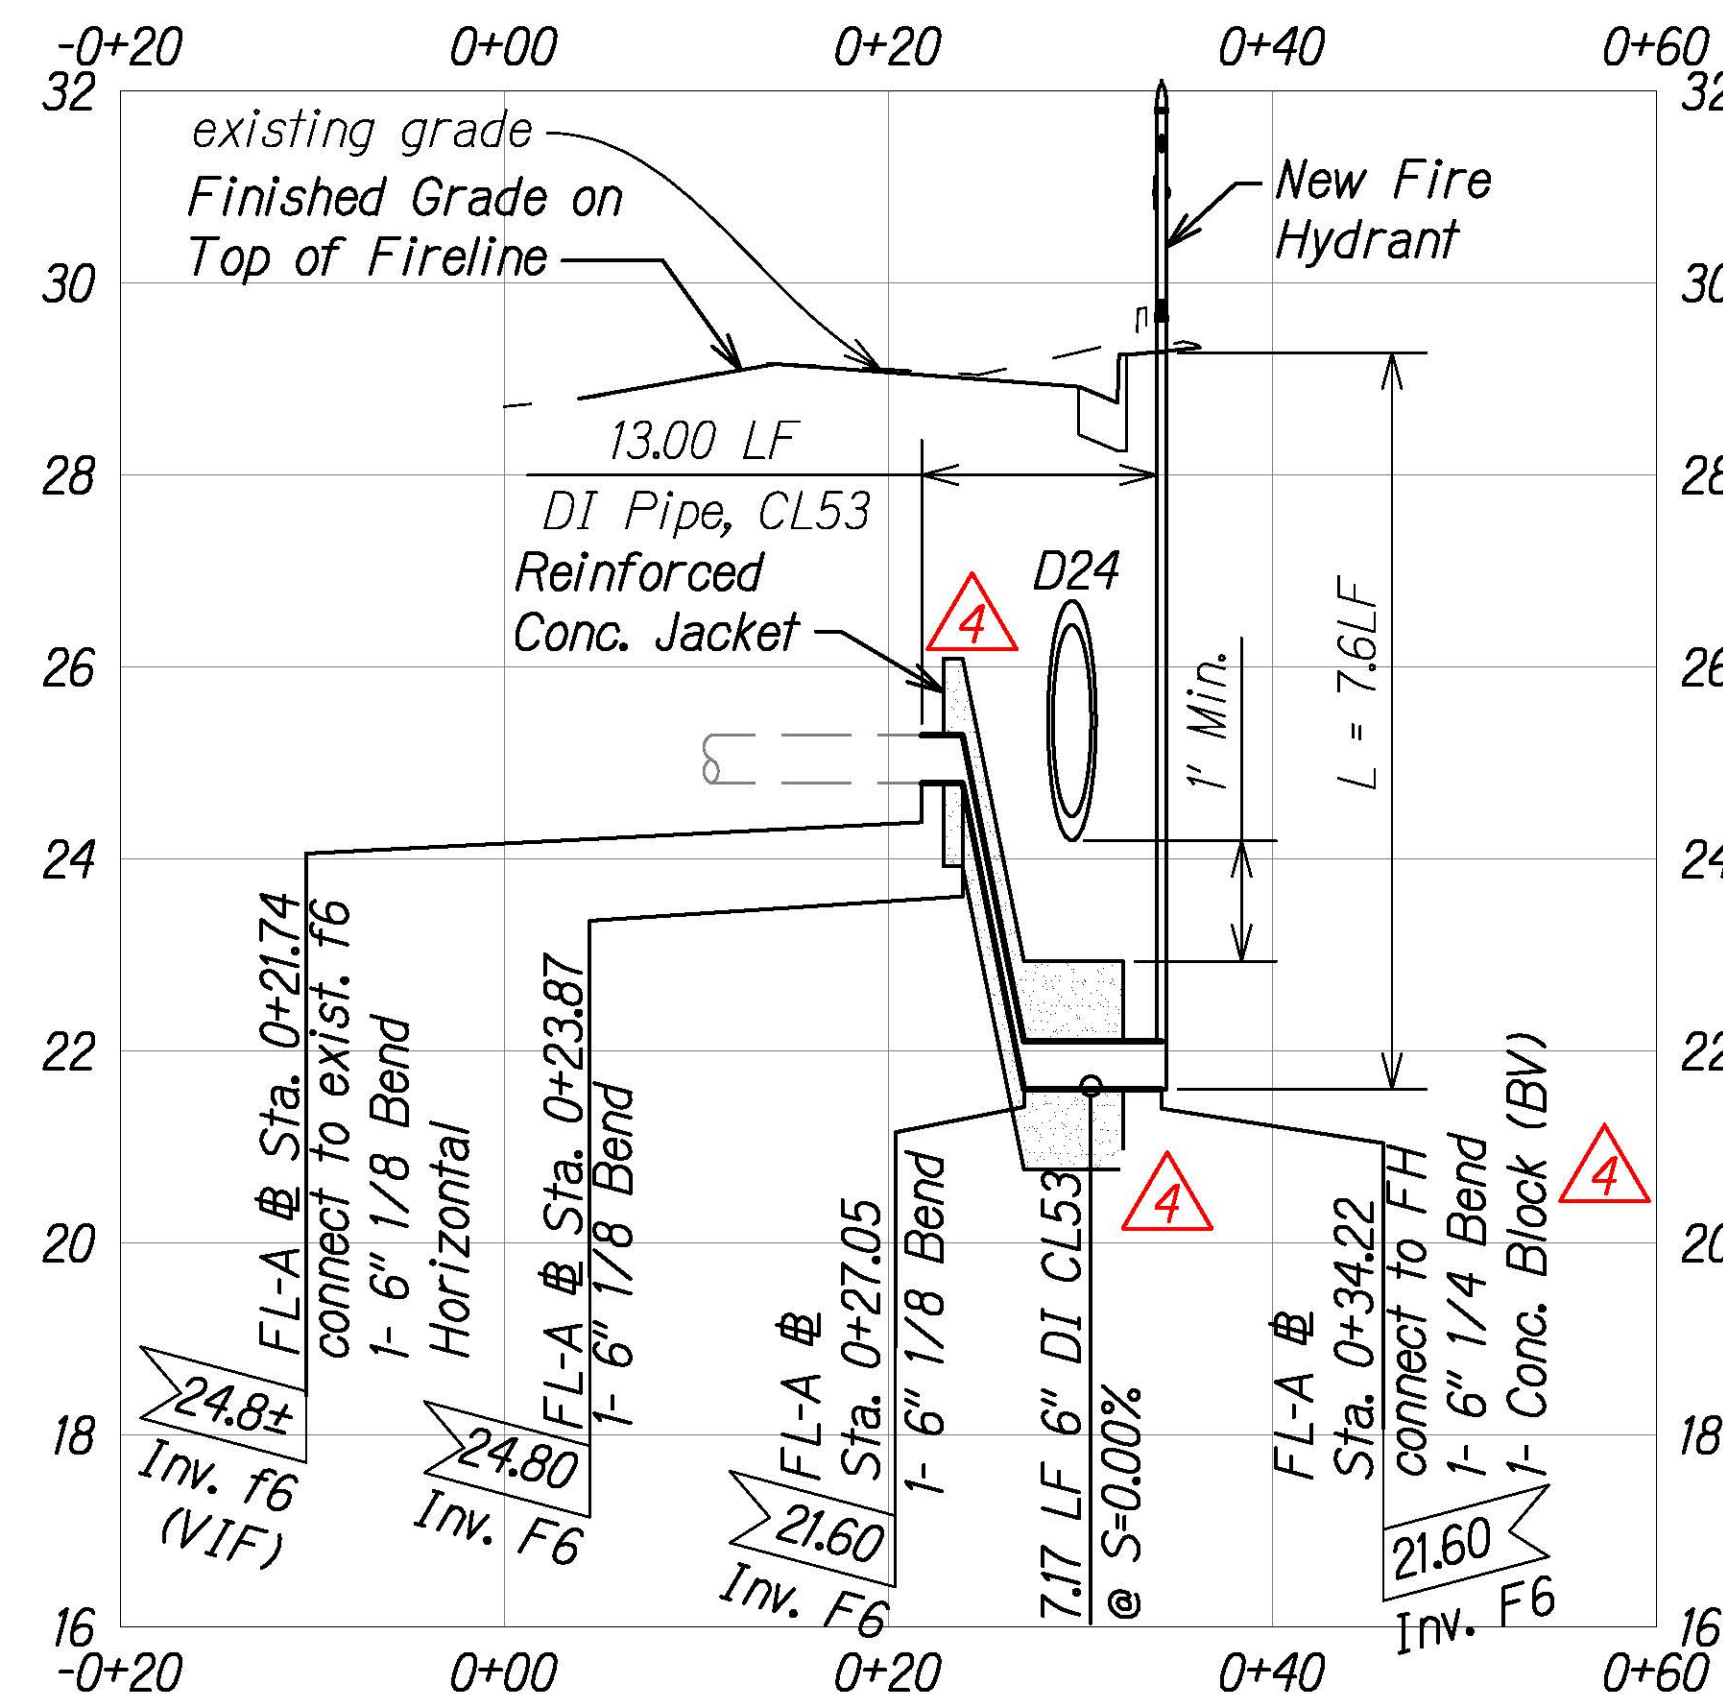

PROFILE - FIRELINE "A"

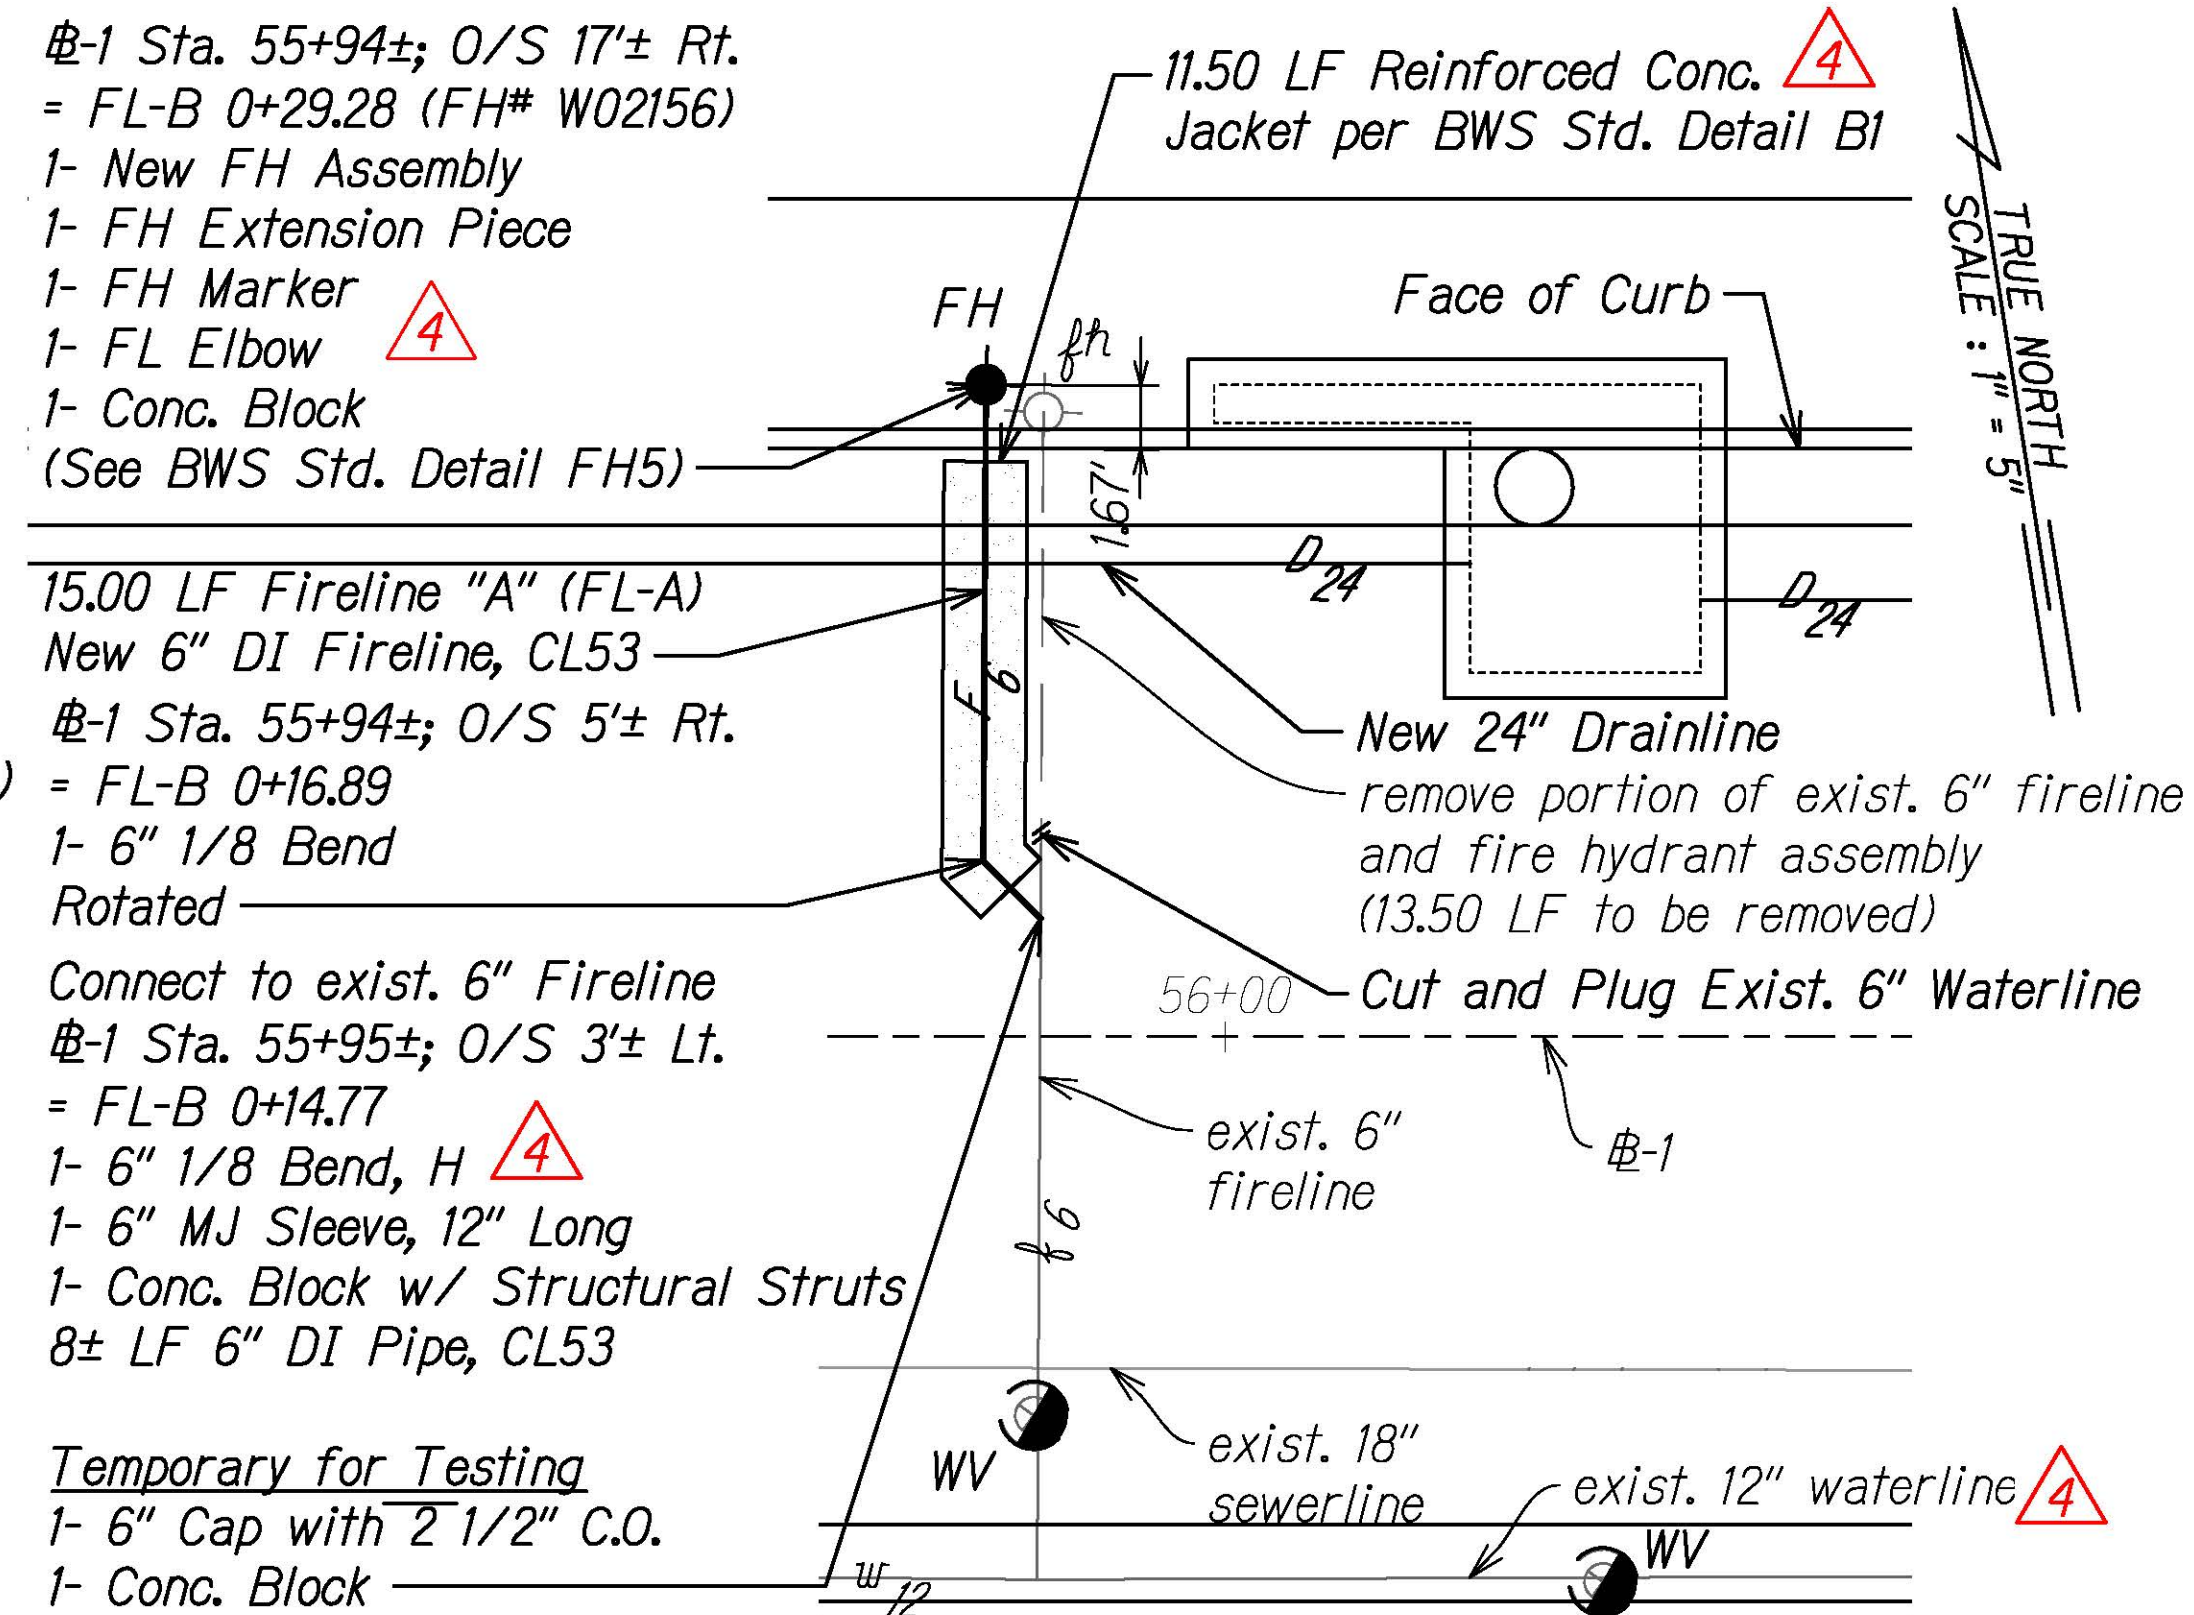

PLAN - FIRELINE "B"

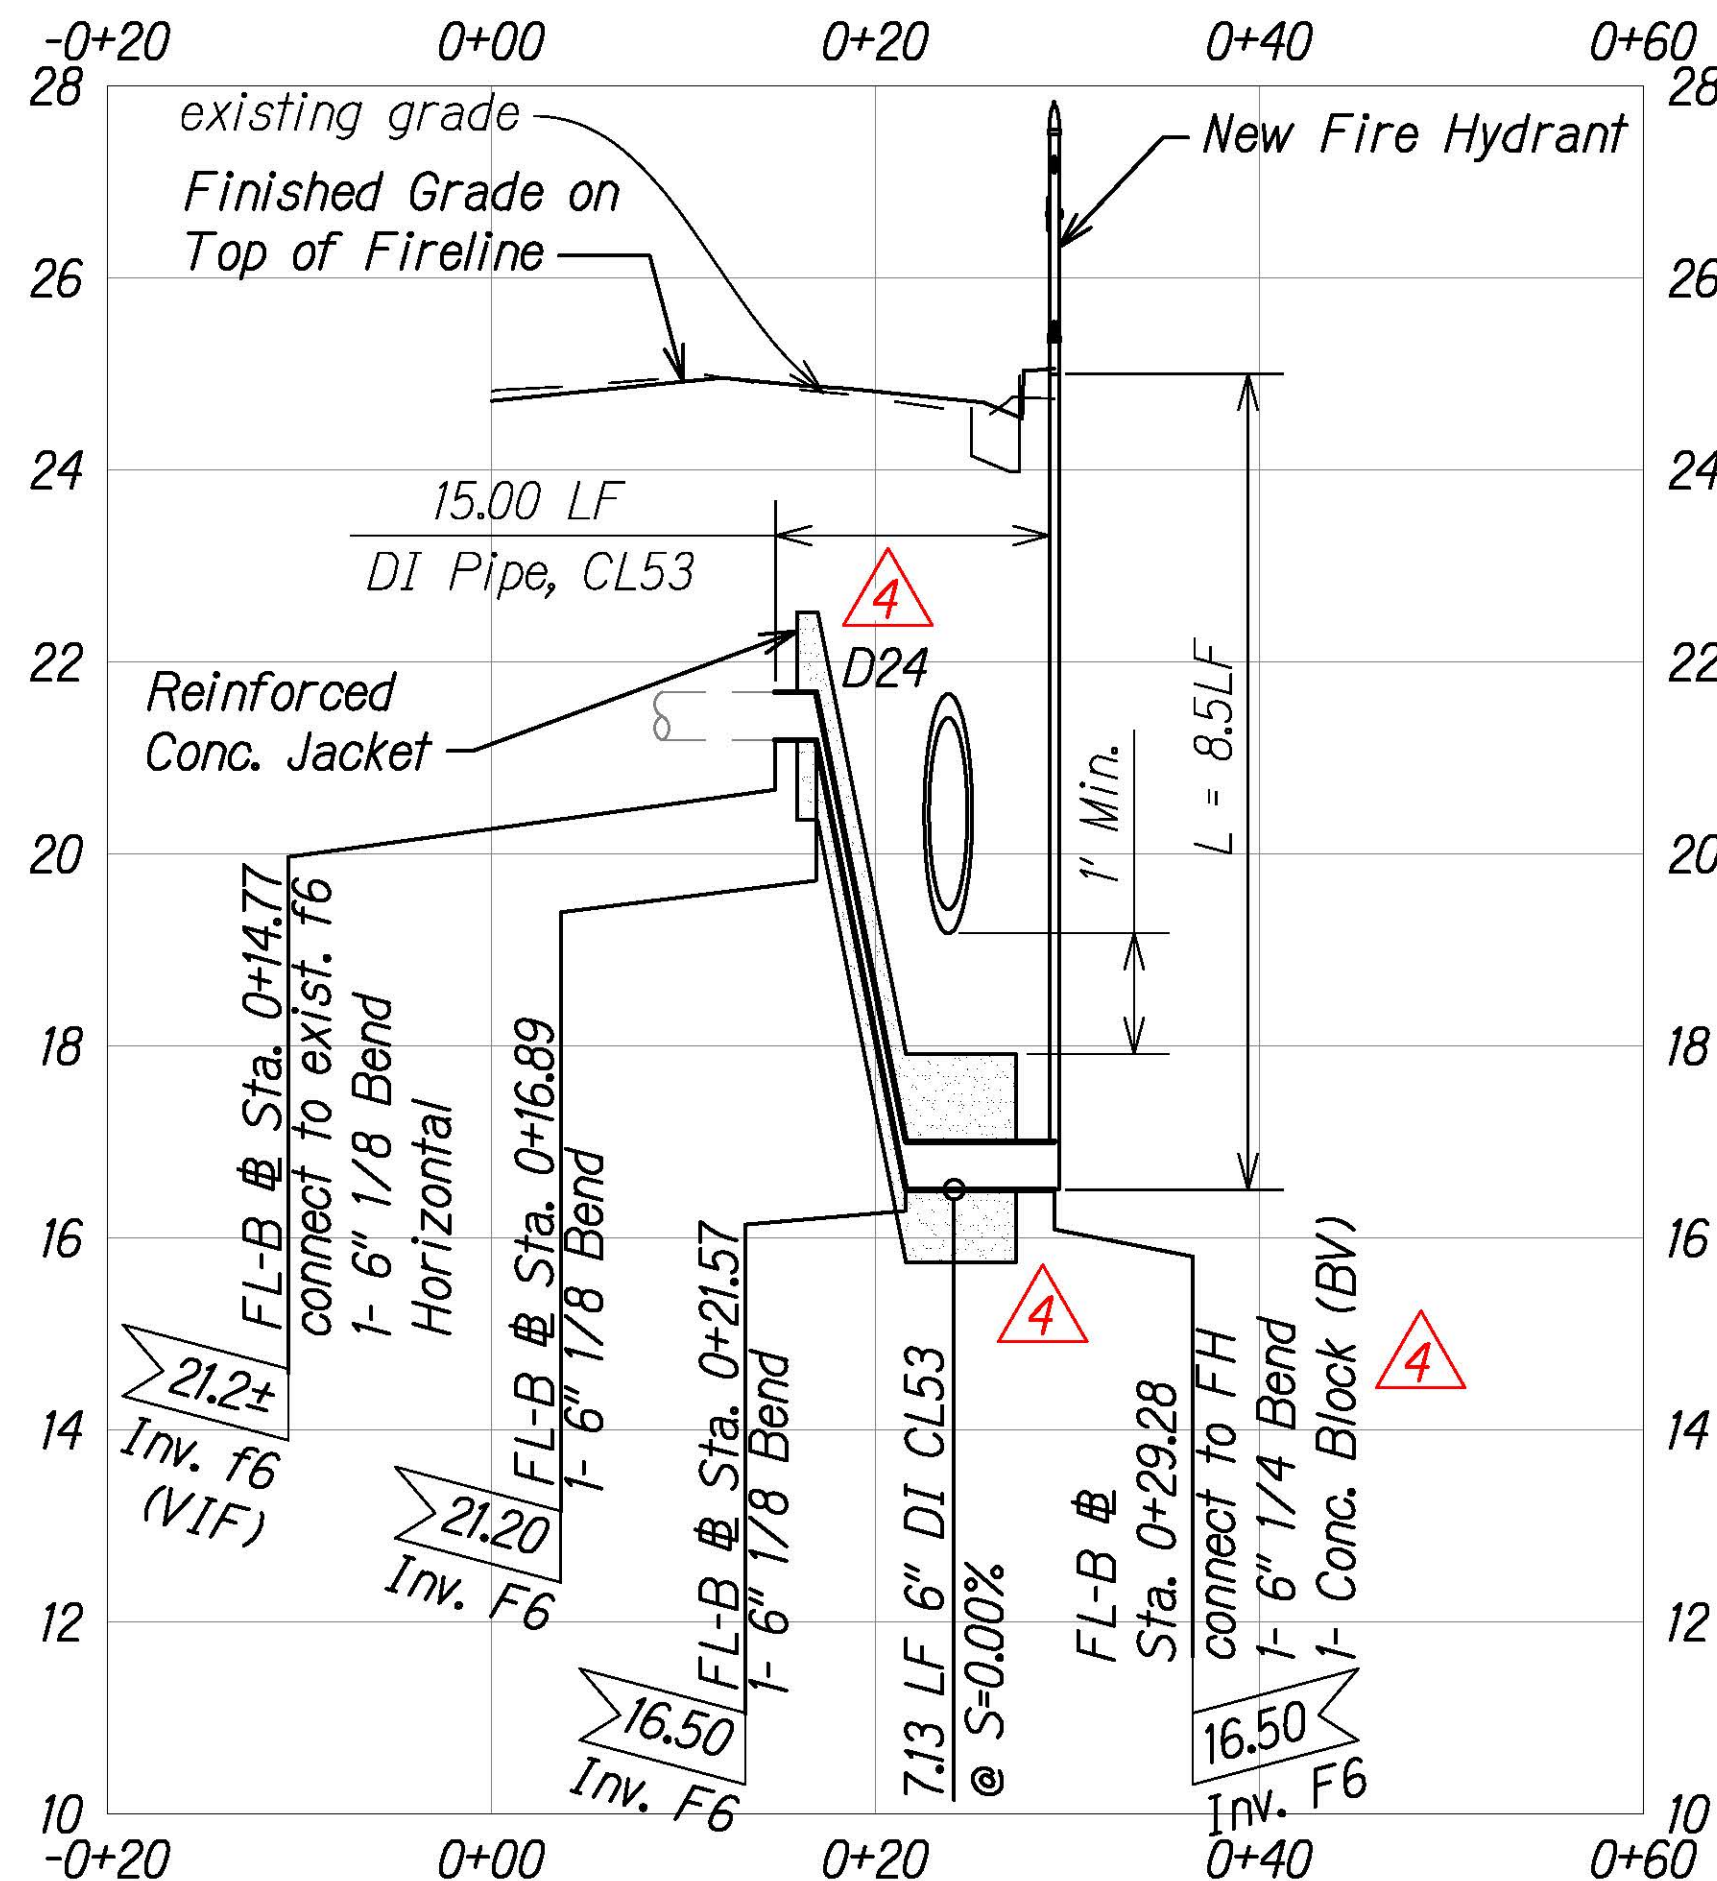





PROFILE - FIRELINE "B"

APPROVED:

MANAGER AND CHIEF ENGINEER, BWS
(For work affecting BWS Facilities in City/State R/W and BWS Easements only)

DATE

GRAPHICAL SCALES:

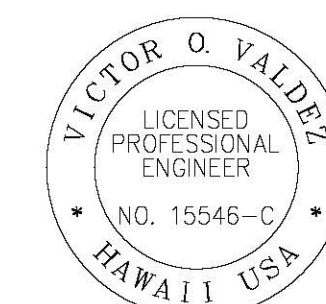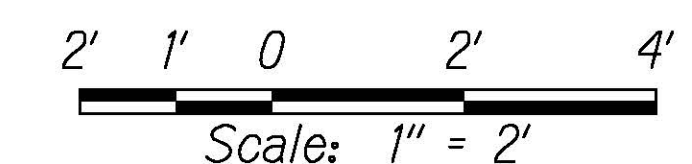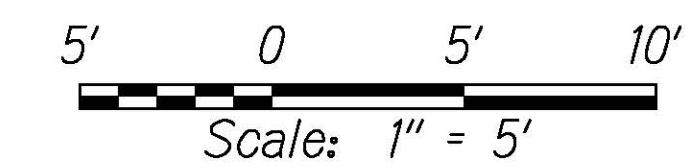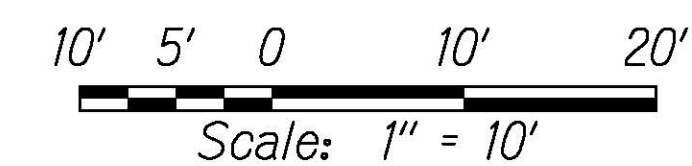

THIS WORK WAS PREPARED BY ME OR UNDER MY SUPERVISION

SIGNATURE

04/30/22
EXPIRATION DATE OF THE LICENSE

4/16/21	Updated Label, and Length of RCJ - BWS Comments 4/12/21
3/26/21	Revised Waterline "A" and Fireline "B" Alignment
DATE	REVISION
STATE OF HAWAII DEPARTMENT OF TRANSPORTATION HIGHWAYS DIVISION	
FIRELINE PLAN AND PROFILE	
KALANIANA'OLE HIGHWAY IMPROVEMENTS PHASE 2	
Poalima Street to Vicinity of Makai Pier	
Federal-Aid Project No. NH-072-1(059)	
Scale: As Shown	Date: March 2021
SHEET No. R51 OF 66 SHEETS	