

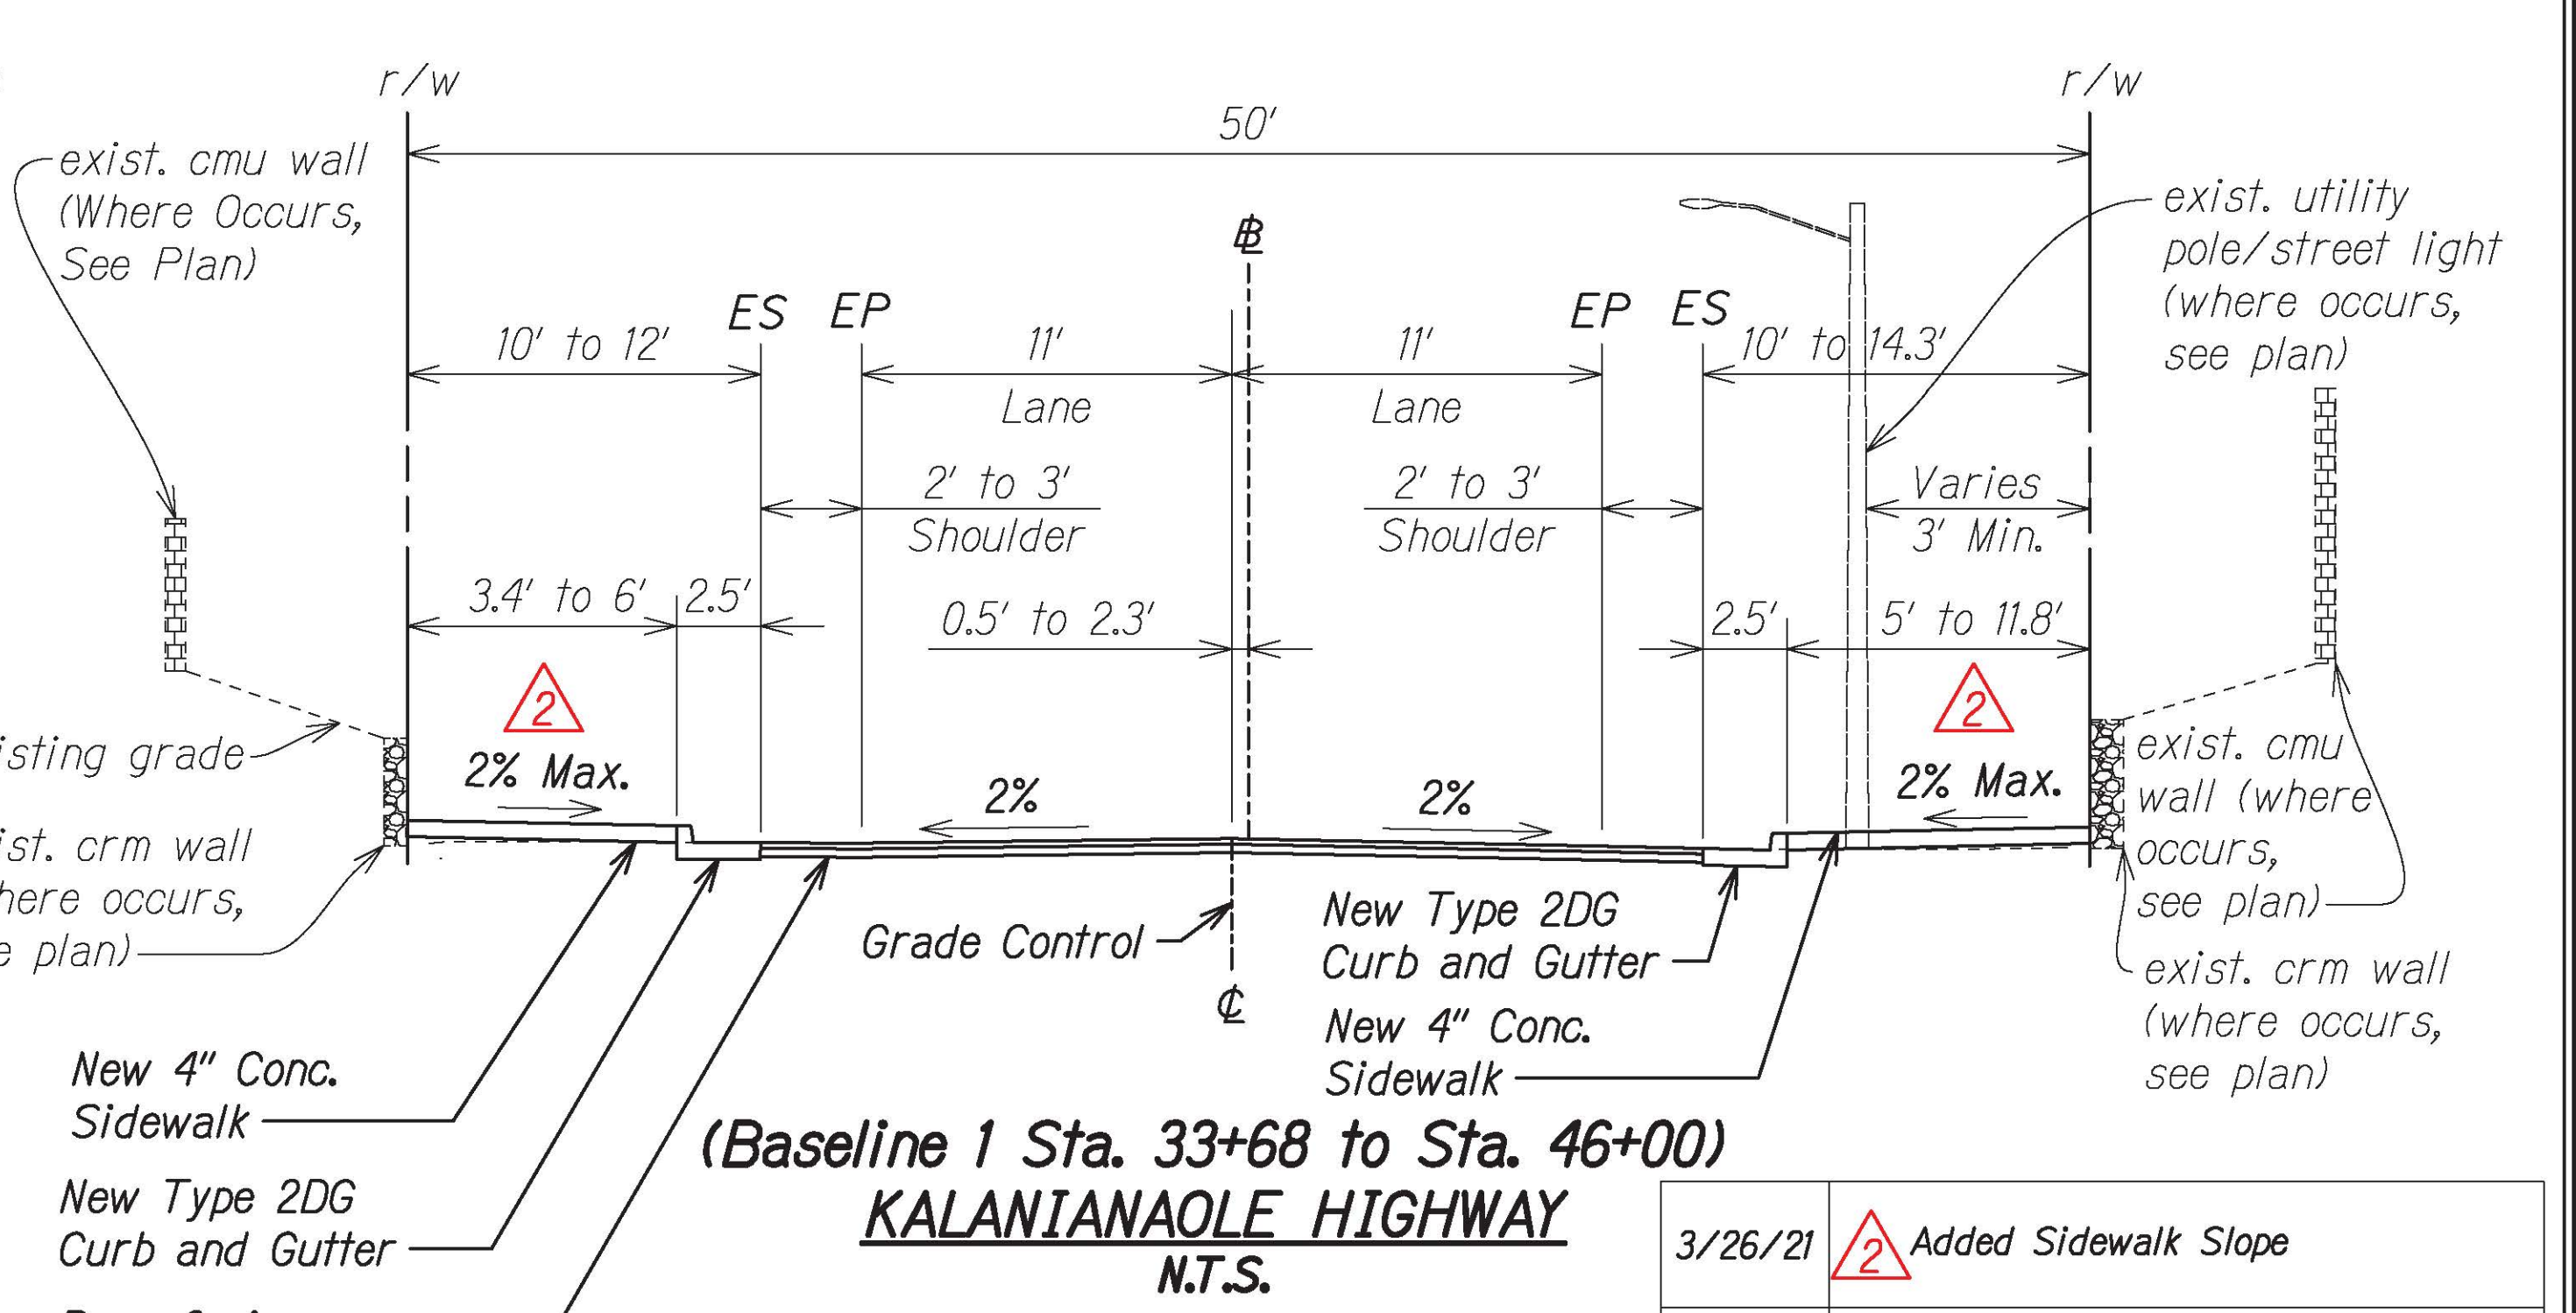
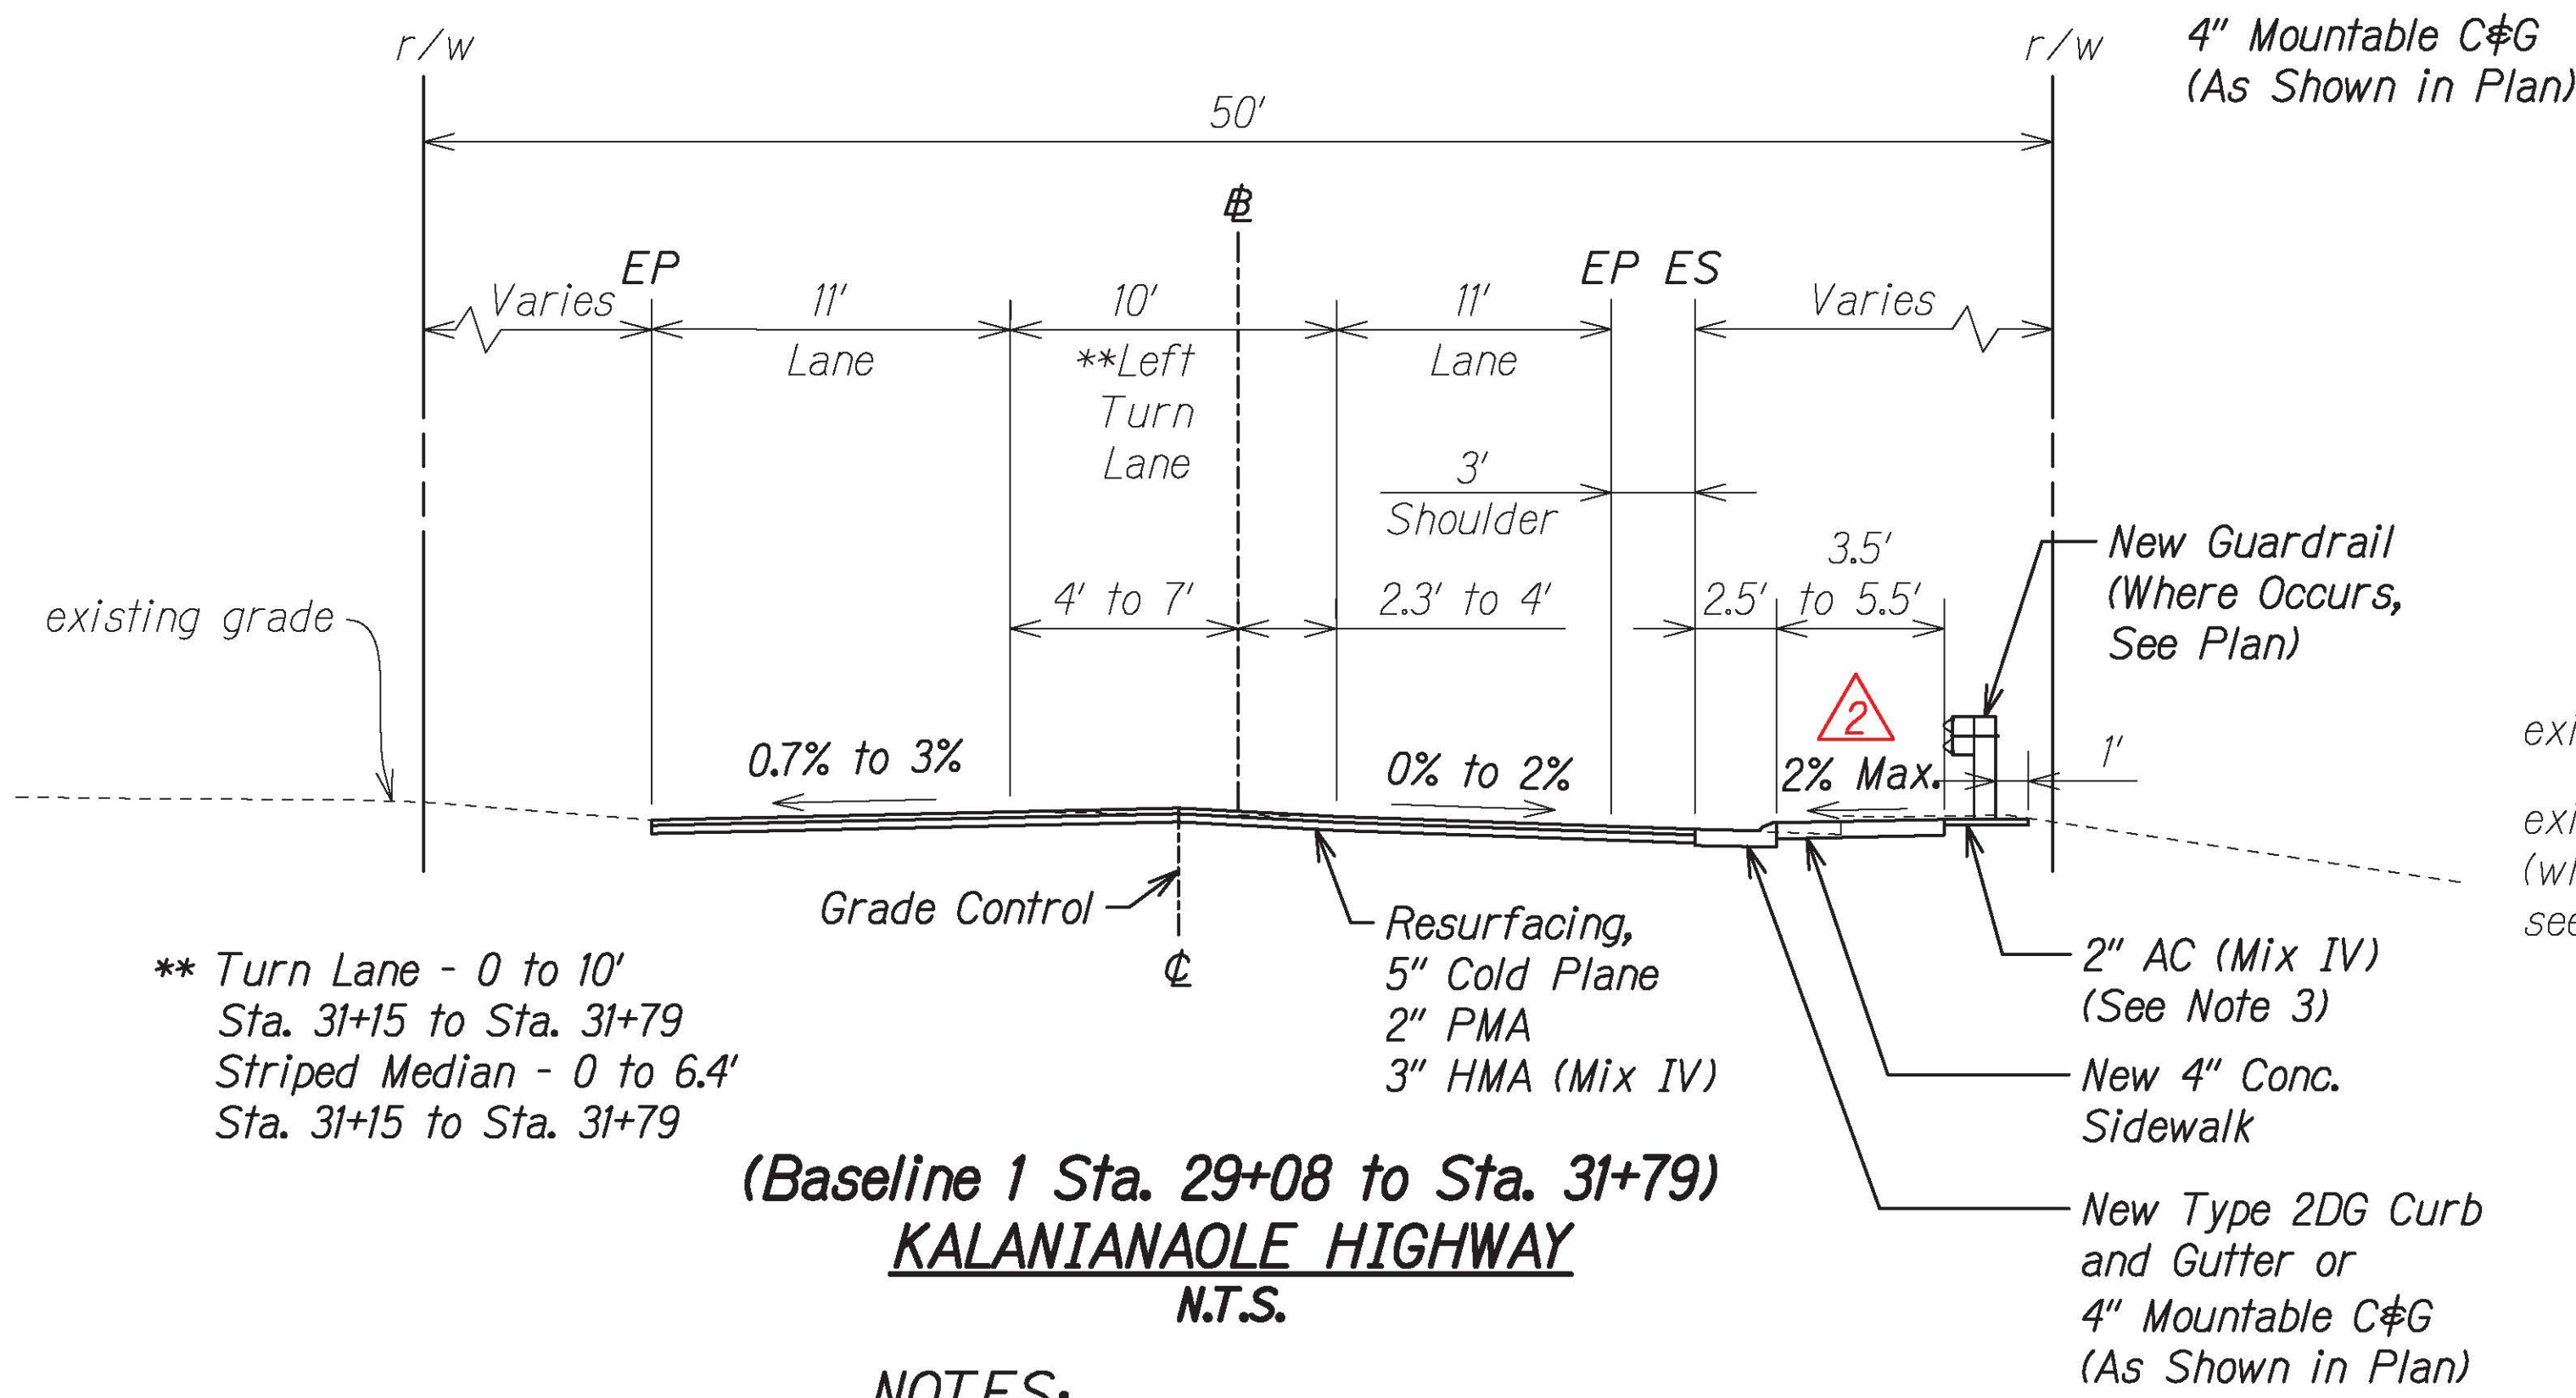
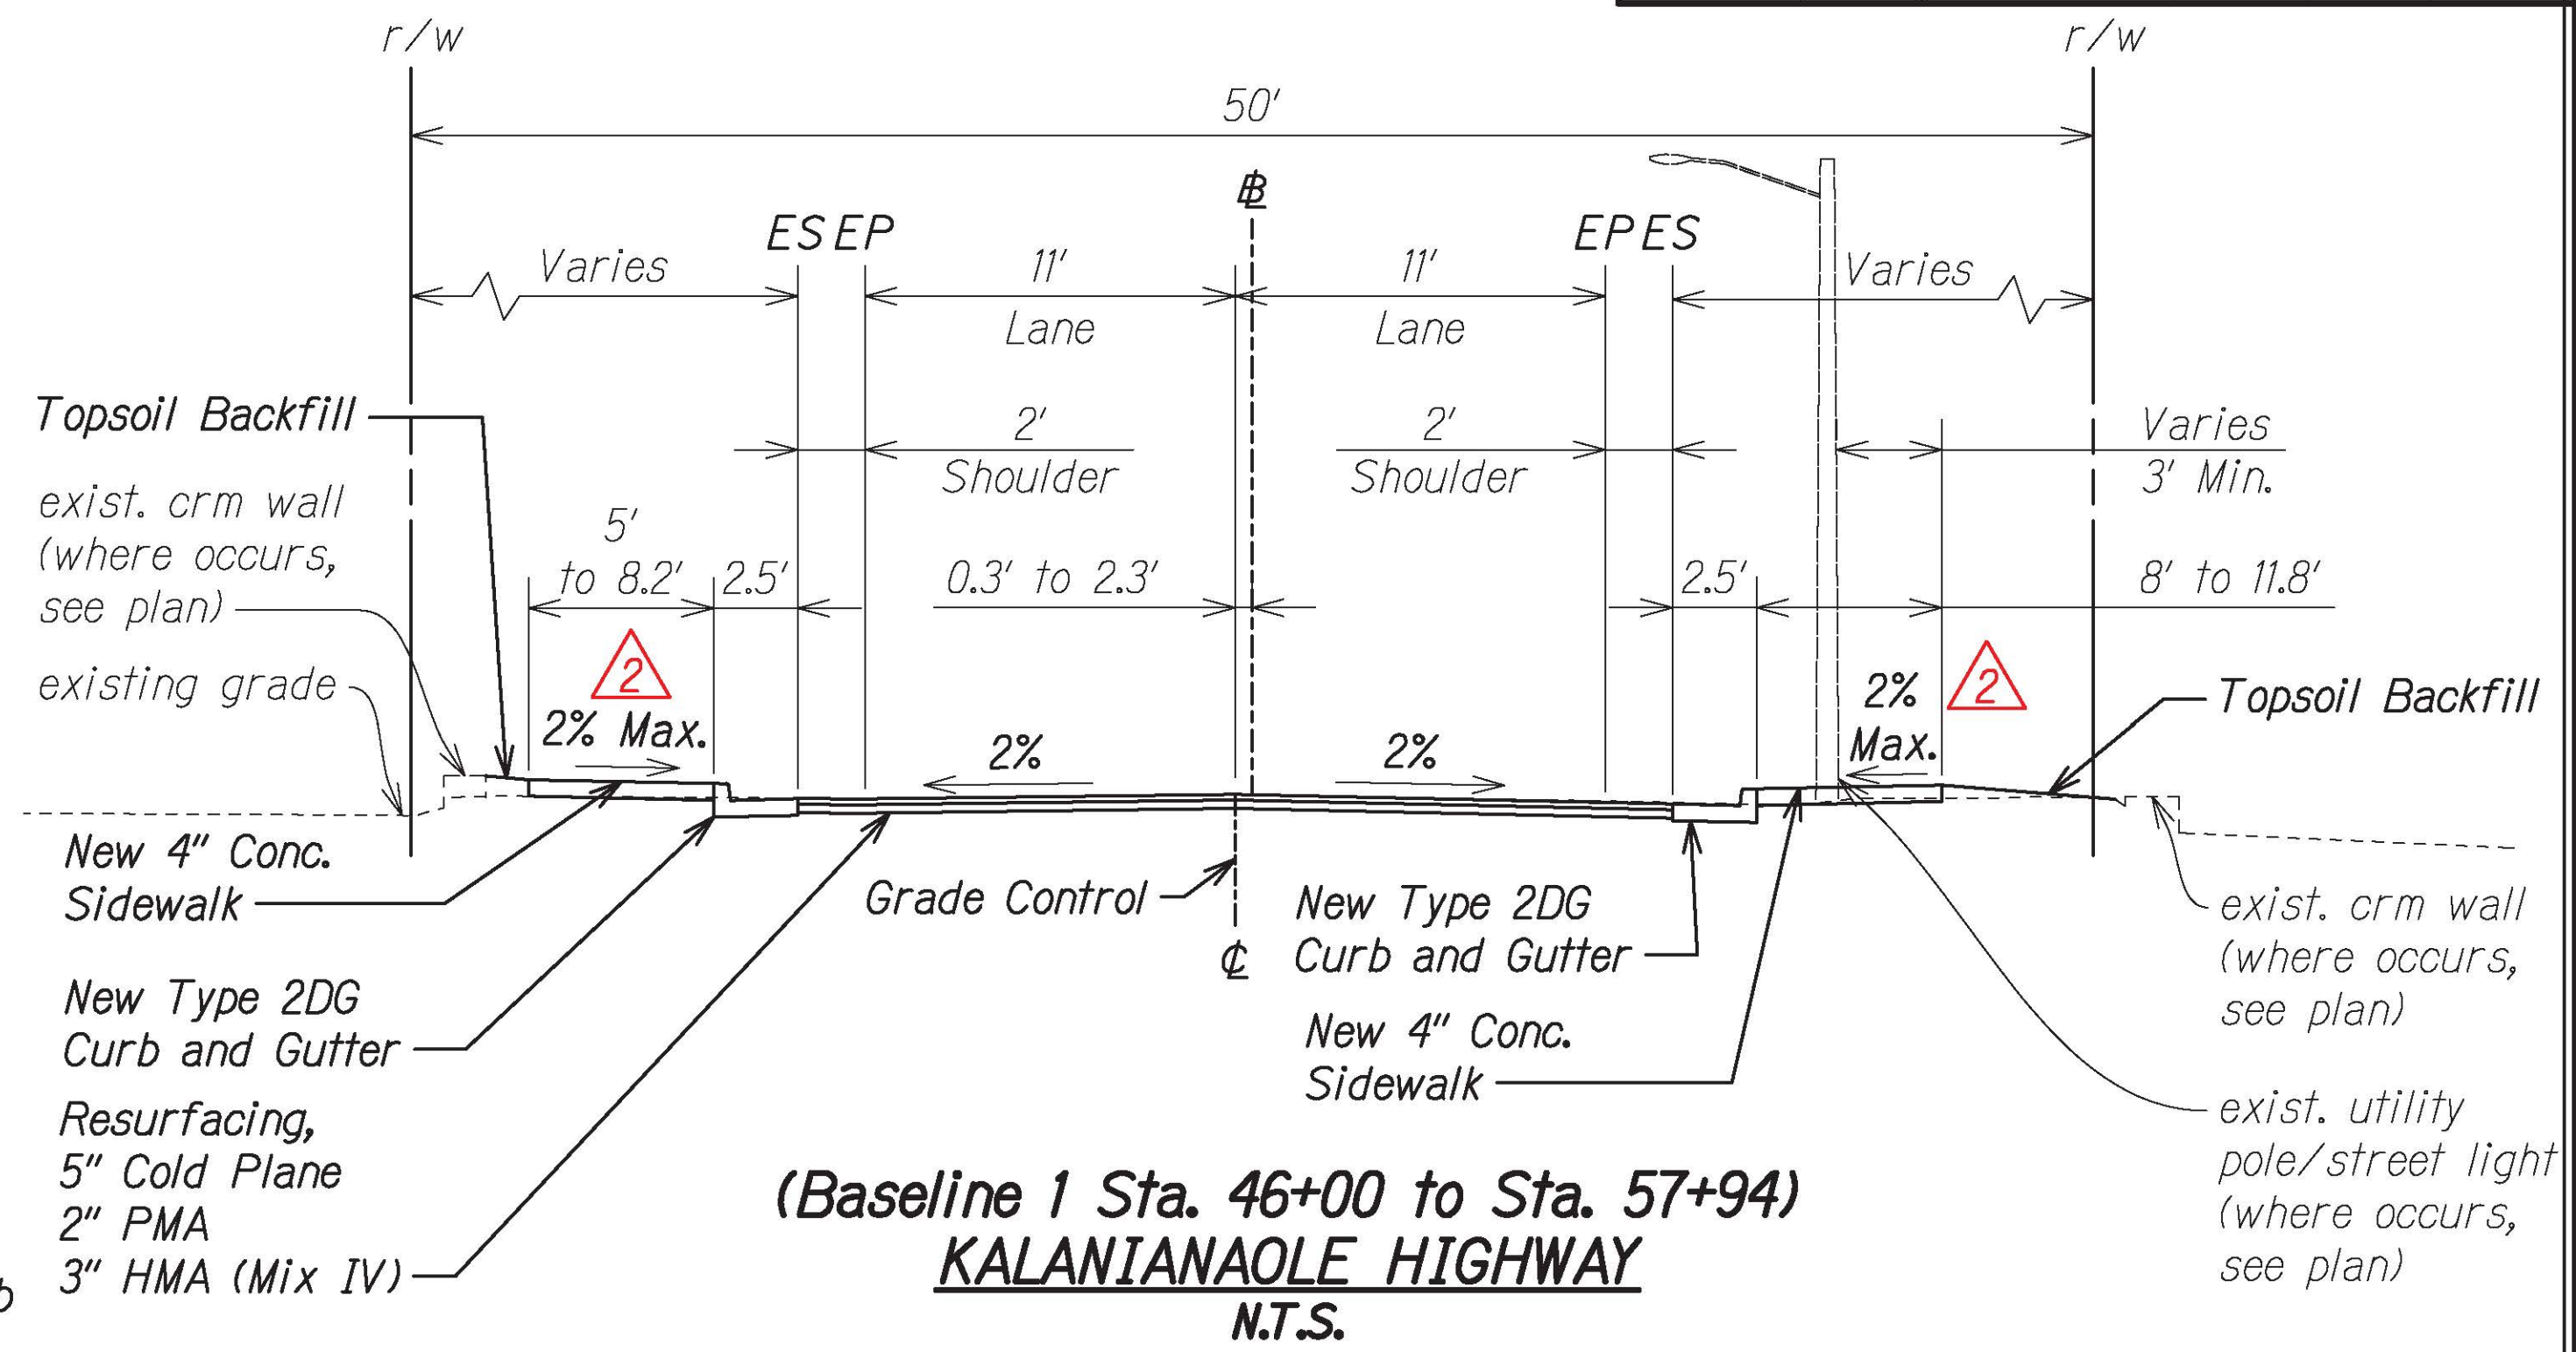
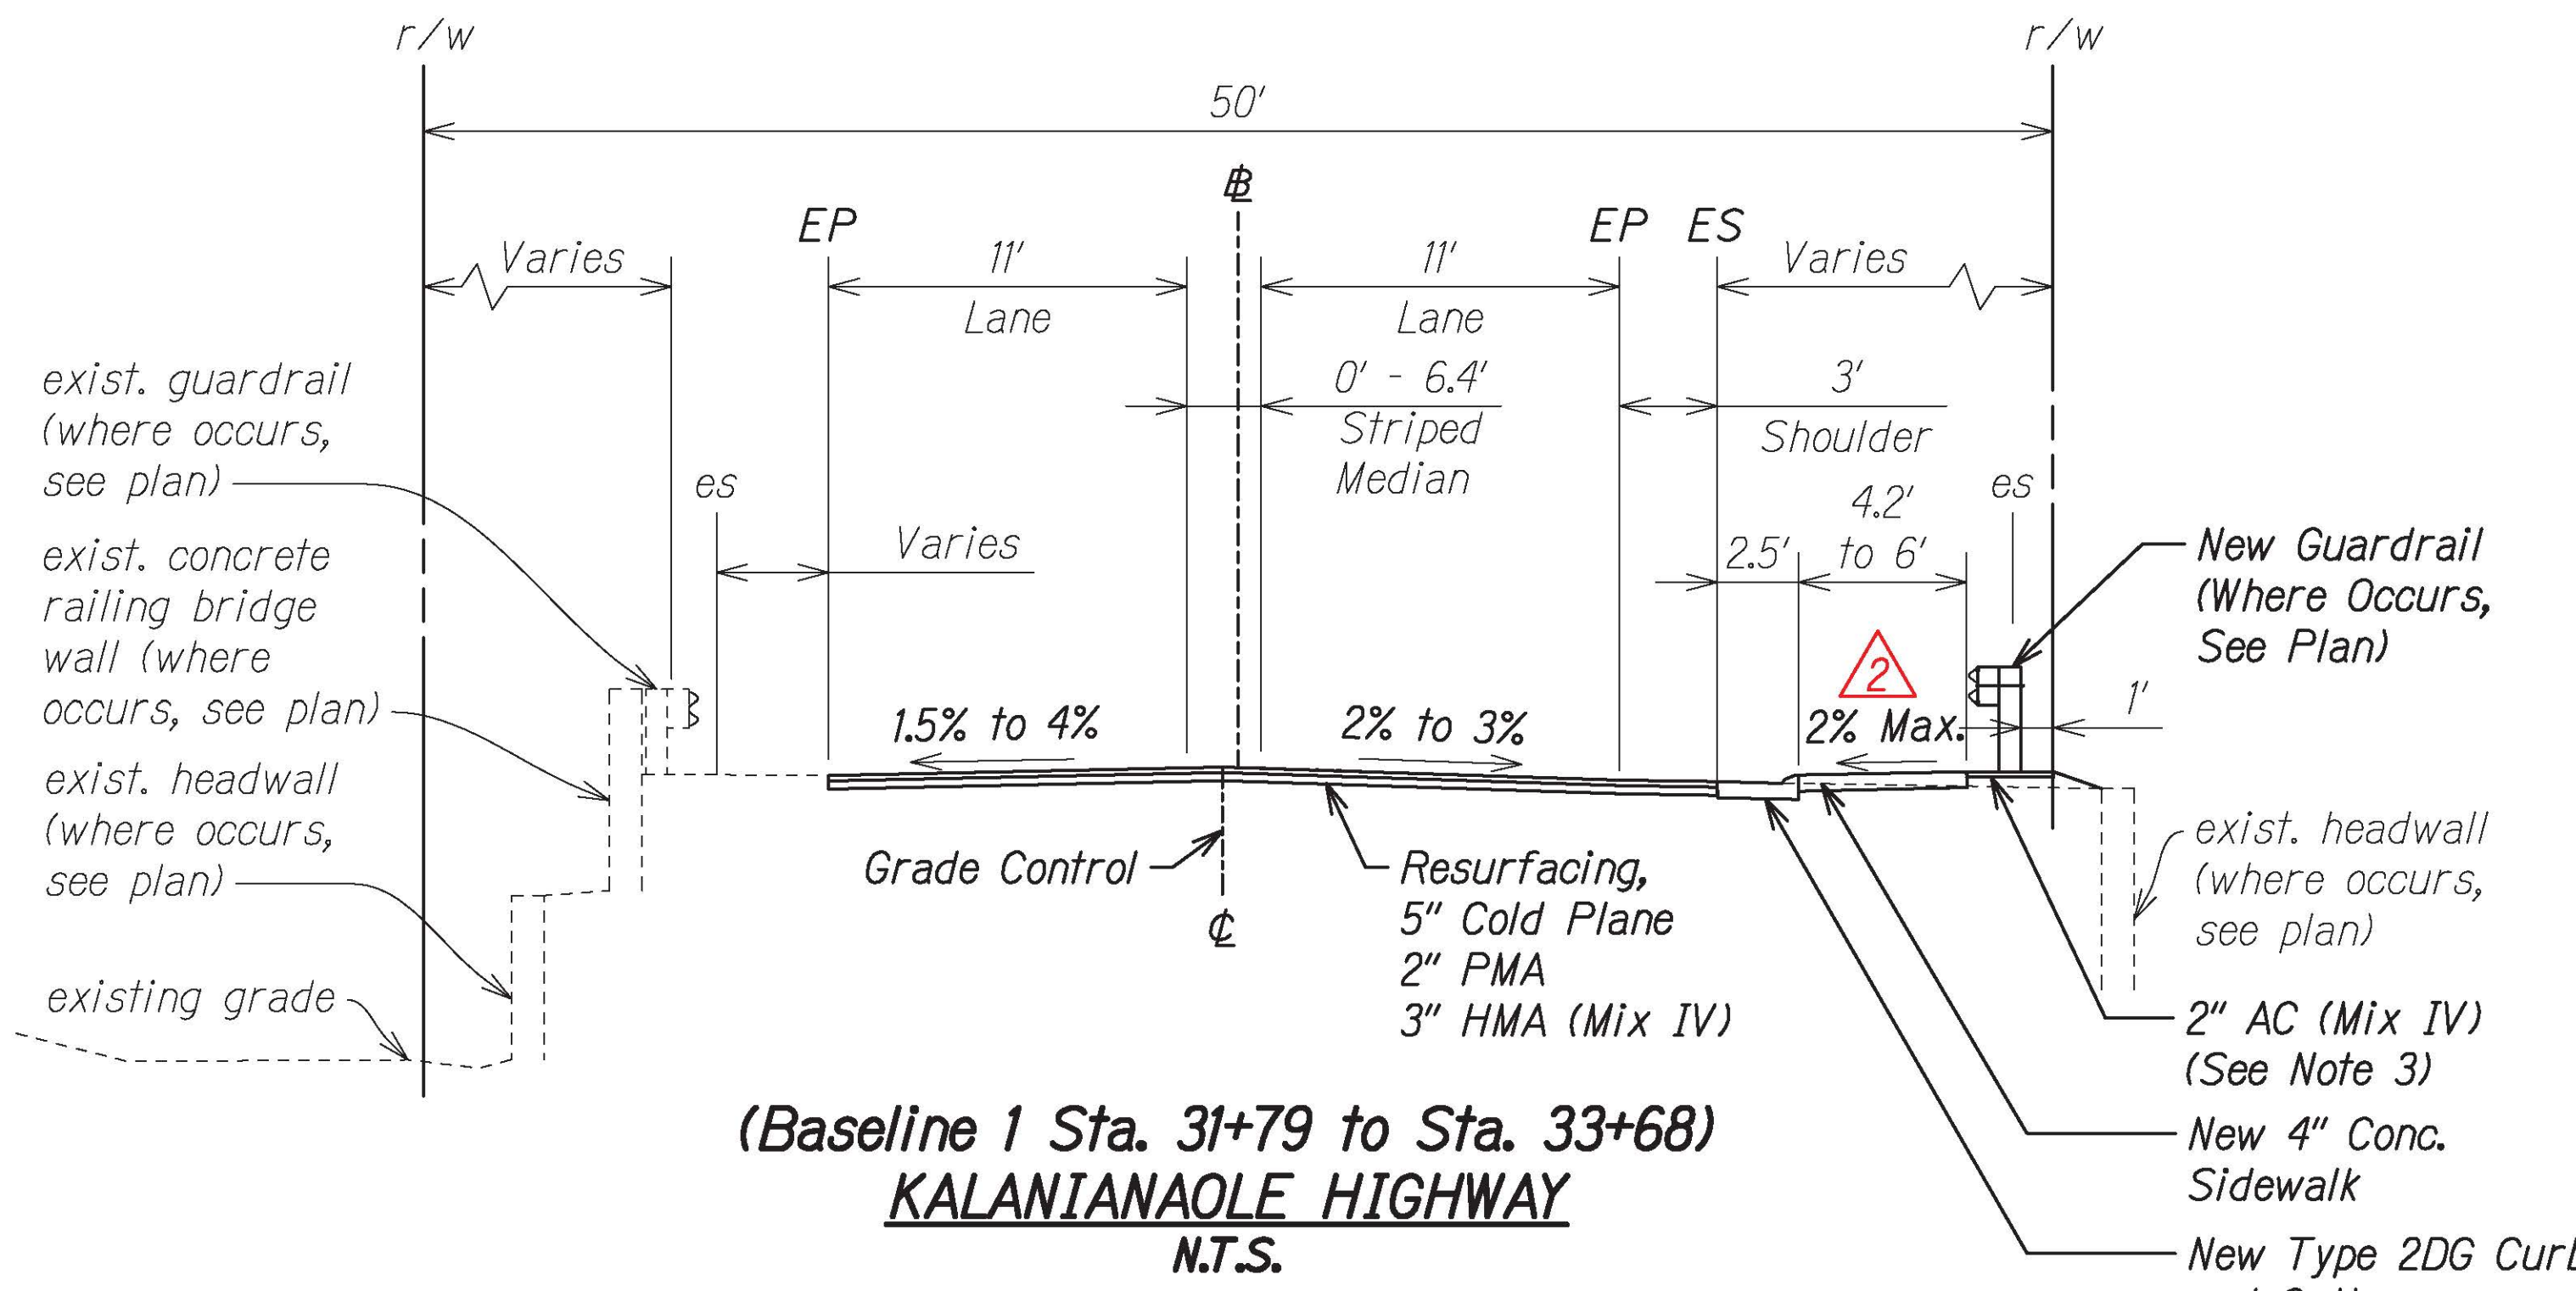


FED. ROAD DIST. NO.	STATE	FED-AID PROJ. NO.	FISCAL YEAR	SHEET NO.	TOTAL SHEETS
HAWAII	HAW.	NH-072-1(059)	2021	ADD. 57	243

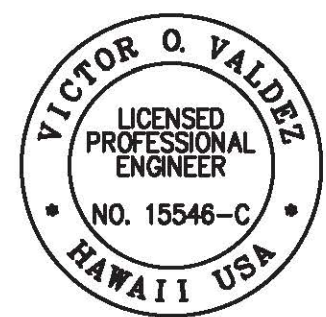

NOTES:

- Limits of AC pavement reconstruction are shown in Roadway Plans, R1 to R43.
- Lane markings are shown in Pavement Markings & Signing Plans, M1 to M44.
- Prior to installation of Ac. Mix No. IV, compact ground to 95% compaction.




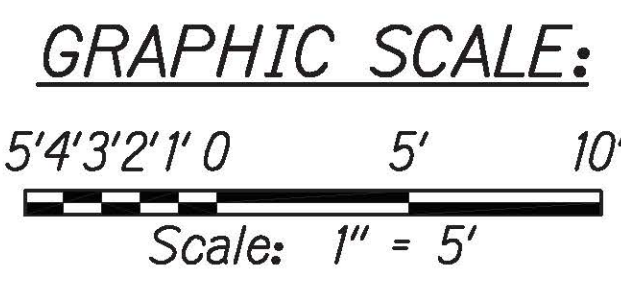


THIS WORK WAS PREPARED BY ME
OR UNDER MY SUPERVISION



[Signature] 04/30/22
SIGNATURE EXPIRATION DATE
OF THE LICENSE

3/26/21	Added Sidewalk Slope
DATE	REVISION
STATE OF HAWAII DEPARTMENT OF TRANSPORTATION HIGHWAYS DIVISION	
TYPICAL SECTIONS	
KALANIANA'OLE HIGHWAY IMPROVEMENTS PHASE 2	
Paolima Street to Vicinity of Makai Pier	
Federal-Aid Project No. NH-072-1(059)	
Scale: 1" = 5'	Date: March 2021
SHEET No. C1 OF 27 SHEETS	

FED. ROAD DIST. NO.	STATE	FED-AID PROJ. NO.	FISCAL YEAR	SHEET NO.	TOTAL SHEETS
HAWAII	HAW.	NH-072-1(059)	2021	ADD. 58	243

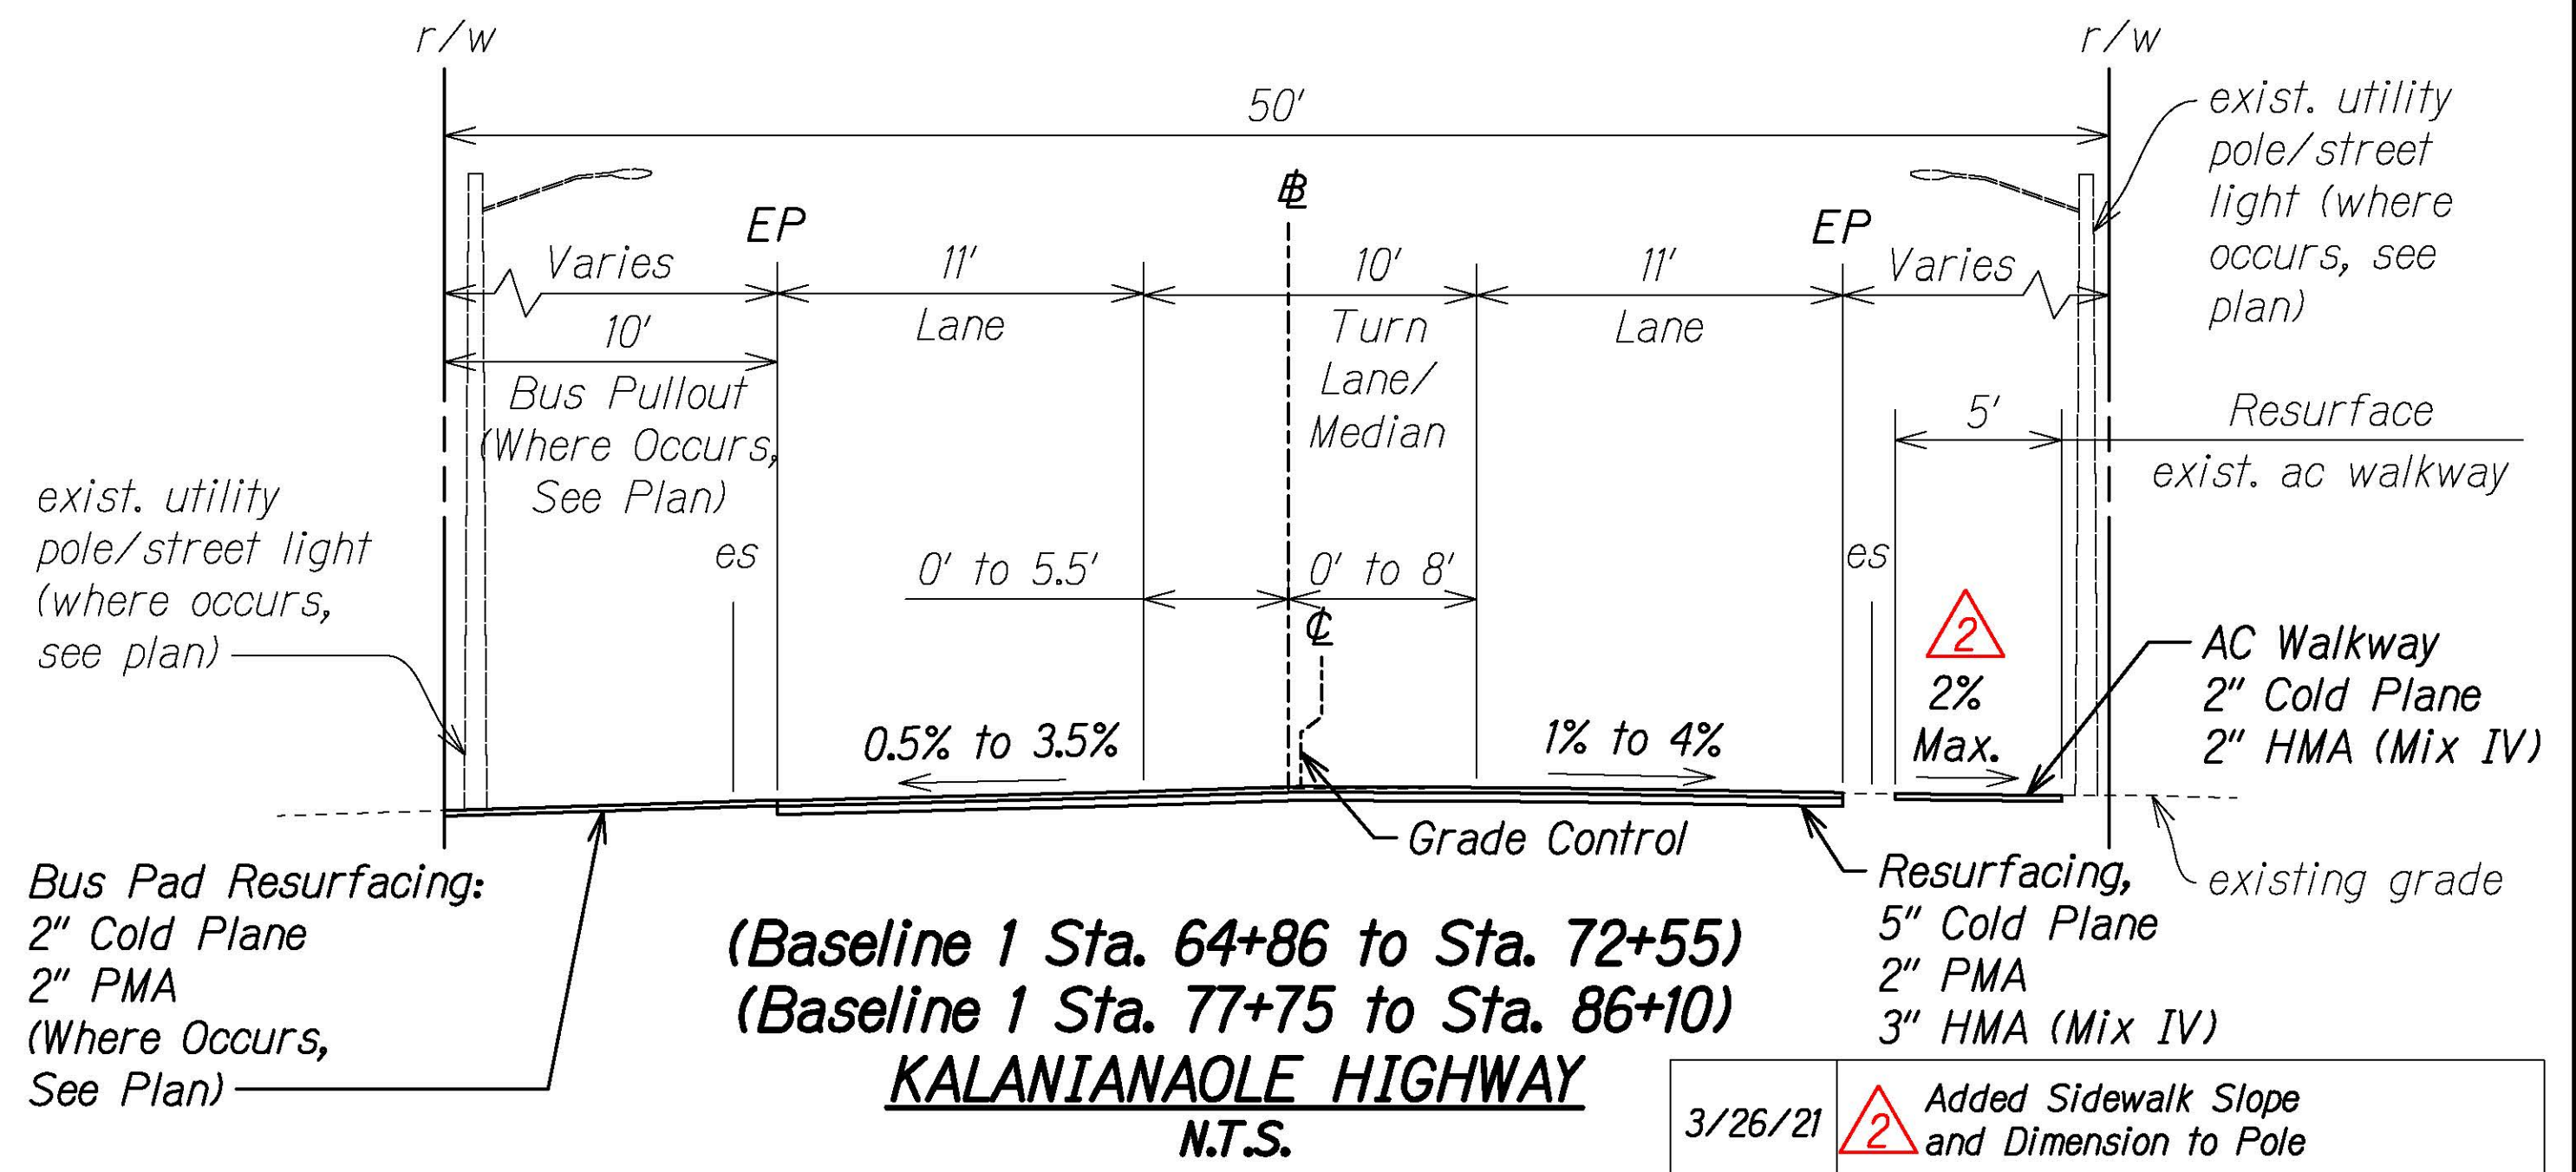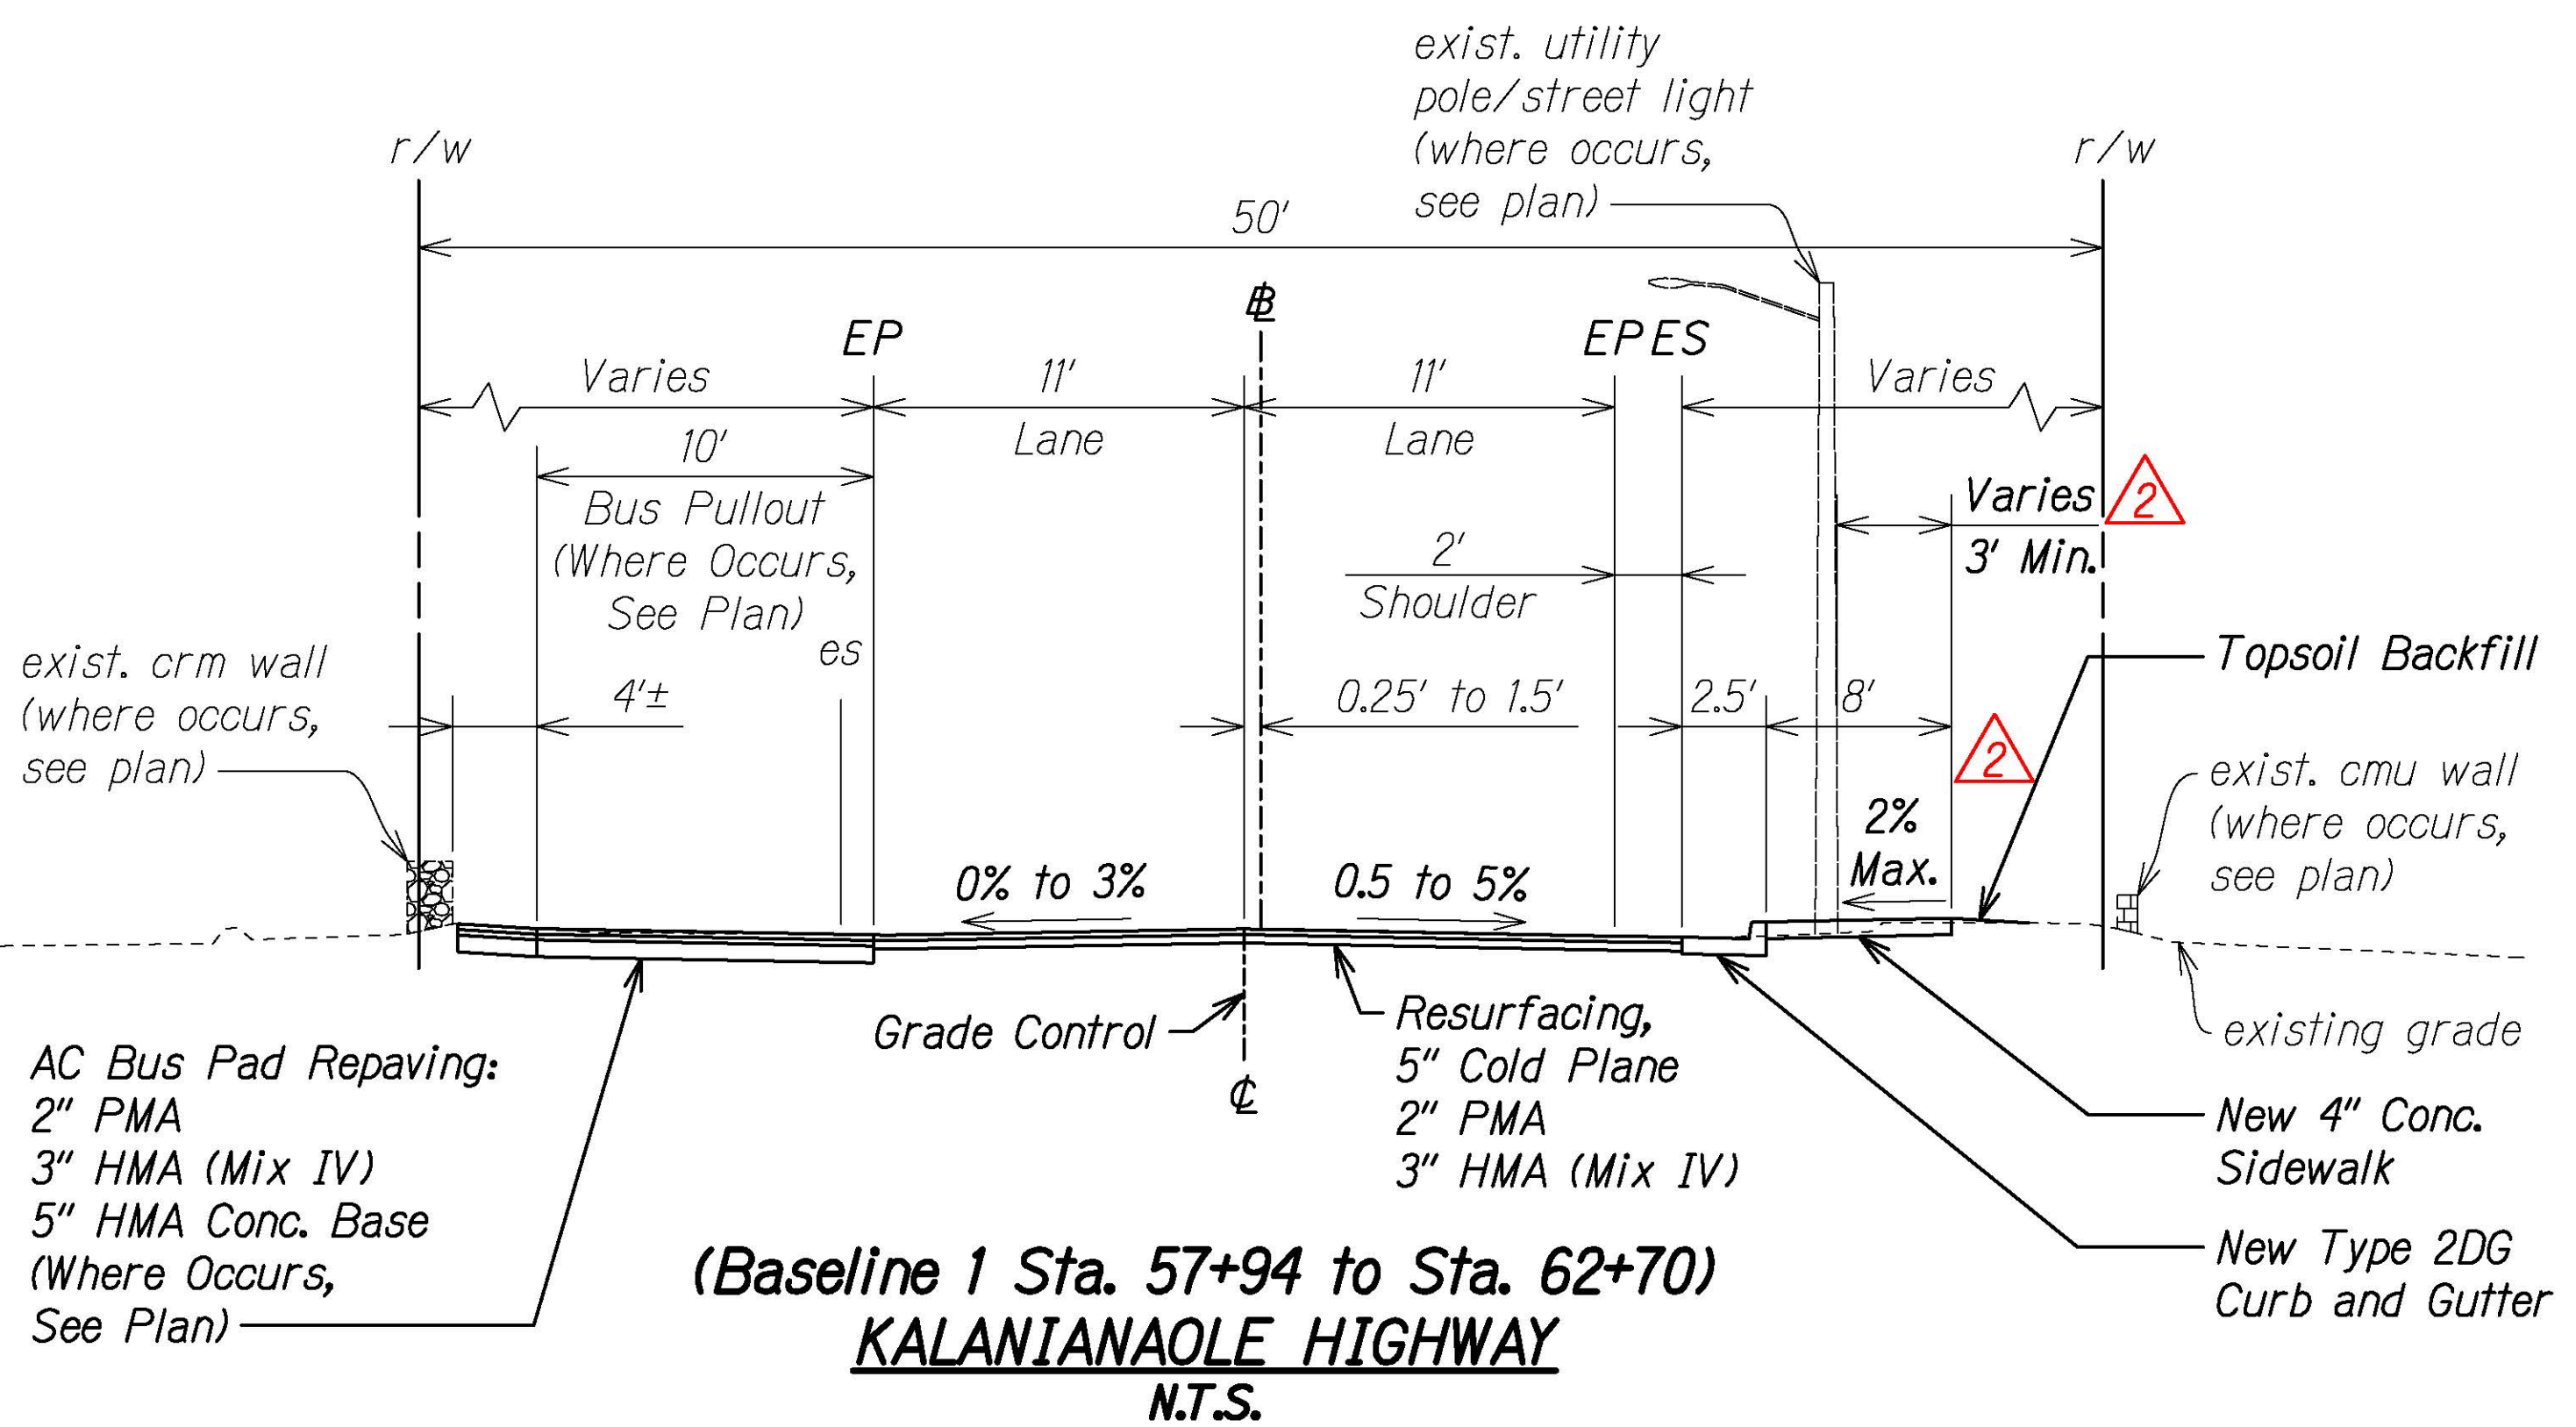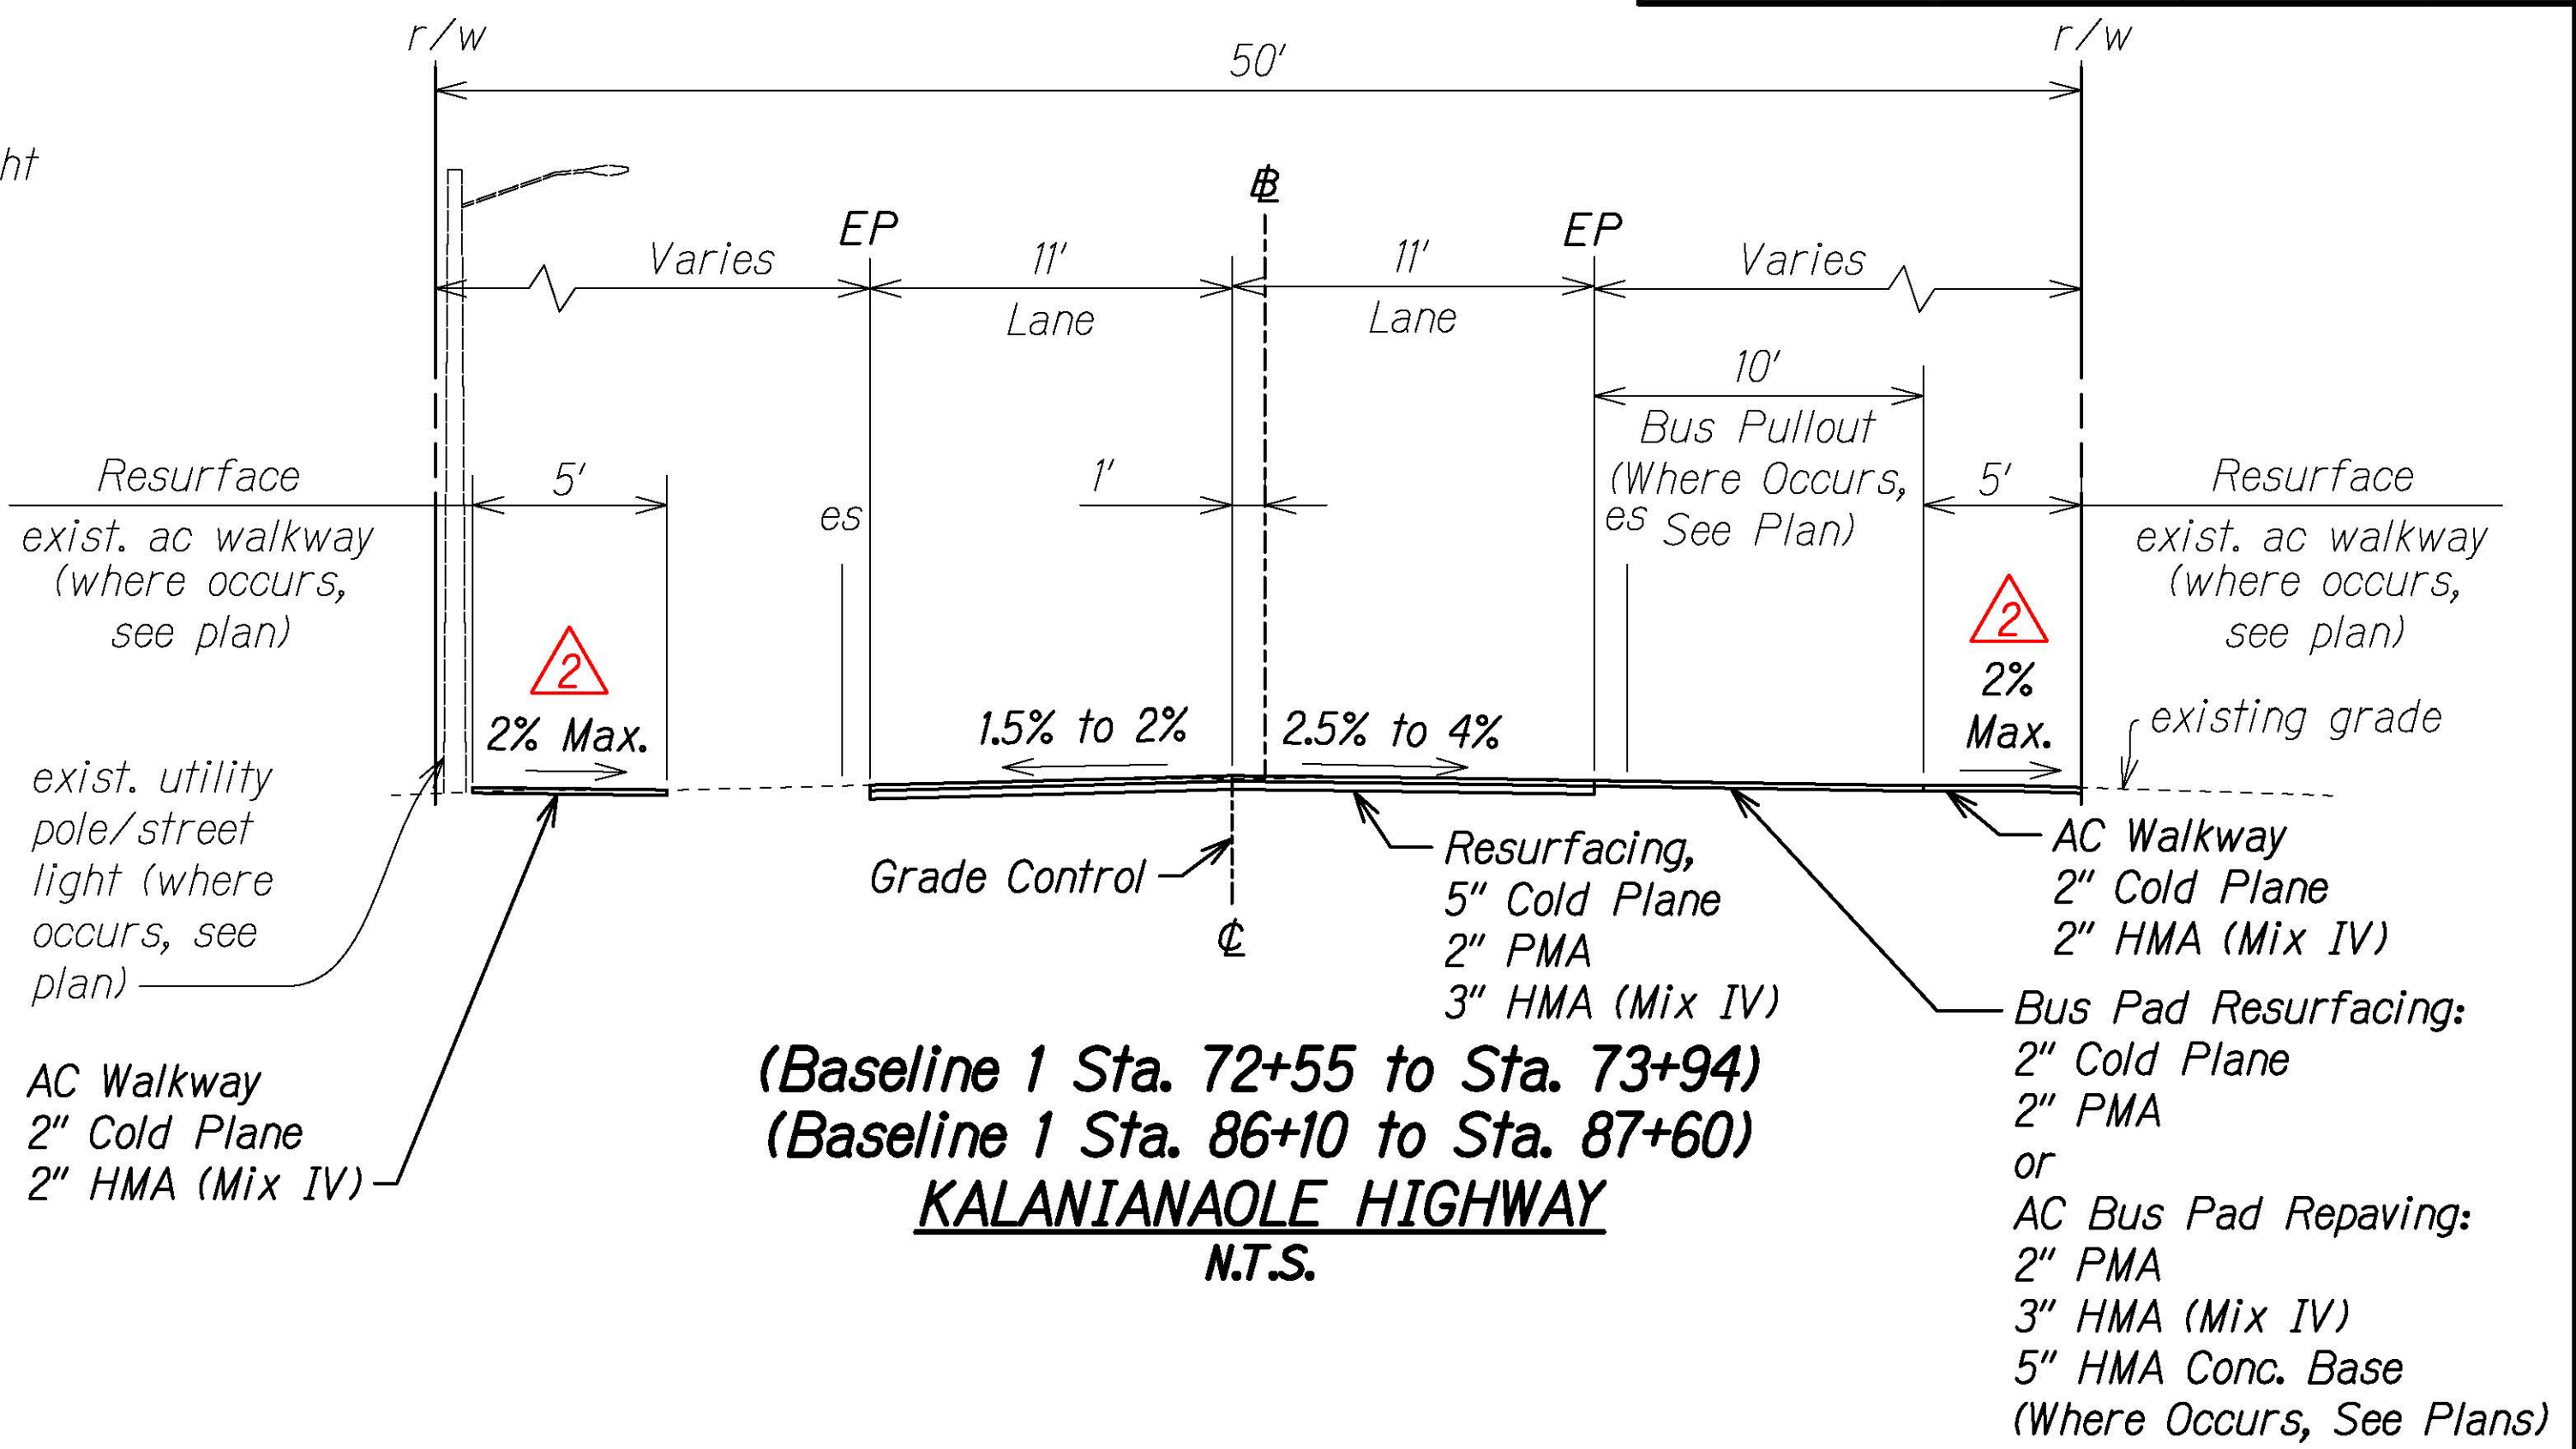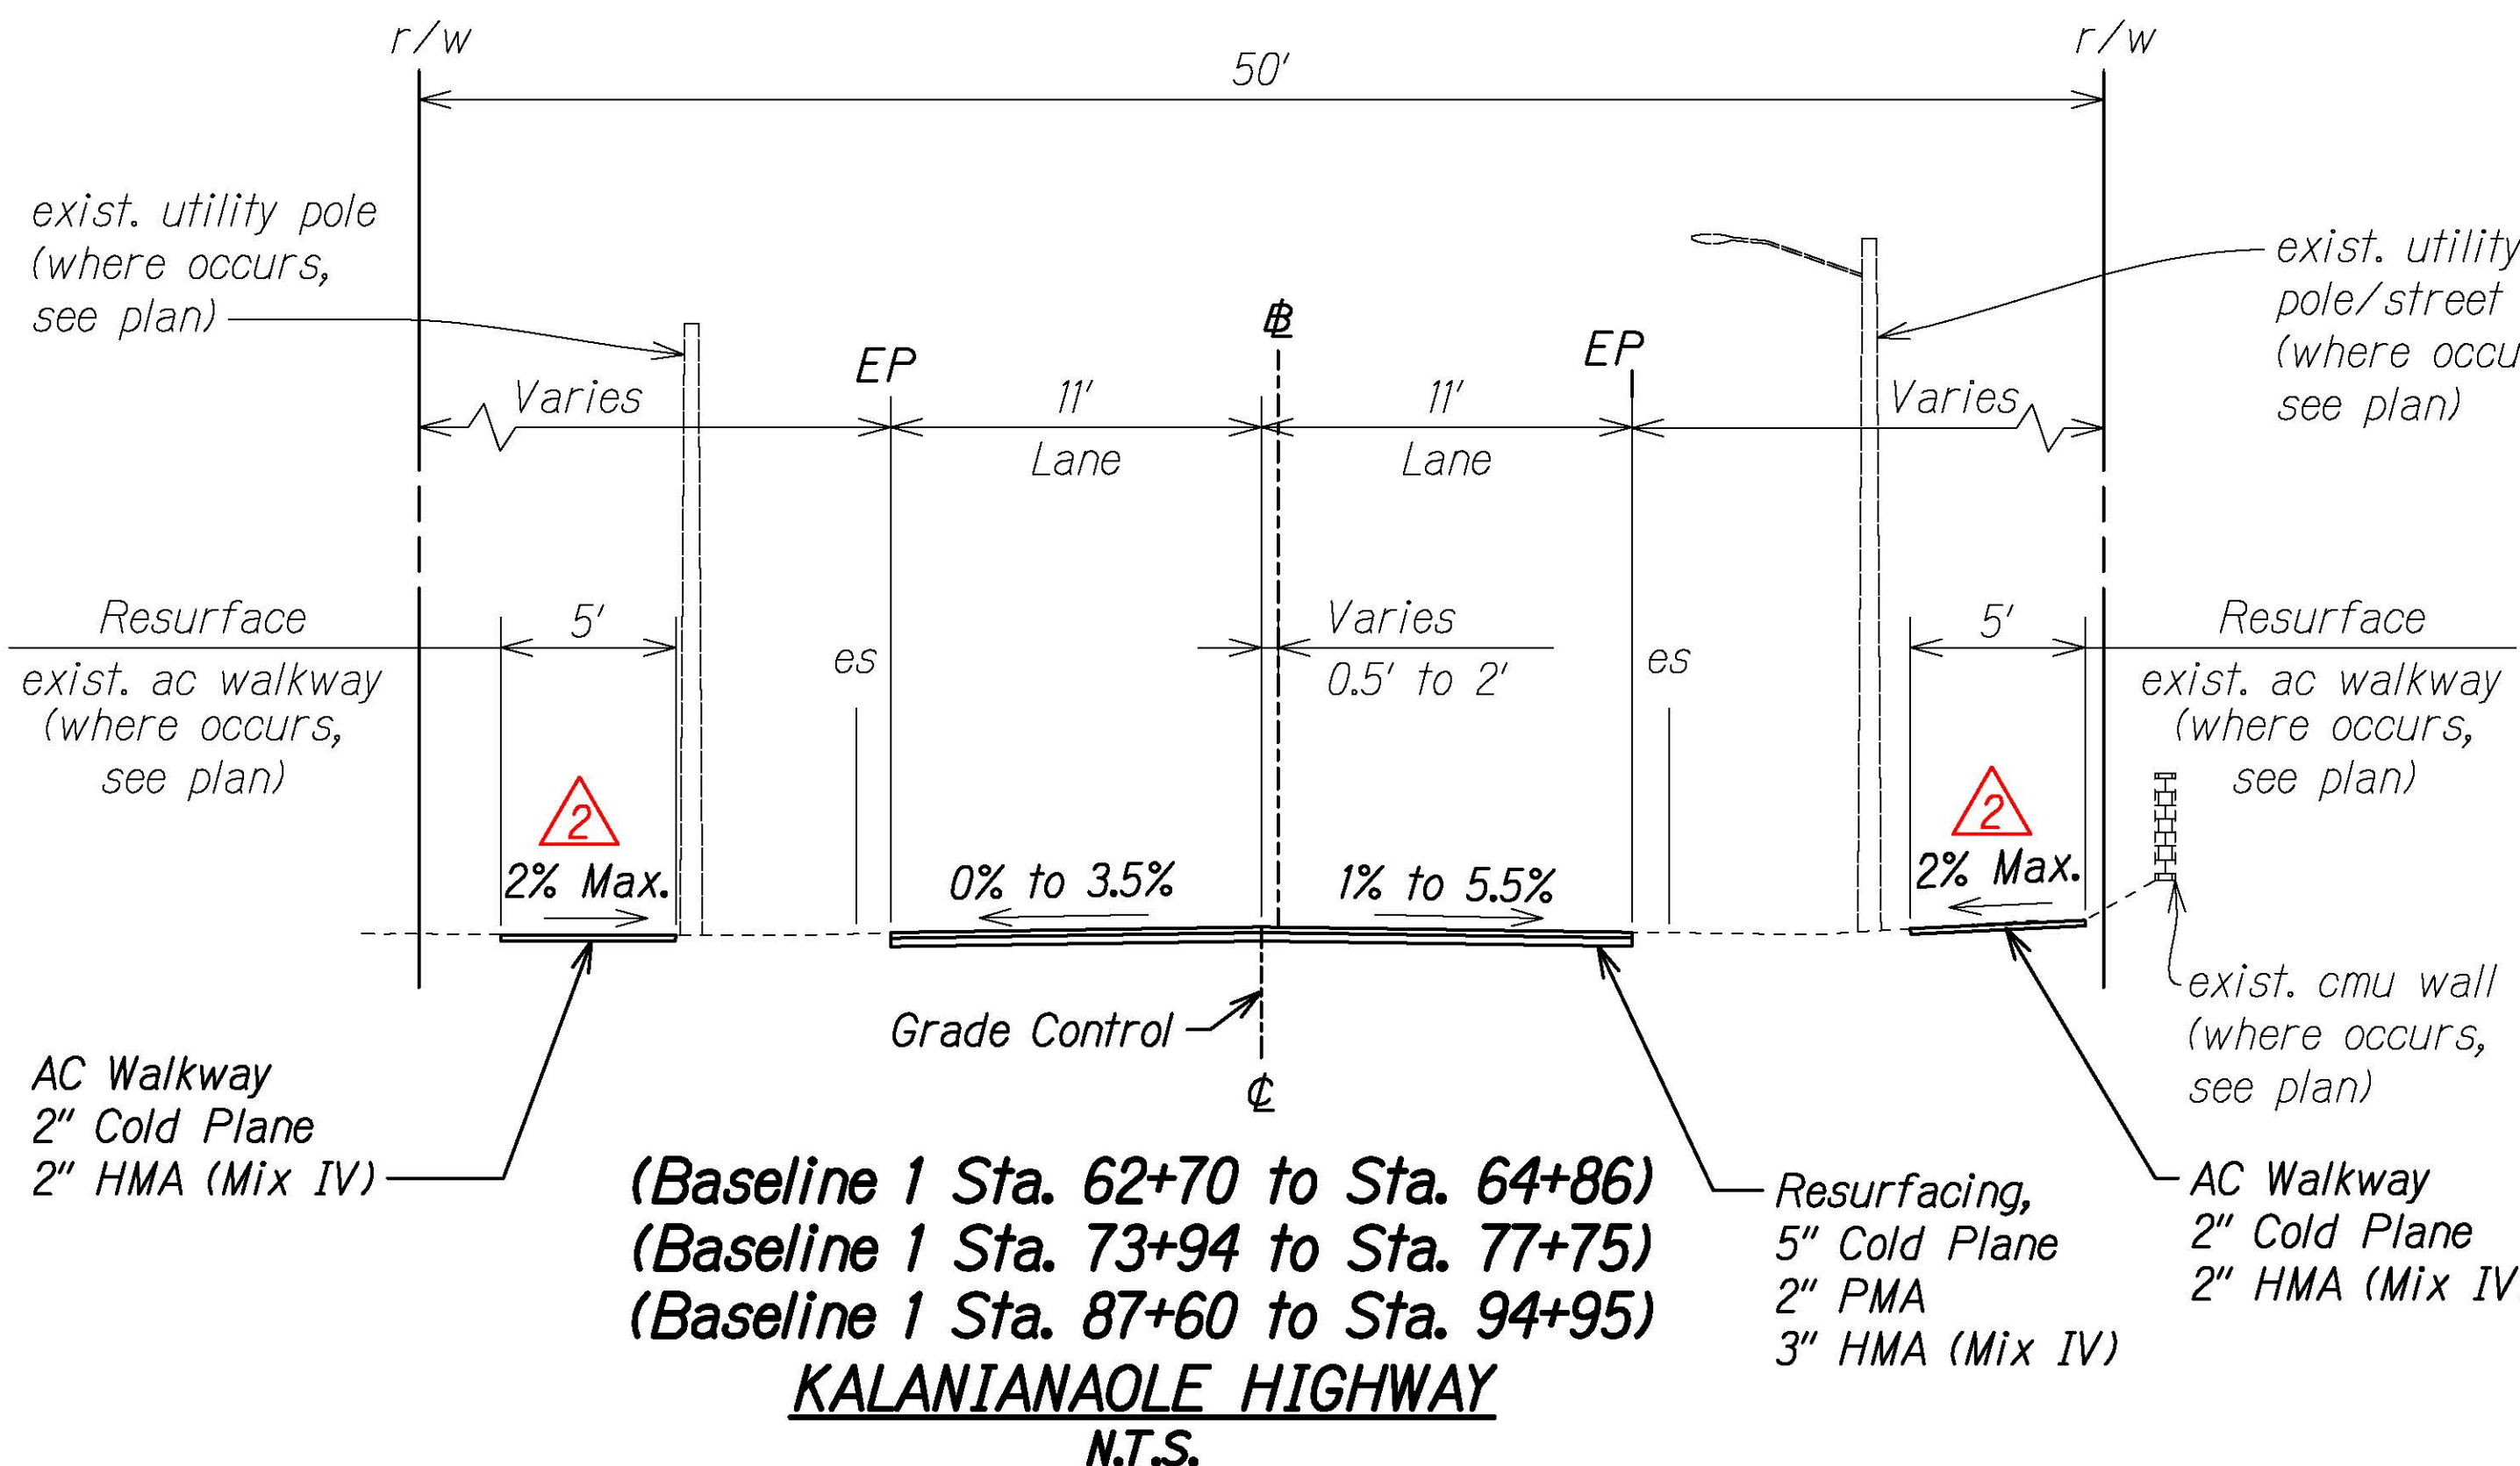

- NOTES:**
- Limits of AC pavement reconstruction are shown in Roadway Plans, R1 to R43.
 - Lane markings are shown in Pavement Markings & Signing Plans, M1 to M44.

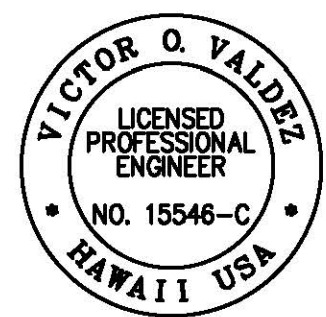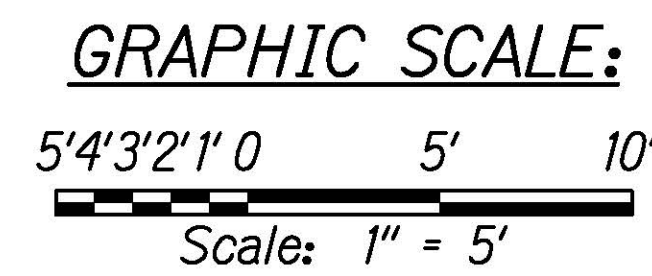


THIS WORK WAS PREPARED BY ME
OR UNDER MY SUPERVISION


[Signature] 04/30/22
SIGNATURE EXPIRATION DATE OF THE LICENSE

3/26/21	Added Sidewalk Slope and Dimension to Pole
DATE	REVISION
STATE OF HAWAII DEPARTMENT OF TRANSPORTATION HIGHWAYS DIVISION	
TYPICAL SECTIONS	
KALANIANA'OLE HIGHWAY IMPROVEMENTS PHASE 2	
Palima Street to Vicinity of Makai Pier	
Federal-Aid Project No. NH-072-1(059)	
Scale: 1" = 5'	Date: March 2021

FED. ROAD DIST. NO.	STATE	FED-AID PROJ. NO.	FISCAL YEAR	SHEET NO.	TOTAL SHEETS
HAWAII	HAW.	NH-072-1(059)	2021	ADD. 59	243

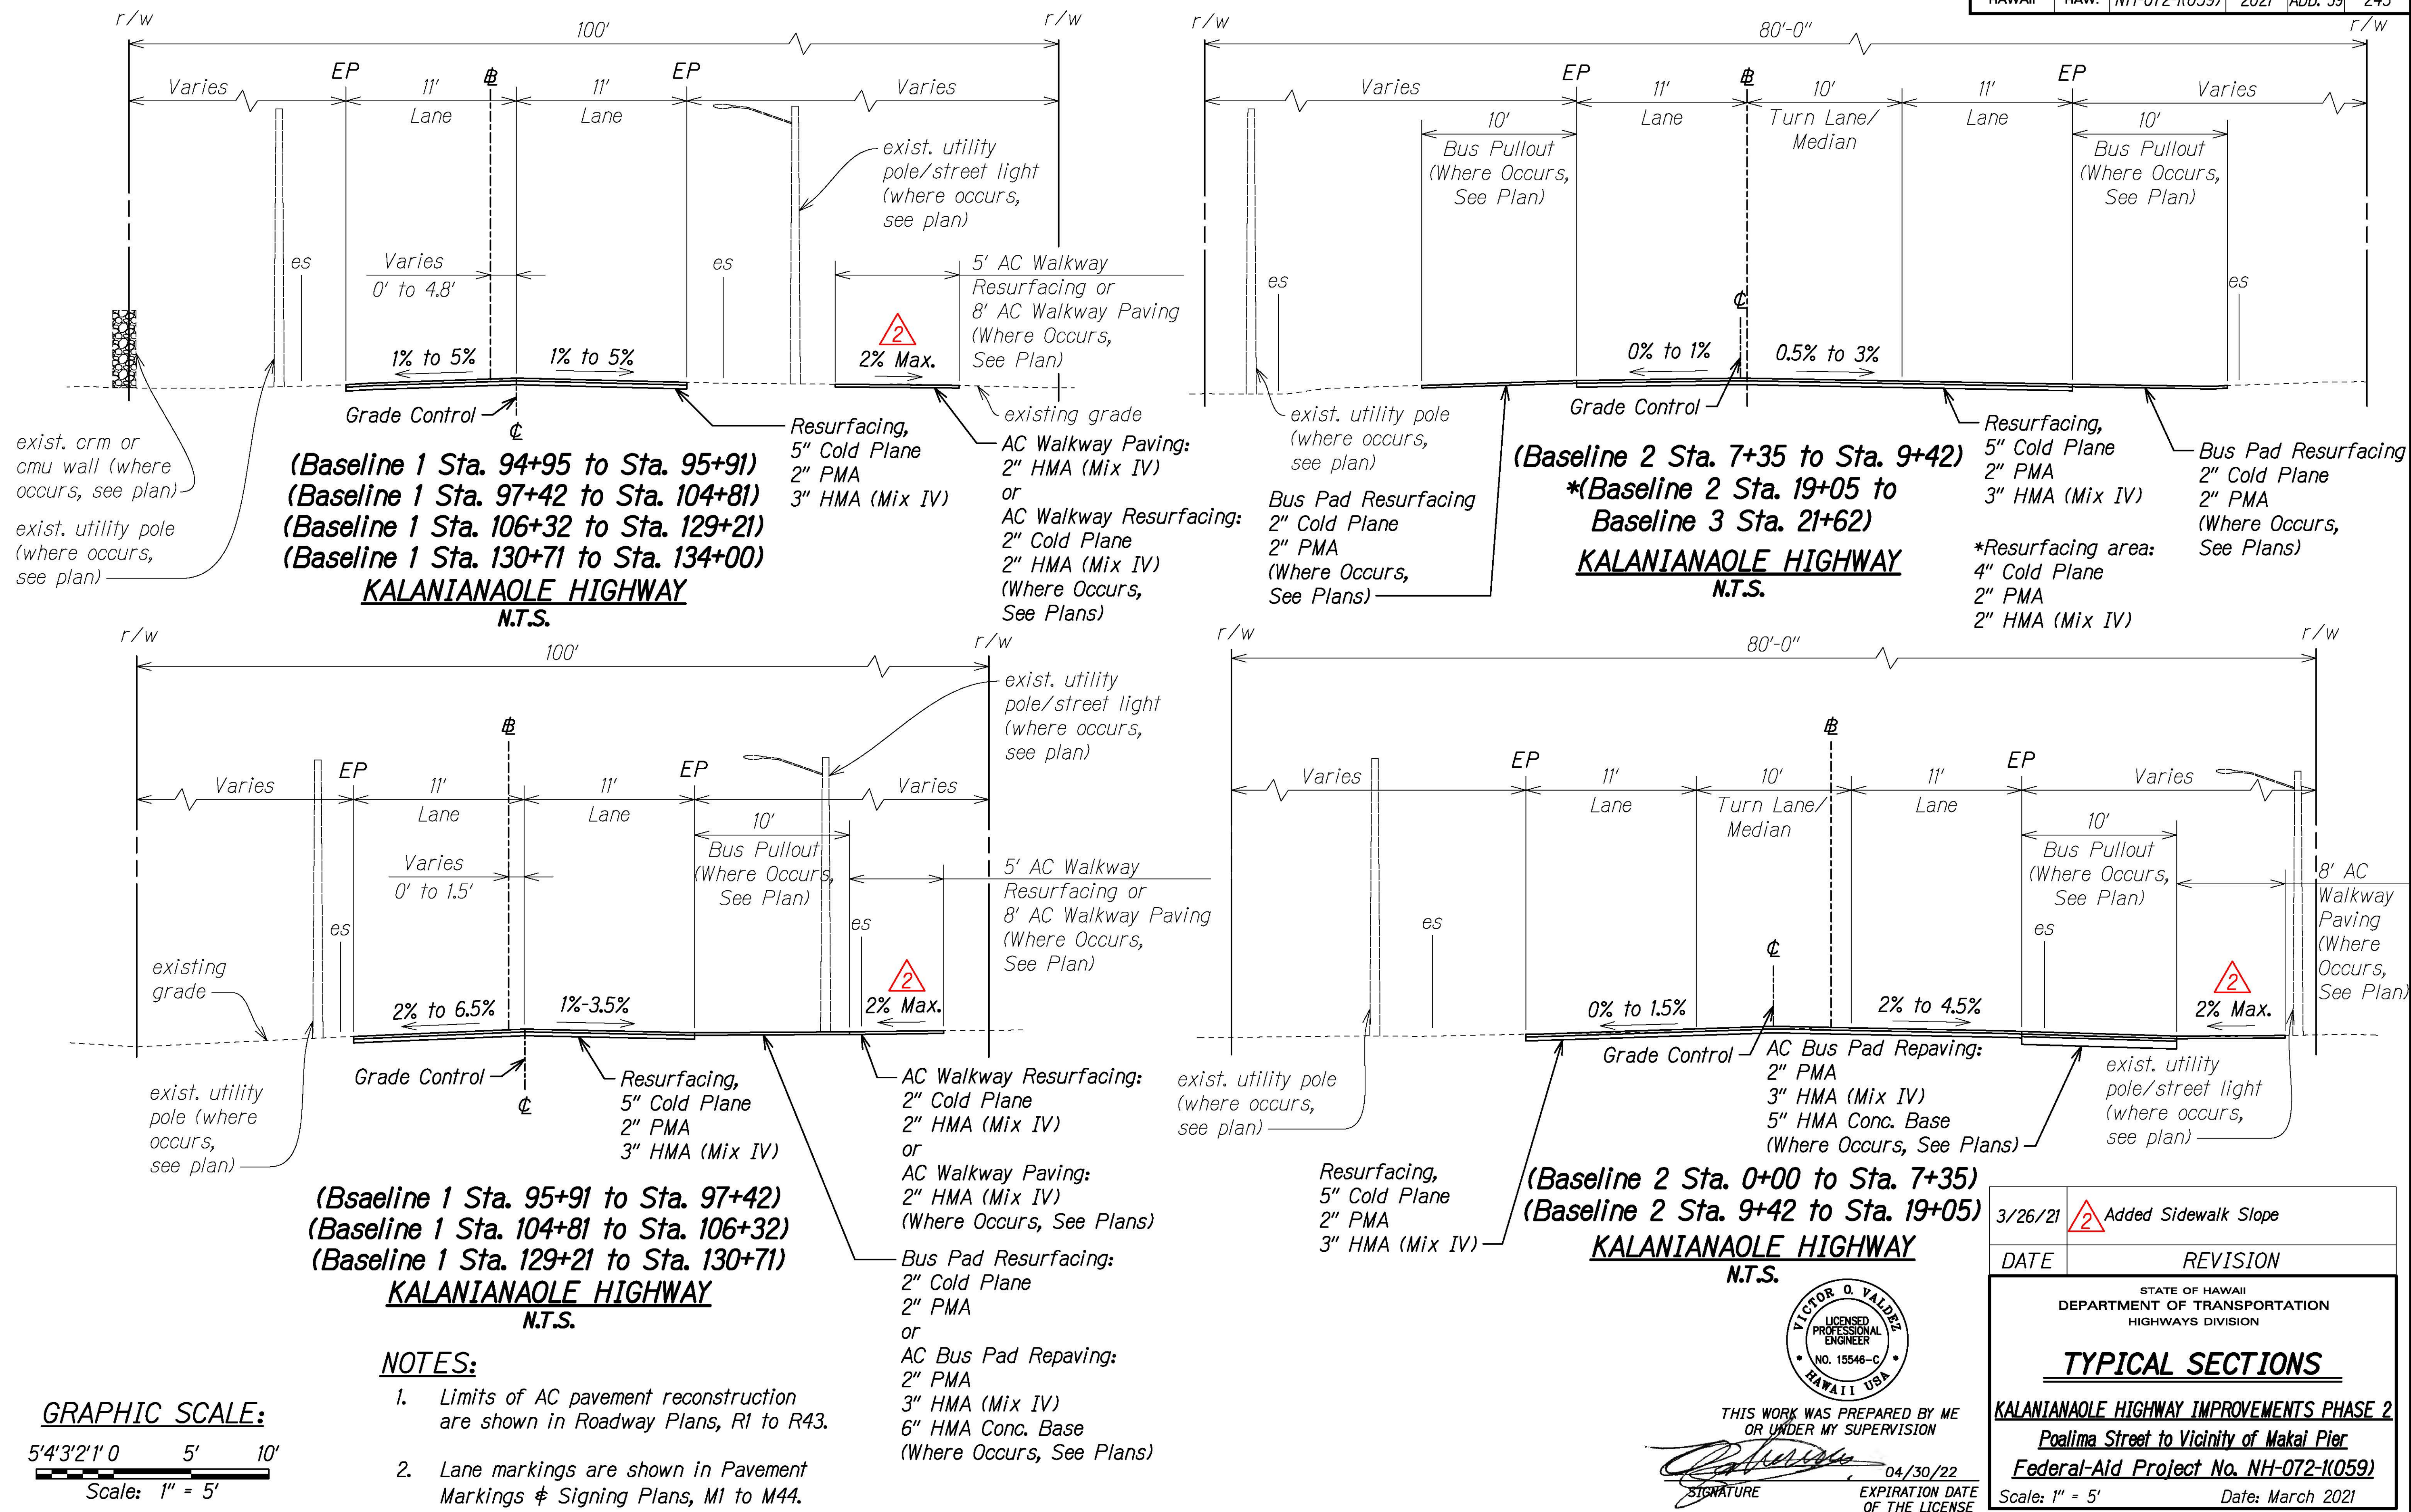

3/26/21	Added Sidewalk Slope
DATE	REVISION
STATE OF HAWAII DEPARTMENT OF TRANSPORTATION HIGHWAYS DIVISION	
TYPICAL SECTIONS	
KALANIANA'OLE HIGHWAY IMPROVEMENTS PHASE 2	
Poalima Street to Vicinity of Makai Pier	
Federal-Aid Project No. NH-072-1(059)	
Scale: 1" = 5'	Date: March 2021

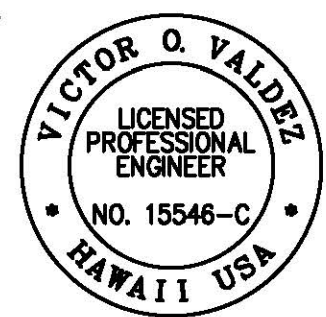




THIS WORK WAS PREPARED BY ME
OR UNDER MY SUPERVISION

SIGNATURE

04/30/22


EXPIRATION DATE
OF THE LICENSE

FED. ROAD DIST. NO.	STATE	FED-AID PROJ. NO.	FISCAL YEAR	SHEET NO.	TOTAL SHEETS
HAWAII	HAW.	NH-072-1(059)	2021	60	243

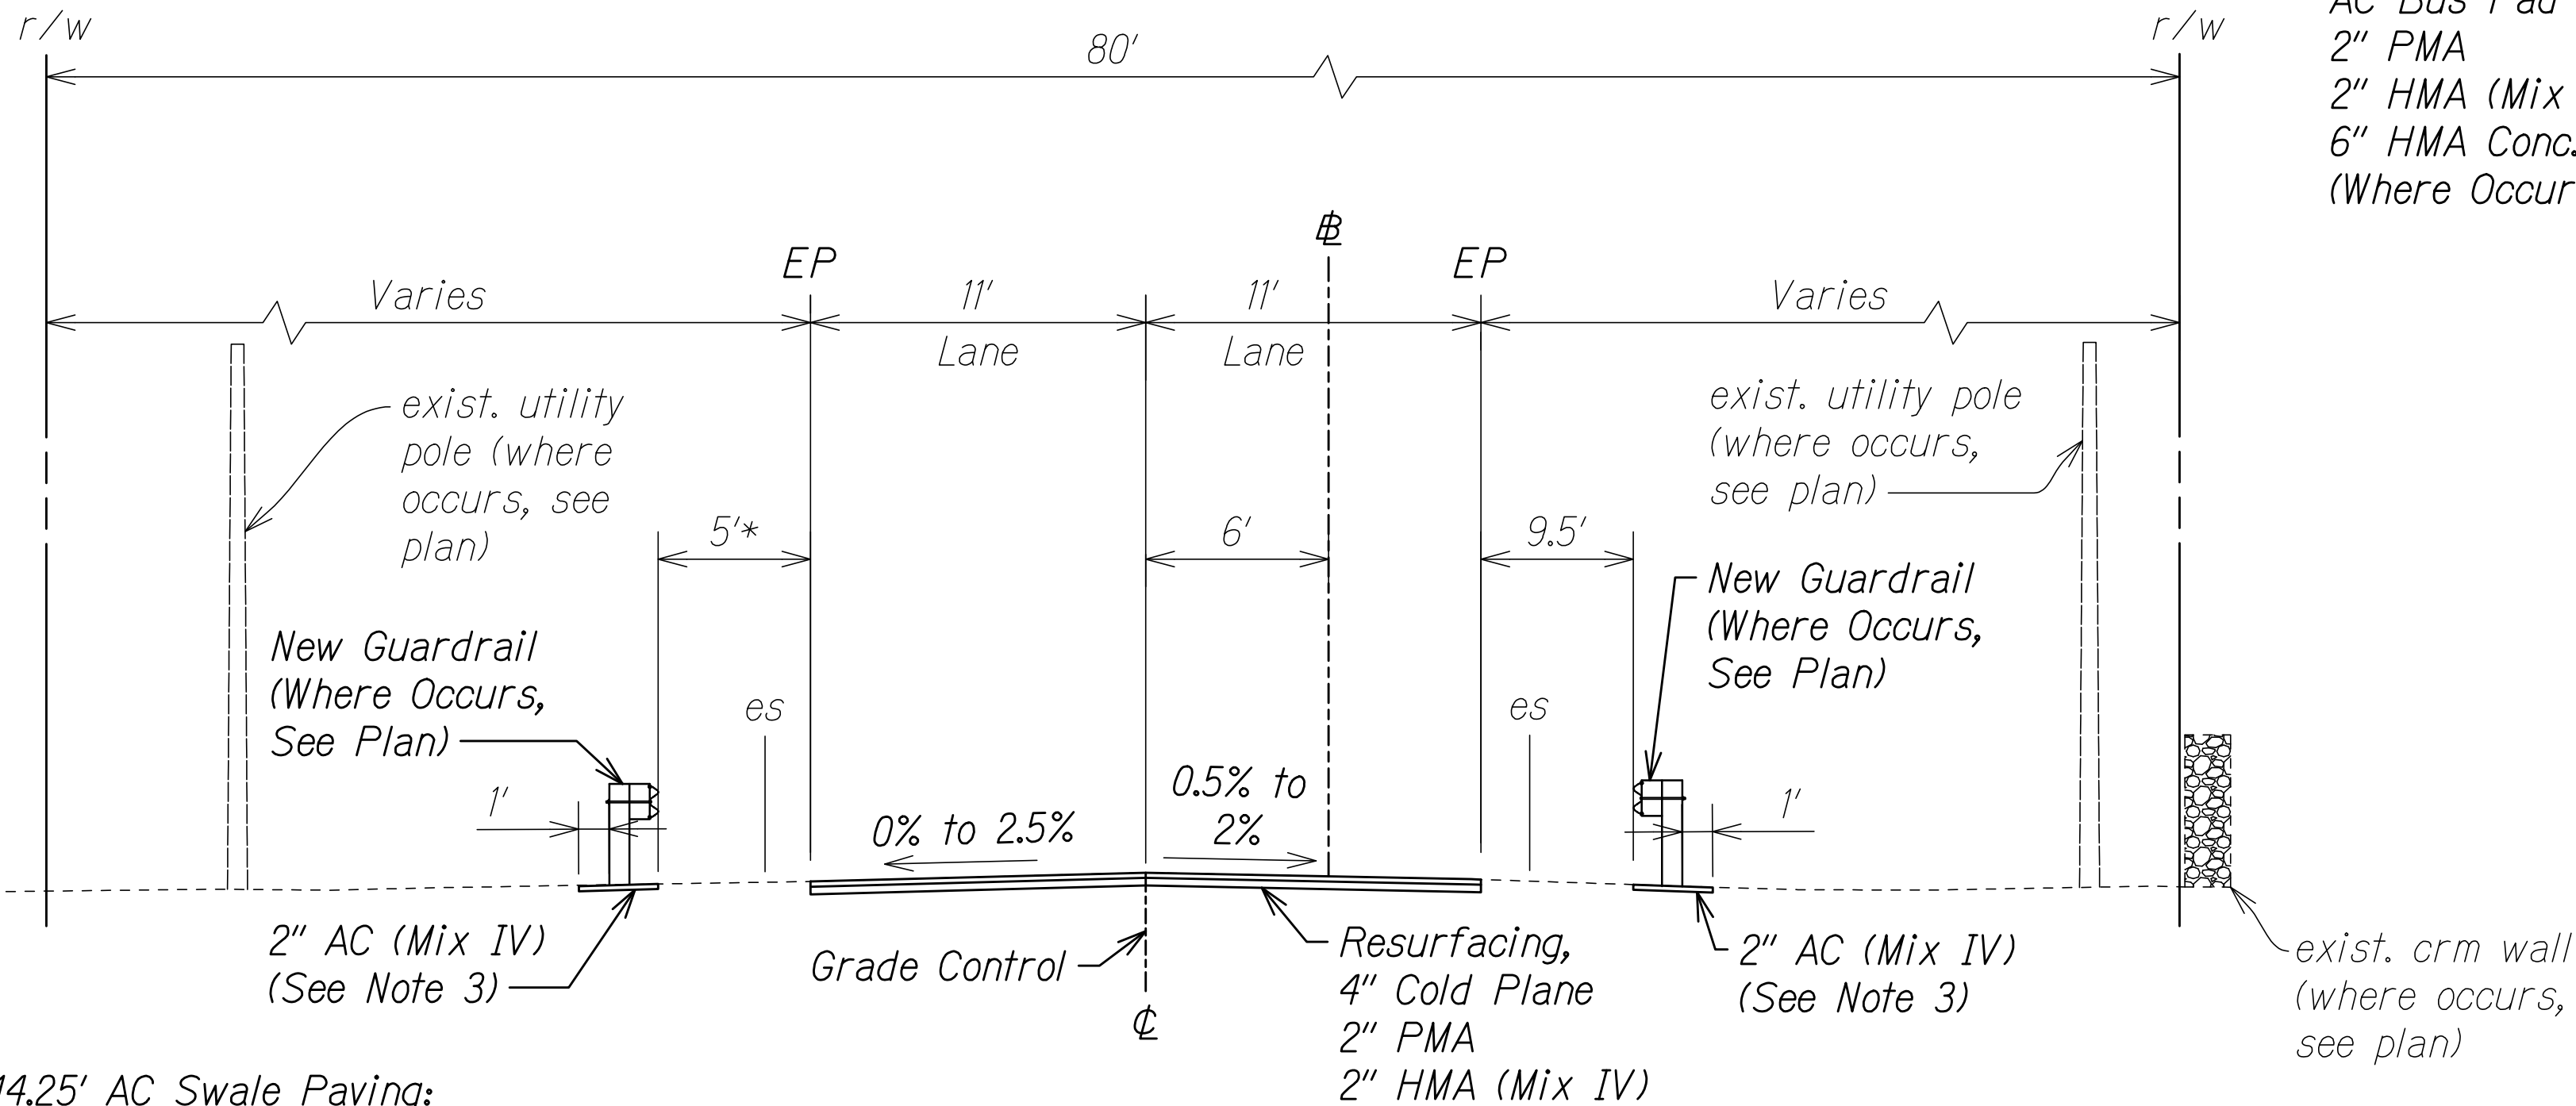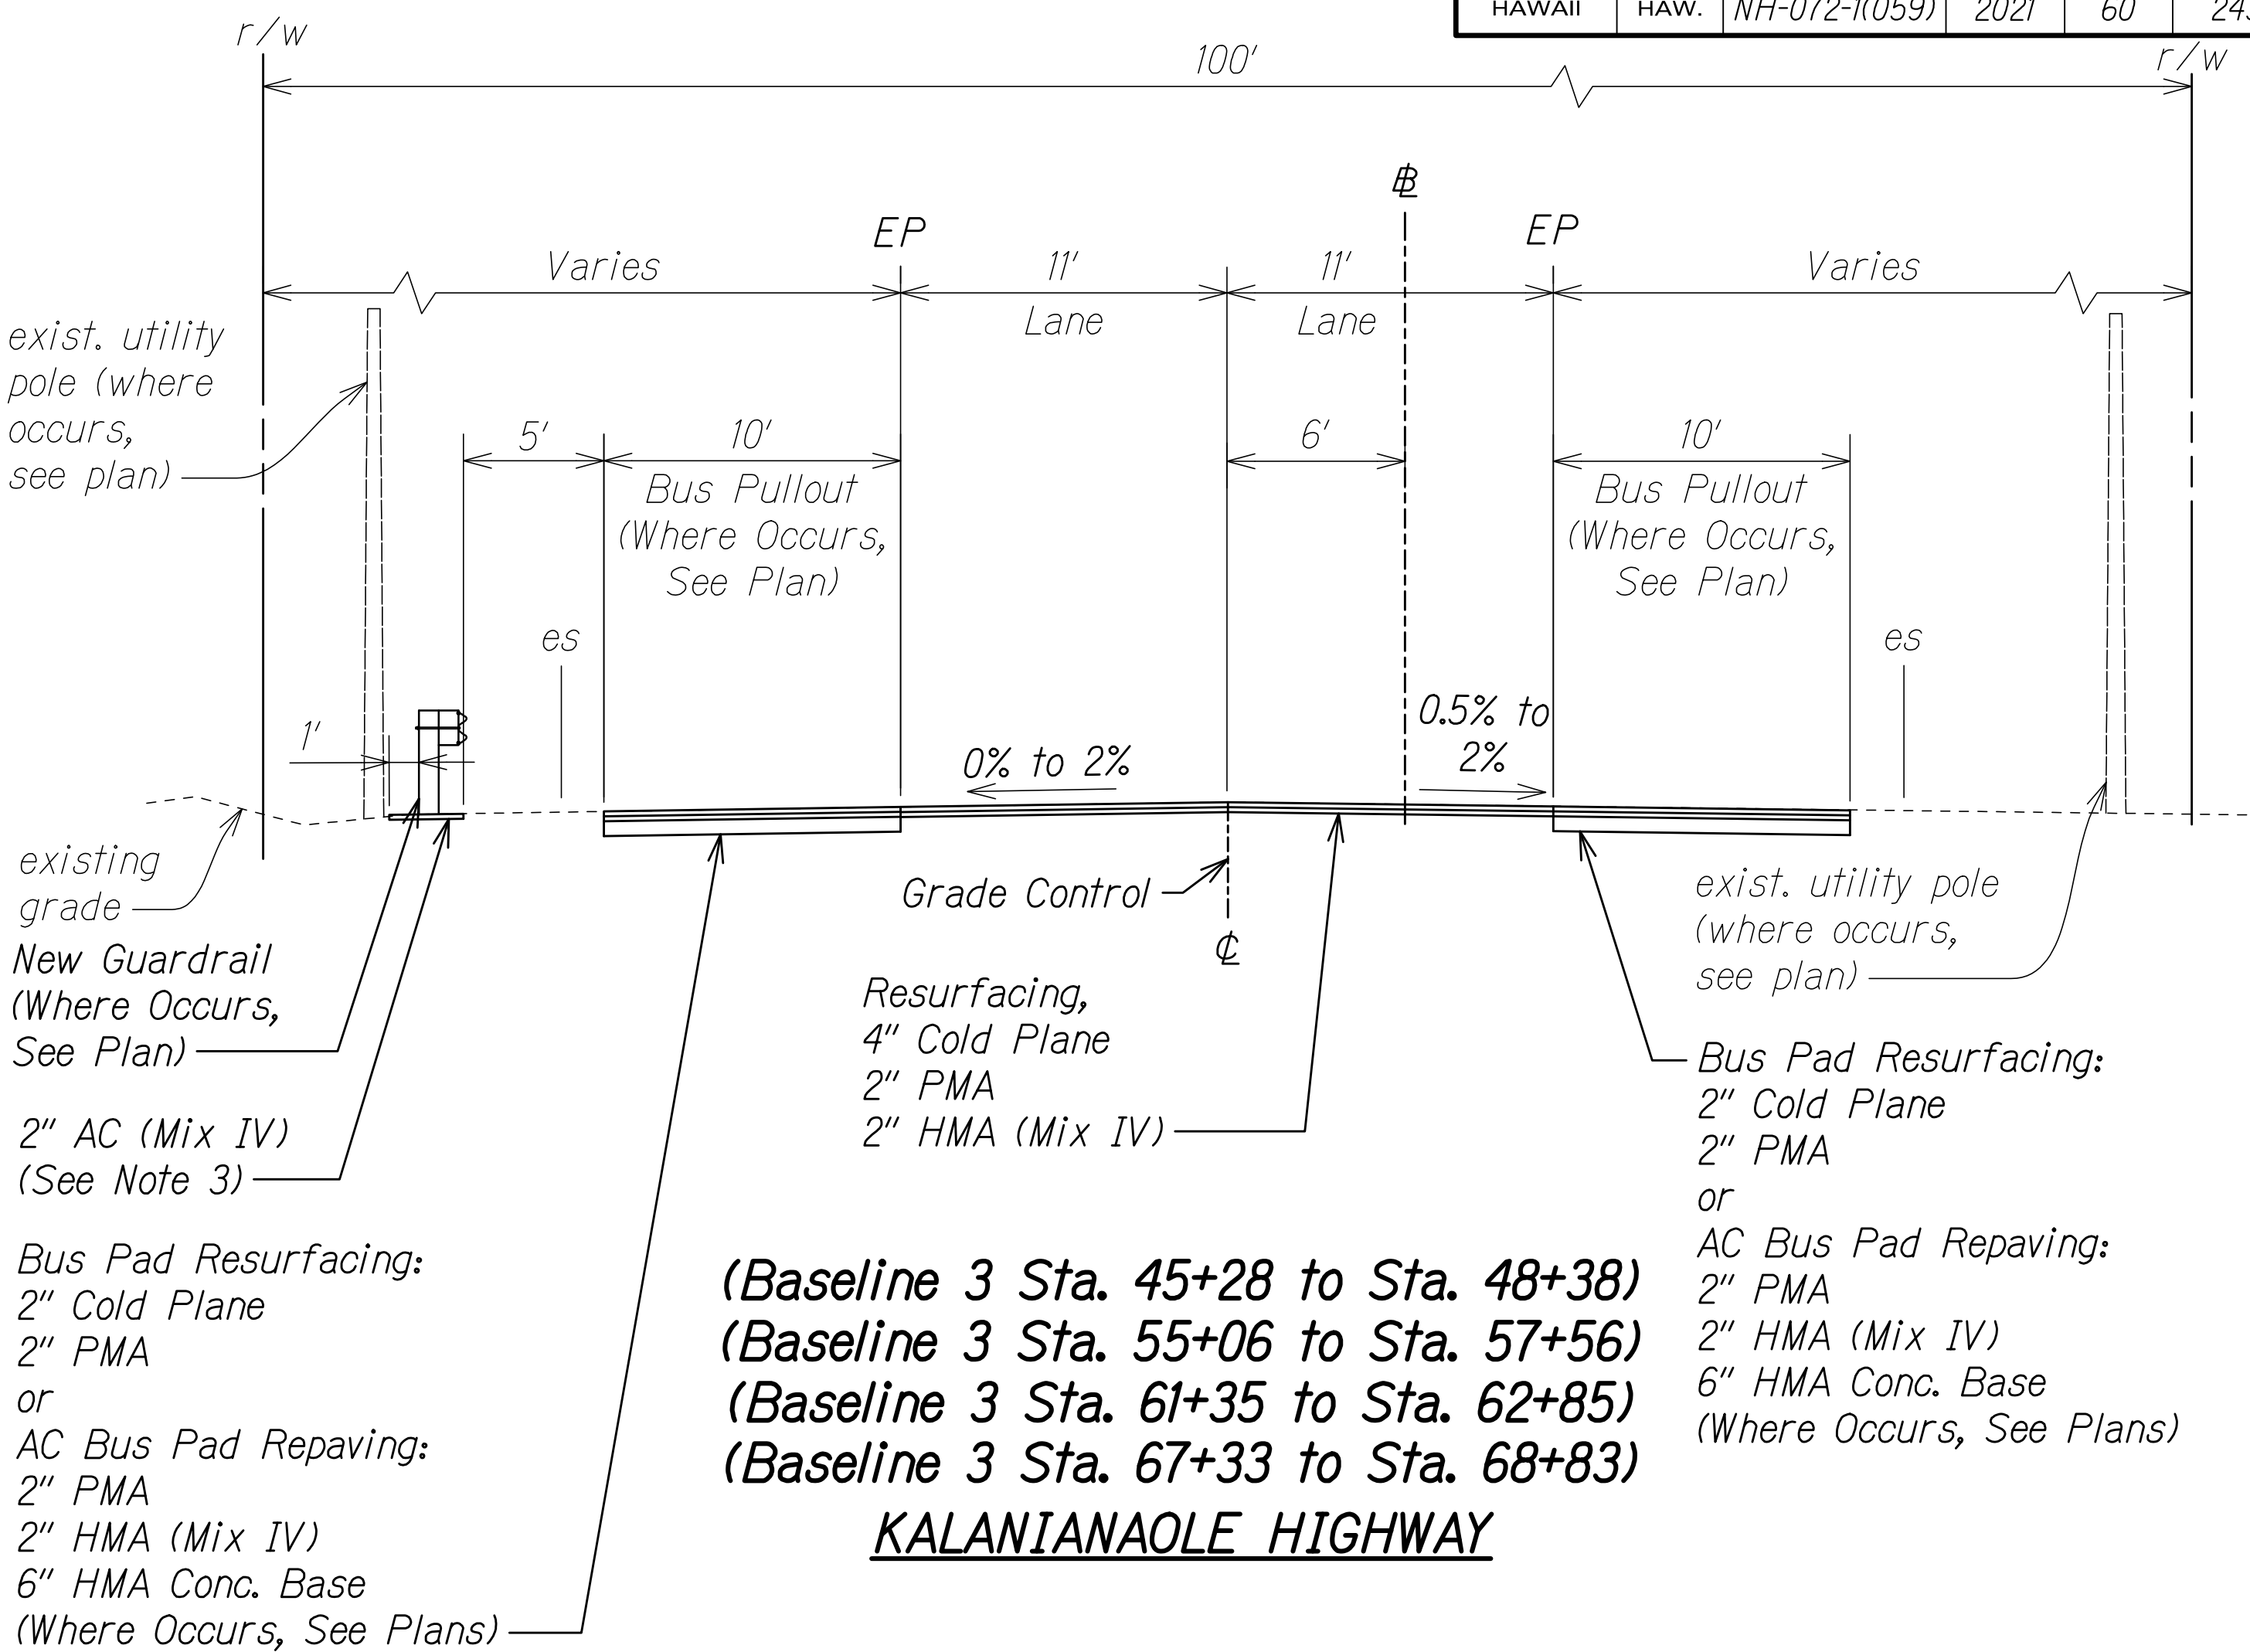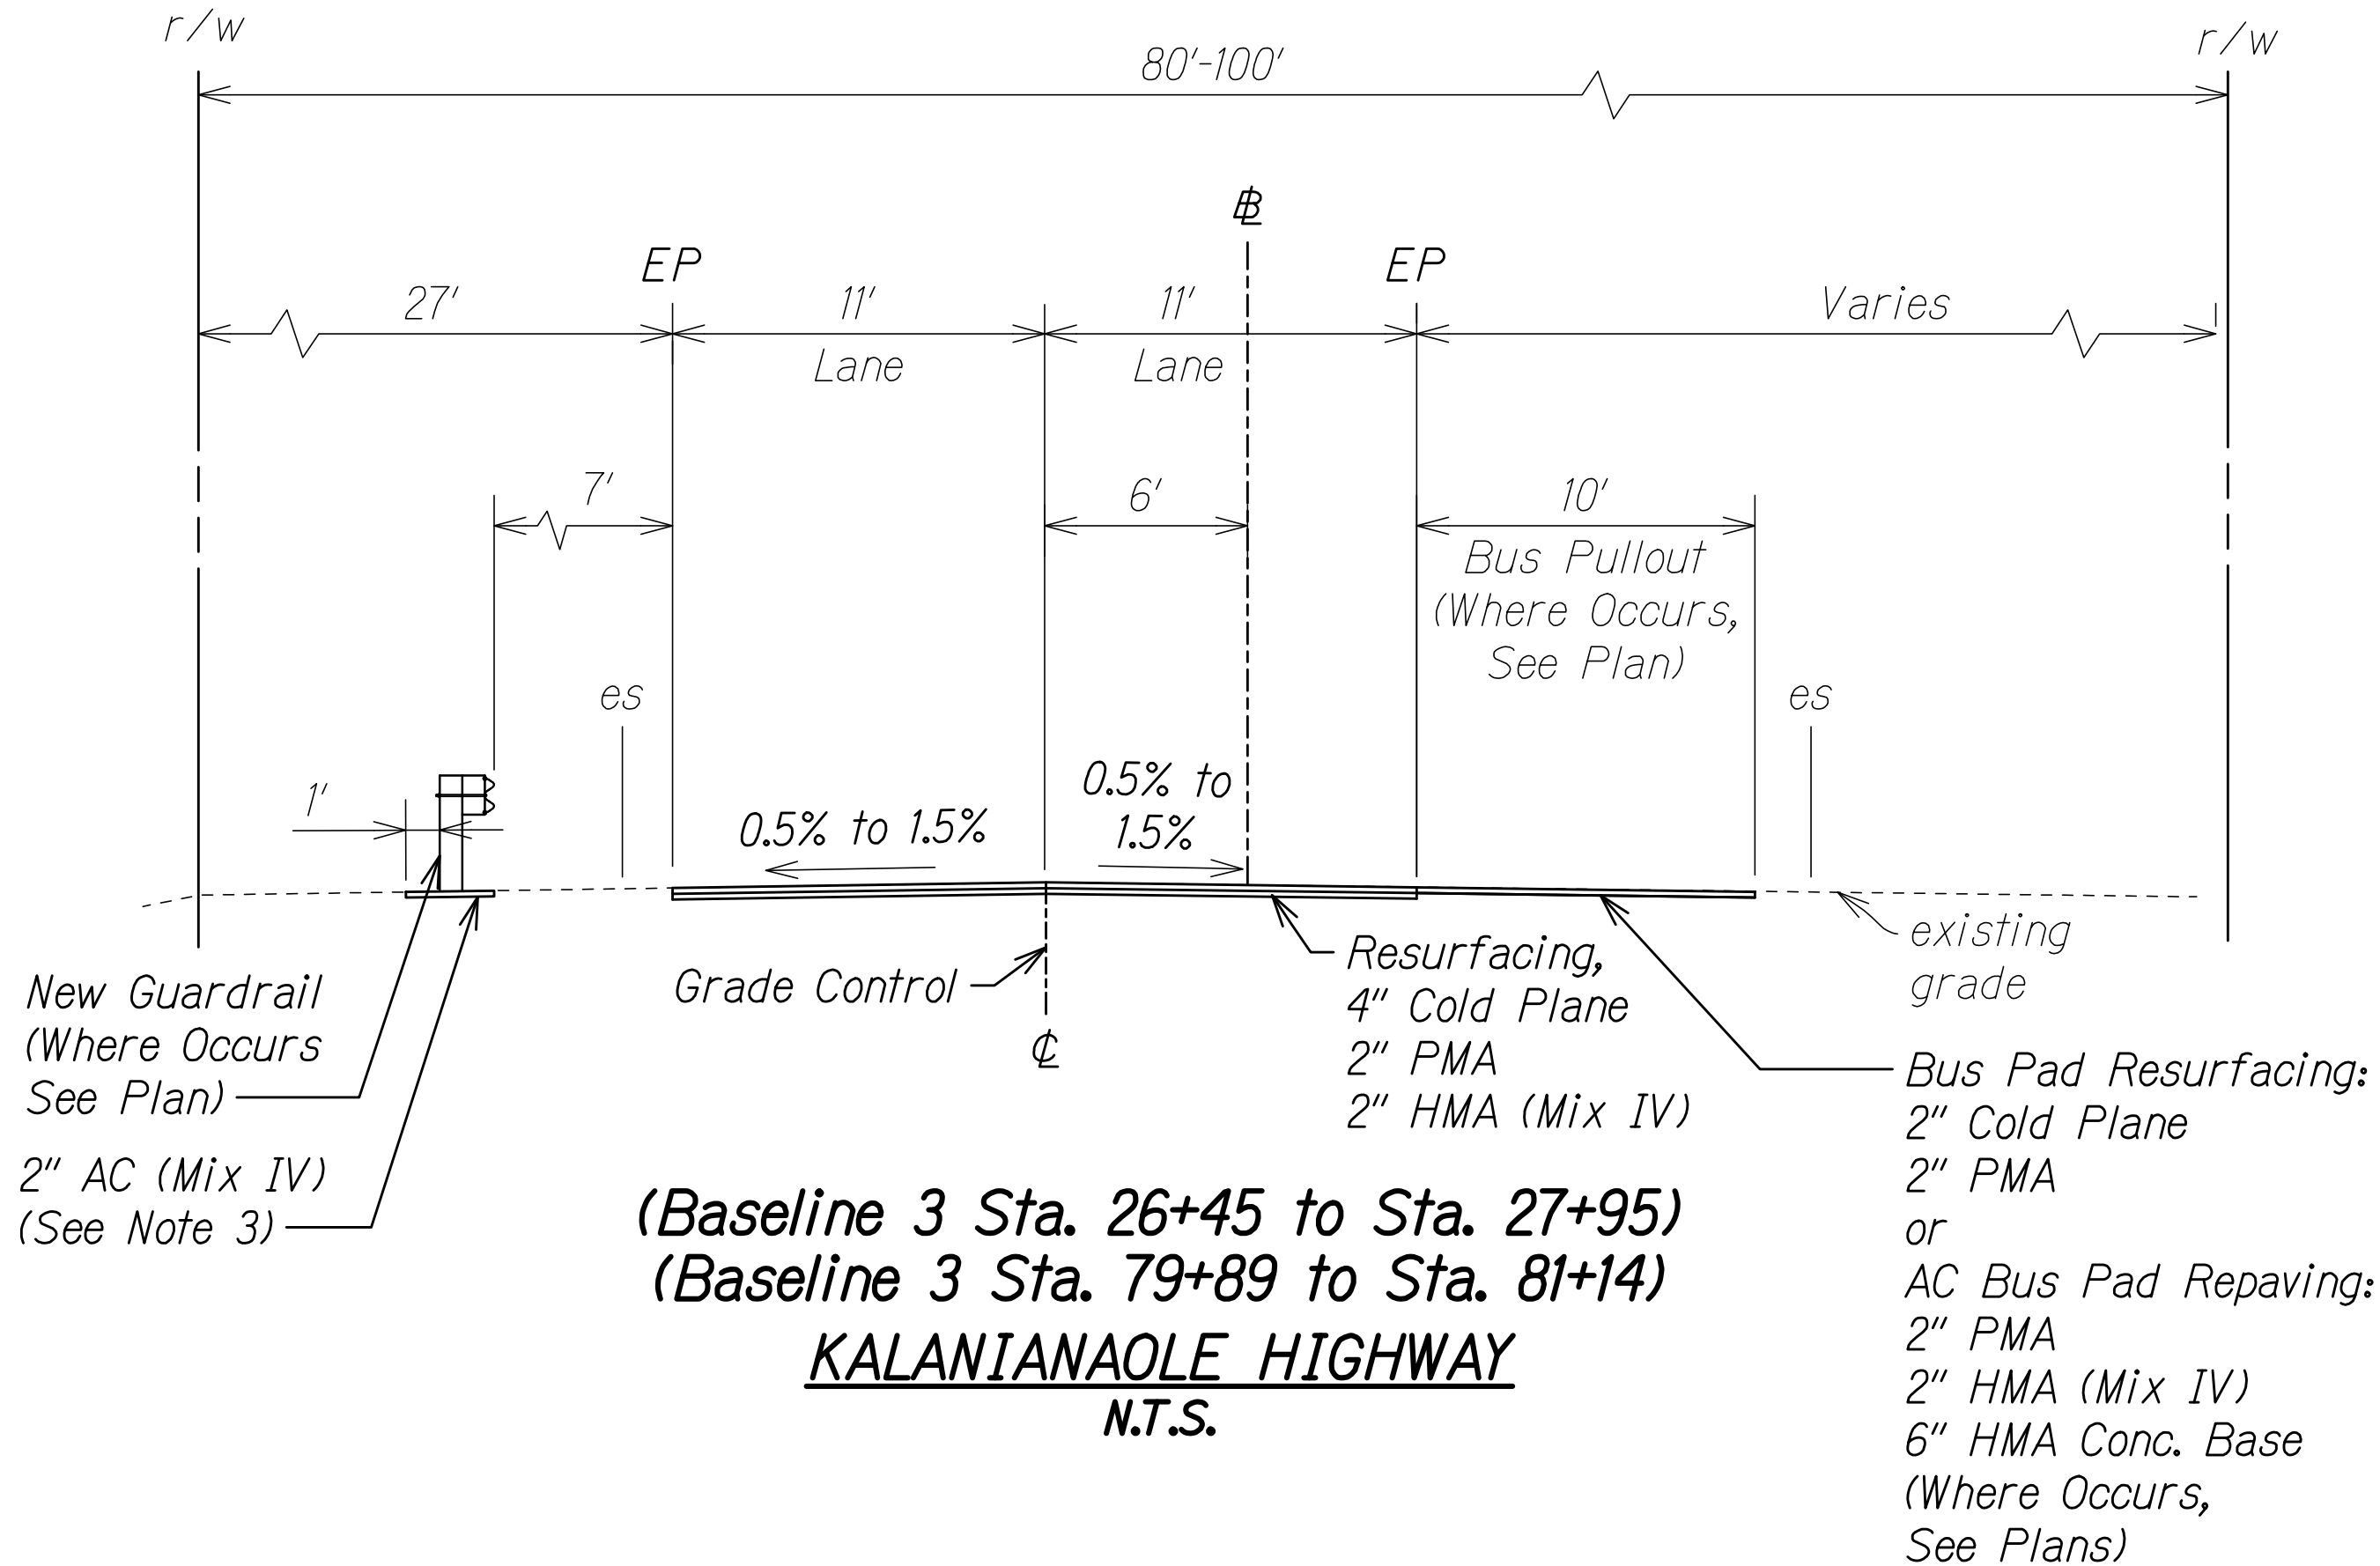

*14.25' AC Swale Paving:
 2" HMA (Mix IV)
 6" HMA Conc. Base
 at Sta. 50+81 to Sta. 55+06

GRAPHIC SCALE:

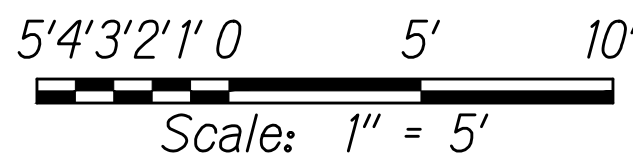

NOTES:

- Limits of AC pavement reconstruction are shown in Roadway Plans, R1 to R43.
- Lane markings are shown in Pavement Markings & Signing Plans, M1 to M44.
- Prior to installation of A.c. Mix No. IV, compact ground to 95% compaction.



THIS WORK WAS PREPARED BY ME
 OR UNDER MY SUPERVISION

[Signature]
 SIGNATURE



04/30/22
 EXPIRATION DATE
 OF THE LICENSE

STATE OF HAWAII
DEPARTMENT OF TRANSPORTATION
HIGHWAYS DIVISION


TYPICAL SECTIONS
KALANIANA'OLE HIGHWAY IMPROVEMENTS PHASE 2
Poolima Street to Vicinity of Makai Pier
Federal-Aid Project No. NH-072-1(059)
Scale: 1" = 5'

Date: January 2021
SHEET No. **C4** OF **27** SHEETS

FED. ROAD DIST. NO.	STATE	FED-AID PROJ. NO.	FISCAL YEAR	SHEET NO.	TOTAL SHEETS
HAWAII	HAW.	NH-072-1(059)	2021	61	243

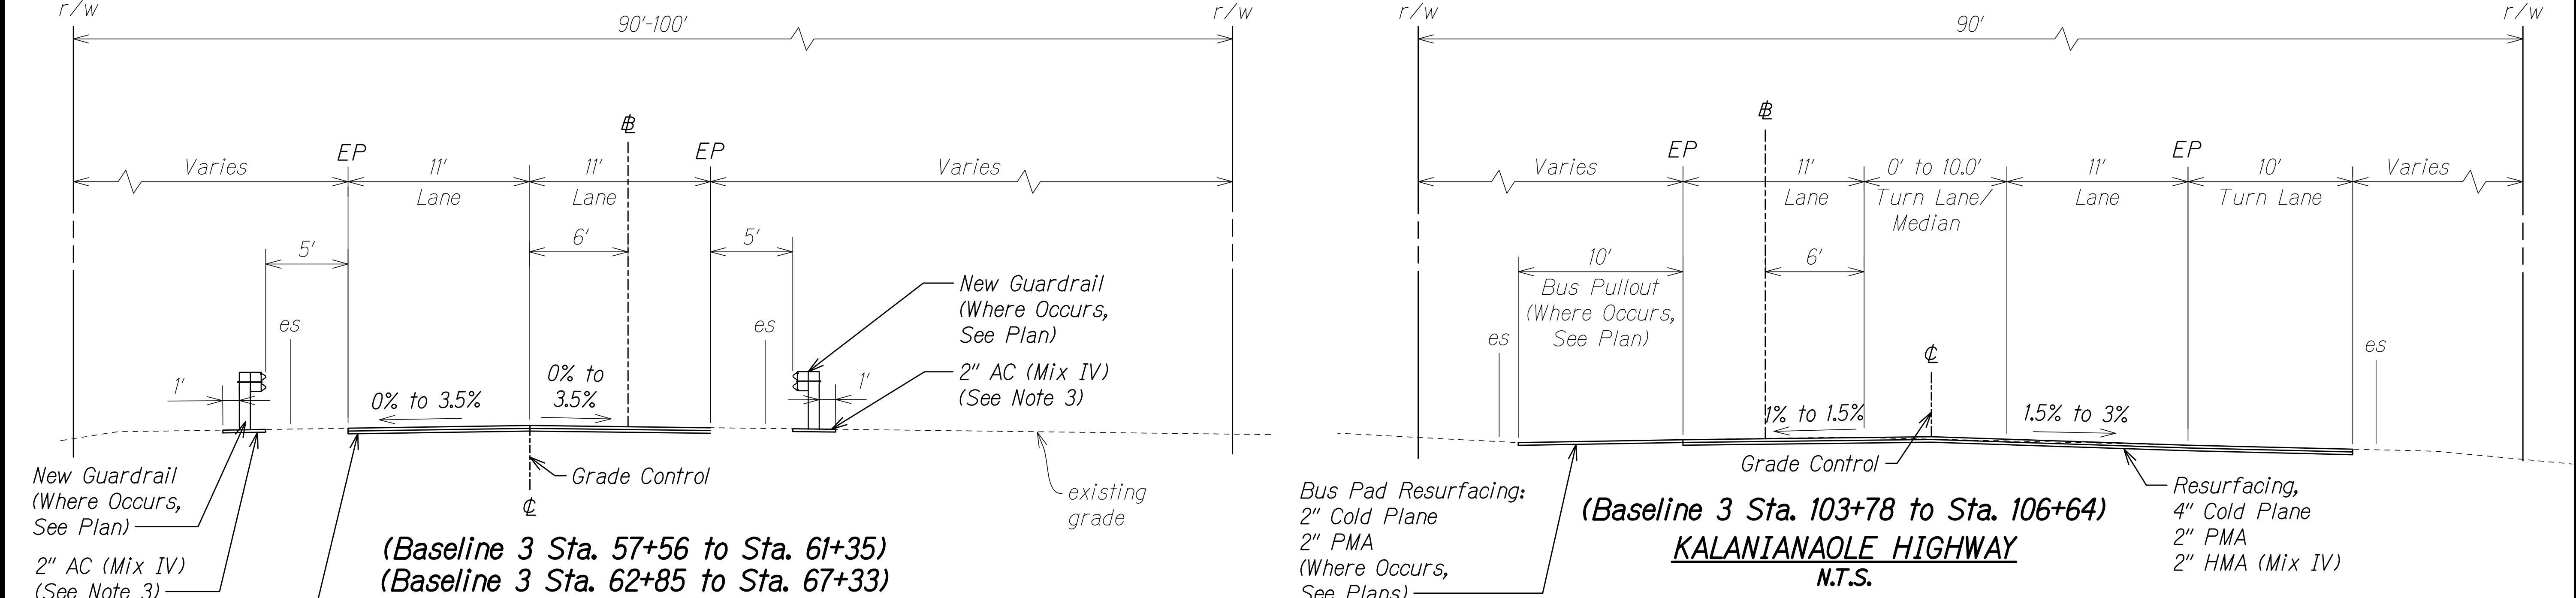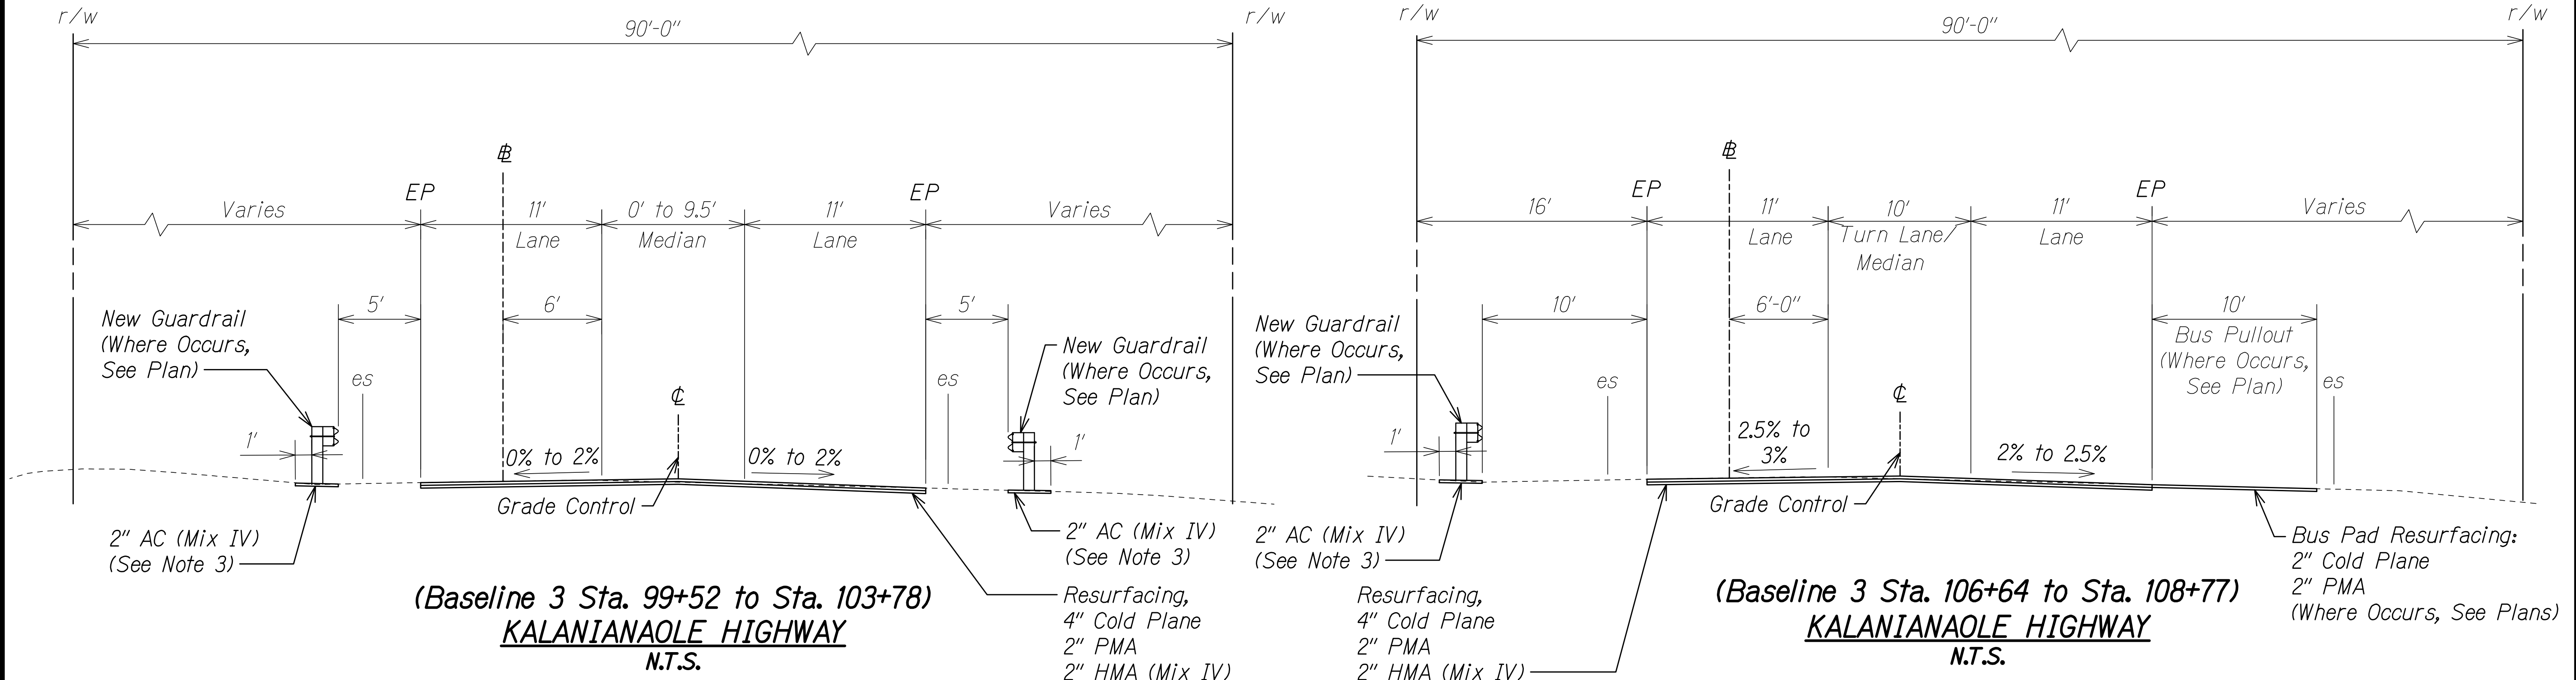

- NOTES:**
- 1. Limits of AC pavement reconstruction are shown in Roadway Plans, R1 to R43.
 - 2. Lane markings are shown in Pavement Markings & Signing Plans, M1 to M44.
 - 3. Prior to installation of A.C. Mix No. IV, compact ground to 95% compaction.

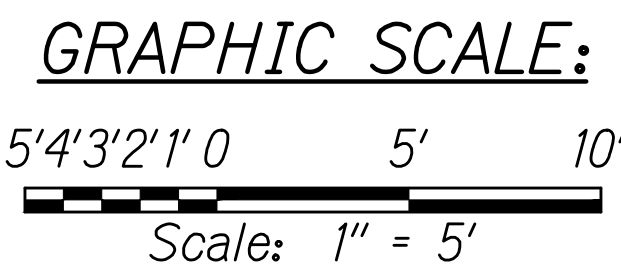

VICTOR O. VALDEZ
LICENSED PROFESSIONAL ENGINEER
NO. 15546-C
HAWAII, USA

THIS WORK WAS PREPARED BY ME OR UNDER MY SUPERVISION

Signature: [Signature]
EXPIRATION DATE OF THE LICENSE: 04/30/22

STATE OF HAWAII
DEPARTMENT OF TRANSPORTATION
HIGHWAYS DIVISION

TYPICAL SECTIONS

KALANIANA'OLE HIGHWAY IMPROVEMENTS PHASE 2
Poalima Street to Vicinity of Makai Pier
Federal-Aid Project No. NH-072-1(059)

Scale: 1" = 5' Date: January 2021

SHEET No. C5 OF 27 SHEETS