



FED. ROAD DIST. NO.	STATE	PROJECT NO.	FISCAL YEAR	SHEET NO.	TOTAL SHEETS
HAWAII	HAW.	72A-02-06	2008	8	66

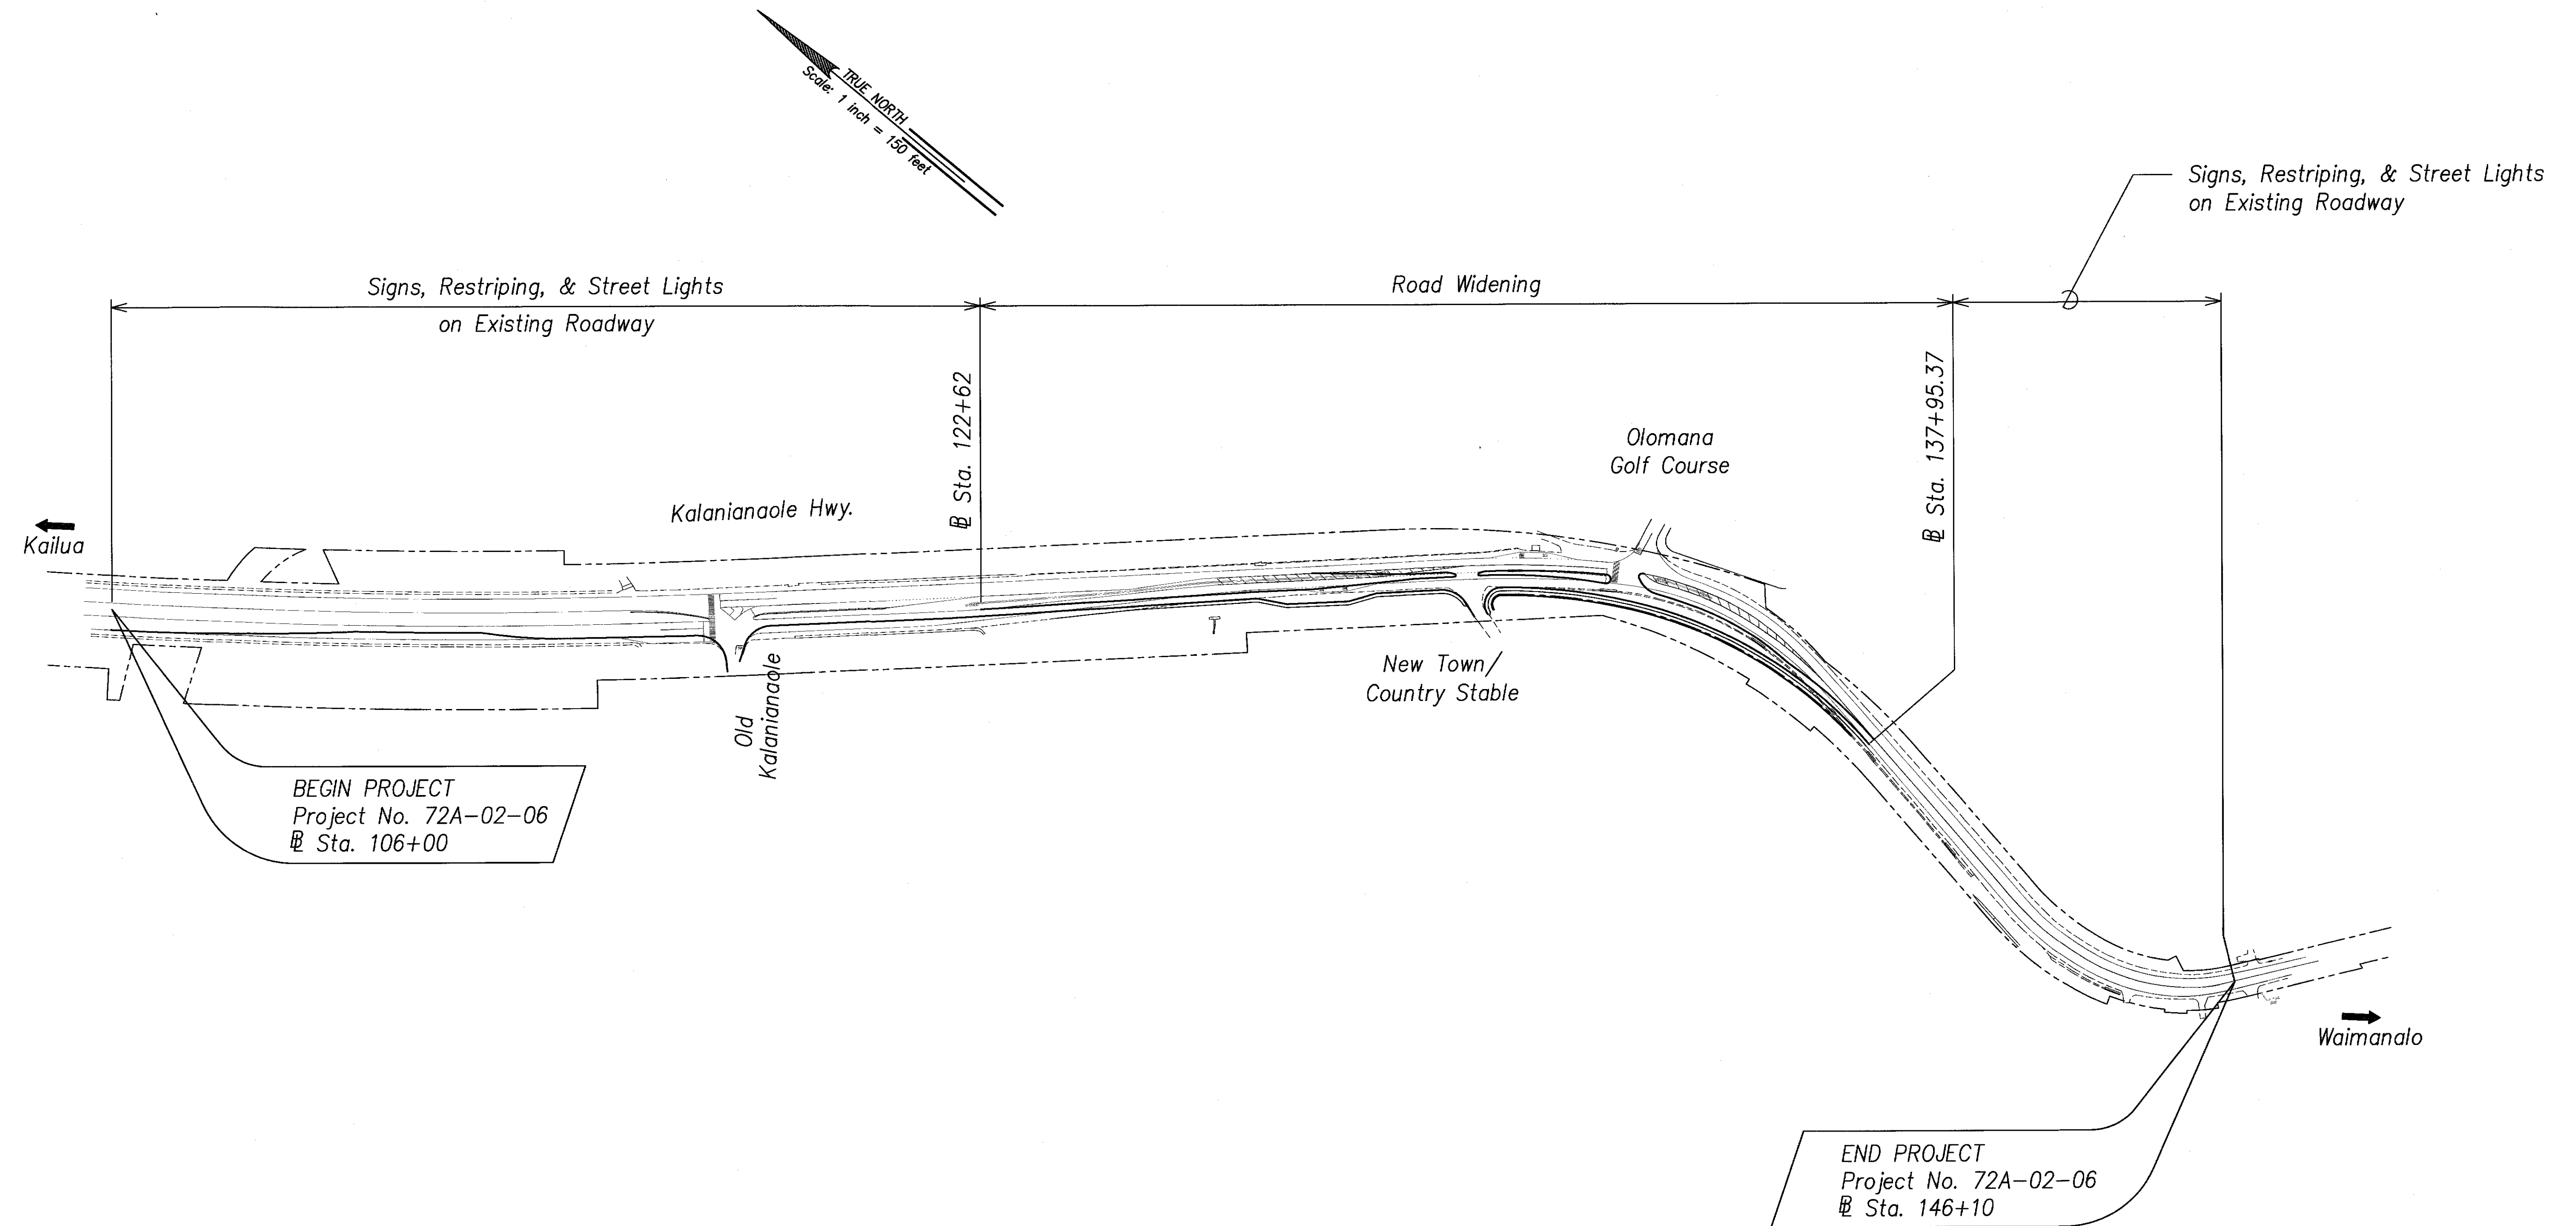

ORIGINAL PLAN	SURVEY PLOTTED BY	DATE
NOTE BOOK	DRAWN BY	
	DESIGNED BY	
	CHECKED BY	
No.		

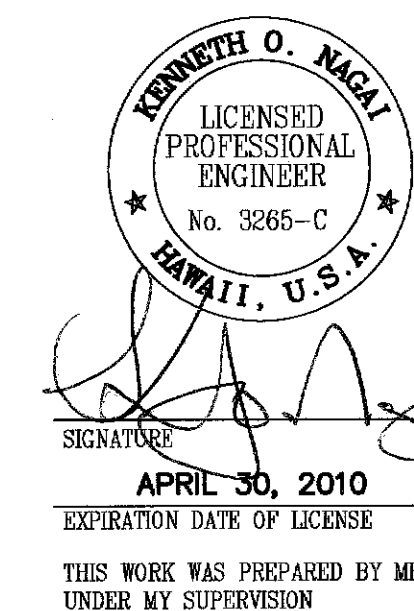

STATE OF HAWAII
DEPARTMENT OF TRANSPORTATION
HIGHWAYS DIVISION

GENERAL SITE PLAN

**KALANIANAʻOLE HIGHWAY MEDIAN
IMPROVEMENTS VICINITY OF OLOMANA
GOLF COURSE PROJECT NO. 72A-02-06**

SCALE: 1"=150' DATE: June 2008

SHEET No. C-6 OF 43 SHEETS

"AS-BUILT"