



FED. ROAD DIST. NO.	STATE	PROJECT NO.	FISCAL YEAR	SHEET NO.	TOTAL SHEETS
HAWAII	HAW.	72A-02-06	2008	38	66

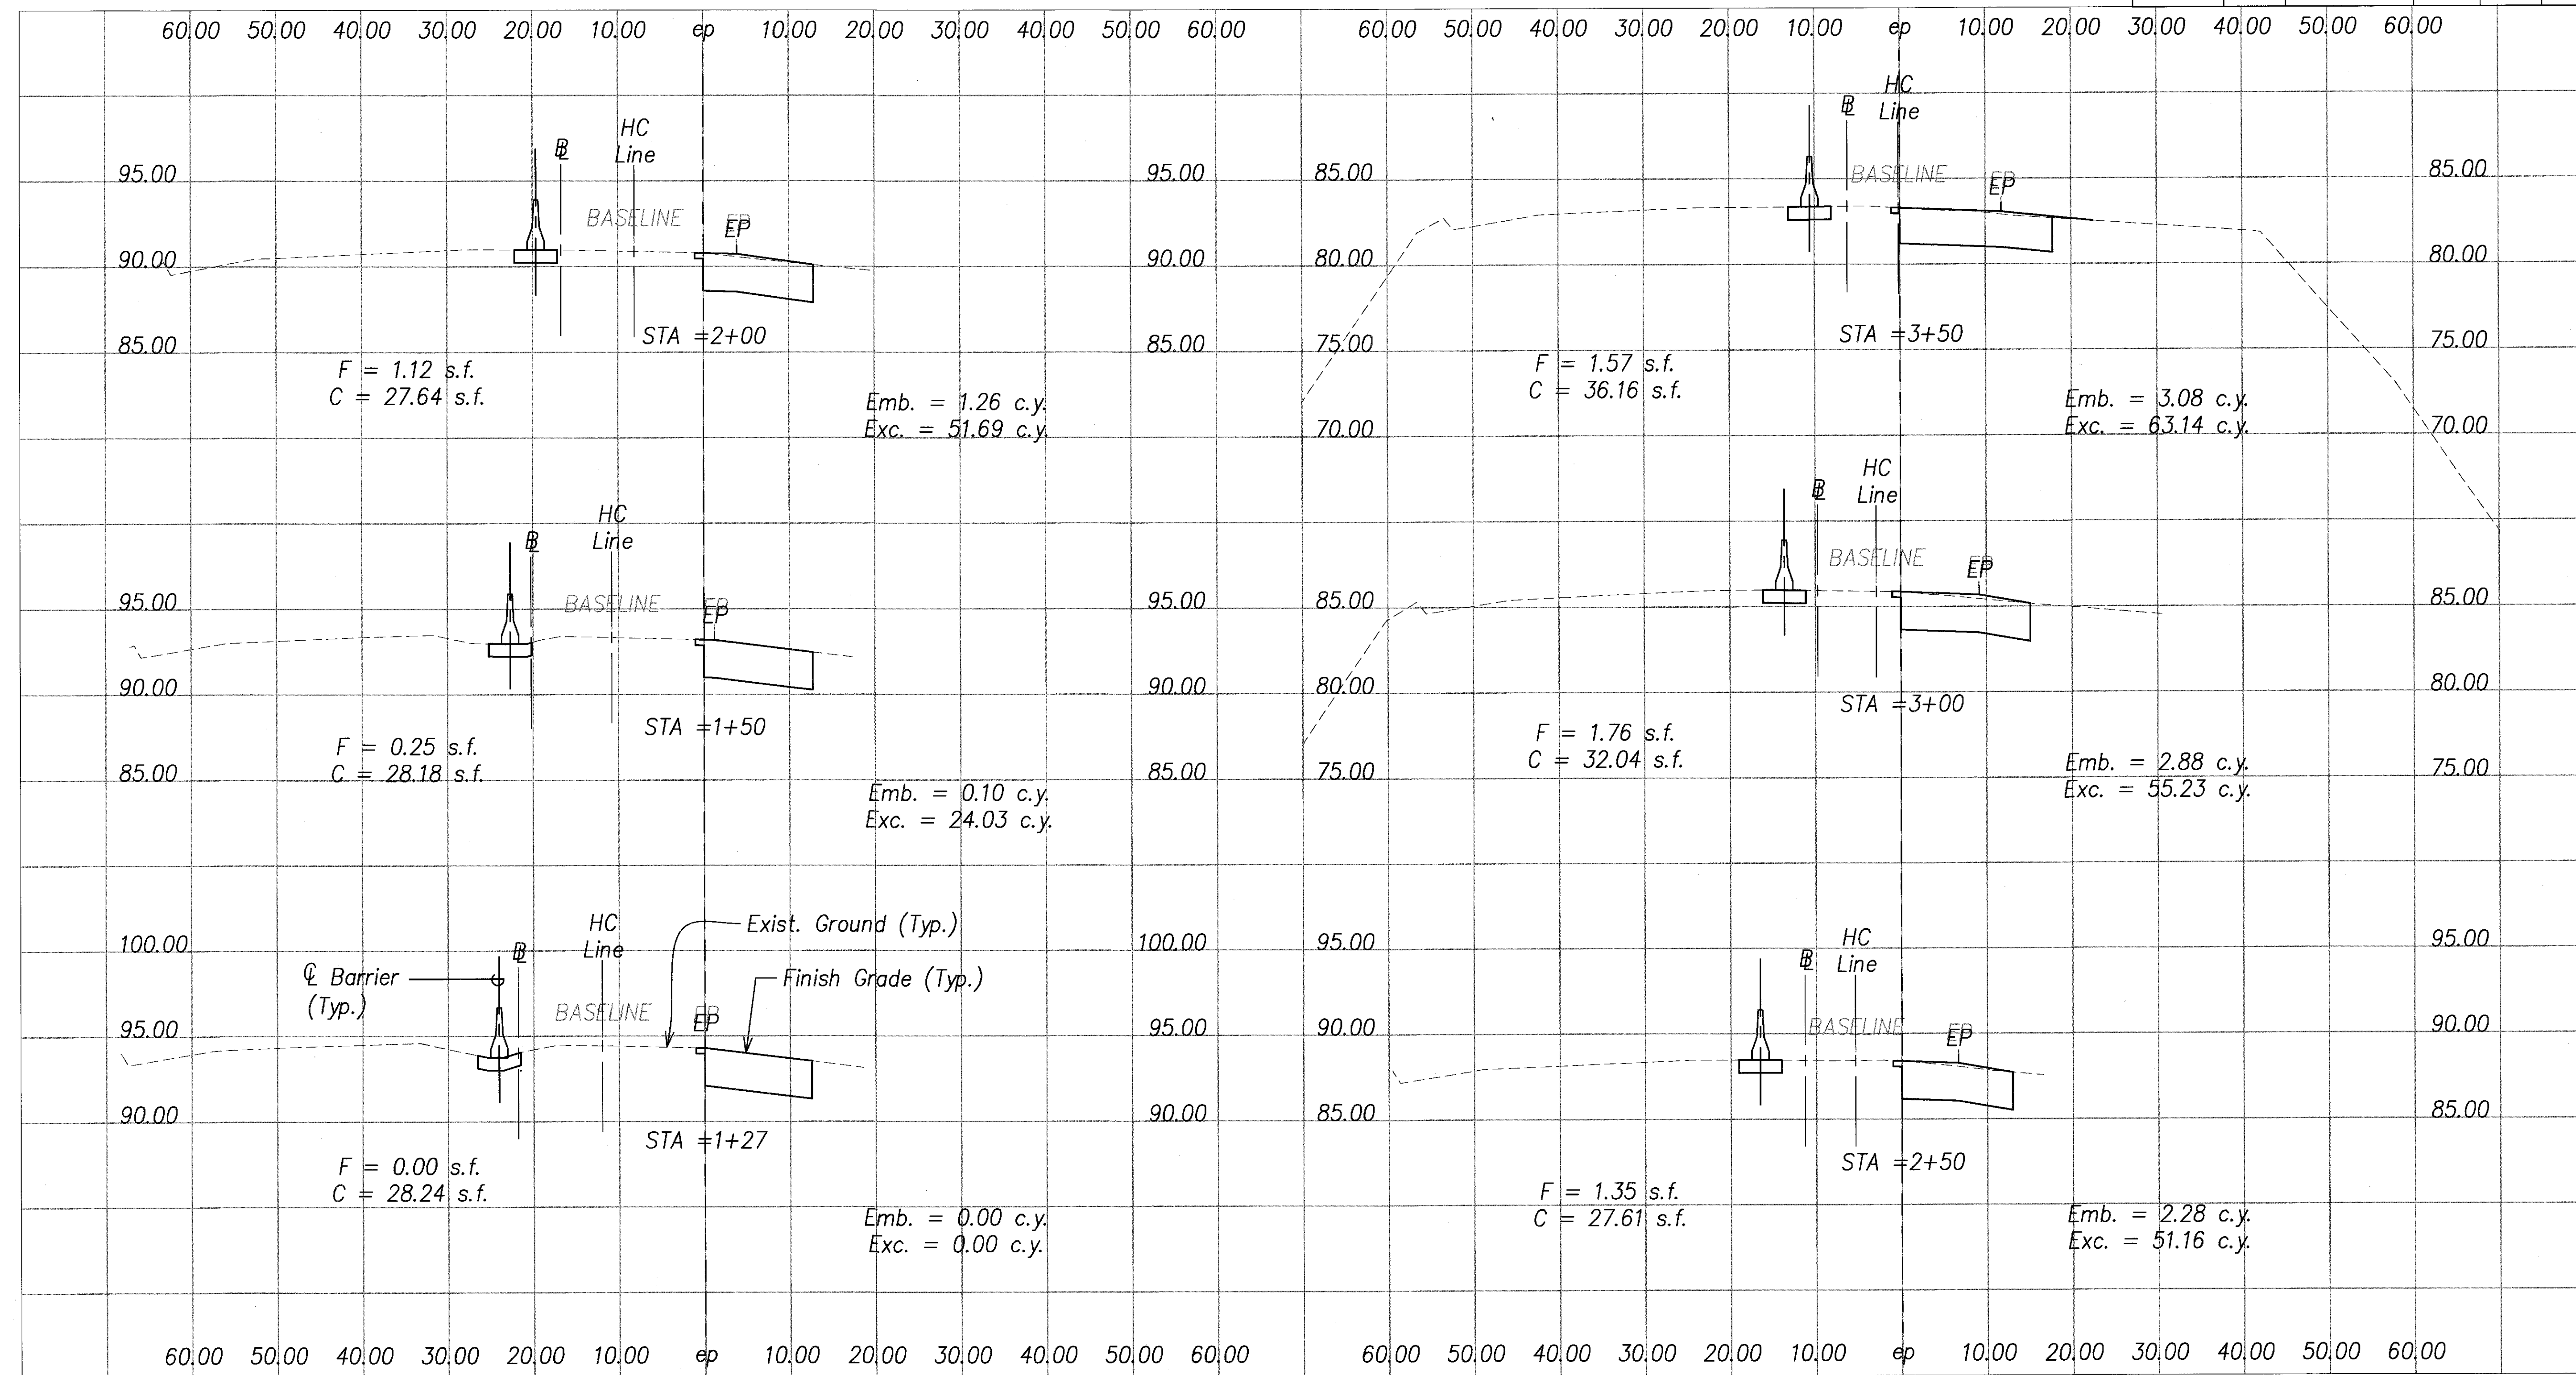

SURVEY PLOTTED BY	DATE
DESIGNED BY	
NOTED BY	
CHECKED BY	
ORIGINAL PLAN	
NOTE BOOK	
No.	

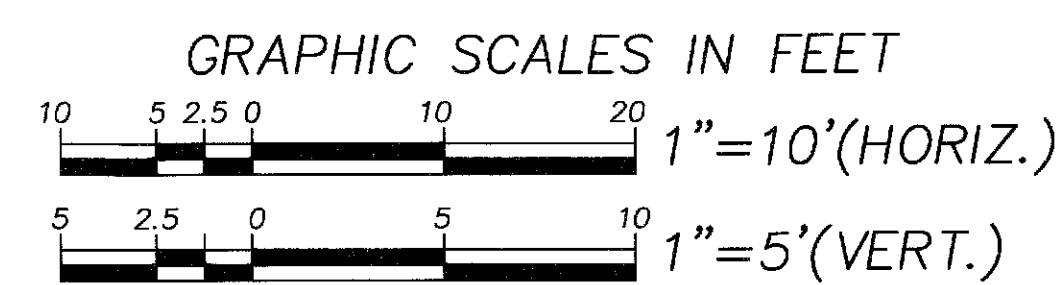

KENNETH O. NAGAI
LICENSED PROFESSIONAL ENGINEER
No. 3265-C
HAWAII, U.S.A.


SIGNATURE
APRIL 30, 2010
EXPIRATION DATE OF LICENSE
THIS WORK WAS PREPARED BY ME OR UNDER MY SUPERVISION

STATE OF HAWAII
DEPARTMENT OF TRANSPORTATION
HIGHWAYS DIVISION


KALANIANA'OLE HWY. CROSS SECTIONS
HC STA. 1+27 TO 3+50
KALANIANA'OLE HIGHWAY MEDIAN
IMPROVEMENTS VICINITY OF OLOMANA
GOLF COURSE PROJECT NO. 72A-02-06

SCALE: (H)1"=10'; (V)1"=5' DATE: June 2008
SHEET No. C-36 OF 43 SHEETS

FED. ROAD DIST. NO.	STATE	PROJECT NO.	FISCAL YEAR	SHEET NO.	TOTAL SHEETS
HAWAII	HAW.	72A-02-06	2008	39	66

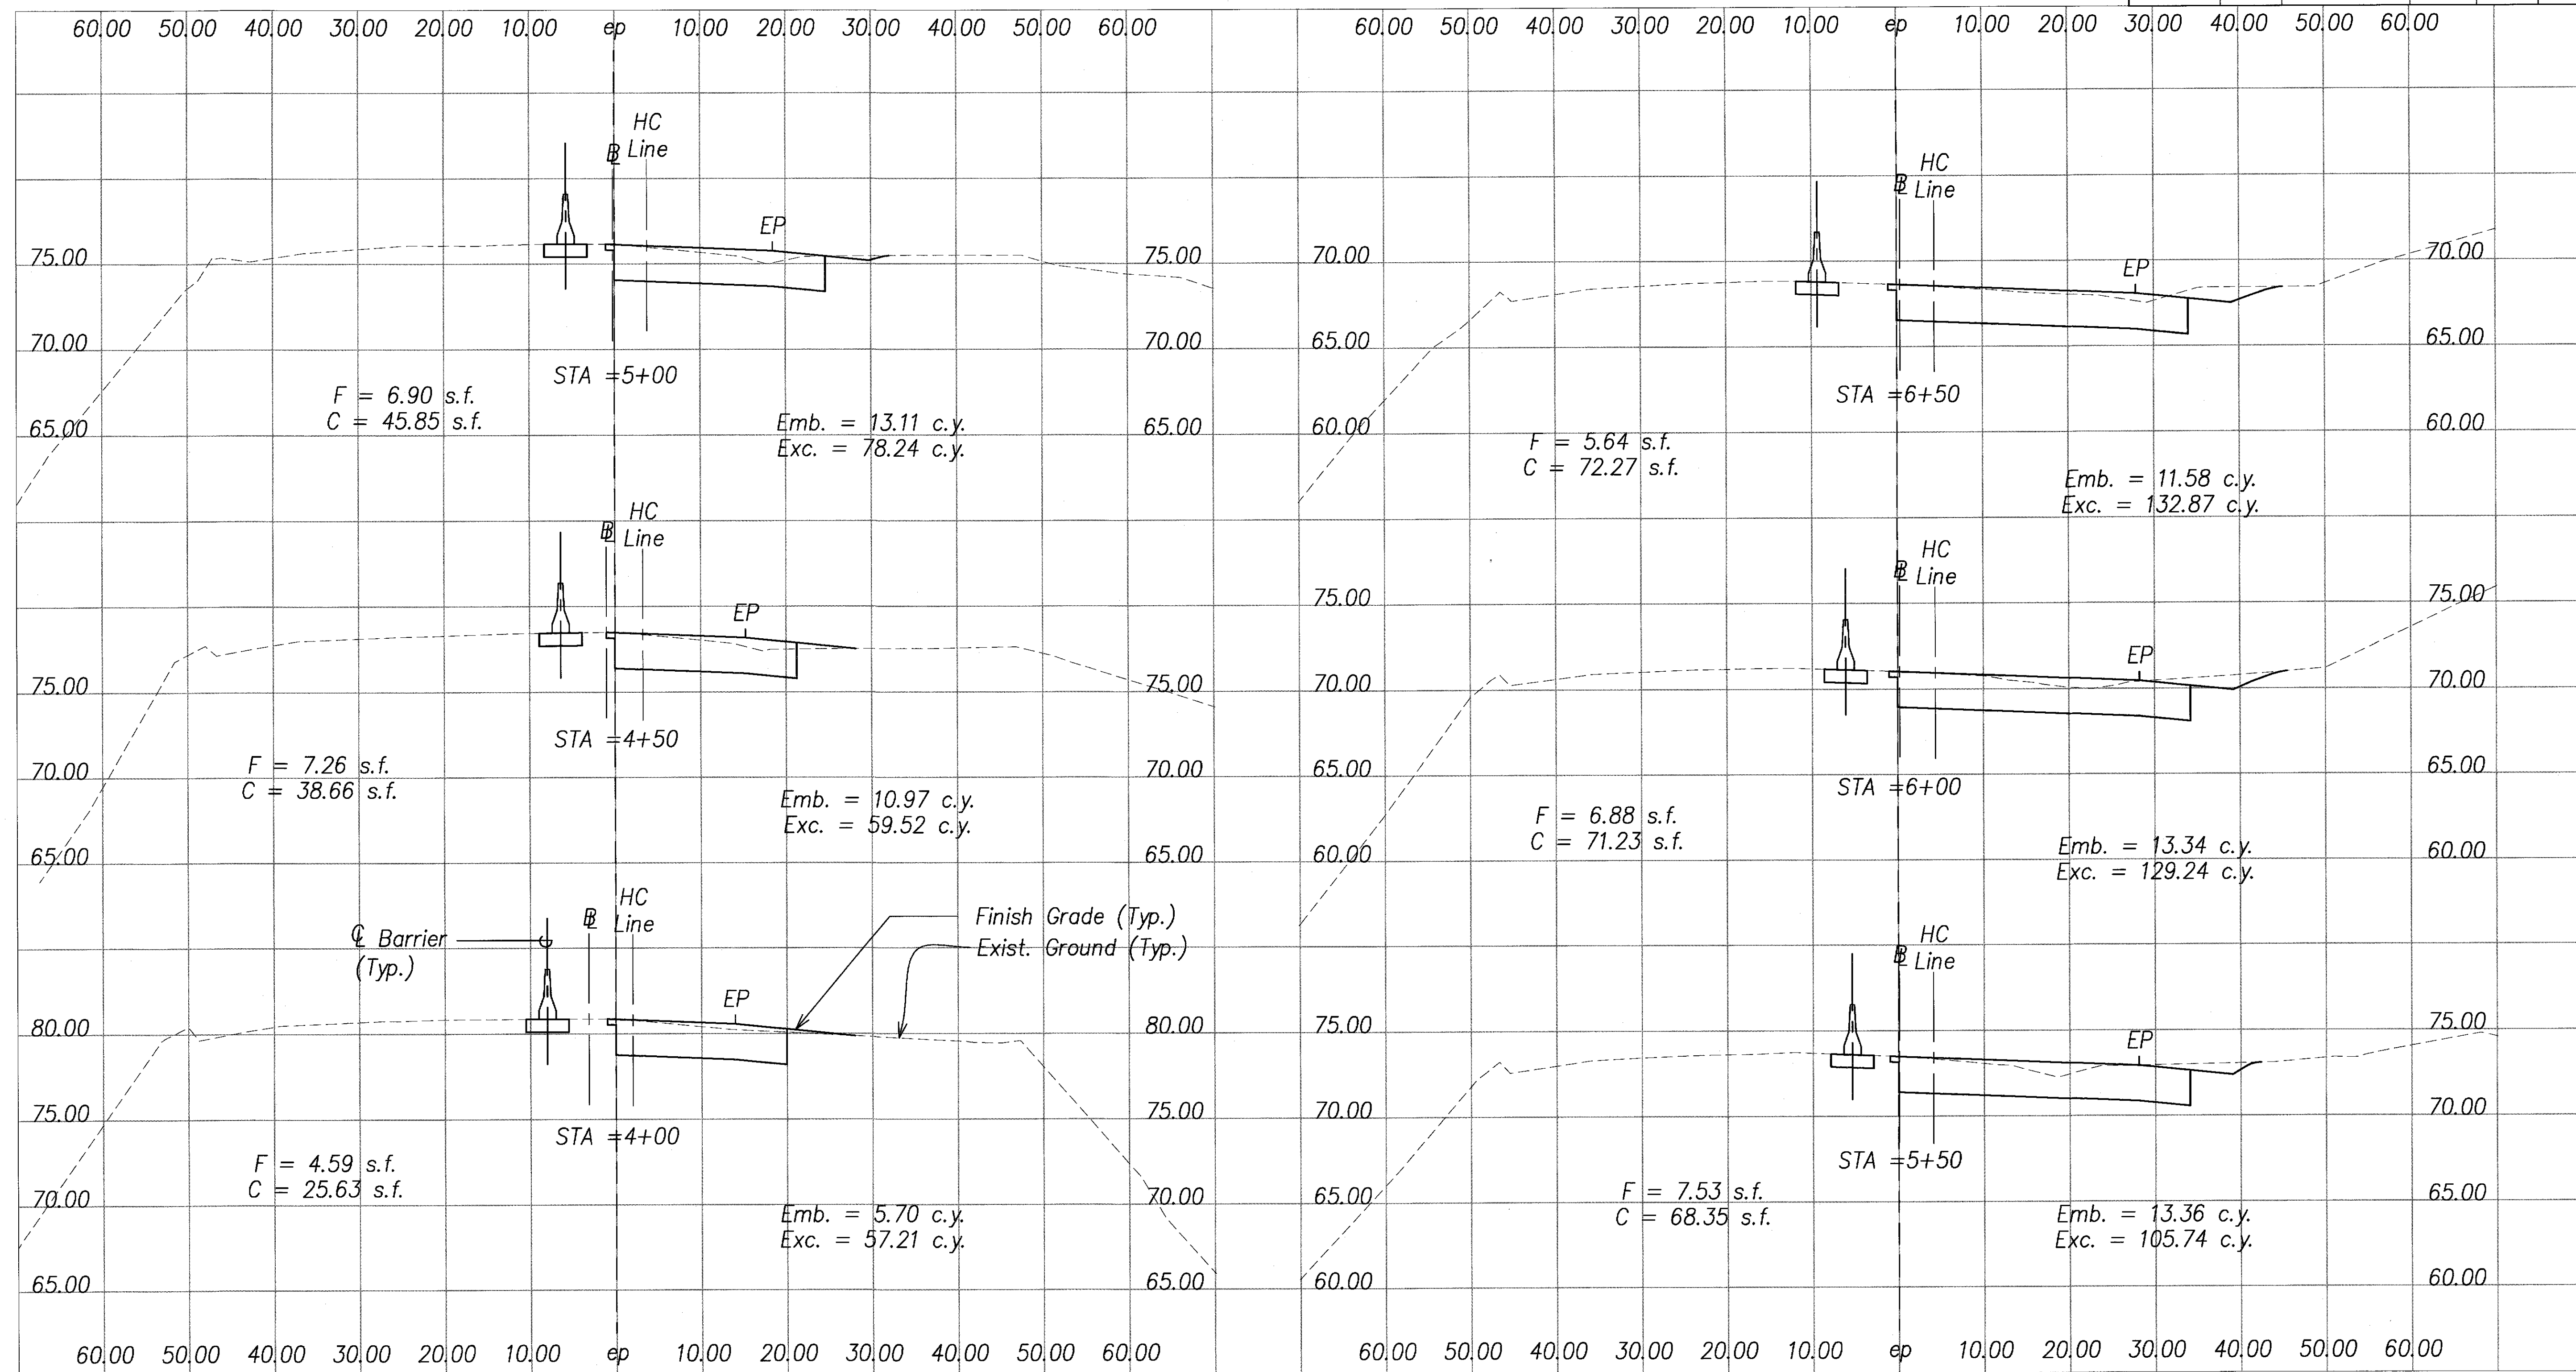


SURVEY PLOTTED BY _____ DATE _____
 DESIGNED BY _____
 CHECKED BY _____
 ORIGINAL PLAN _____
 NOTE BOOK _____
 No. _____

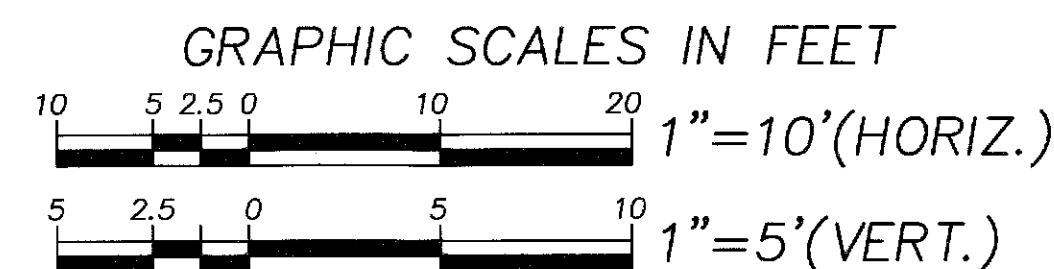



KENNETH O. NAGAI
 LICENSED PROFESSIONAL ENGINEER
 No. 3285-C
 HAWAII, U.S.A.
 APRIL 30, 2010
 EXPIRATION DATE OF LICENSE
 THIS WORK WAS PREPARED BY ME OR UNDER MY SUPERVISION

STATE OF HAWAII
 DEPARTMENT OF TRANSPORTATION
 HIGHWAYS DIVISION
KALANIANA'OLE HWY. CROSS SECTIONS
HC STA. 4+00 TO 6+50
KALANIANA'OLE HIGHWAY MEDIAN
IMPROVEMENTS VICINITY OF OLOMANA
GOLF COURSE PROJECT NO. 72A-02-06
 SCALE: (H)1"=10', (V)1"=5' DATE: June 2008
 SHEET No. C-37 OF 43 SHEETS

FED. ROAD DIST. NO.	STATE	PROJECT NO.	FISCAL YEAR	SHEET NO.	TOTAL SHEETS
HAWAII	HAW.	72A-02-06	2008	40	66

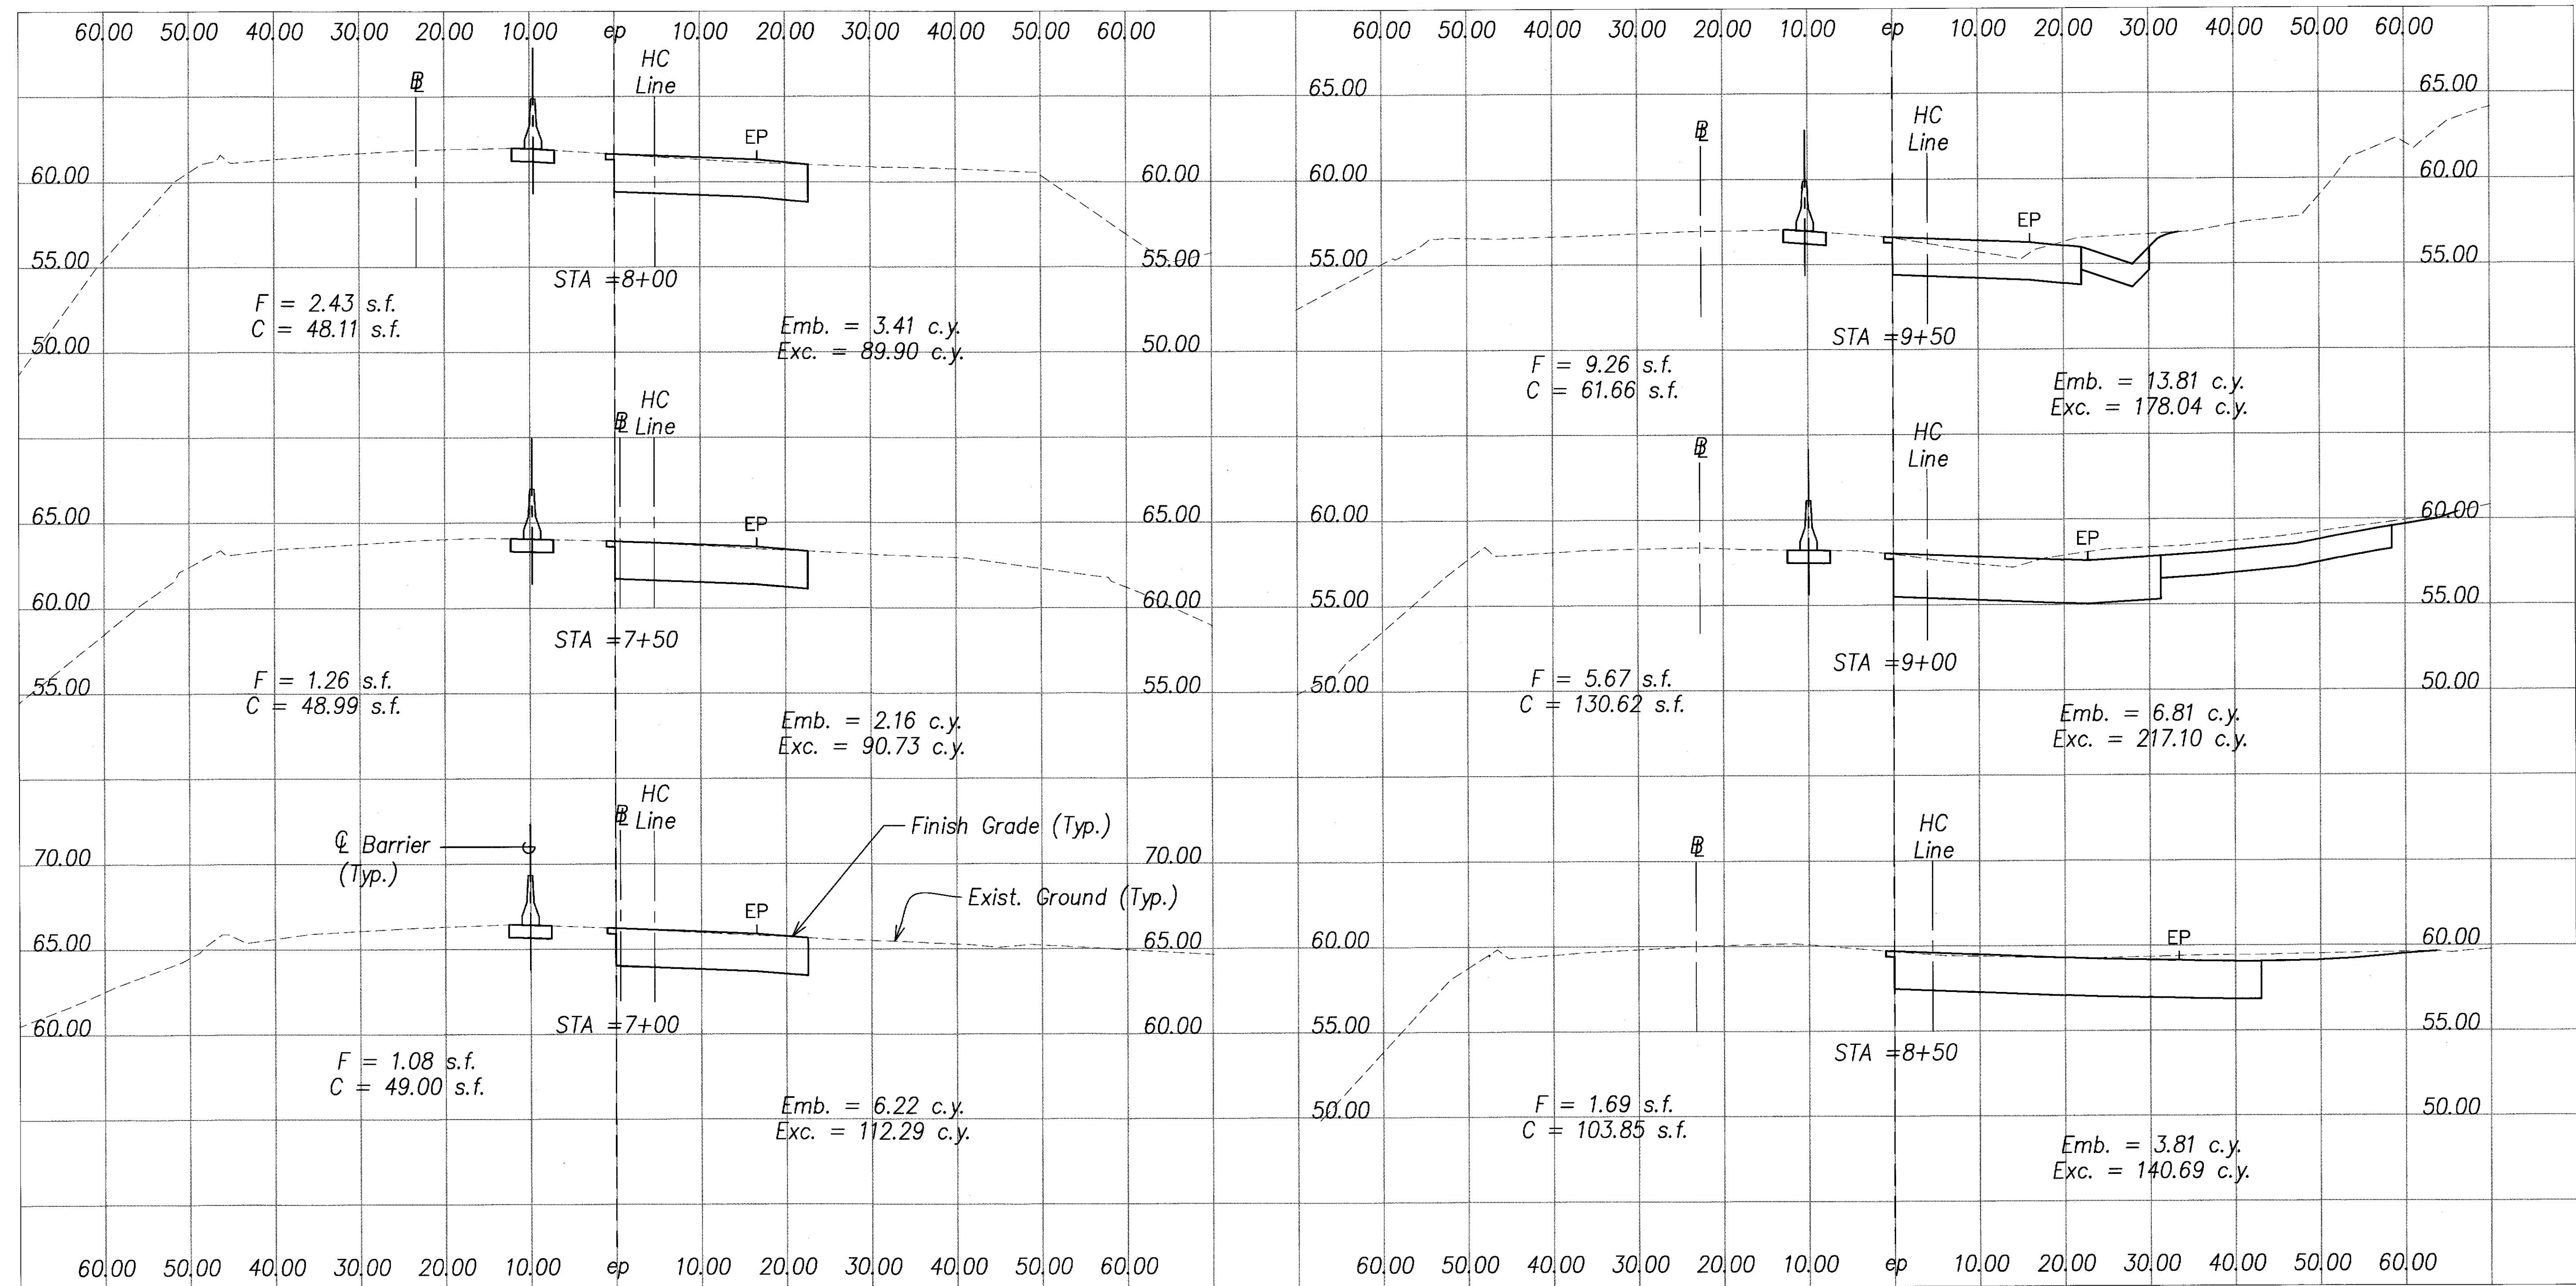

ORIGINAL PLAN	SURVEY PLOTTED BY	DATE
	DESIGNED BY	
	QUANTITIES BY	
	CHECKED BY	
No.		

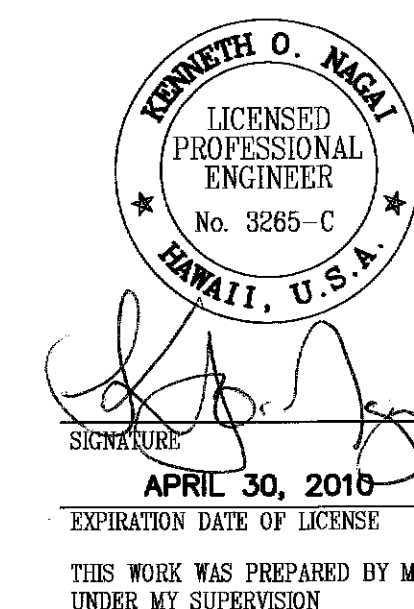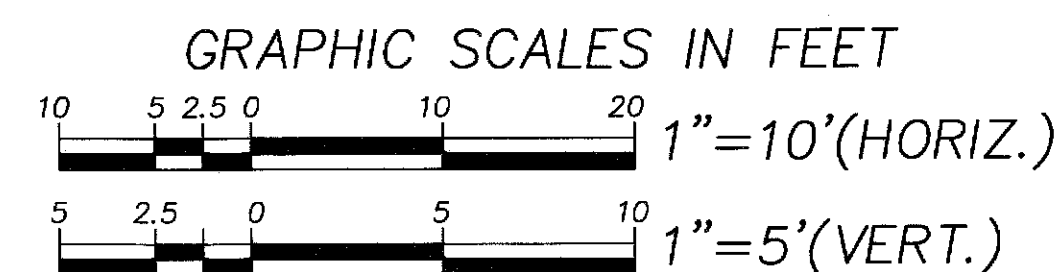


STATE OF HAWAII
DEPARTMENT OF TRANSPORTATION
HIGHWAYS DIVISION

KALANIANAʻOLE HWY. CROSS SECTIONS
HC STA. 7+00 TO 9+50
KALANIANAʻOLE HIGHWAY MEDIAN
IMPROVEMENTS VICINITY OF OLOMANA
GOLF COURSE PROJECT NO. 72A-02-06


SCALE: (H)1"=10'; (V)1"=5' DATE: June 2008

SHEET No. C-38 OF 43 SHEETS

FED. ROAD DIST. NO.	STATE	PROJECT NO.	FISCAL YEAR	SHEET NO.	TOTAL SHEETS
HAWAII	HAW.	72A-02-06	2008	41	66

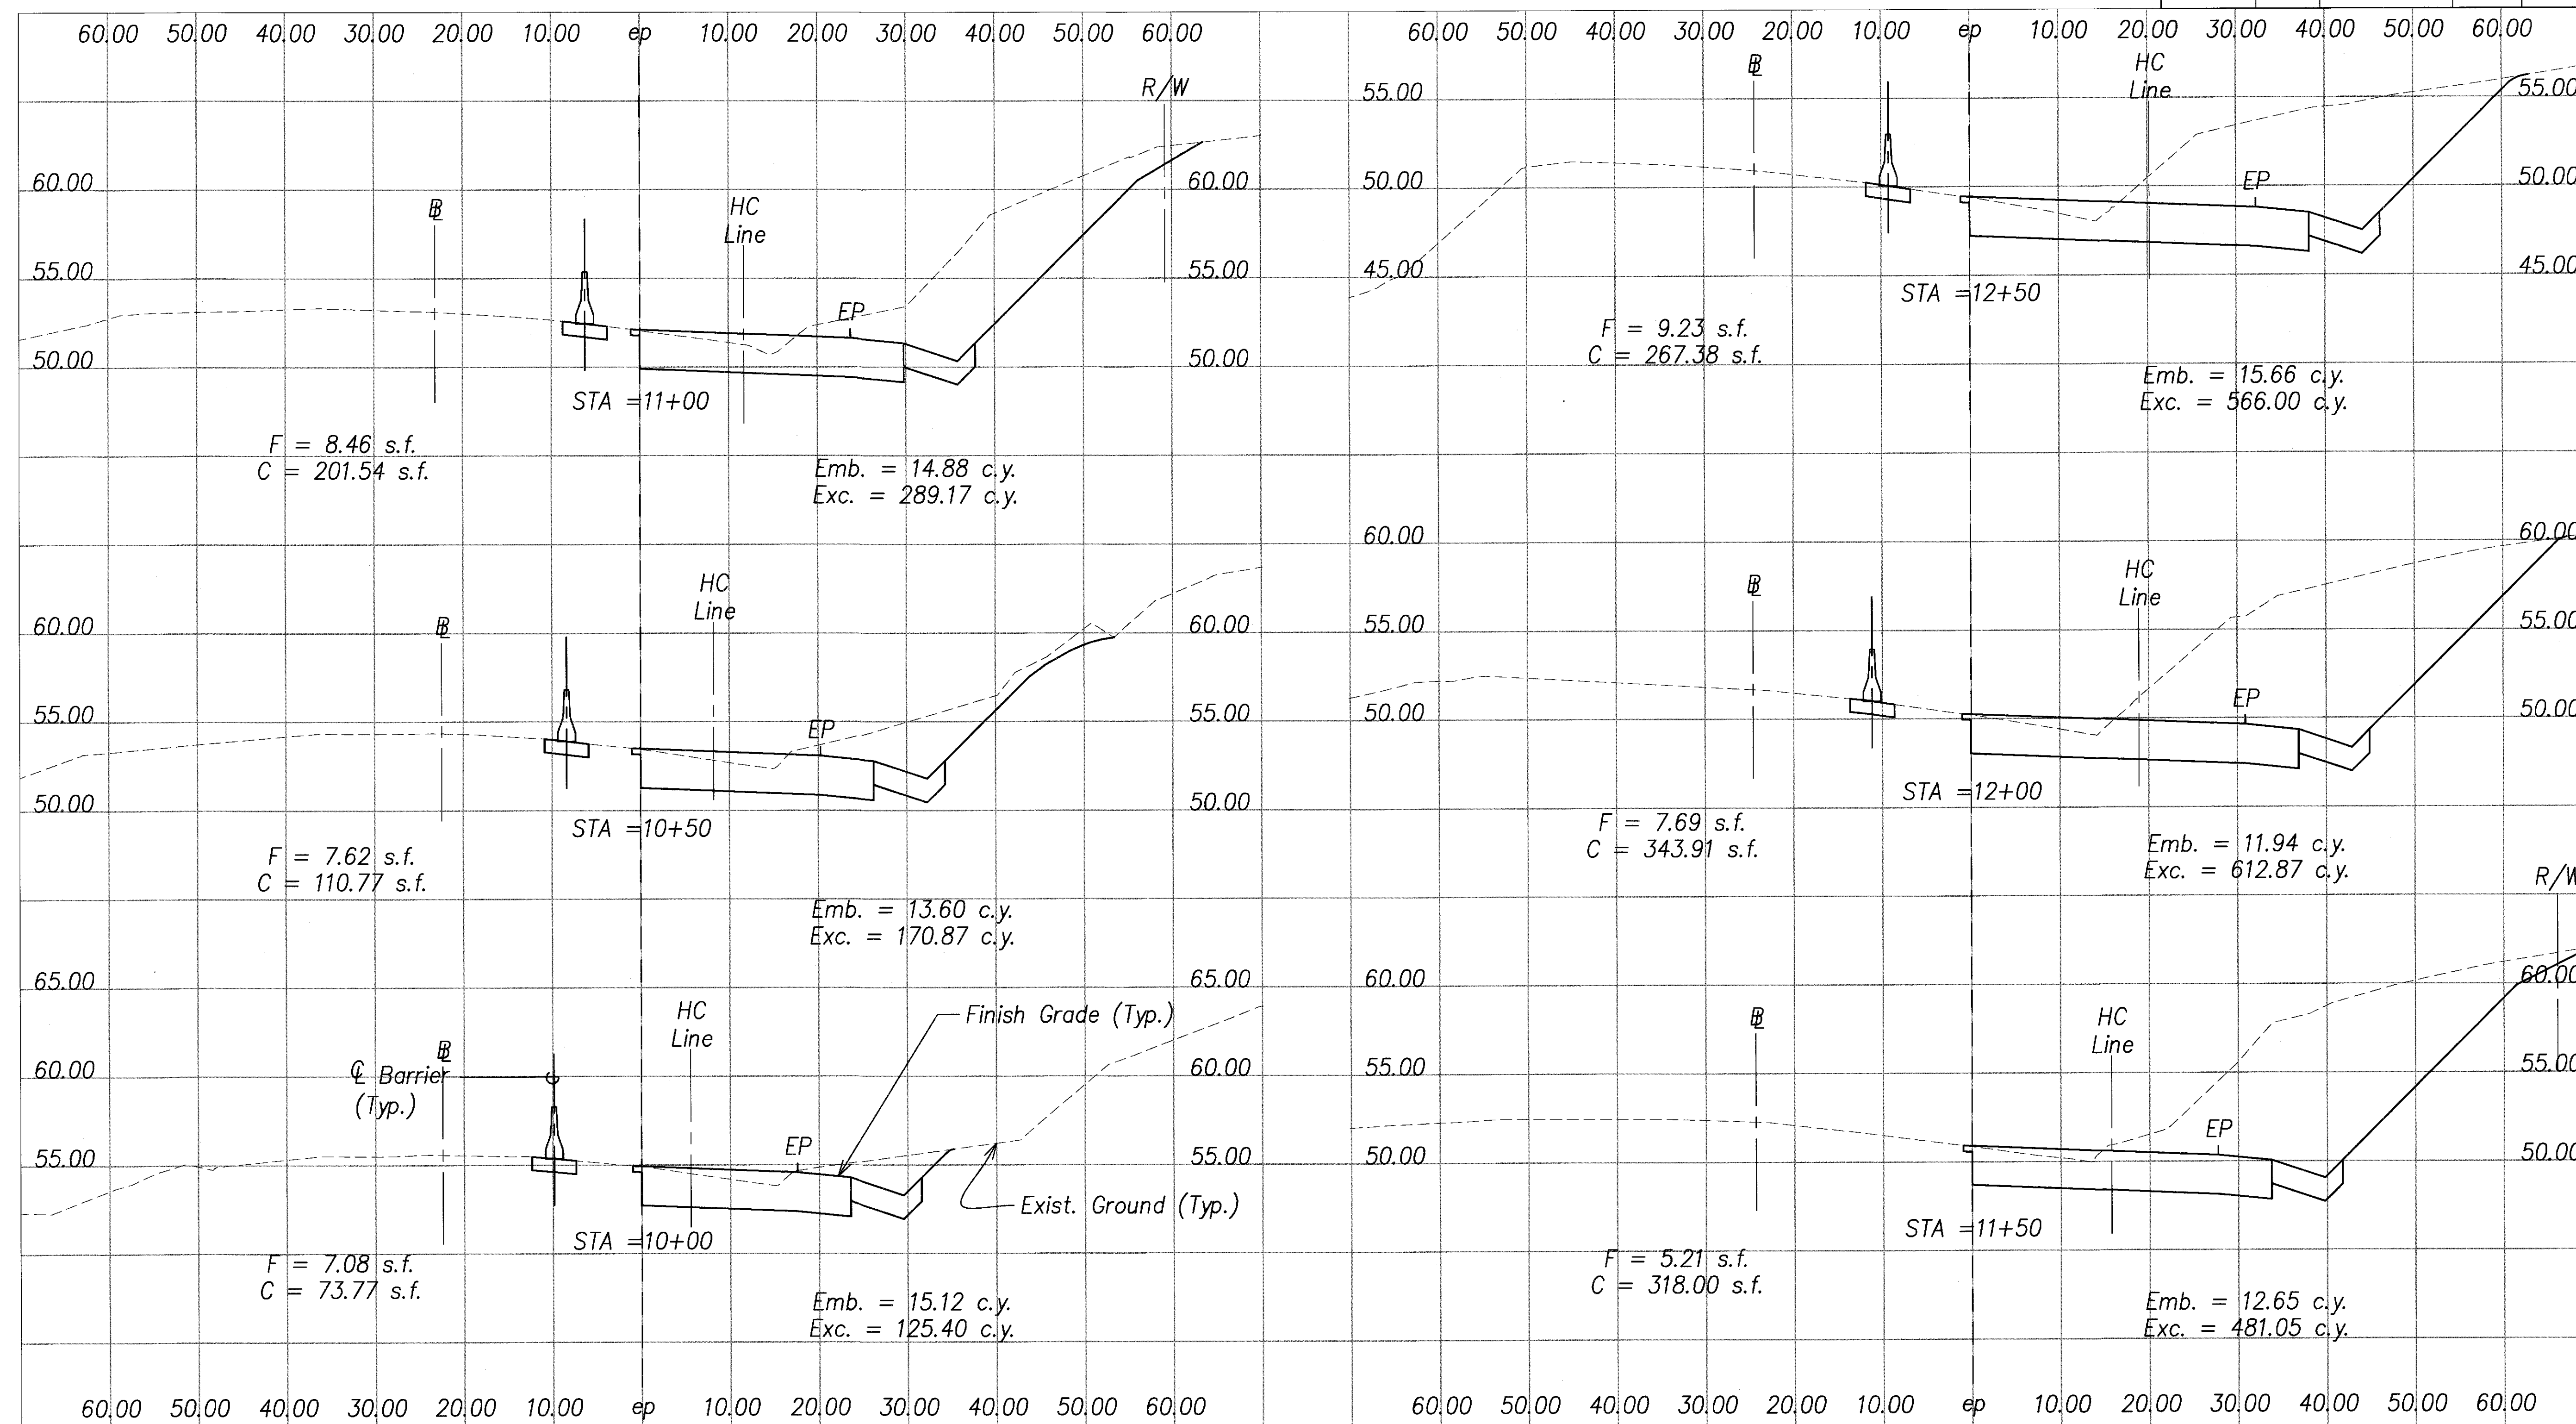

ORIGINAL PLAN	DATE
DESIGNED BY	DATE
TRACED BY	DATE
DESIGNED BY	DATE
QUANTITIES BY	DATE
CHECKED BY	DATE

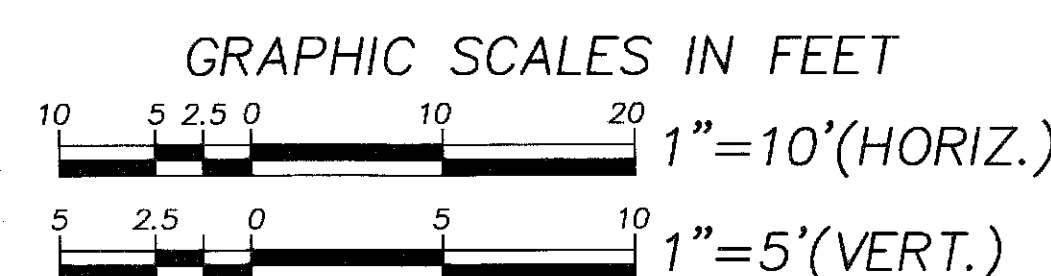

KENNETH O. MAGI
 LICENSED PROFESSIONAL ENGINEER
 No. 3265-C
 HAWAII, U.S.A.

APRIL 30, 2010
 EXPIRATION DATE OF LICENSE

THIS WORK WAS PREPARED BY ME OR UNDER MY SUPERVISION


STATE OF HAWAII
 DEPARTMENT OF TRANSPORTATION
 HIGHWAYS DIVISION

KALANIANA'OLE HWY. CROSS SECTIONS
HC STA. 10+00 TO 12+50
KALANIANA'OLE HIGHWAY MEDIAN
IMPROVEMENTS VICINITY OF OLOMANA
GOLF COURSE PROJECT NO. 72A-02-06


SCALE: (H)1"=10'; (V)1"=5' DATE: June 2008

SHEET No. C-39 OF 43 SHEETS

FED. ROAD DIST. NO.	STATE	PROJECT NO.	FISCAL YEAR	SHEET NO.	TOTAL SHEETS
HAWAII	HAW.	72A-02-06	2008	42	66

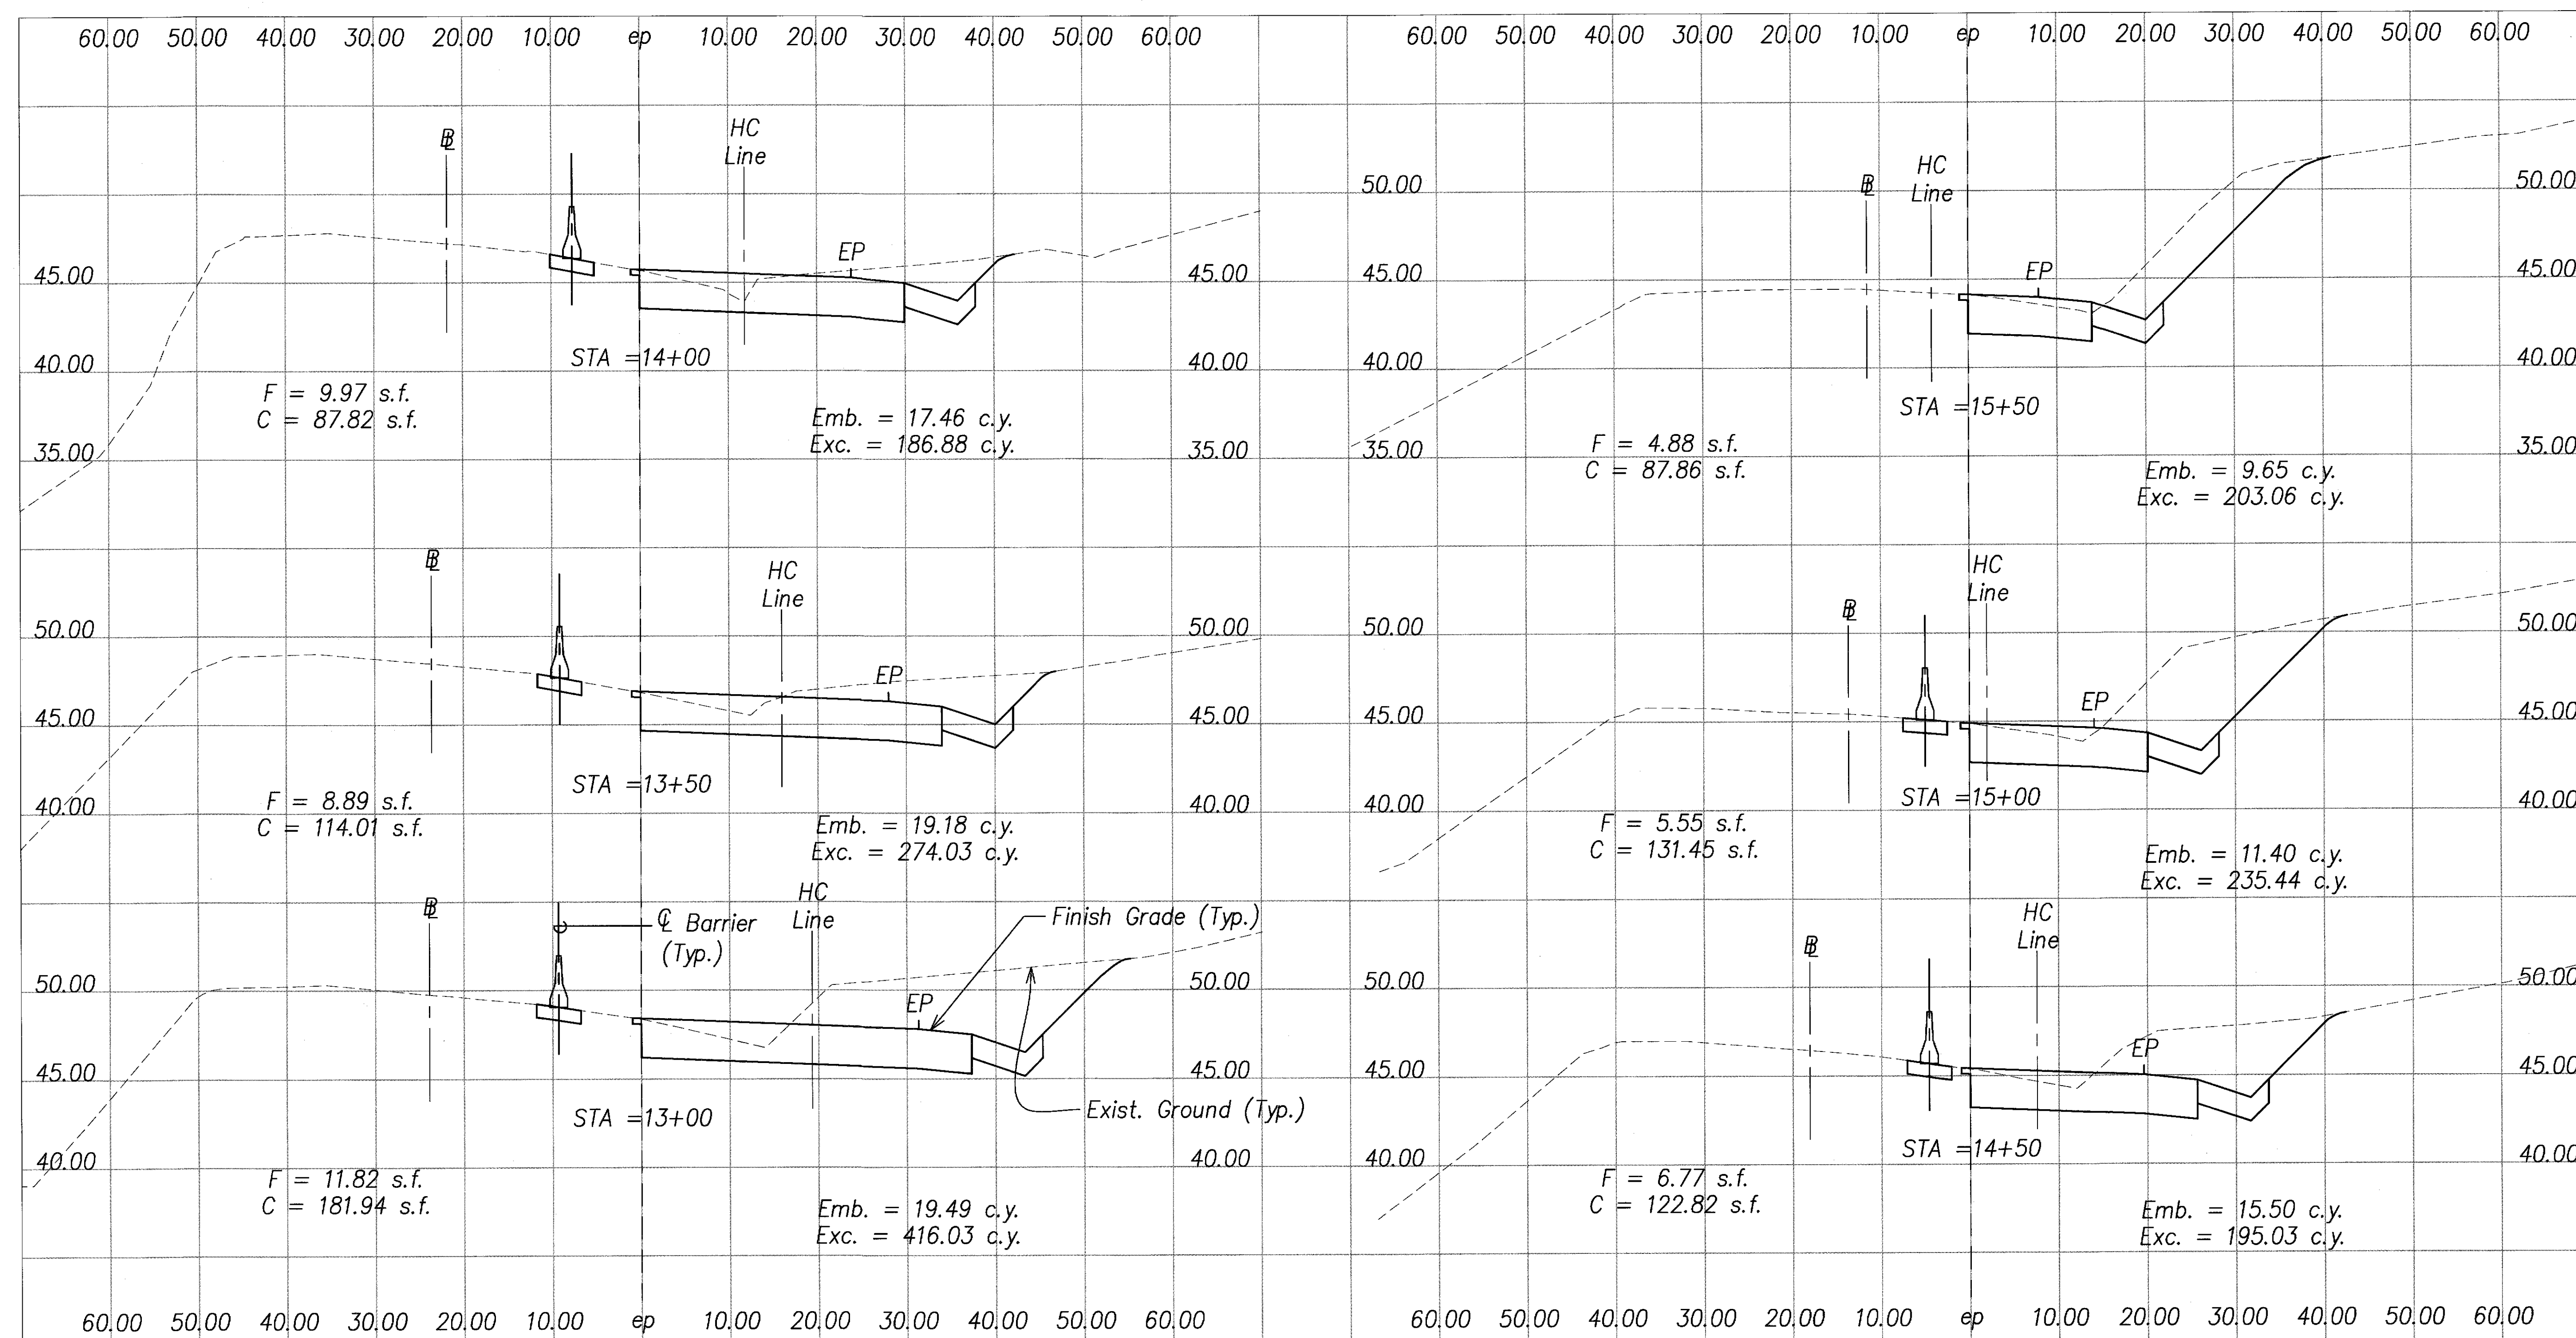




GRAPHIC SCALES IN FEET
 1"=10'(HORIZ.)
 1"=5'(VERT.)

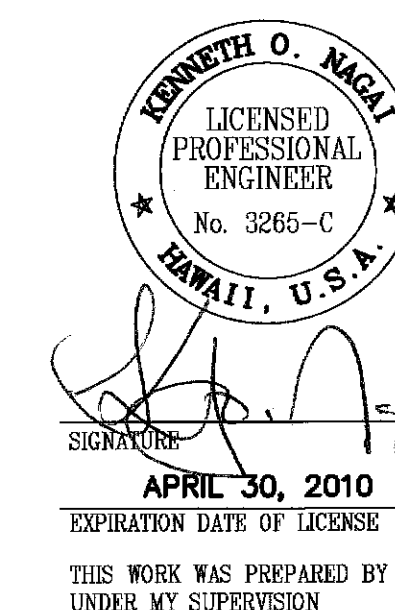

STATE OF HAWAII
 DEPARTMENT OF TRANSPORTATION
 HIGHWAYS DIVISION
KALANIANAʻOLE HWY. CROSS SECTIONS
HC STA. 13+00 TO 15+50
KALANIANAʻOLE HIGHWAY MEDIAN
IMPROVEMENTS VICINITY OF OLOMANA
GOLF COURSE PROJECT NO. 72A-02-06
 SCALE: (H)1"=10', (V)1"=5' DATE: June 2008
 SHEET No. C-40 OF 43 SHEETS

"AS-BUILT"

FED. ROAD DIST. NO.	STATE	PROJECT NO.	FISCAL YEAR	SHEET NO.	TOTAL SHEETS
HAWAII	HAW.	72A-02-06	2008	43	66

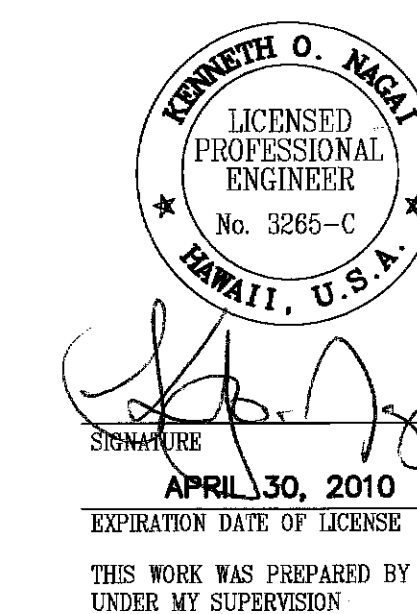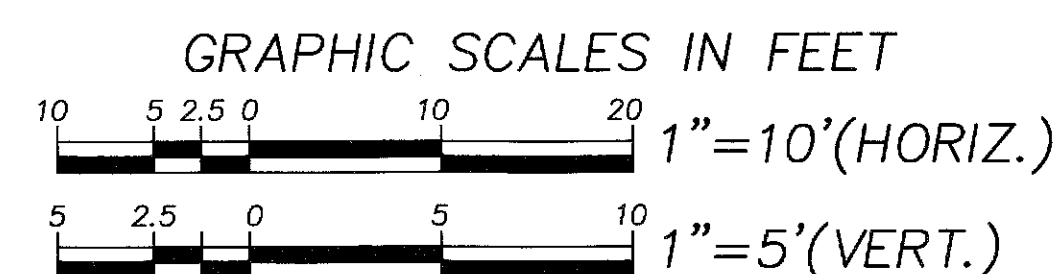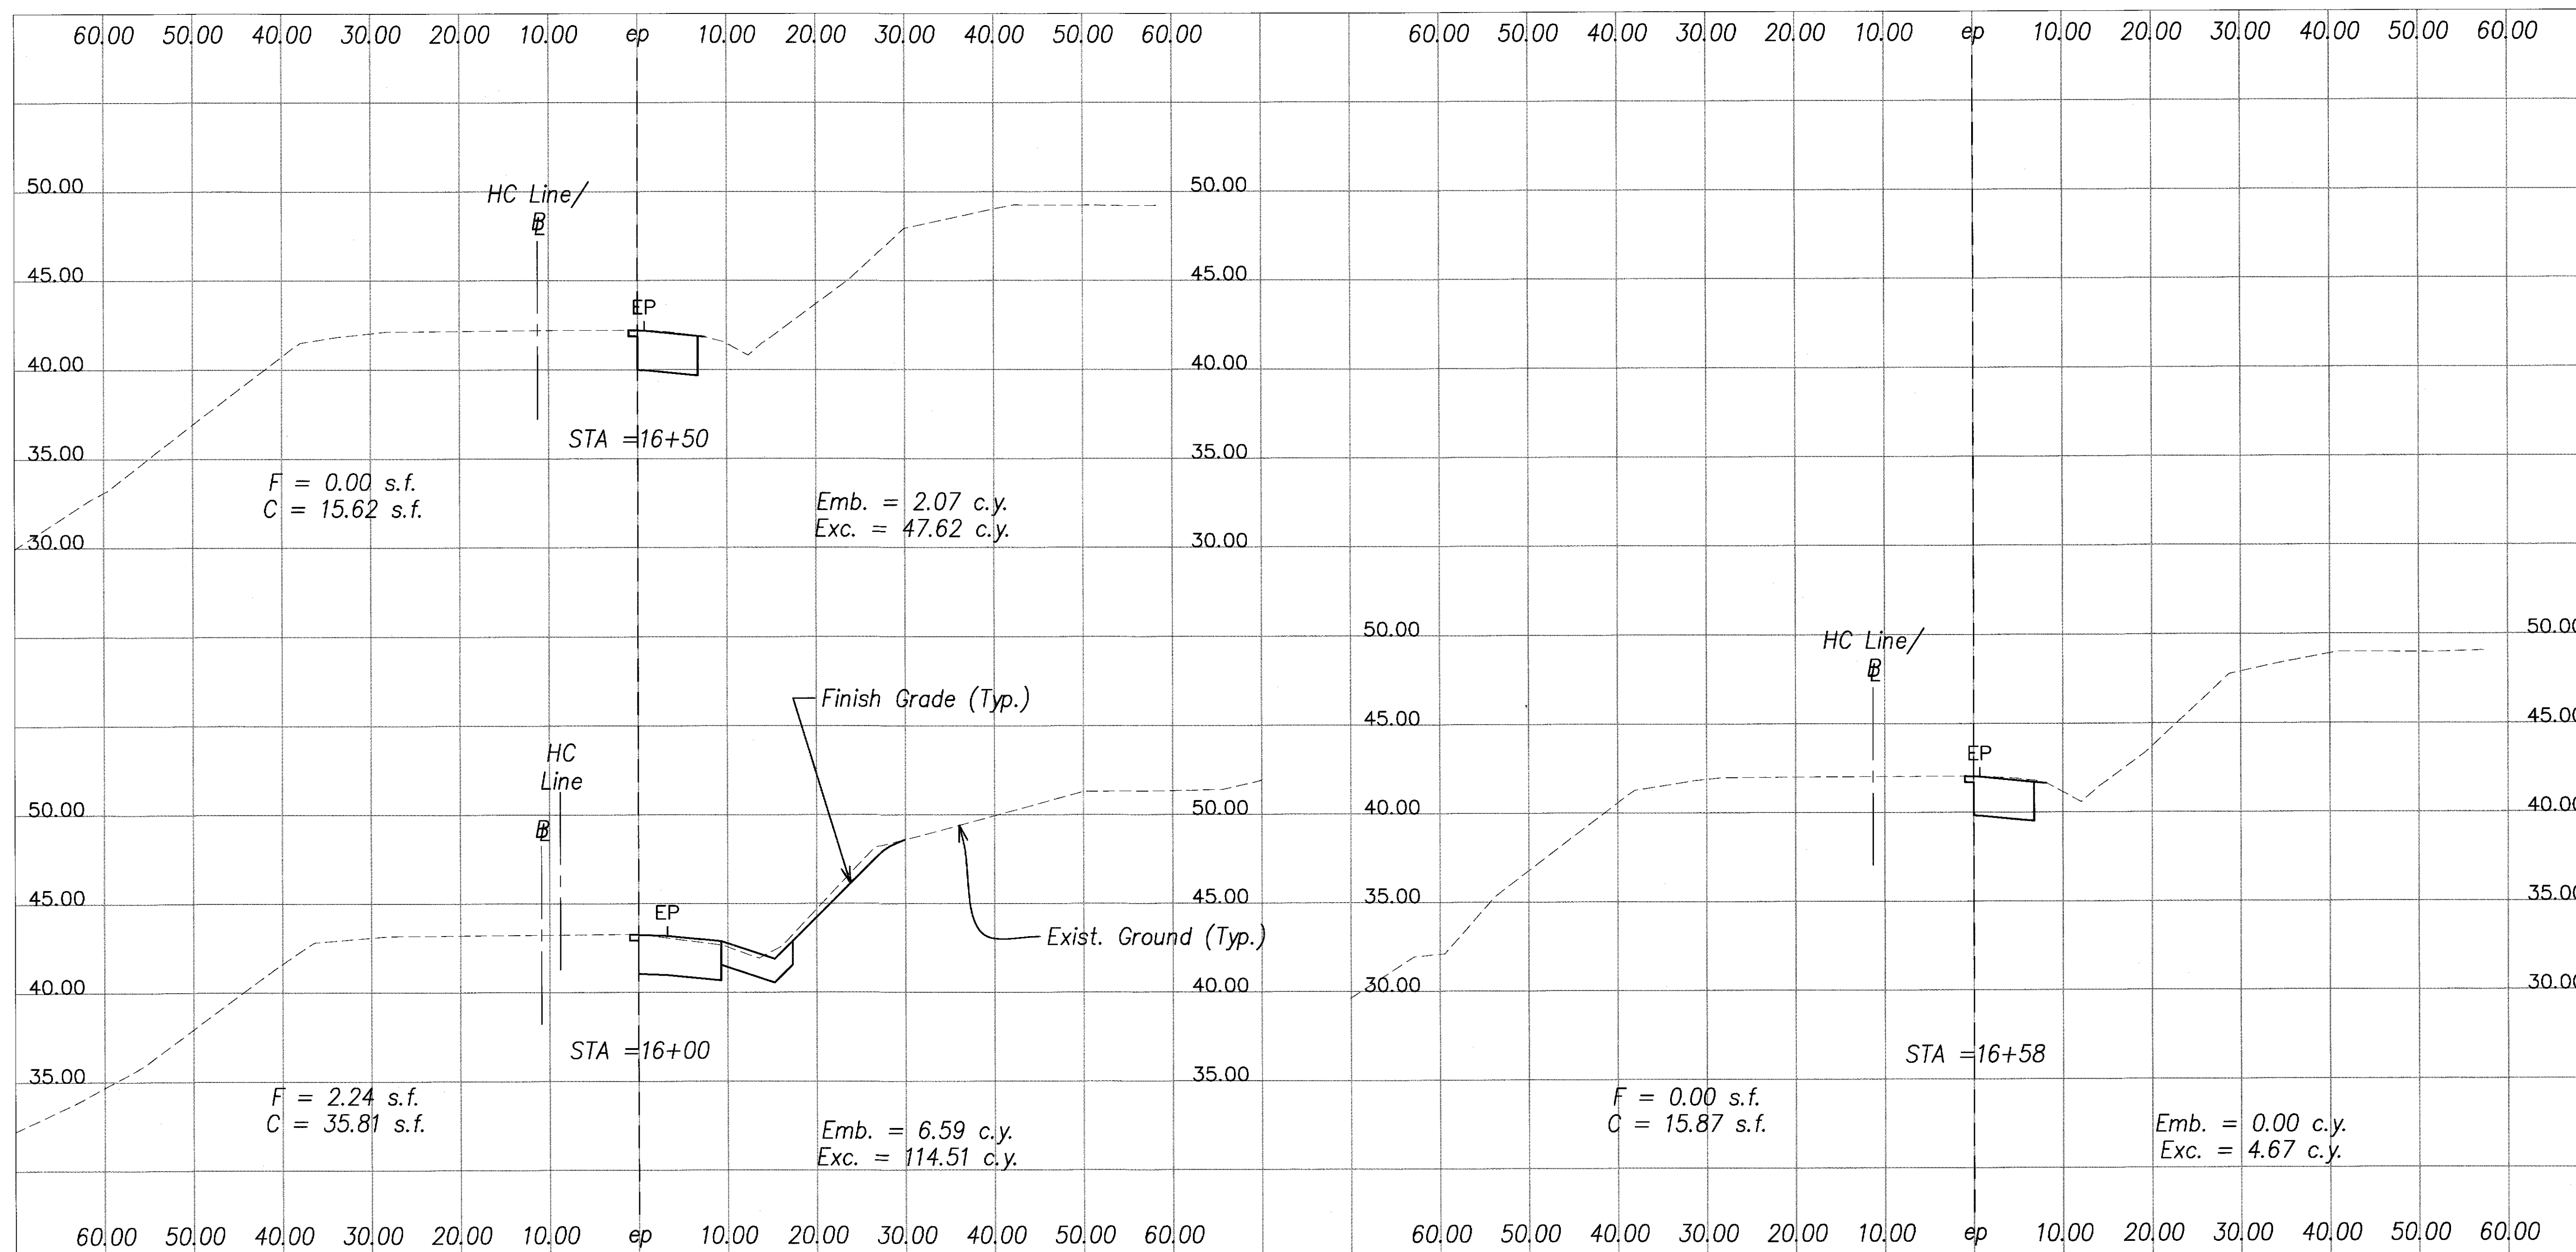

STATE OF HAWAII
DEPARTMENT OF TRANSPORTATION
HIGHWAYS DIVISION

KALANIANAʻOLE HWY. CROSS SECTIONS
HC STA. 16+00 TO 16+58
KALANIANAʻOLE HIGHWAY MEDIAN
IMPROVEMENTS VICINITY OF OLOMANA
GOLF COURSE PROJECT NO. 72A-02-06

SCALE: (H)1"=10', (V)1"=5' DATE: June 2008

SHEET No. C-41 OF 43 SHEETS

SURVEY PLOTTED BY	DATE
DRAWN BY	
DESIGNED BY	
QUANTITIES BY	
CHECKED BY	

ORIGINAL PLAN No.