

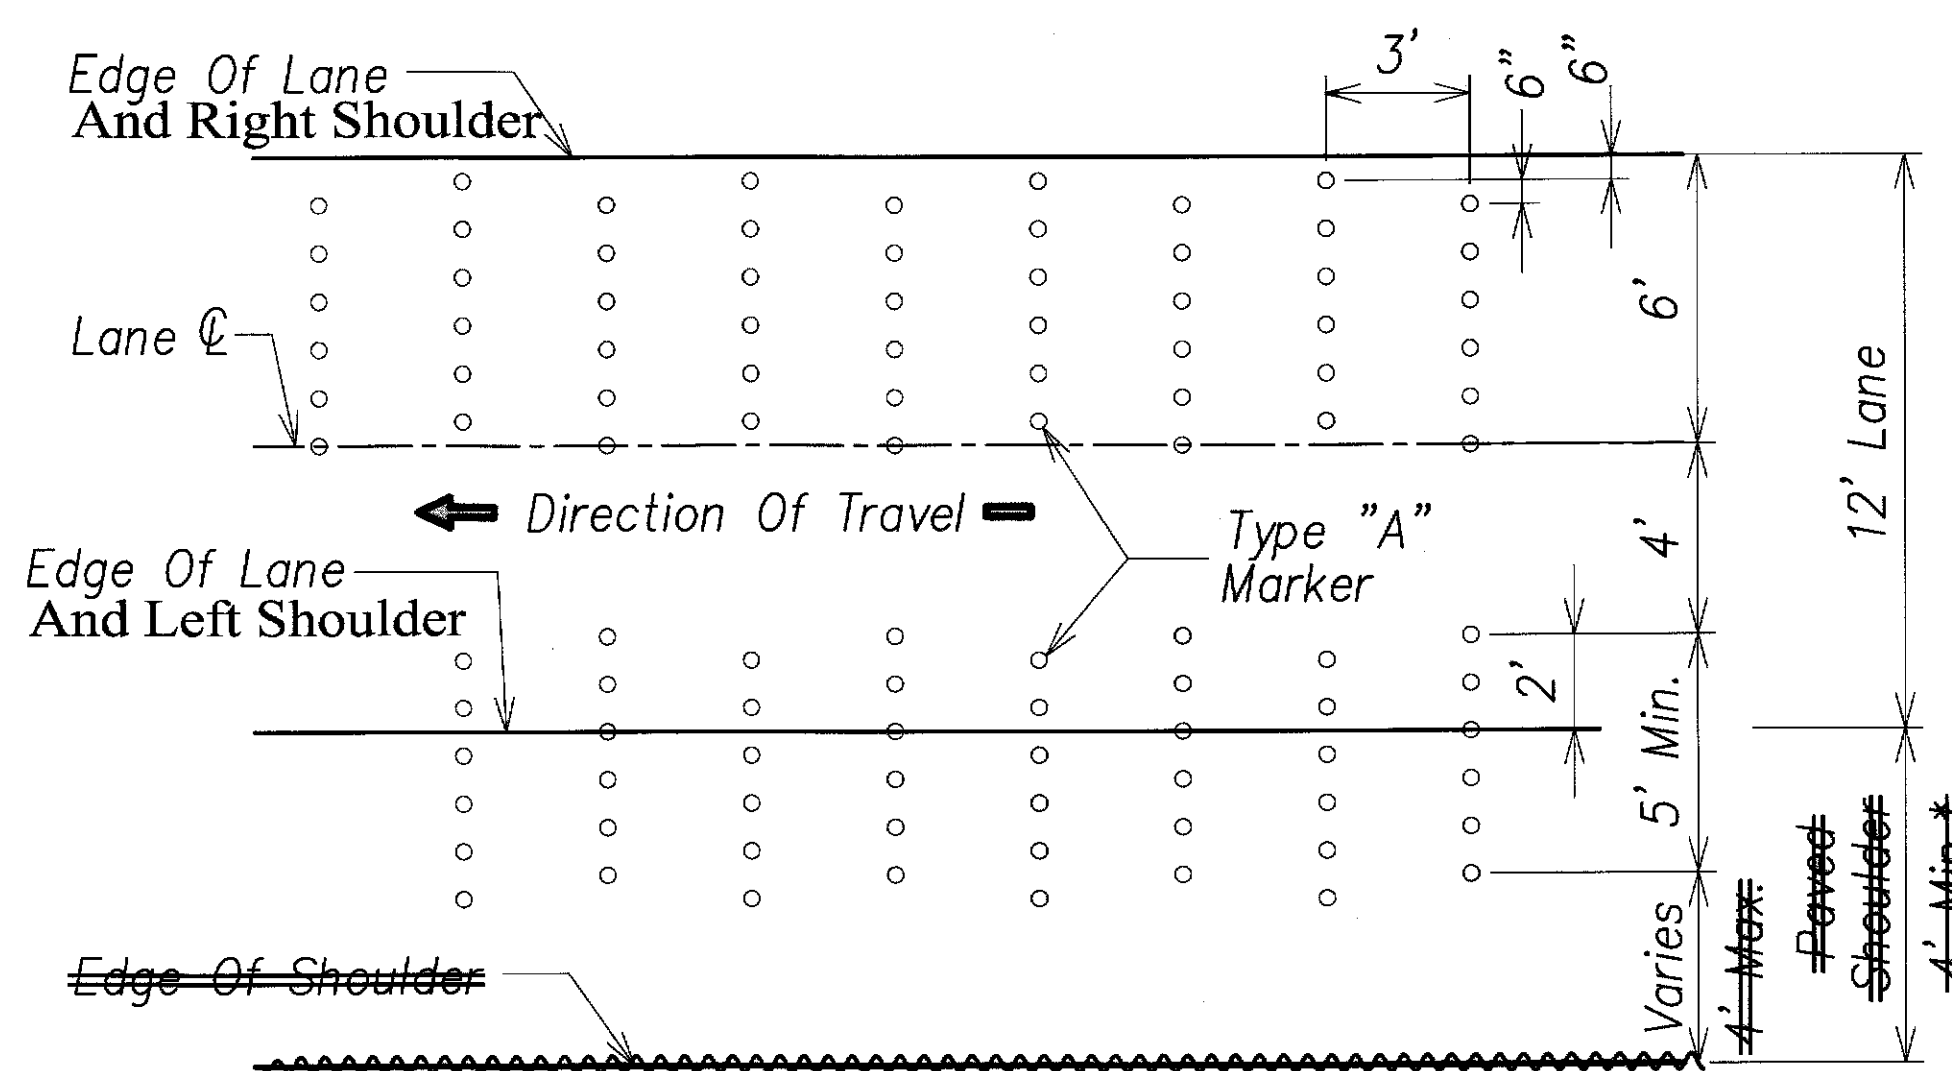
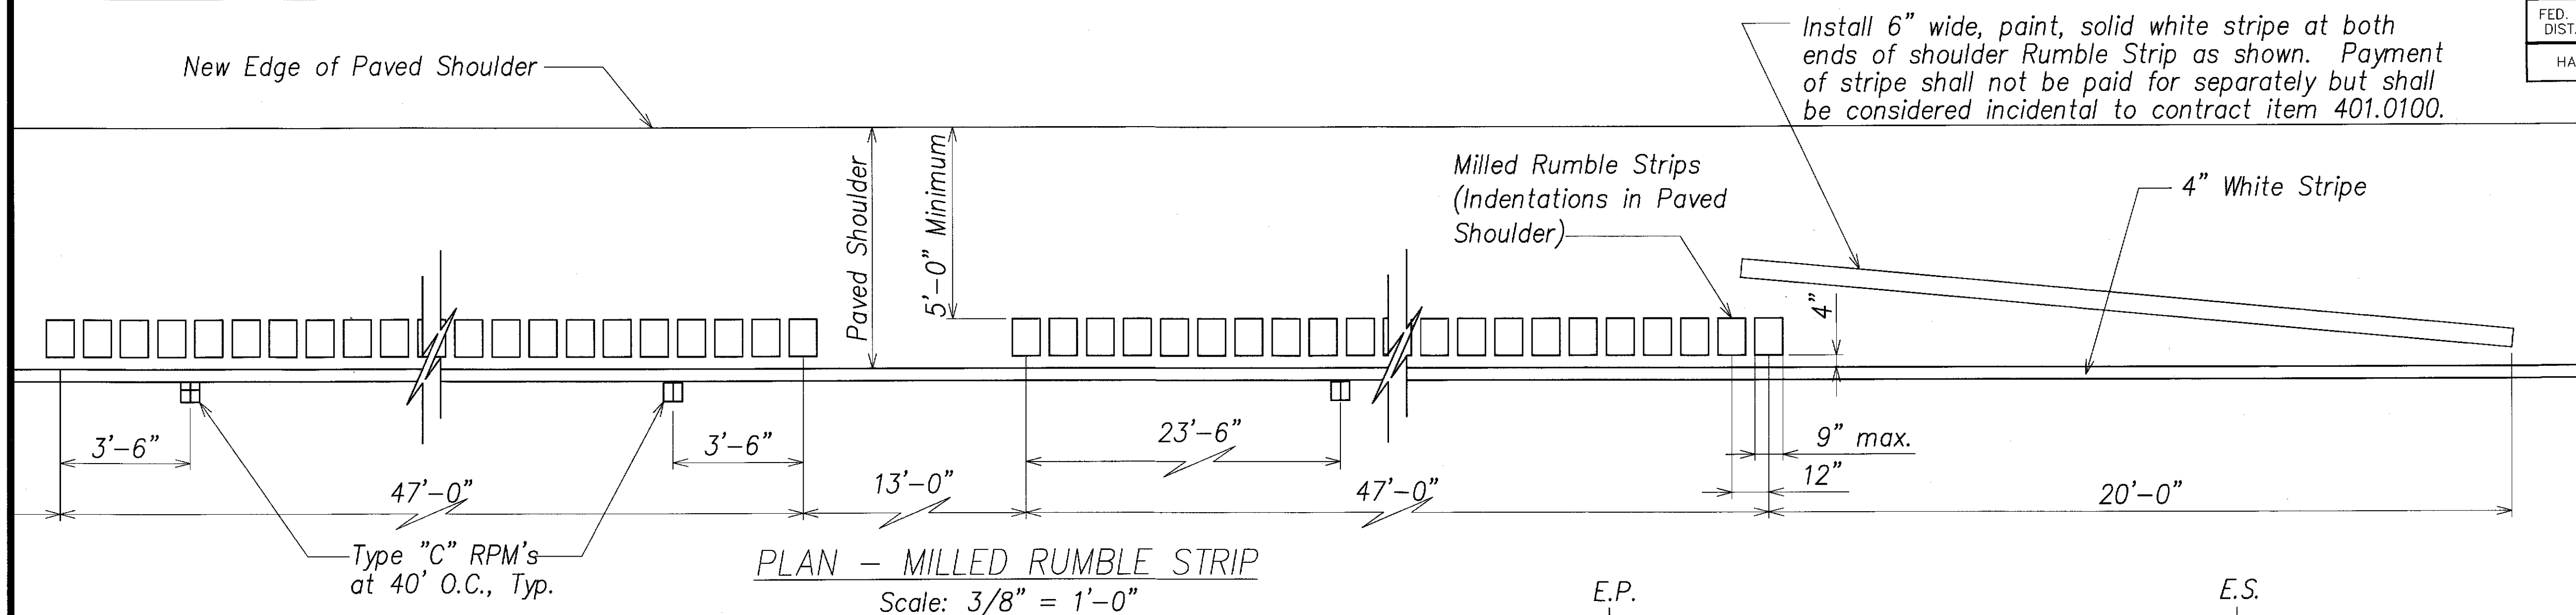


FED. ROAD DIST. NO.	STATE	PROJECT NO.	FISCAL YEAR	SHEET NO.	TOTAL SHEETS
HAWAII	HAW.	72A-02-06	2008	30	66

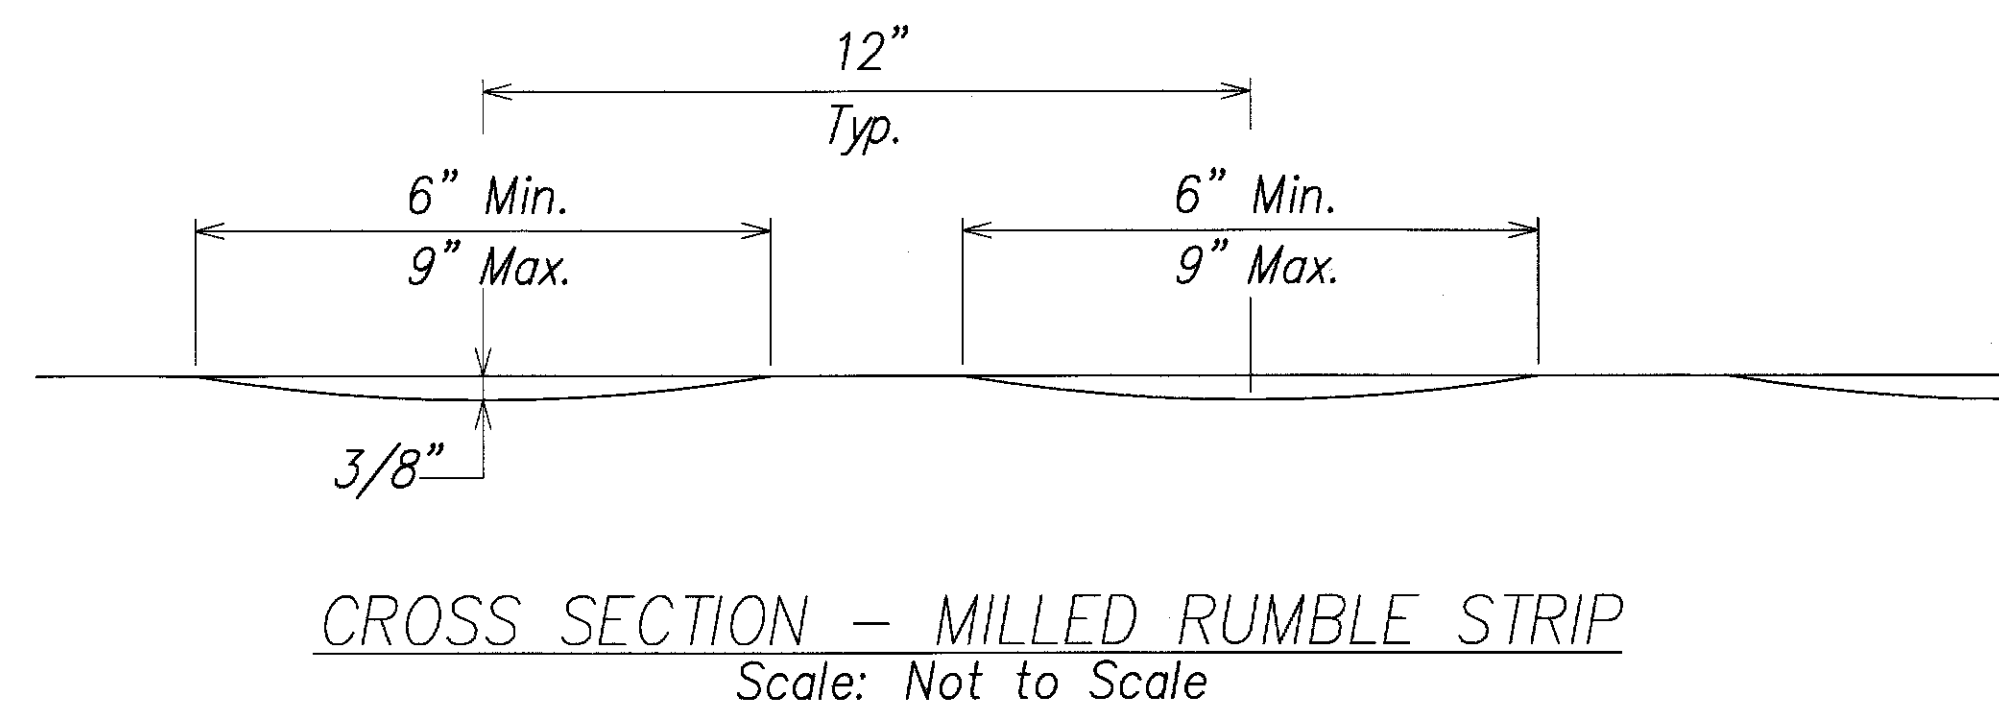

\* If Less Than 4' Extend Rumble Strip Across Paved Shoulder


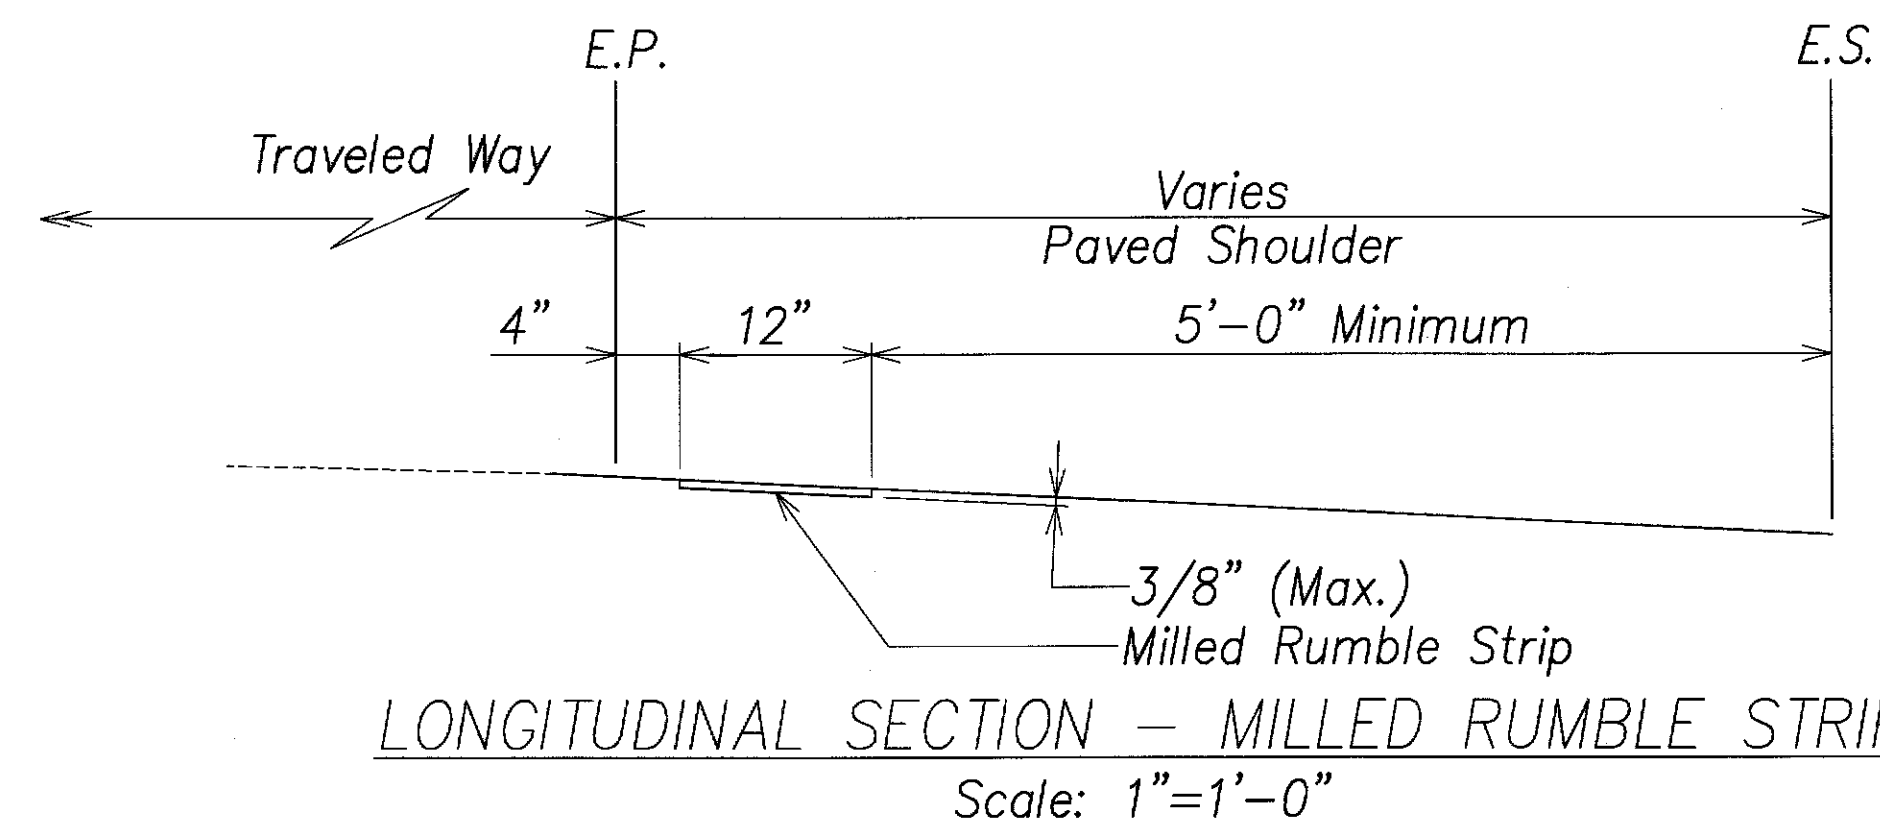


#### MILLED RUMBLE STRIP NOTES:

1. The method of constructing the Milled Rumble Strip shall be submitted to the Engineer for acceptance prior to the actual work.
2. The construction of the the Milled Rumble Strip shall be paid for under Hot Mix Asphalt (MHA) Pavement. The milling apparatus and 20 lf, 6" white stripe shall be considered incidental to Hot Mix Asphalt (HMA) Pavement and will not be paid for separately.
3. Rumble strips shall be installed at location noted on the plans.
4. Do not place Type "C" markers within 2 ft. of the 13 ft. Rumble Strip opening.
5. Rumble Strips are to be installed after the edge of pavement stripe and before the installation of the Type "C" markers.
6. Rumble strips should not be used unless 5 feet of clear shoulder width for bicycle use is available between the rumble strips and the outer edge of the paved shoulder.

#### LEGEND FOR AS-BUILT POSTING

- ~~~~~ Squiggly line for as-built deletion
- == Double line for as-built deletion
- Roadway Text for as-built posting

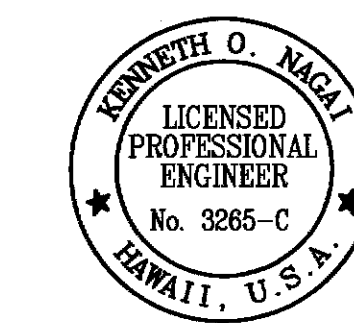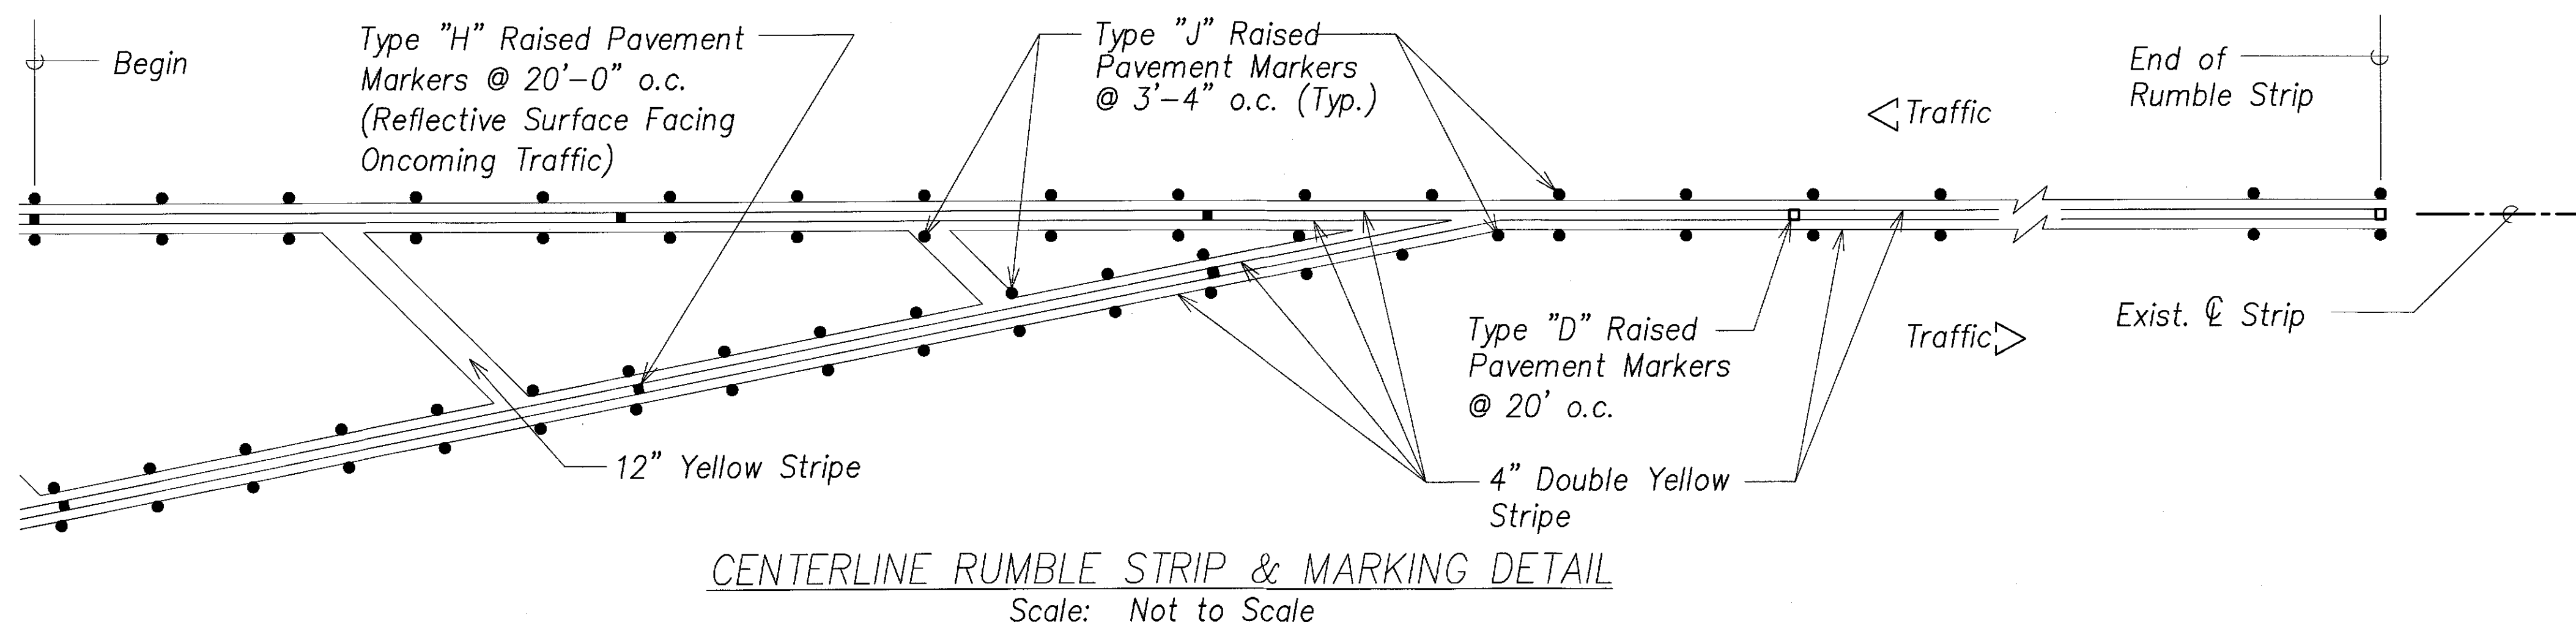

SIGNATURE  
APRIL 30, 2010  
EXPIRATION DATE OF LICENSE  
THIS WORK WAS PREPARED BY ME OR UNDER MY SUPERVISION

STATE OF HAWAII  
DEPARTMENT OF TRANSPORTATION  
HIGHWAYS DIVISION  
**RUMBLE STRIP  
DETAILS AND NOTES**  
KALANIANA'OLE HIGHWAY MEDIAN  
IMPROVEMENTS VICINITY OF OLOMANA  
GOLF COURSE PROJECT NO. 72A-02-06  
SCALE: AS NOTED DATE: June 2008

SHEET No. C-28 OF 43 SHEETS

"AS-BUILT"