



FED. ROAD DIST. NO.	STATE	PROJECT NO.	FISCAL YEAR	SHEET NO.	TOTAL SHEETS
HAWAII	HAW.	72A-02-06	2008	22	66

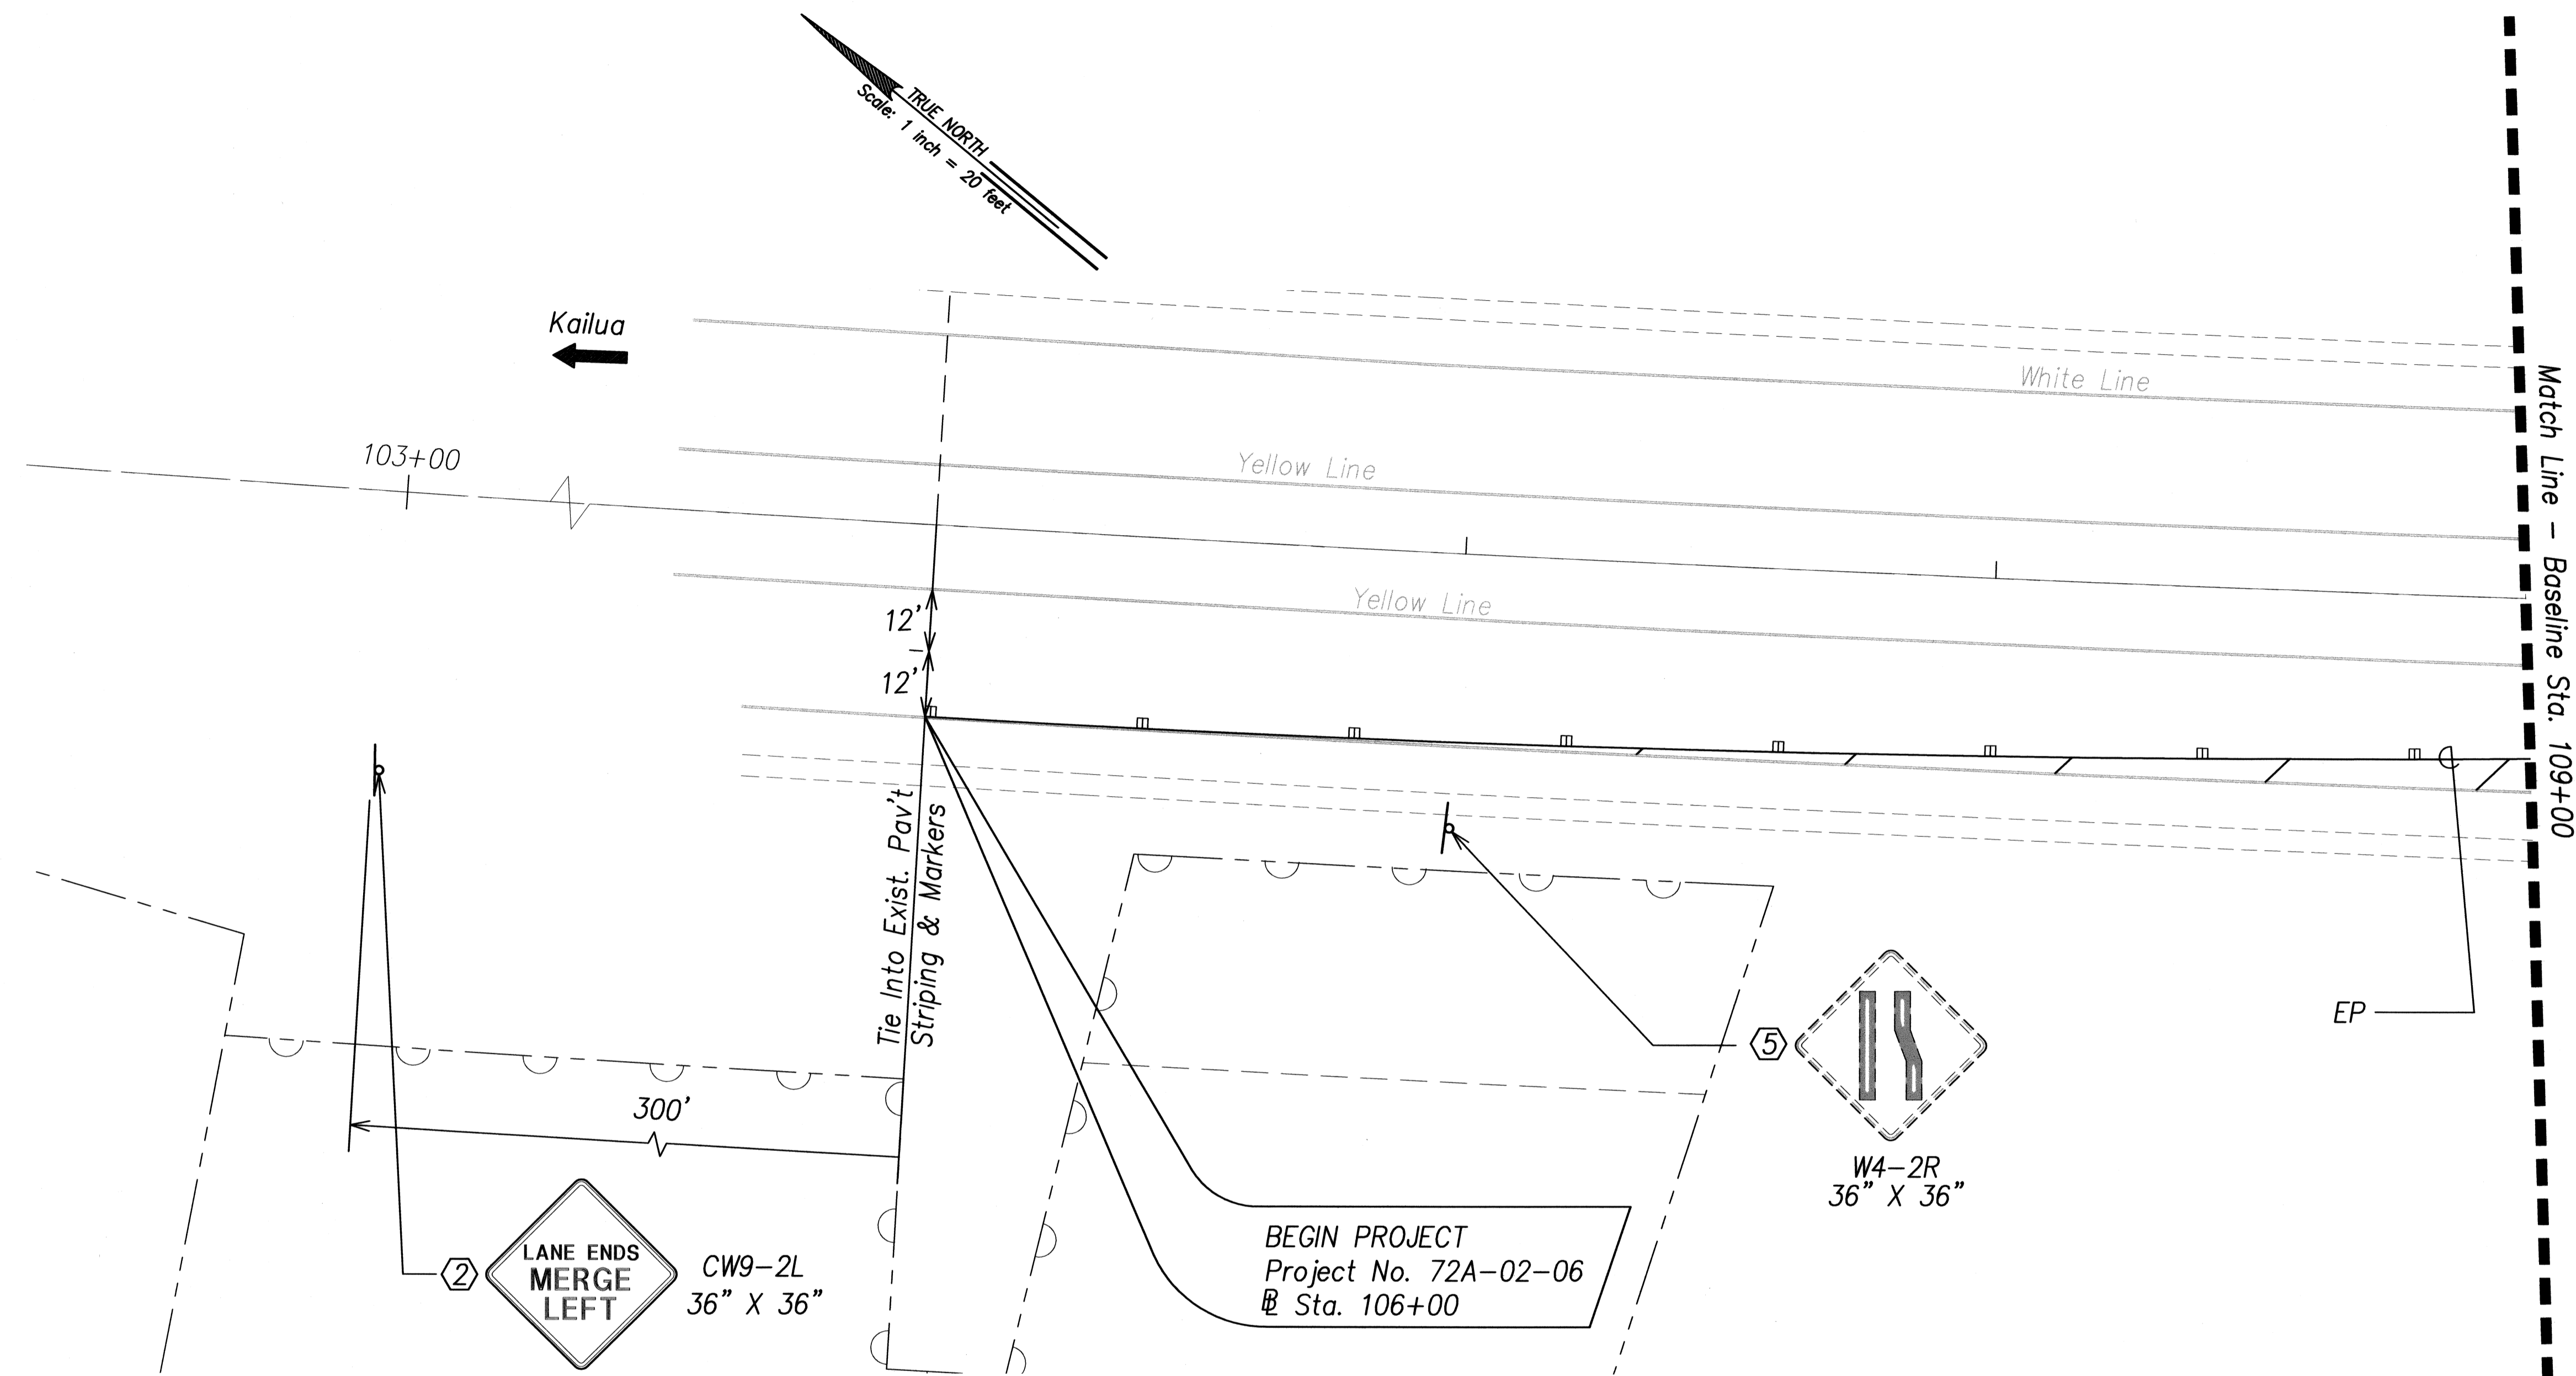

NOTES:

- ① Exist. Sign To Remain
- ② Install New Sign W/ New Post(s)
- ③ Remove Exist. Sign & Post(s)
- ④ Salvage Exist. Sign & Remove Exist. Post(s)
- ⑤ Install Exist. Sign On New Posts(s)
- ⑥ Median Nose Delineation
- ⑦ Seal milled areas in asphalt concrete pavement with Emulsified Asphalt (Type SS-1, SS-1h, CSS-1, CSS-1h).

DATE	_____
DESIGNED BY	_____
TRACED BY	_____
DESIGNED BY	_____
QUANTITIES BY	_____
CHECKED BY	_____
ORIGINAL PLAN	_____
NOTE BOOK	_____
No.	_____

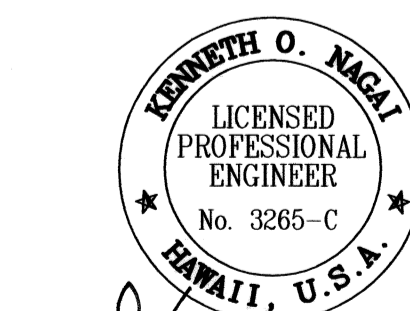

APRIL 30, 2010
EXPIRATION DATE OF LICENSE
THIS WORK WAS PREPARED BY ME OR UNDER MY SUPERVISION

STATE OF HAWAII
DEPARTMENT OF TRANSPORTATION
HIGHWAYS DIVISION



**SIGNING & PAVEMENT
MARKING PLAN - 1**

KALANIANA'OLE HIGHWAY MEDIAN
IMPROVEMENTS VICINITY OF OLOMANA
GOLF COURSE PROJECT NO. 72A-02-06

SCALE: 1"=40' DATE: June 2008

SHEET No. C-20 OF 43 SHEETS



FED. ROAD DIST. NO.	STATE	PROJECT NO.	FISCAL YEAR	SHEET NO.	TOTAL SHEETS
HAWAII	HAW.	72A-02-06	2008	CC02	66

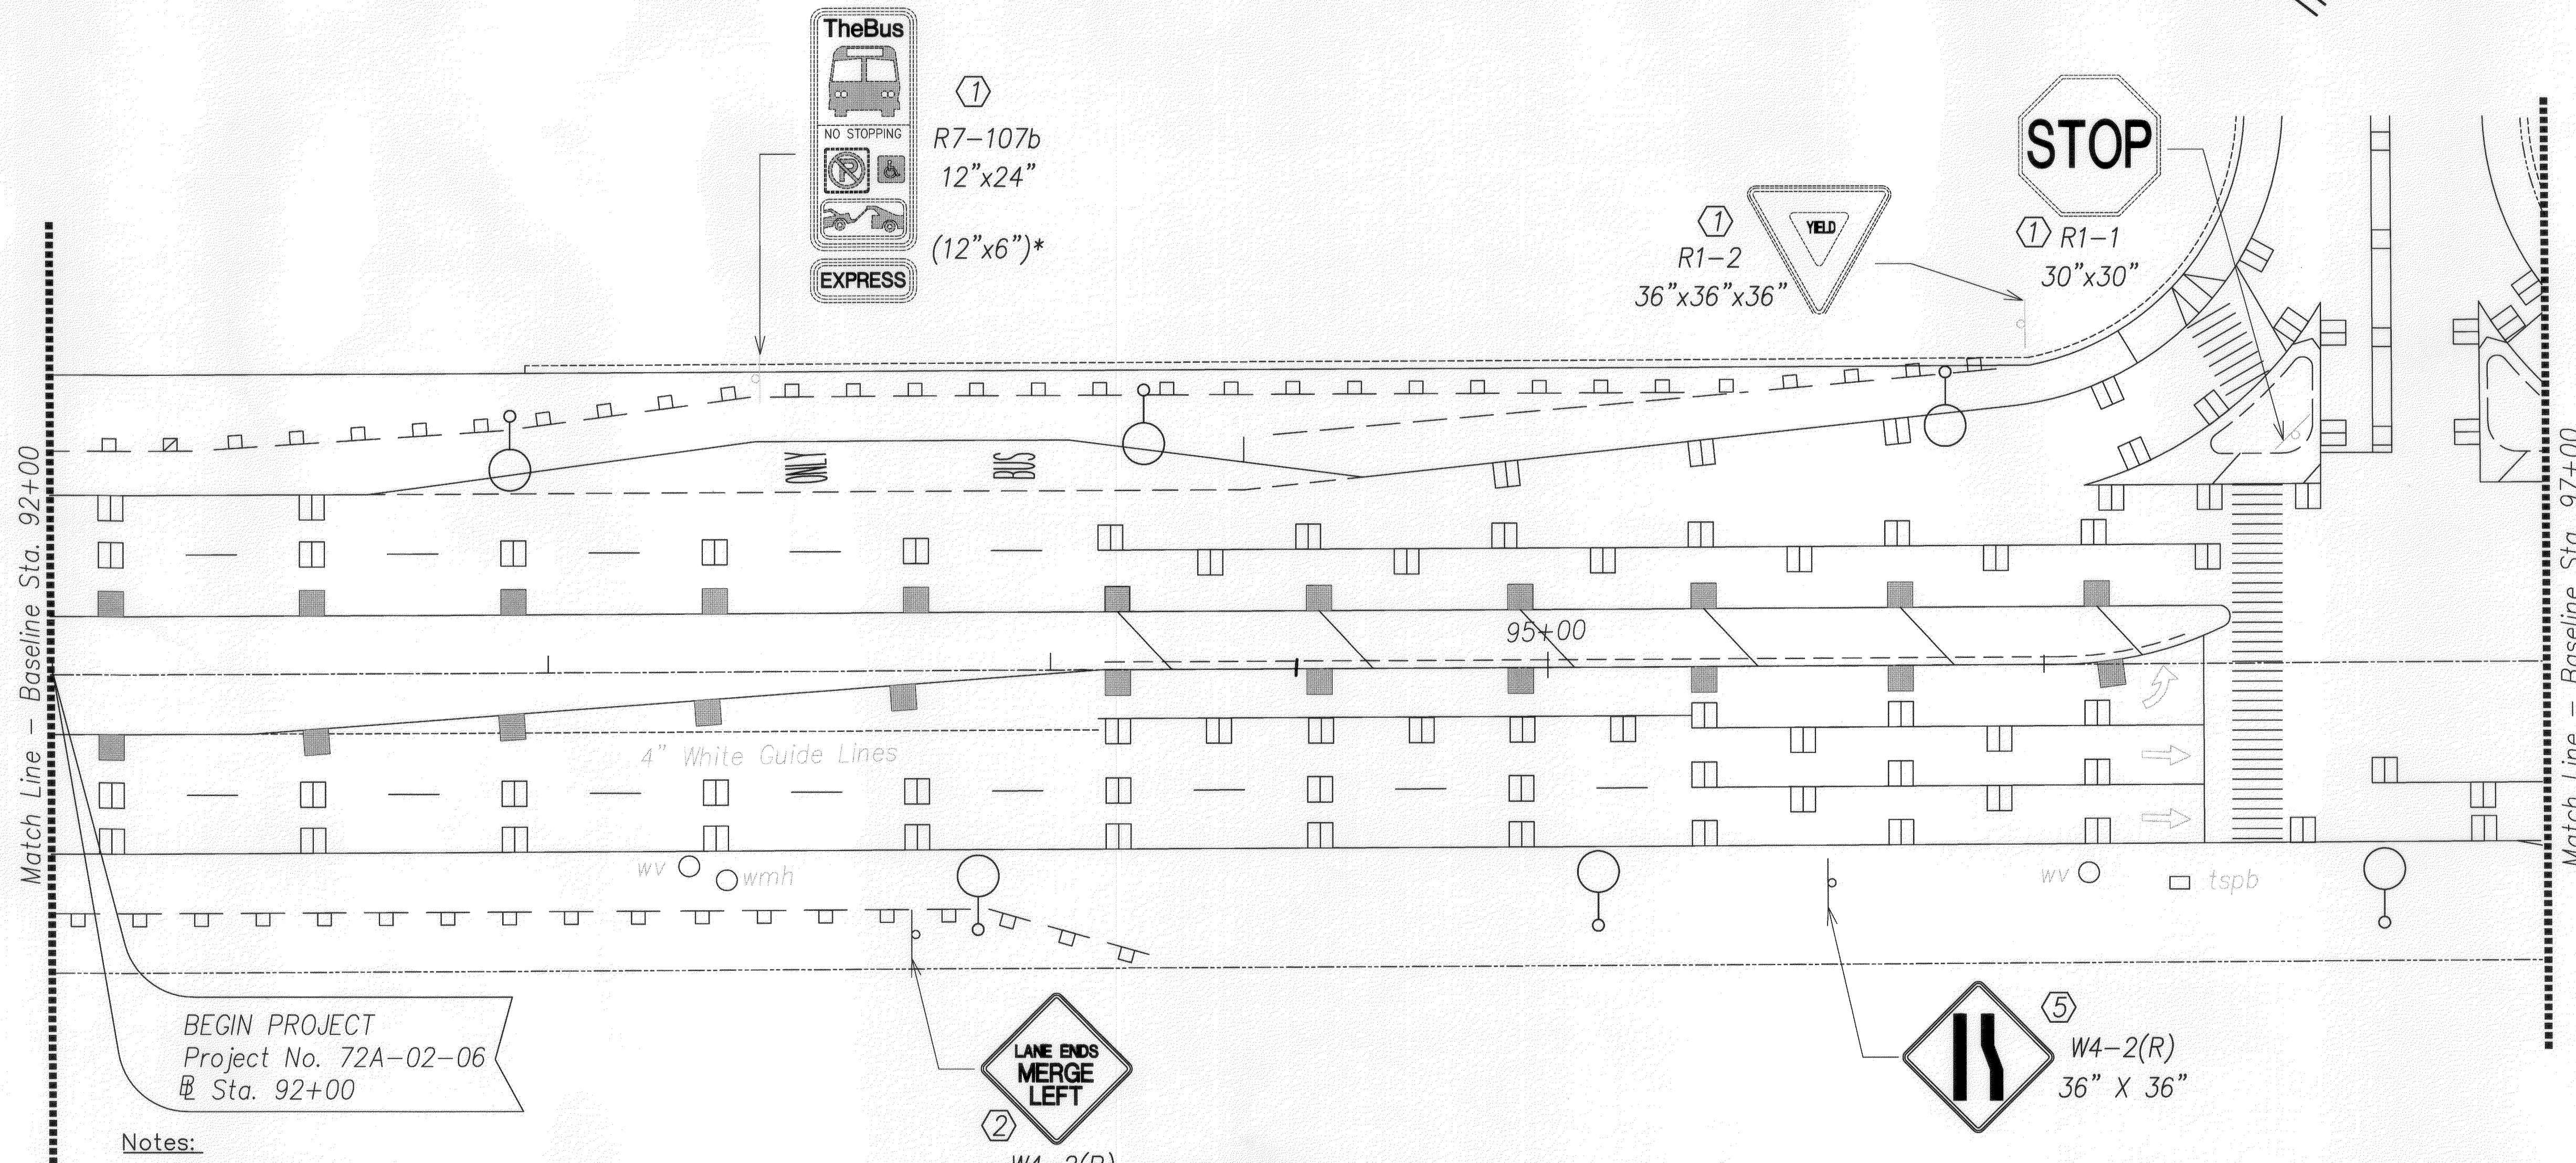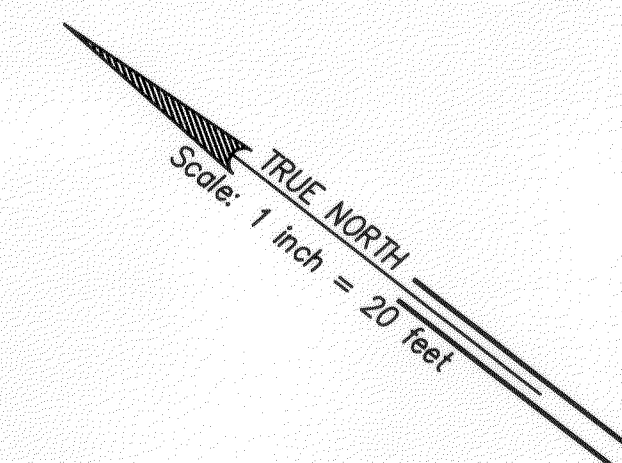

BEGIN PROJECT
Project No. 72A-02-06
@ Sta. 92+00

Notes:

- Eradicate 3 ea. existing merge arrows between Sta. 103+00 and 106+00
- Eradicate existing taper line and markers between Sta. 106+00 and 110+39
- Add taper between Sta. 103+00 and 108+50 with Type C raised pavement markers at 40' OC (Approximately 14 markers)
- Extend diagonals or add new diagonals to taper line between Sta. 103+00 and 108+50
- Remove 11 ea old delineators between Sta. 106+00 and 110+39 and install new flexible delineator post, white, 35' OC along taper between Sta. 103+00 and 108+50. (Approximately 16 ea.) (Can reuse 11 old delineators, if replace base)
- Stripe new right edgeline with markers between Sta. 108+50 to 110+39. Tie in to existing at 110+39. Extend existing diagonals to new edgeline.

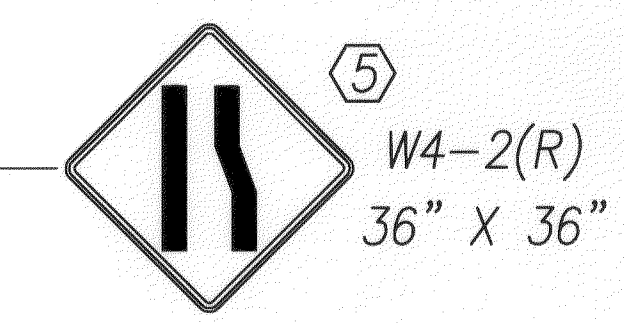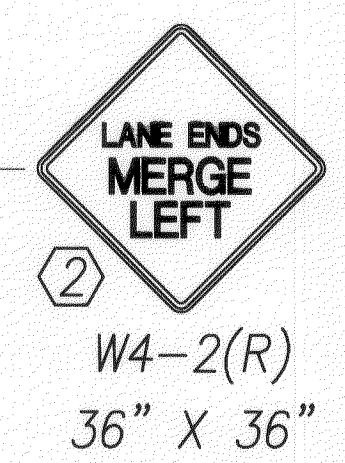

NOTES:

- ① Exist. Sign To Remain
- ② Install New Sign W/ New Post(s)
- ③ Remove Exist. Sign & Post(s)
- ④ Salvage Exist. Sign & Remove Exist. Post(s)
- ⑤ Install Exist. Sign On New Posts(s)
- ⑥ Median Nose Delineation
- ⑦ Seal milled areas in asphalt concrete pavement with Emulsified Asphalt (Type SS-1, SS-1h, CSS-1, CSS-1h).

LEGEND FOR AS-BUILT POSTING	
	Squiggly line for as-built deletion
	Double line for as-built deletion
	Roadway
	Text for as-built posting

DATE	_____
DESIGNED BY	_____
CHECKED BY	_____
NO. _____	_____



SIGNATURE: *Kenneth O. Nagai*
APRIL 30, 2010
EXPIRATION DATE OF LICENSE
THIS WORK WAS PREPARED BY ME OR UNDER MY SUPERVISION

STATE OF HAWAII
DEPARTMENT OF TRANSPORTATION
HIGHWAYS DIVISION

SIGNING & PAVEMENT MARKING PLAN - 1



KALANIANA'OLE HIGHWAY MEDIAN IMPROVEMENTS VICINITY OF OLOMANA
GOLF COURSE PROJECT NO. 72A-02-06

SCALE: As Shown DATE: June 2008

"AS-BUILT"

CC0 22

FED. ROAD DIST. NO.	STATE	PROJECT NO.	FISCAL YEAR	SHEET NO.	TOTAL SHEETS
HAWAII	HAW.	72A-02-06	2008	CC22S-1	66

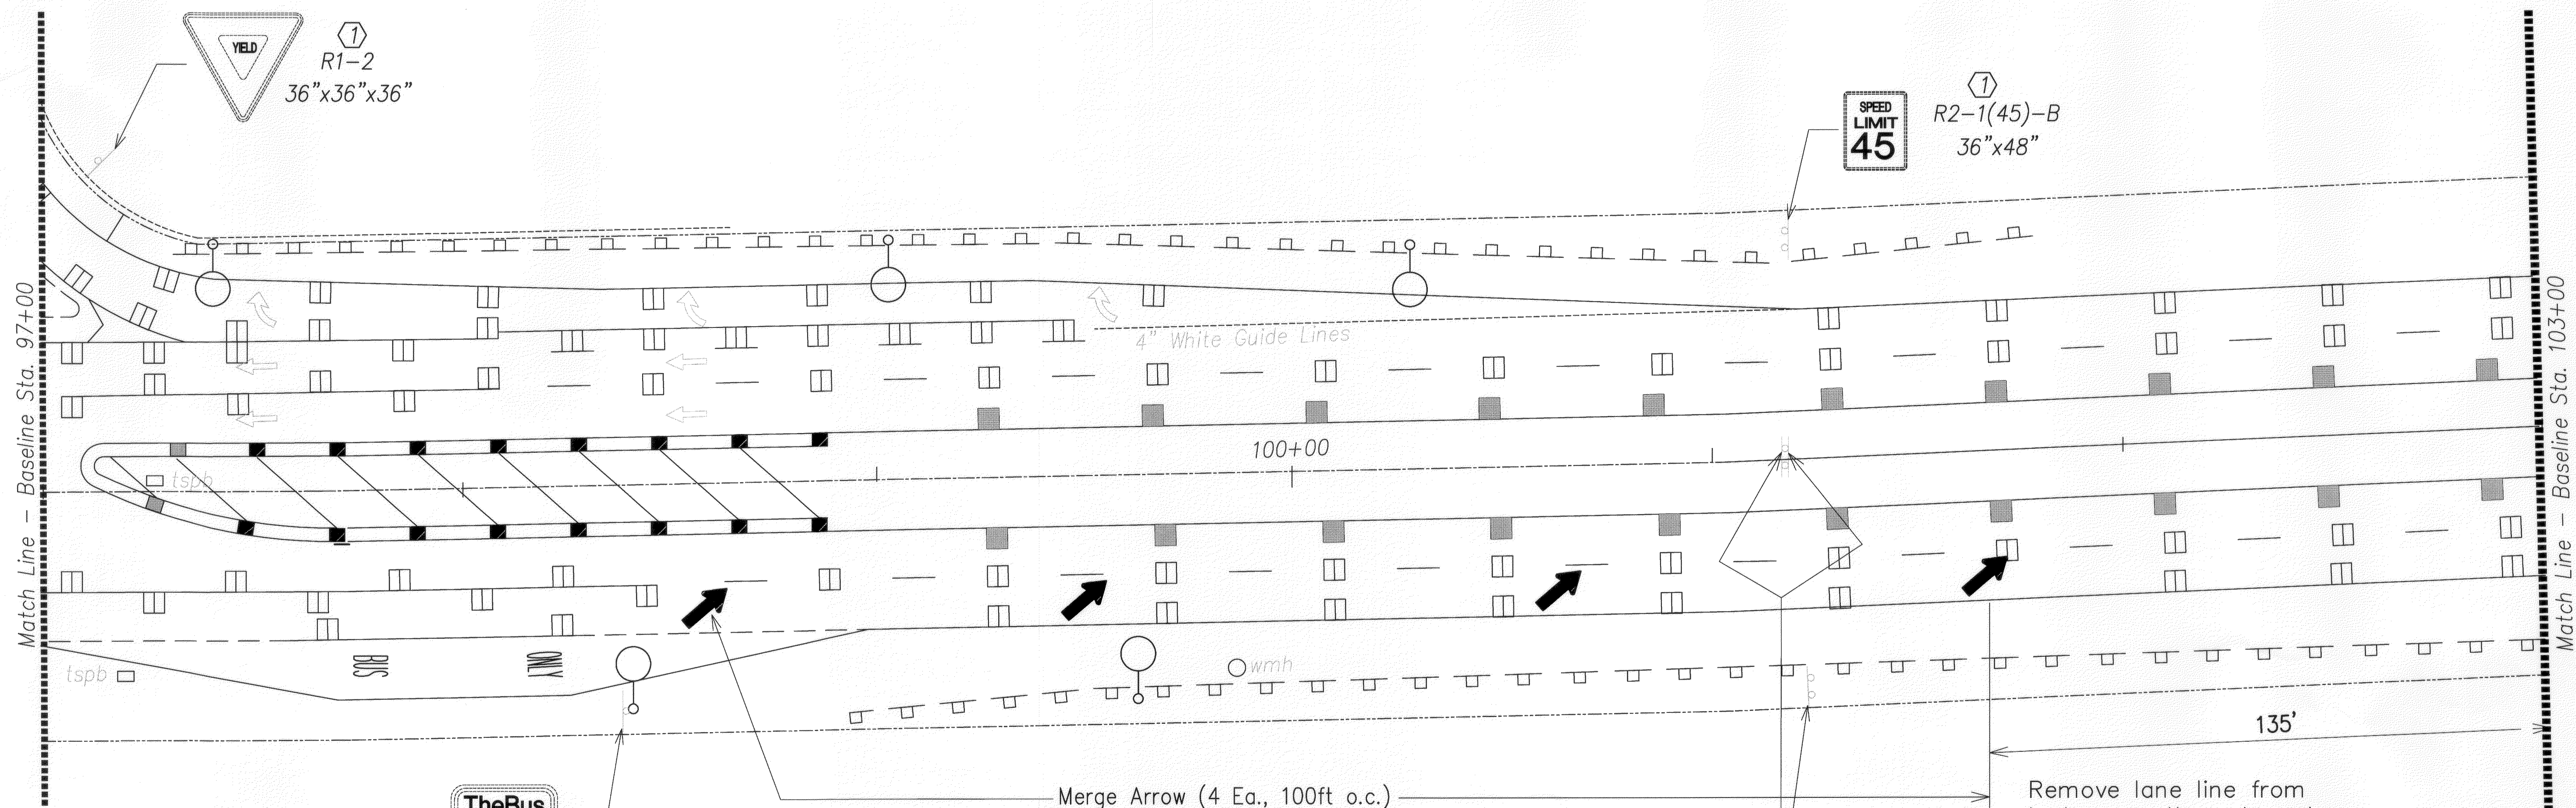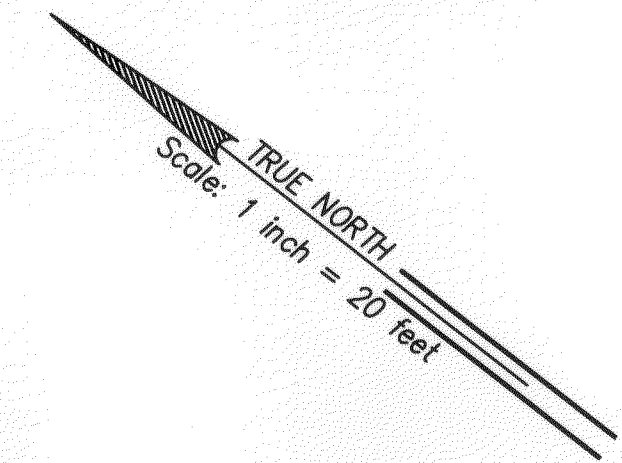

①
R7-107b
12"x24"
(12"x6")*

- Notes:**
- Eradicate 3 ea. existing merge arrows between Sta. 103+00 and 106+00
 - Eradicate existing taper line and markers between Sta. 106+00 and 110+39
 - Add taper between Sta. 103+00 and 108+50 with Type C raised pavement markers at 40' OC (Approximately 14 markers)
 - Extend diagonals or add new diagonals to taper line between Sta. 103+00 and 108+50
 - Remove 11 ea old delineators between Sta. 106+00 and 110+39 and install new flexible delineator post, white, 35' OC along taper between Sta. 103+00 and 108+50. (Approximately 16 ea.) (Can reuse 11 old delineators, if replace base)
 - Stripe new right edgeline with markers between Sta. 108+50 to 110+39. Tie in to existing at 110+39. Extend existing diagonals to new edgeline.

①
R2-1(45)-B
36"x48"

- NOTES:**
- ① Exist. Sign To Remain
 - ② Install New Sign W/ New Post(s)
 - ③ Remove Exist. Sign & Post(s)
 - ④ Salvage Exist. Sign & Remove Exist. Post(s)
 - ⑤ Install Exist. Sign On New Posts(s)
 - ⑥ Median Nose Delineation
 - ⑦ Seal milled areas in asphalt concrete pavement with Emulsified Asphalt (Type SS-1, SS-1h, CSS-1, CSS-1h).

LEGEND FOR AS-BUILT POSTING

	Squiggly line for as-built deletion
	Double line for as-built deletion
	Text for as-built posting

KENNETH O. NAKA
LICENSED PROFESSIONAL ENGINEER
No. 3285-C
HAWAII, U.S.A.

[Signature]
SIGNATURE
APRIL 30, 2010
EXPIRATION DATE OF LICENSE
THIS WORK WAS PREPARED BY ME OR UNDER MY SUPERVISION

STATE OF HAWAII
DEPARTMENT OF TRANSPORTATION
HIGHWAYS DIVISION

SIGNING & PAVEMENT MARKING PLAN - 1

KALANIANA'OLE HIGHWAY MEDIAN IMPROVEMENTS VICINITY OF OLOMANA GOLF COURSE PROJECT NO. 72A-02-06


SCALE: As Shown DATE: June 2008

DATE	_____
DESIGNED BY	_____
CHECKED BY	_____
NO. _____	


"AS-BUILT"

CC022S-1

FED. ROAD DIST. NO.	STATE	PROJECT NO.	FISCAL YEAR	SHEET NO.	TOTAL SHEETS
HAWAII	HAW.	72A-02-06	2008	225-2	66

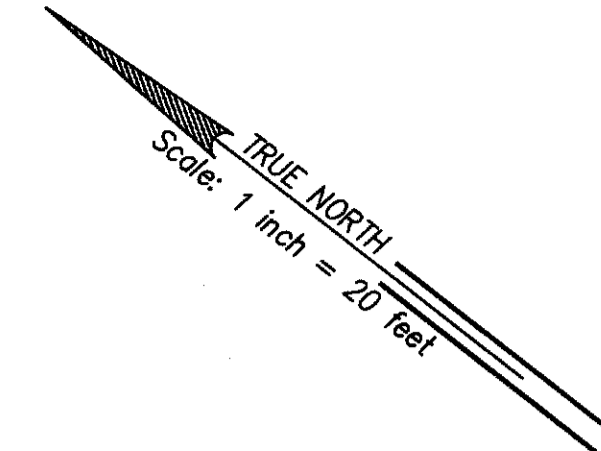

Match Line - Baseline Sta. 103+00
Begin Merge Taper
Tie into Existing Pavement
Striping and Markers

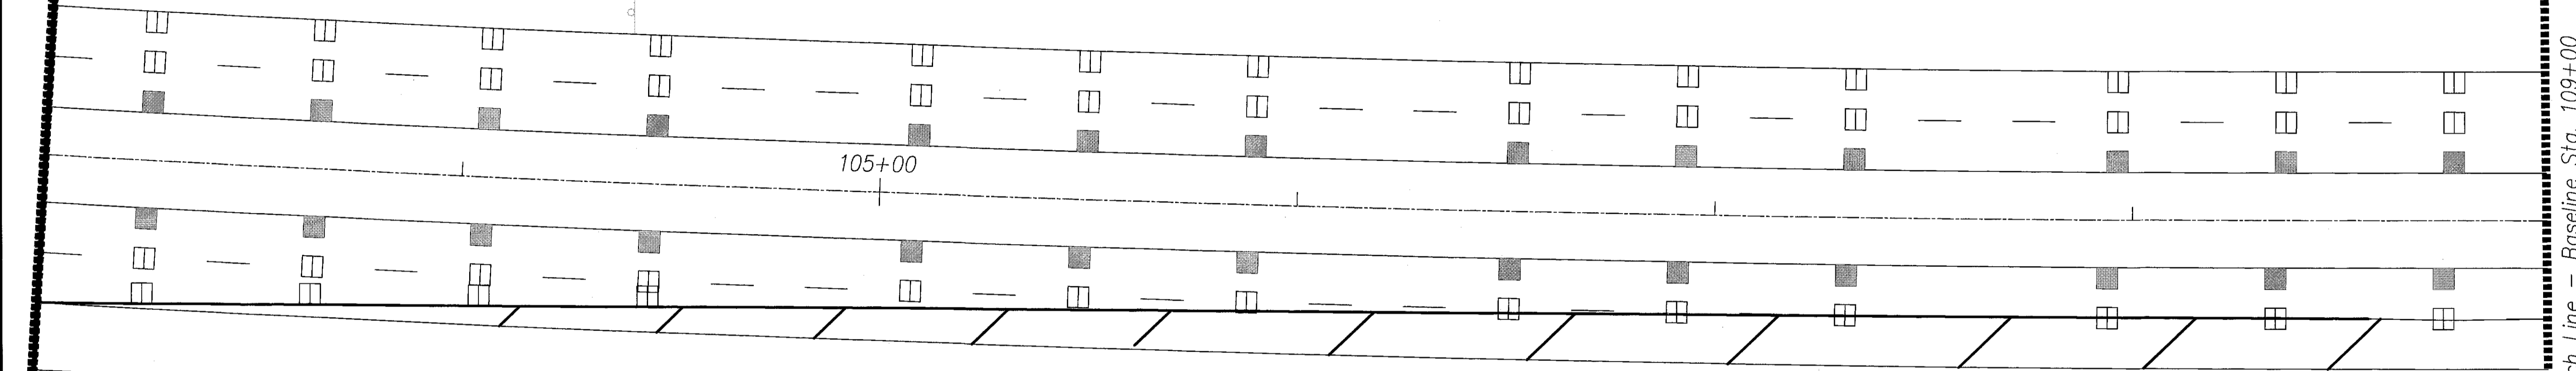


Match Line - Baseline Sta. 109+00

①
D10-4
12"x24"
②
D10-7
10"x7"

①
D10-4
12"x24"
D10-7
10"x7"
②
MILE
2
72

Notes:

- Eradicate 3 ea. existing merge arrows between Sta. 103+00 and 106+00
- Eradicate existing taper line and markers between Sta. 106+00 and 110+39
- Add taper between Sta. 103+00 and 108+50 with Type C raised pavement markers at 40' OC (Approximately 14 markers)
- Extend diagonals or add new diagonals to taper line between Sta. 103+00 and 108+50
- Remove 11 ea old delineators between Sta. 106+00 and 110+39 and install new flexible delineator post, white, 35' OC along taper between Sta. 103+00 and 108+50. (Approximately 16 ea.) (Can reuse 11 old delineators, if replace base)
- Stripe new right edgeline with markers between Sta. 108+50 to 110+39. Tie in to existing at 110+39. Extend existing diagonals to new edgeline.

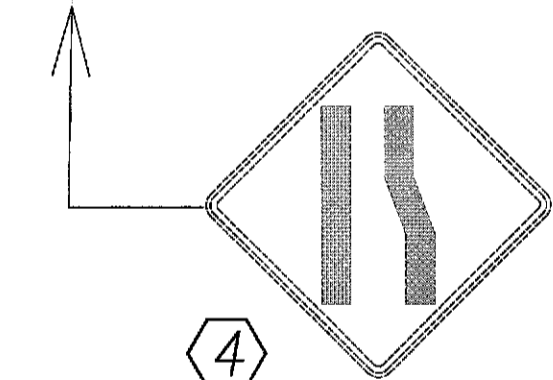

④
W4-2(R)
36" X 36"
Relocate from approx Sta. 107+00 to 95+50




②
W4-2(R) Remove Construction Sign and return to State.
36" X 36" Sign and return to State.
New warning sign at about Sta. 93+75.

LEGEND FOR AS-BUILT POSTING

	Squiggly line for as-built deletion
	Double line for as-built deletion
	Text for as-built posting

NOTES:

- ① Exist. Sign To Remain
- ② Install New Sign W/ New Post(s)
- ③ Remove Exist. Sign & Post(s)
- ④ Salvage Exist. Sign & Remove Exist. Post(s)
- ⑤ Install Exist. Sign On New Posts(s)
- ⑥ Median Nose Delineation
- ⑦ Seal milled areas in asphalt concrete pavement with Emulsified Asphalt (Type SS-1, SS-1h, CSS-1, CSS-1h).

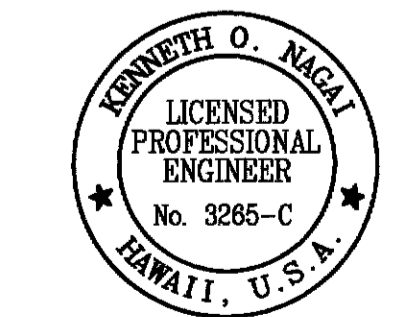

SIGNATURE
APRIL 30, 2010
EXPIRATION DATE OF LICENSE
THIS WORK WAS PREPARED BY ME OR UNDER MY SUPERVISION

STATE OF HAWAII
DEPARTMENT OF TRANSPORTATION
HIGHWAYS DIVISION

SIGNING & PAVEMENT MARKING PLAN - 1

KALANIANA'OLE HIGHWAY MEDIAN IMPROVEMENTS VICINITY OF OLOMANA GOLF COURSE PROJECT NO. 72A-02-06


SCALE: As Shown DATE: June 2008

SURVEY PLOTTED BY	DATE
DRAWN BY	
TRACED BY	
CHECKED BY	
ORIGINAL PLAN	
NOTE BOOK	
No.	

"AS-BUILT"

CC0 22 S-2

FED. ROAD DIST. NO.	STATE	PROJECT NO.	FISCAL YEAR	SHEET NO.	TOTAL SHEETS
HAWAII	HAW.	72A-02-06	2008	23	66

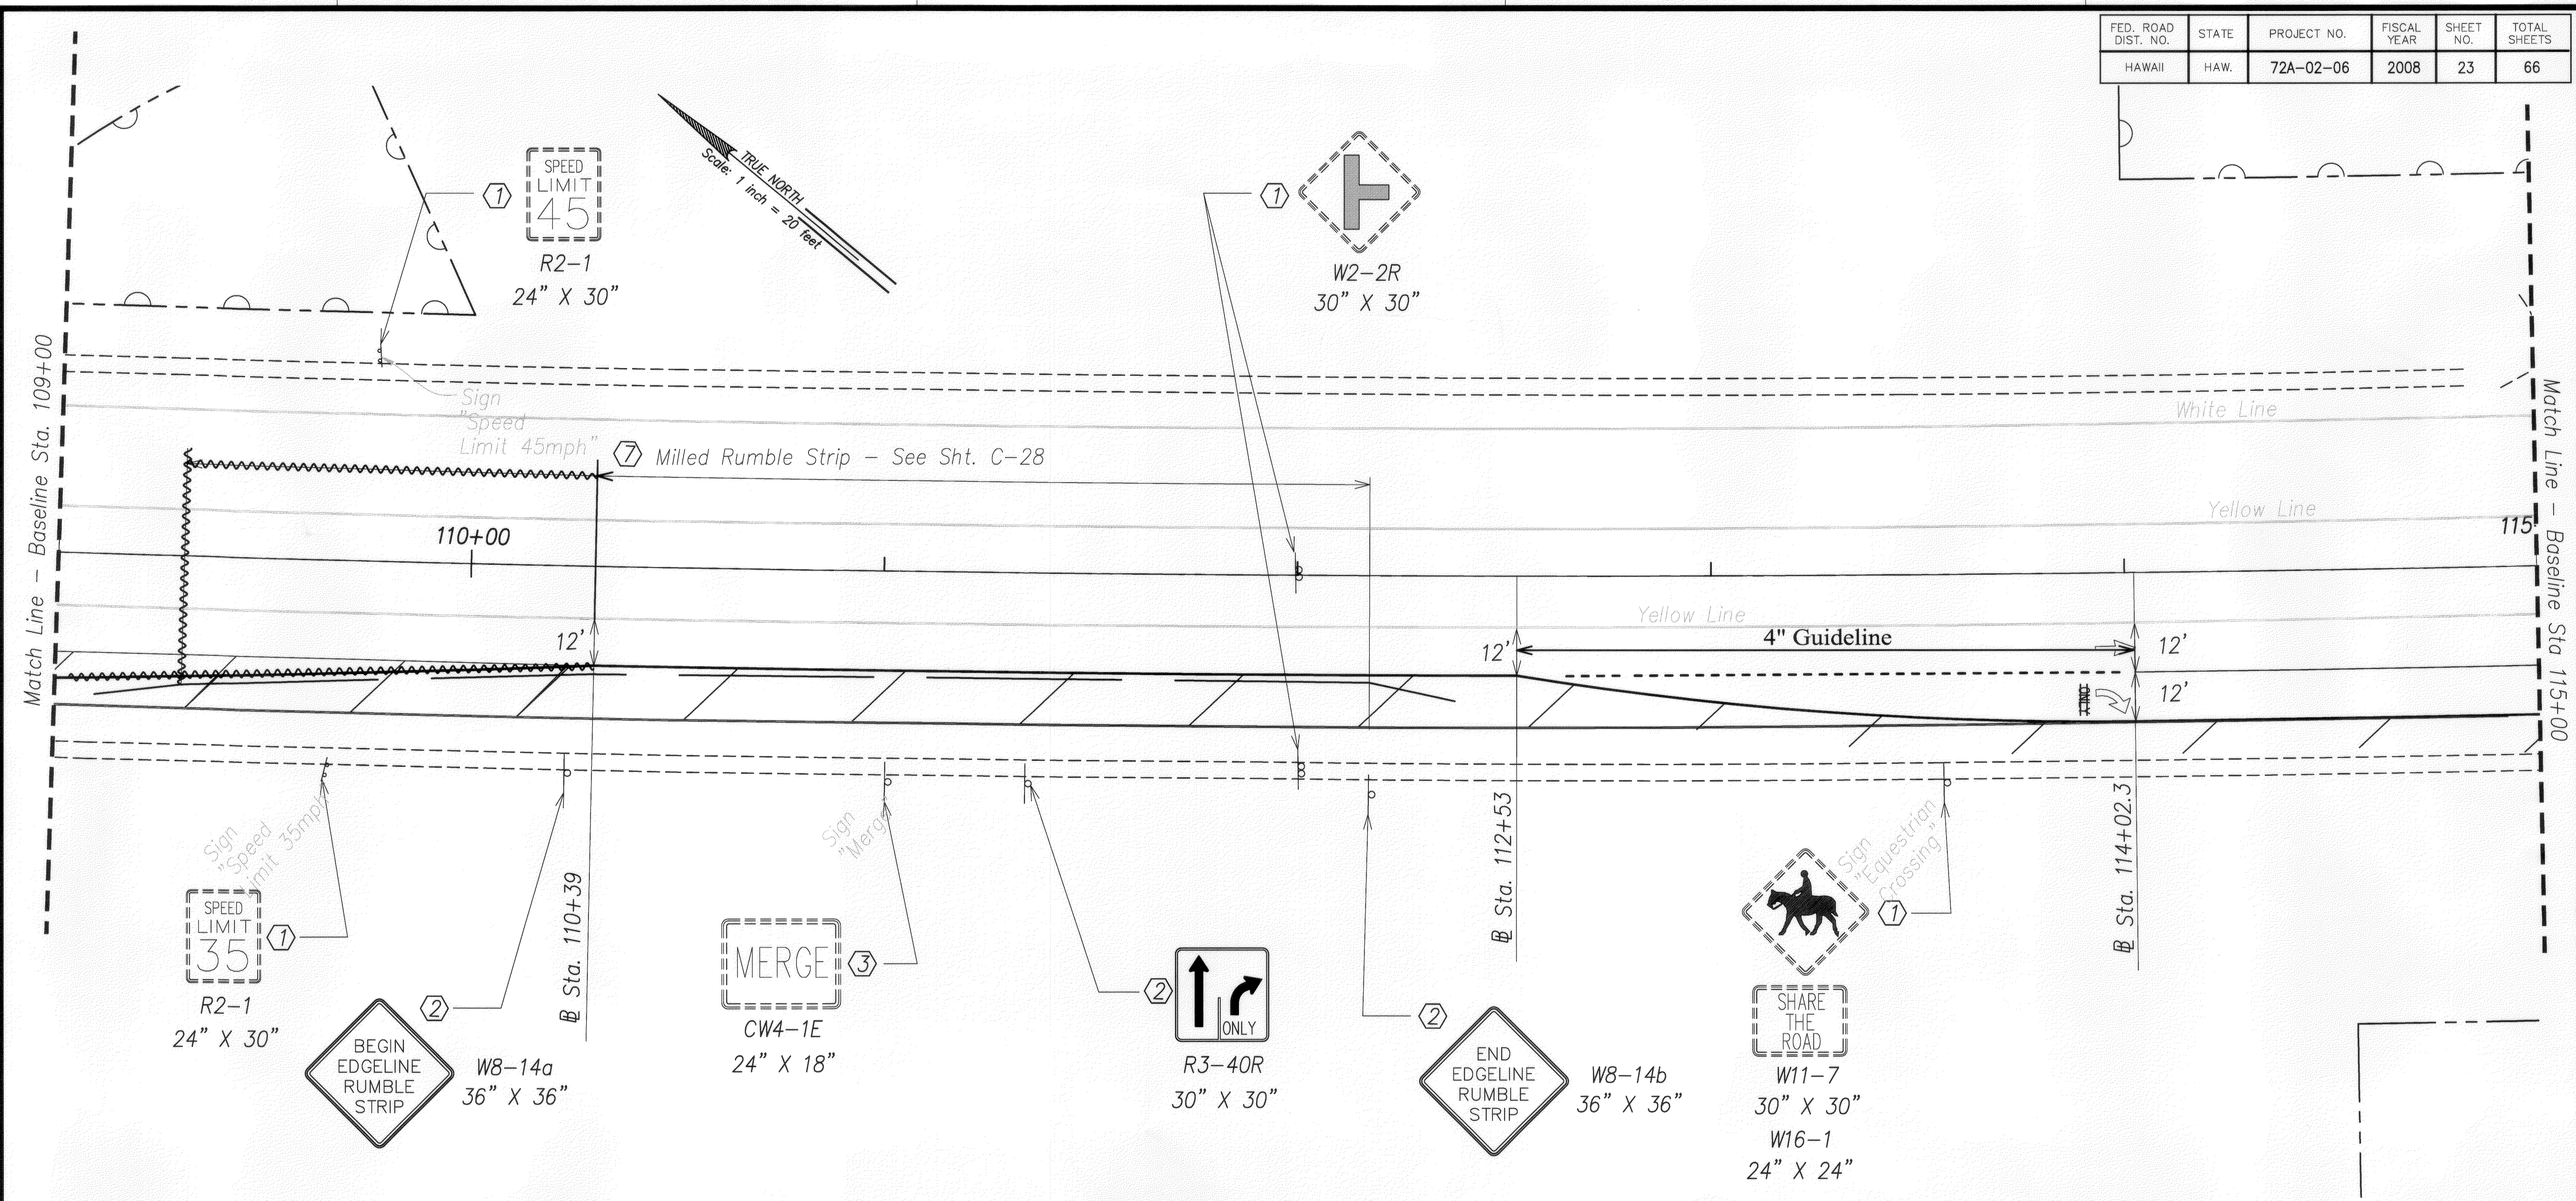

NOTES:

- ① Exist. Sign To Remain
- ② Install New Sign W/ New Post(s)
- ③ Remove Exist. Sign & Post(s)
- ④ Salvage Exist. Sign & Remove Exist. Post(s)
- ⑤ Install Exist. Sign On New Posts(s)
- ⑥ Median Nose Delineation
- ⑦ Seal milled areas in asphalt concrete pavement with Emulsified Asphalt (Type SS-1, SS-1h, CSS-1, CSS-1h).

LEGEND FOR AS-BUILT POSTING

	Squiggly line for as-built deletion
	Double line for as-built deletion
	Roadway Text for as-built posting

DATE	_____
SURVEY PLOTTED BY	_____
DRAWN BY	_____
CHECKED BY	_____
APPROVED BY	_____
ORIGINAL PLAN	_____
NOTE BOOK	_____
No.	_____

KENNETH O. NACA
 LICENSED PROFESSIONAL ENGINEER
 No. 3265-C
 HAWAII, U.S.A.

SIGNATURE:

APRIL 30, 2010
 EXPIRATION DATE OF LICENSE

THIS WORK WAS PREPARED BY ME OR UNDER MY SUPERVISION

STATE OF HAWAII
 DEPARTMENT OF TRANSPORTATION
 HIGHWAYS DIVISION

SIGNING & PAVEMENT MARKING PLAN - 2


KALANIANA'OLE HIGHWAY MEDIAN IMPROVEMENTS VICINITY OF OLOMANA GOLF COURSE PROJECT NO. 72A-02-06

SCALE: 1"=40' DATE: June 2008

SHEET No. C-21 OF 43 SHEETS

"AS-BUILT"

FED. ROAD DIST. NO.	STATE	PROJECT NO.	FISCAL YEAR	SHEET NO.	TOTAL SHEETS
HAWAII	HAW.	72A-02-06	2008	24	66

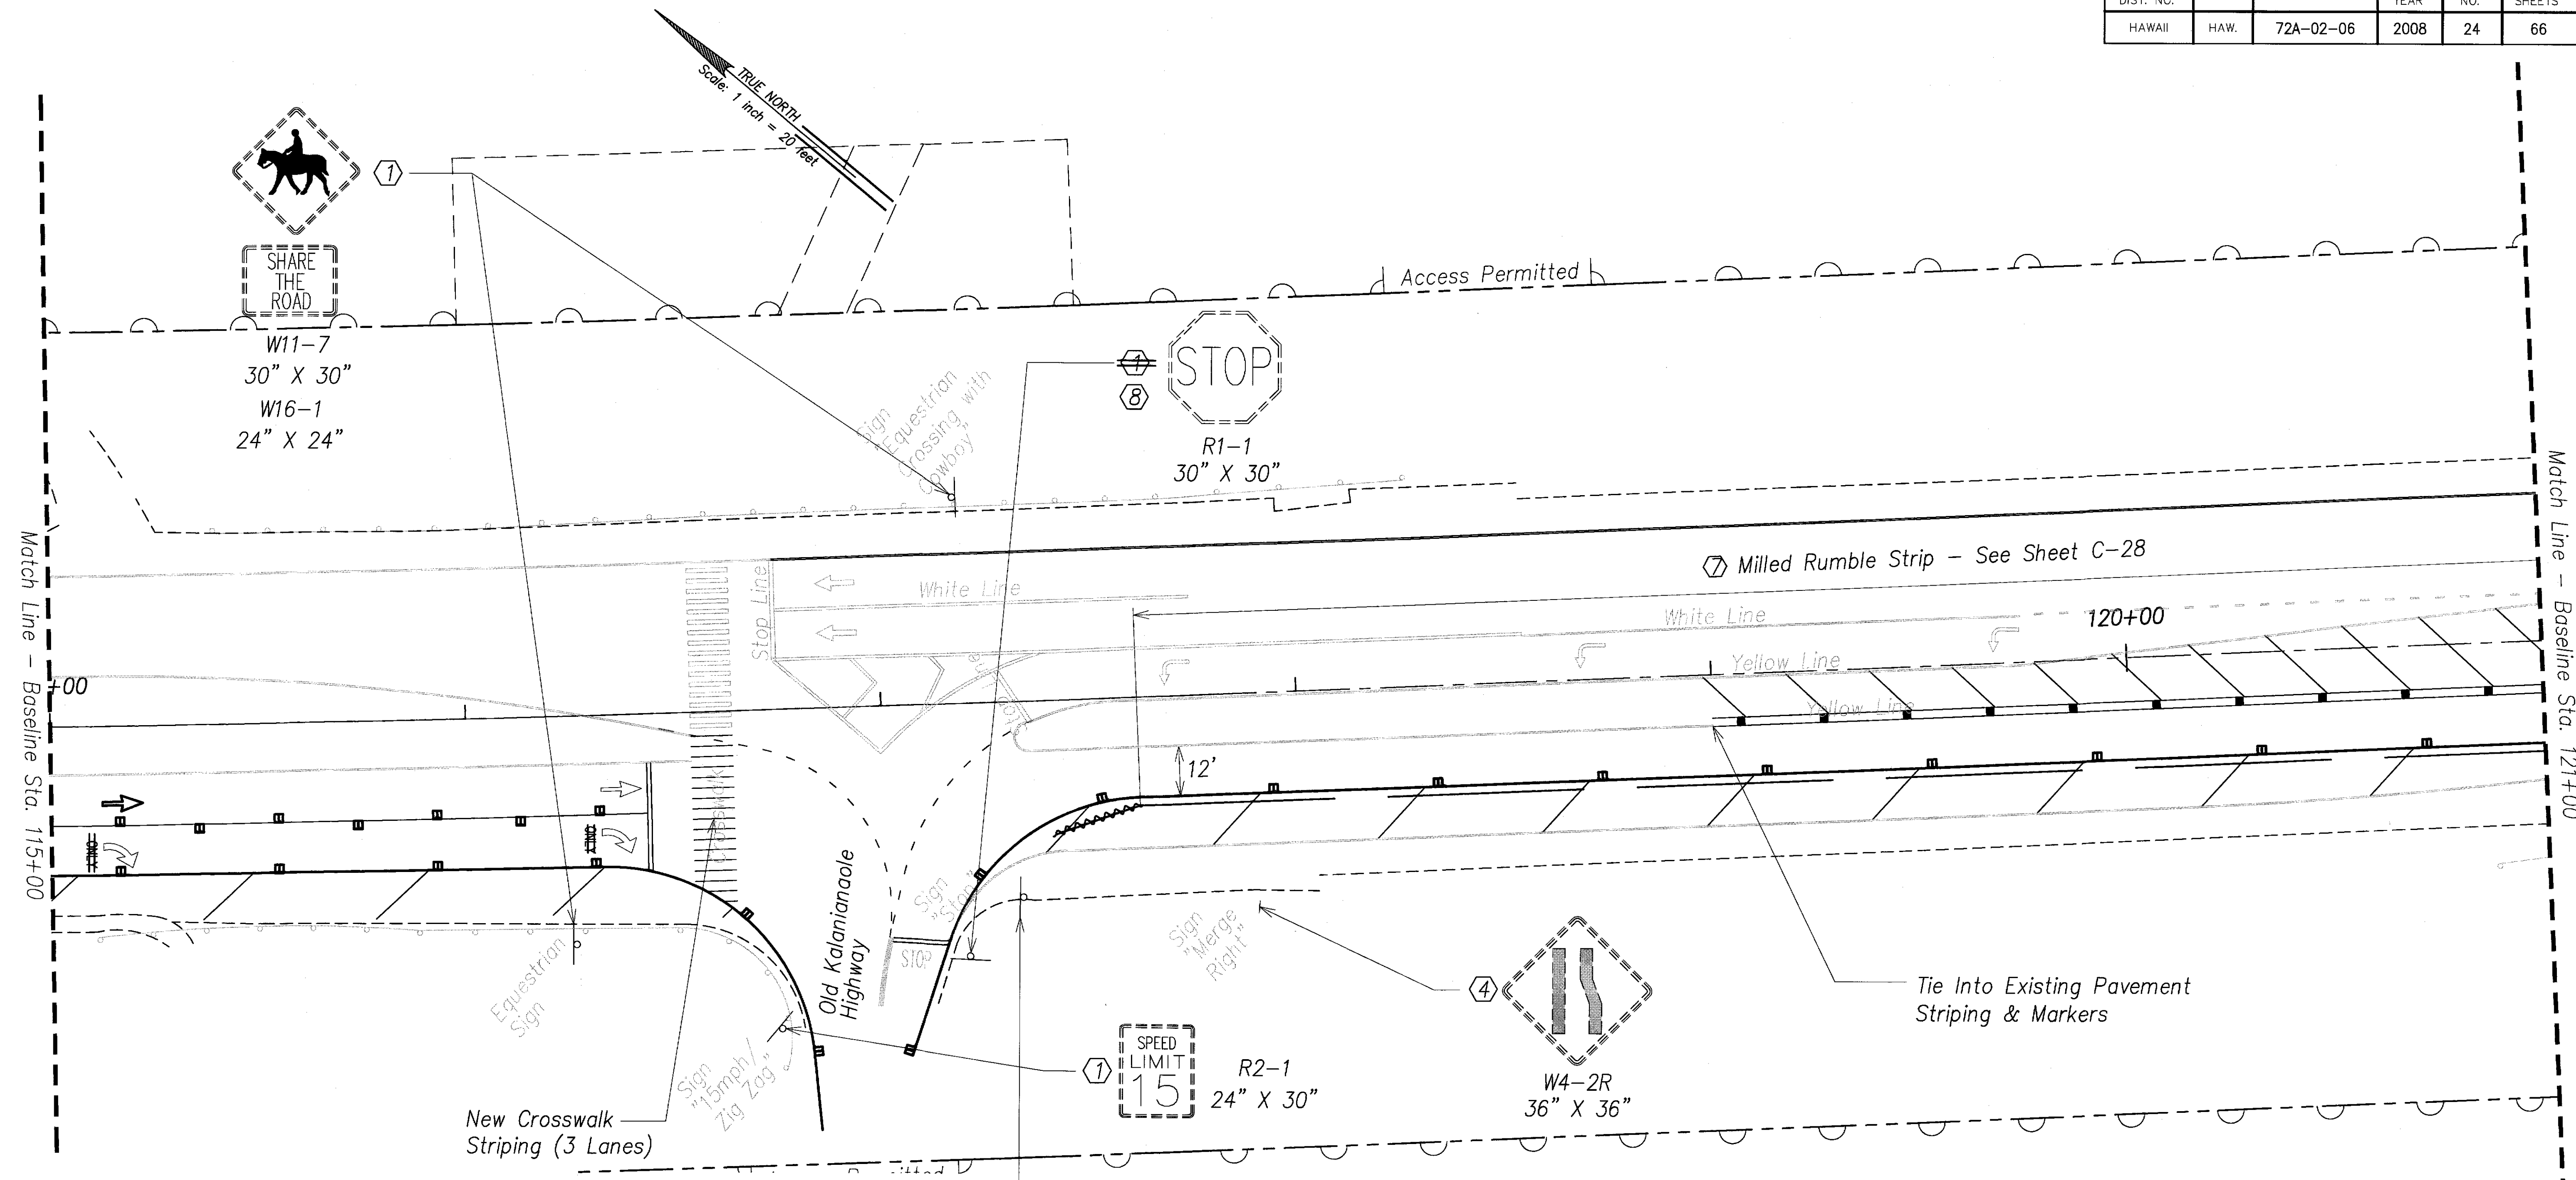

NOTES:

- ① Exist. Sign To Remain
- ② Install New Sign W/ New Post(s)
- ③ Remove Exist. Sign & Post(s)
- ④ Salvage Exist. Sign & Remove Exist. Post(s)
- ⑤ Install Exist. Sign On New Posts(s)
- ⑥ Median Nose Delineation
- ⑦ Seal milled areas in asphalt concrete pavement with Emulsified Asphalt (Type SS-1, SS-1h, CSS-1, CSS-1h).
- ⑧ Remove Existing Sign & Post(s) and Install New Sign on New Post(s)

LEGEND FOR AS-BUILT POSTING	
	Squiggly line for as-built deletion
	Double line for as-built deletion
	Text for as-built posting


DATE
SURVEY PLOTTED BY
DRAWN BY
TRACED BY
DESIGNED BY
CHECKED BY
ORIGINAL PLAN
NOTE BOOK
No.

SIGNATURE: *Kenneth O. Nagai*
 APRIL 30, 2010
 EXPIRATION DATE OF LICENSE
 THIS WORK WAS PREPARED BY ME OR UNDER MY SUPERVISION

STATE OF HAWAII
 DEPARTMENT OF TRANSPORTATION
 HIGHWAYS DIVISION
SIGNING & PAVEMENT MARKING PLAN - 3
 KALANIANA'OLE HIGHWAY MEDIAN IMPROVEMENTS VICINITY OF OLOMANA GOLF COURSE PROJECT NO. 72A-02-06
 SCALE: 1"=40' DATE: June 2008
 SHEET No. C-22 OF 43 SHEETS

"AS-BUILT"

FED. ROAD DIST. NO.	STATE	PROJECT NO.	FISCAL YEAR	SHEET NO.	TOTAL SHEETS
HAWAII	HAW.	72A-02-06	2008	25	66

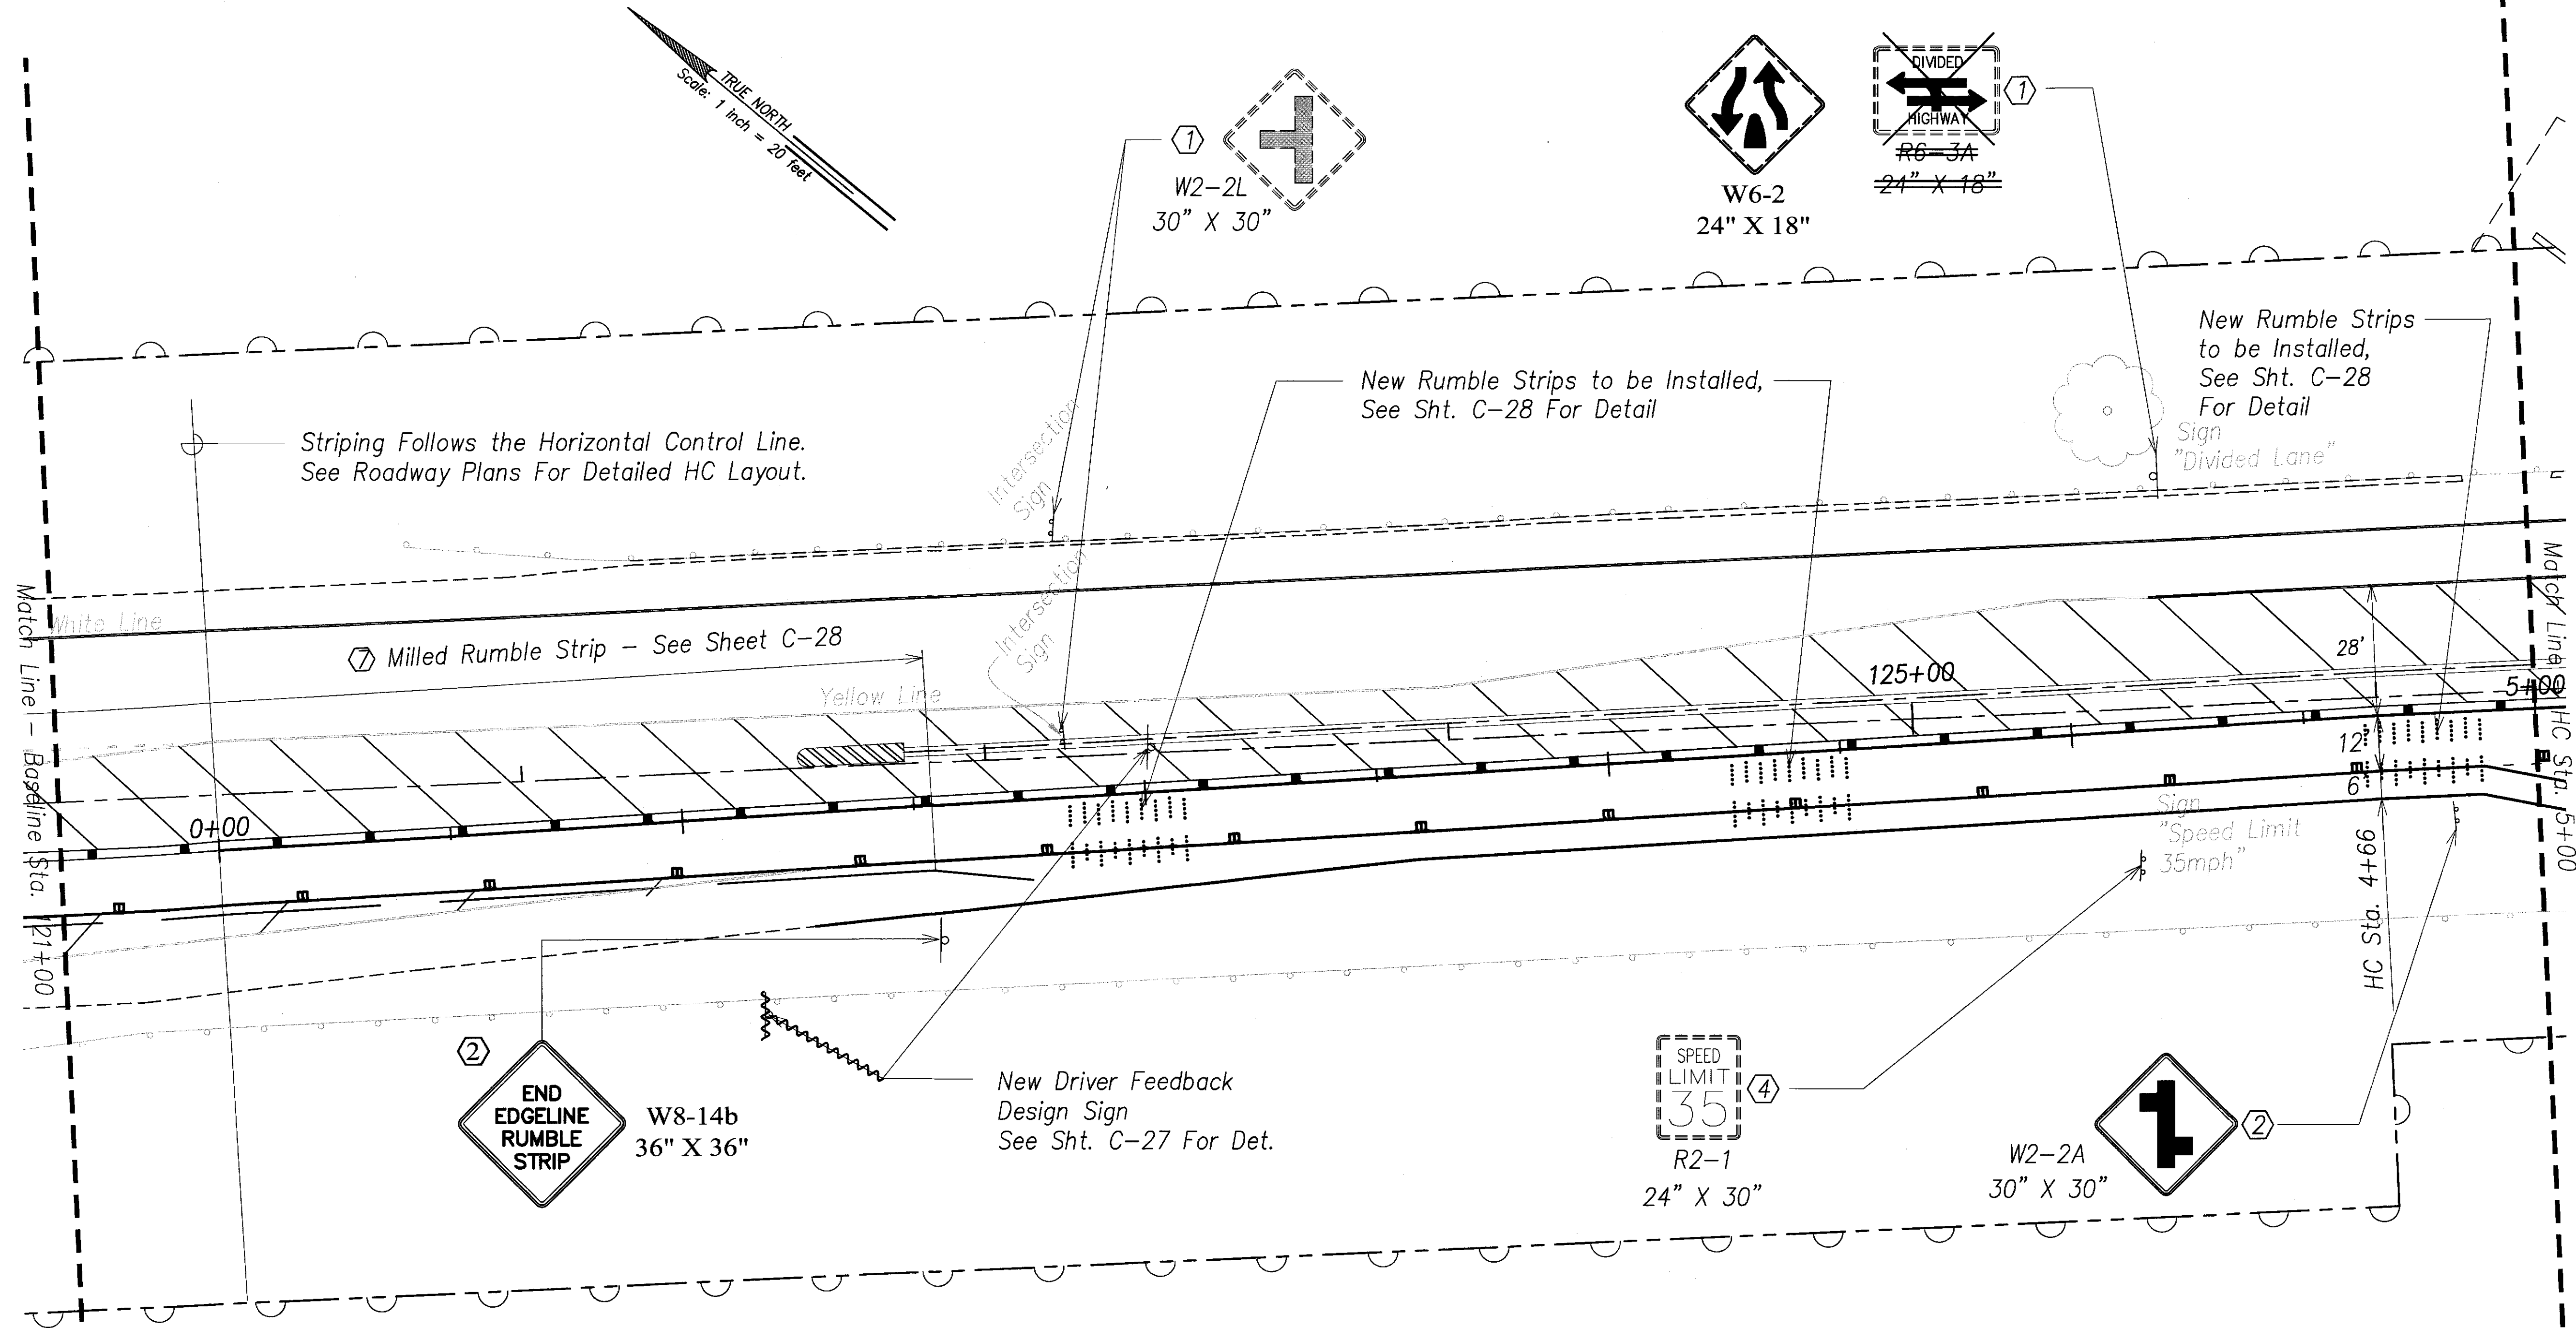

- NOTES:**
- ① Exist. Sign To Remain
 - ② Install New Sign W/ New Post(s)
 - ③ Remove Exist. Sign & Post(s)
 - ④ Salvage Exist. Sign & Remove Exist. Post(s)
 - ⑤ Install Exist. Sign On New Posts(s)
 - ⑥ Median Nose Delineation
 - ⑦ Seal milled areas in asphalt concrete pavement with Emulsified Asphalt (Type SS-1, SS-1h, CSS-1, CSS-1h).

LEGEND FOR AS-BUILT POSTING


	Squiggly line for as-built deletion
	Double line for as-built deletion
	Roadway Text for as-built posting

KENNETH O. MAGLI
 LICENSED PROFESSIONAL ENGINEER
 No. 3265-C
 HAWAII, U.S.A.
 APRIL 30, 2010
 EXPIRATION DATE OF LICENSE
 THIS WORK WAS PREPARED BY ME OR UNDER MY SUPERVISION

STATE OF HAWAII
 DEPARTMENT OF TRANSPORTATION
 HIGHWAYS DIVISION
SIGNING & PAVEMENT MARKING PLAN - 4
 KALANIANA'OLE HIGHWAY MEDIAN IMPROVEMENTS VICINITY OF OLOMANA GOLF COURSE PROJECT NO. 72A-02-06
 SCALE: 1"=40' DATE: June 2008

DESIGNED BY	DATE
PLANNED BY	
QUANTITIES BY	
CHECKED BY	
ORIGINAL PLAN	
NOTE BOOK	
No.	

"AS-BUILT"

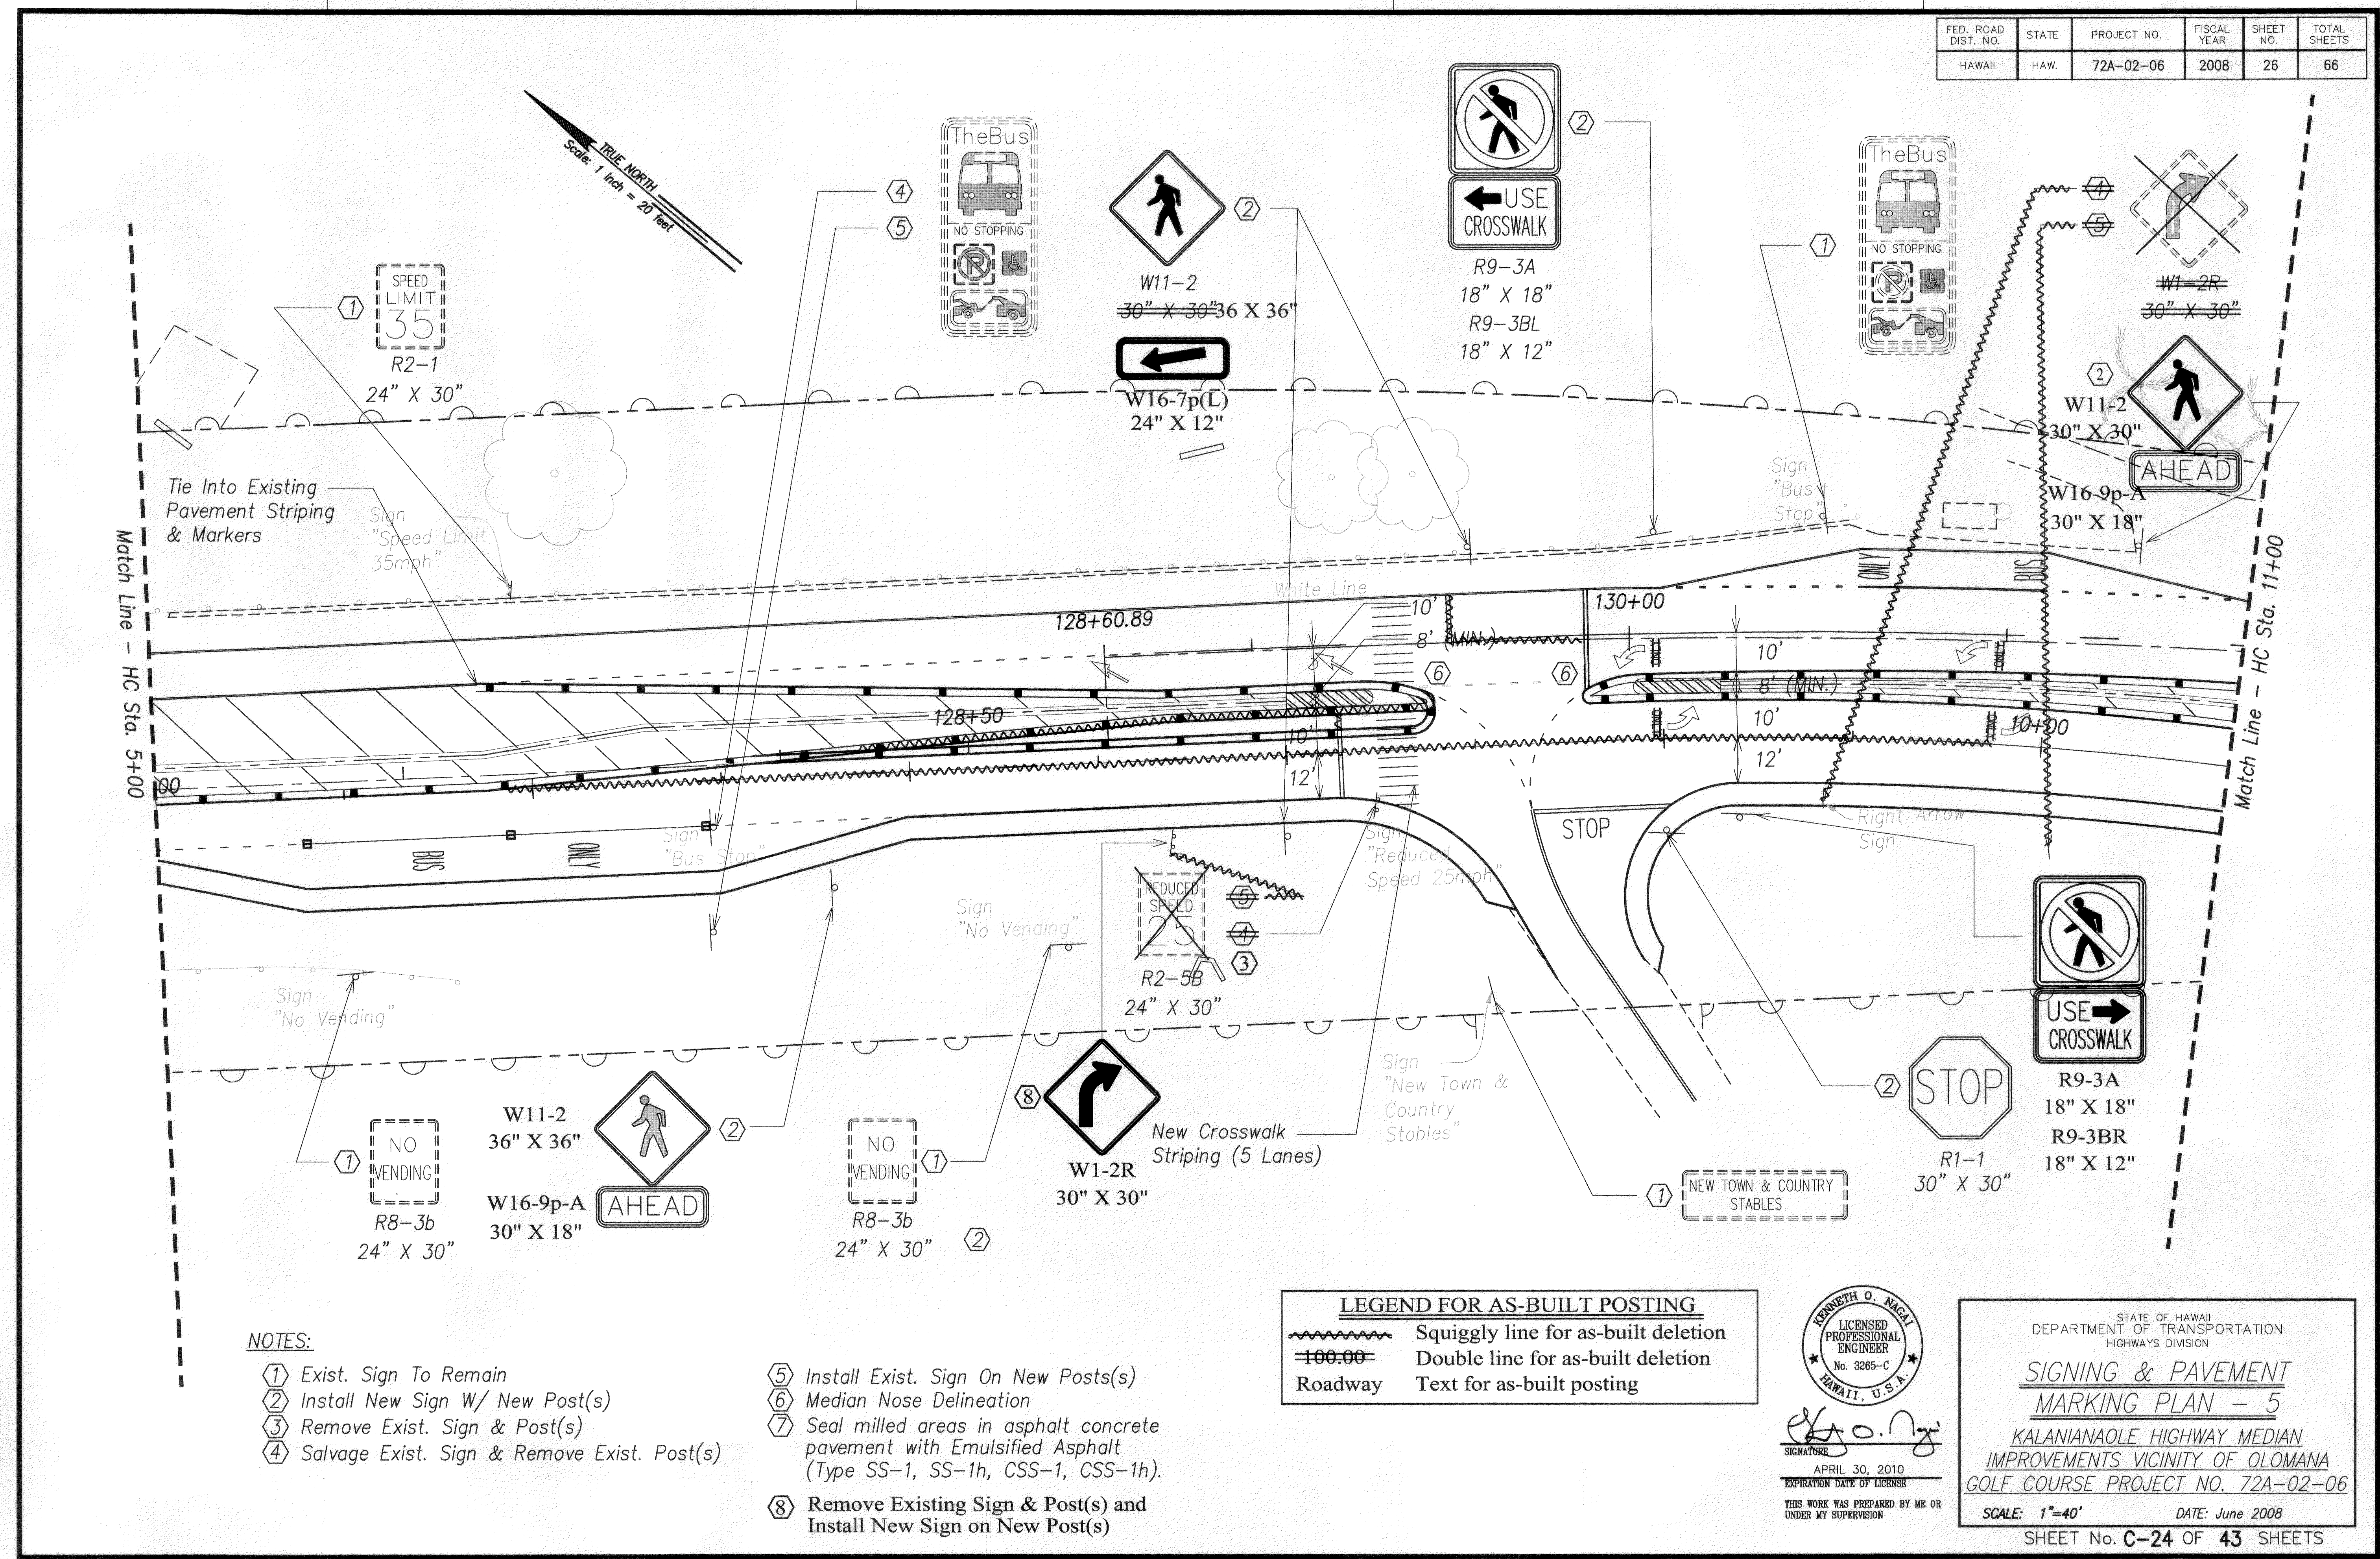

NOTES:

- ① Exist. Sign To Remain
- ② Install New Sign W/ New Post(s)
- ③ Remove Exist. Sign & Post(s)
- ④ Salvage Exist. Sign & Remove Exist. Post(s)
- ⑤ Install Exist. Sign On New Posts(s)
- ⑥ Median Nose Delineation
- ⑦ Seal milled areas in asphalt concrete pavement with Emulsified Asphalt (Type SS-1, SS-1h, CSS-1, CSS-1h).
- ⑧ Remove Existing Sign & Post(s) and Install New Sign on New Post(s)

LEGEND FOR AS-BUILT POSTING

	Squiggly line for as-built deletion
	Double line for as-built deletion
	Text for as-built posting



SIGNATURE: *[Signature]*
 APRIL 30, 2010
 EXPIRATION DATE OF LICENSE
 THIS WORK WAS PREPARED BY ME OR UNDER MY SUPERVISION

STATE OF HAWAII
 DEPARTMENT OF TRANSPORTATION
 HIGHWAYS DIVISION

SIGNING & PAVEMENT MARKING PLAN - 5


KALANIANA'OLE HIGHWAY MEDIAN IMPROVEMENTS VICINITY OF OLOMANA GOLF COURSE PROJECT NO. 72A-02-06

SCALE: 1"=40' DATE: June 2008
 SHEET No. C-24 OF 43 SHEETS

DATE	_____
DESIGNED BY	_____
CHECKED BY	_____
DATE	_____
DESIGNED BY	_____
CHECKED BY	_____
DATE	_____
DESIGNED BY	_____
CHECKED BY	_____

"AS-BUILT"

FED. ROAD DIST. NO.	STATE	PROJECT NO.	FISCAL YEAR	SHEET NO.	TOTAL SHEETS
HAWAII	HAW.	72A-02-06	2008	27	66

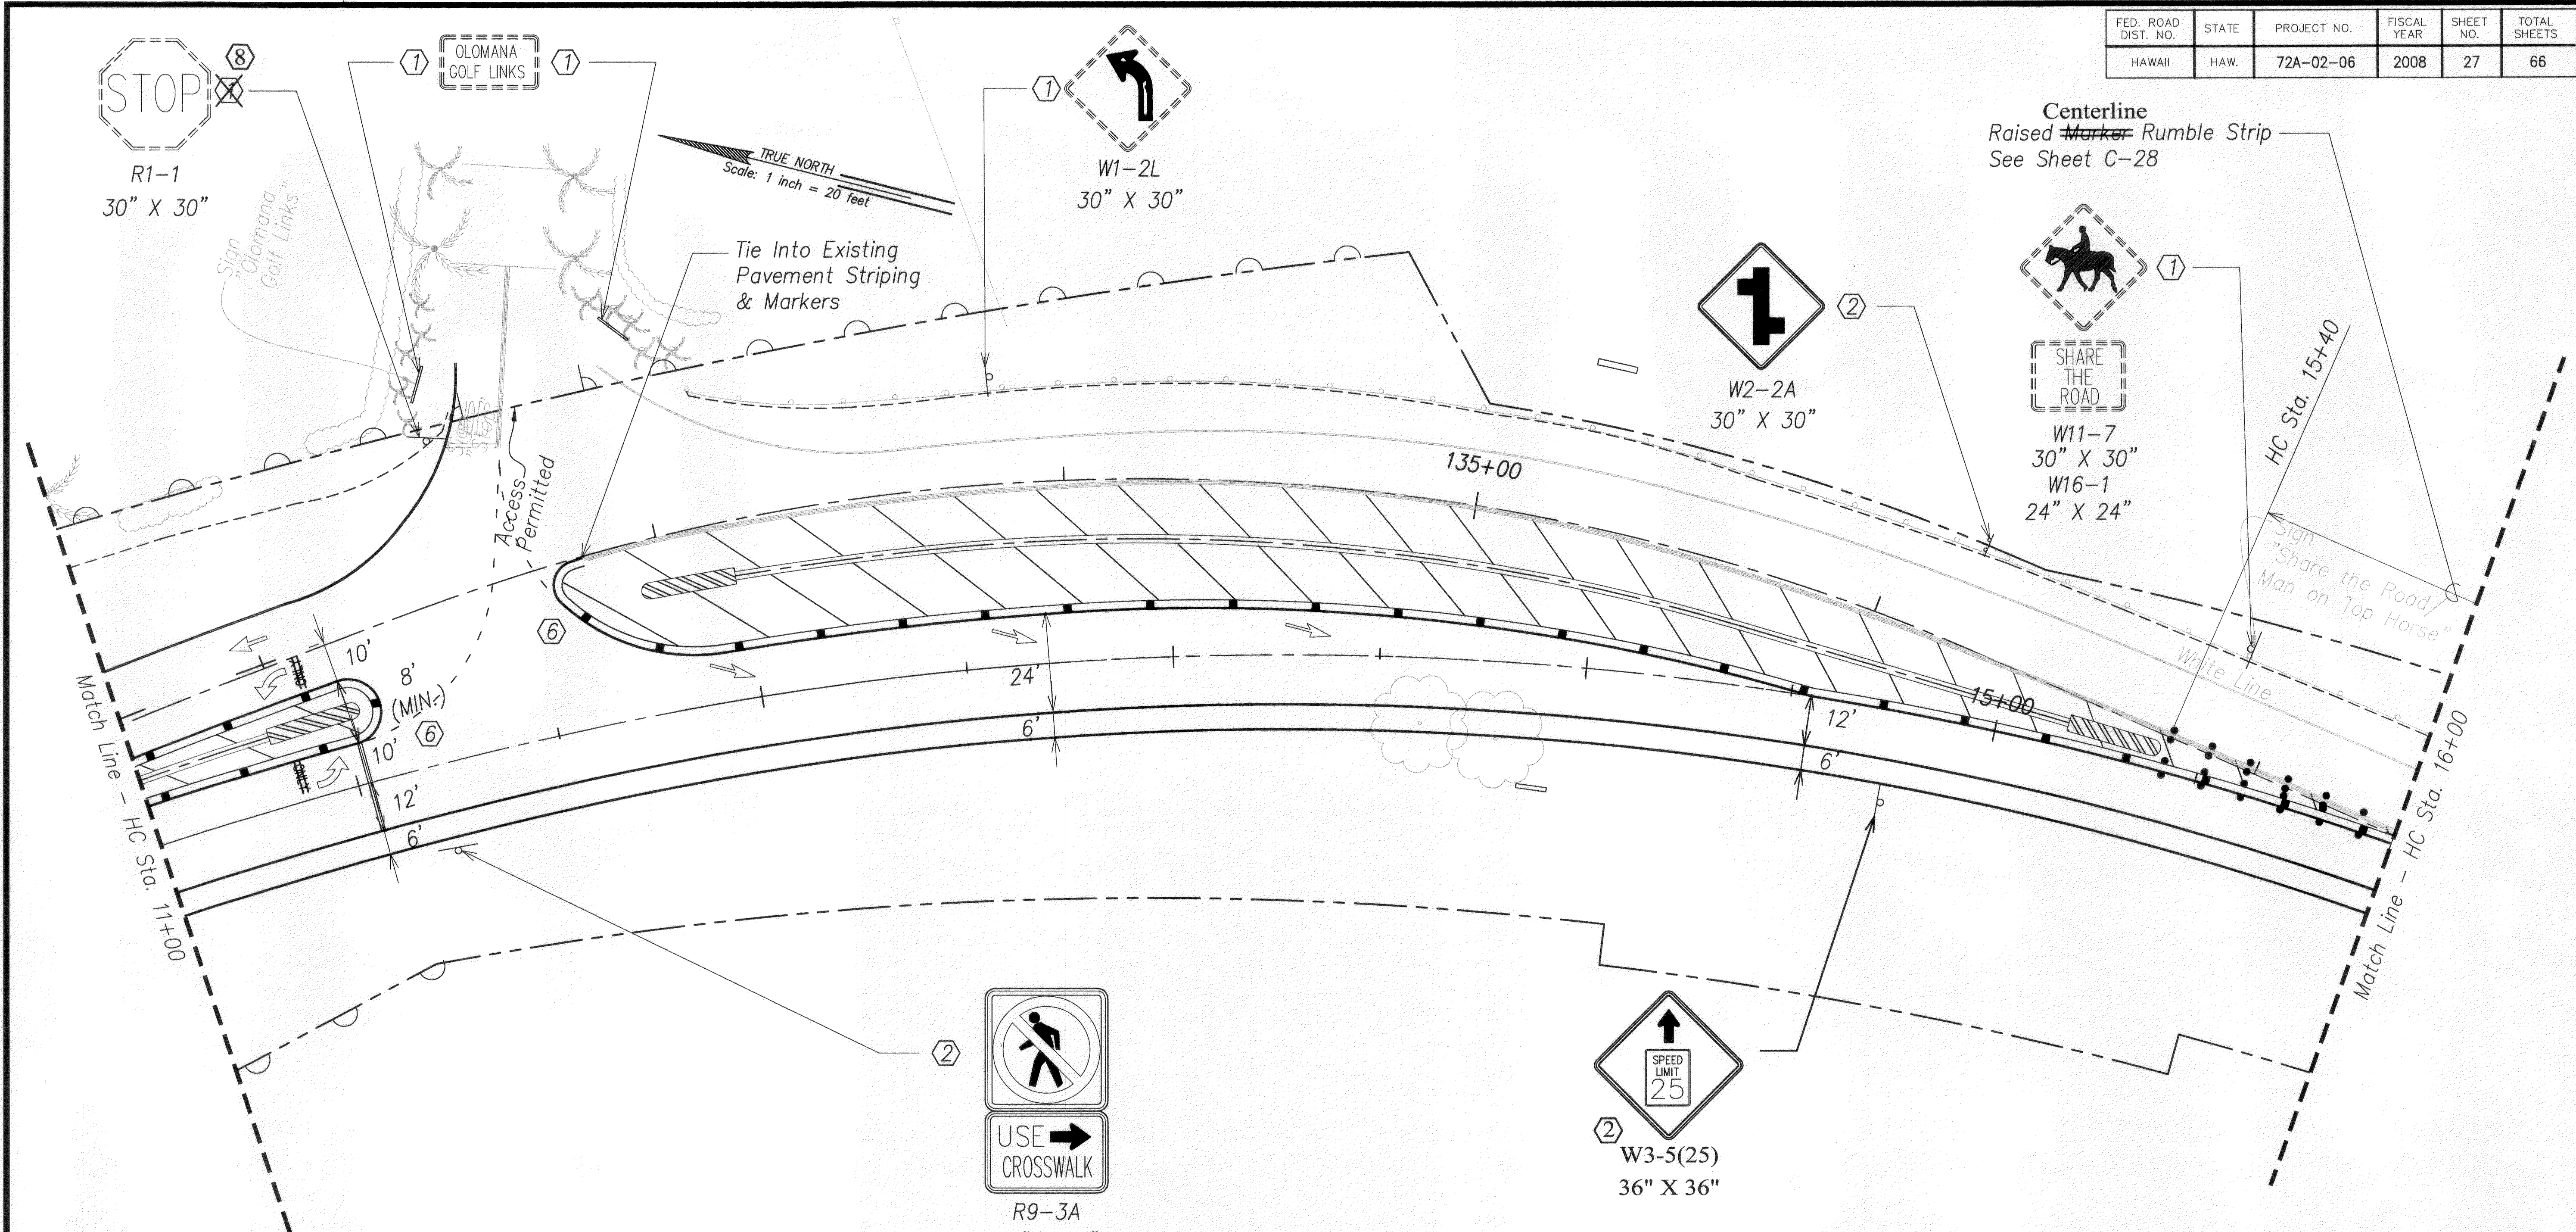

R1-1
30" X 30"

W1-2L
30" X 30"

W2-2A
30" X 30"

W11-7
30" X 30"
W16-1
24" X 24"

R9-3A
18" X 18"
R9-3BR
18" X 12"

W3-5(25)
36" X 36"

NOTES:

- ① Exist. Sign To Remain
- ② Install New Sign W/ New Post(s)
- ③ Remove Exist. Sign & Post(s)
- ④ Salvage Exist. Sign & Remove Exist. Post(s)
- ⑤ Install Exist. Sign On New Posts(s)
- ⑥ Median Nose Delineation
- ⑦ Seal milled areas in asphalt concrete pavement with Emulsified Asphalt (Type SS-1, SS-1h, CSS-1, CSS-1h).
- ⑧ Remove Existing Sign & Post(s) and Install New Sign on New Post(s)

LEGEND FOR AS-BUILT POSTING

	Squiggly line for as-built deletion
	Double line for as-built deletion
Roadway	Text for as-built posting



DESIGNED BY	DATE
TRACED BY	
QUANTITIES BY	
CHECKED BY	
NO. _____	

KENNETH O. MCGILL
LICENSED PROFESSIONAL ENGINEER
No. 3286-C
HAWAII, U.S.A.
[Signature]
APRIL 30, 2010
EXPIRATION DATE OF LICENSE
THIS WORK WAS PREPARED BY ME OR UNDER MY SUPERVISION

STATE OF HAWAII
DEPARTMENT OF TRANSPORTATION
HIGHWAYS DIVISION
SIGNING & PAVEMENT MARKING PLAN - 6
KALANIANA'OLE HIGHWAY MEDIAN IMPROVEMENTS VICINITY OF OLOMANA GOLF COURSE PROJECT NO. 72A-02-06
SCALE: 1"=40' DATE: June 2008
SHEET No. C-25 OF 43 SHEETS

"AS-BUILT"

FED. ROAD DIST. NO.	STATE	PROJECT NO.	FISCAL YEAR	SHEET NO.	TOTAL SHEETS
HAWAII	HAW.	72A-02-06	2008	28	66

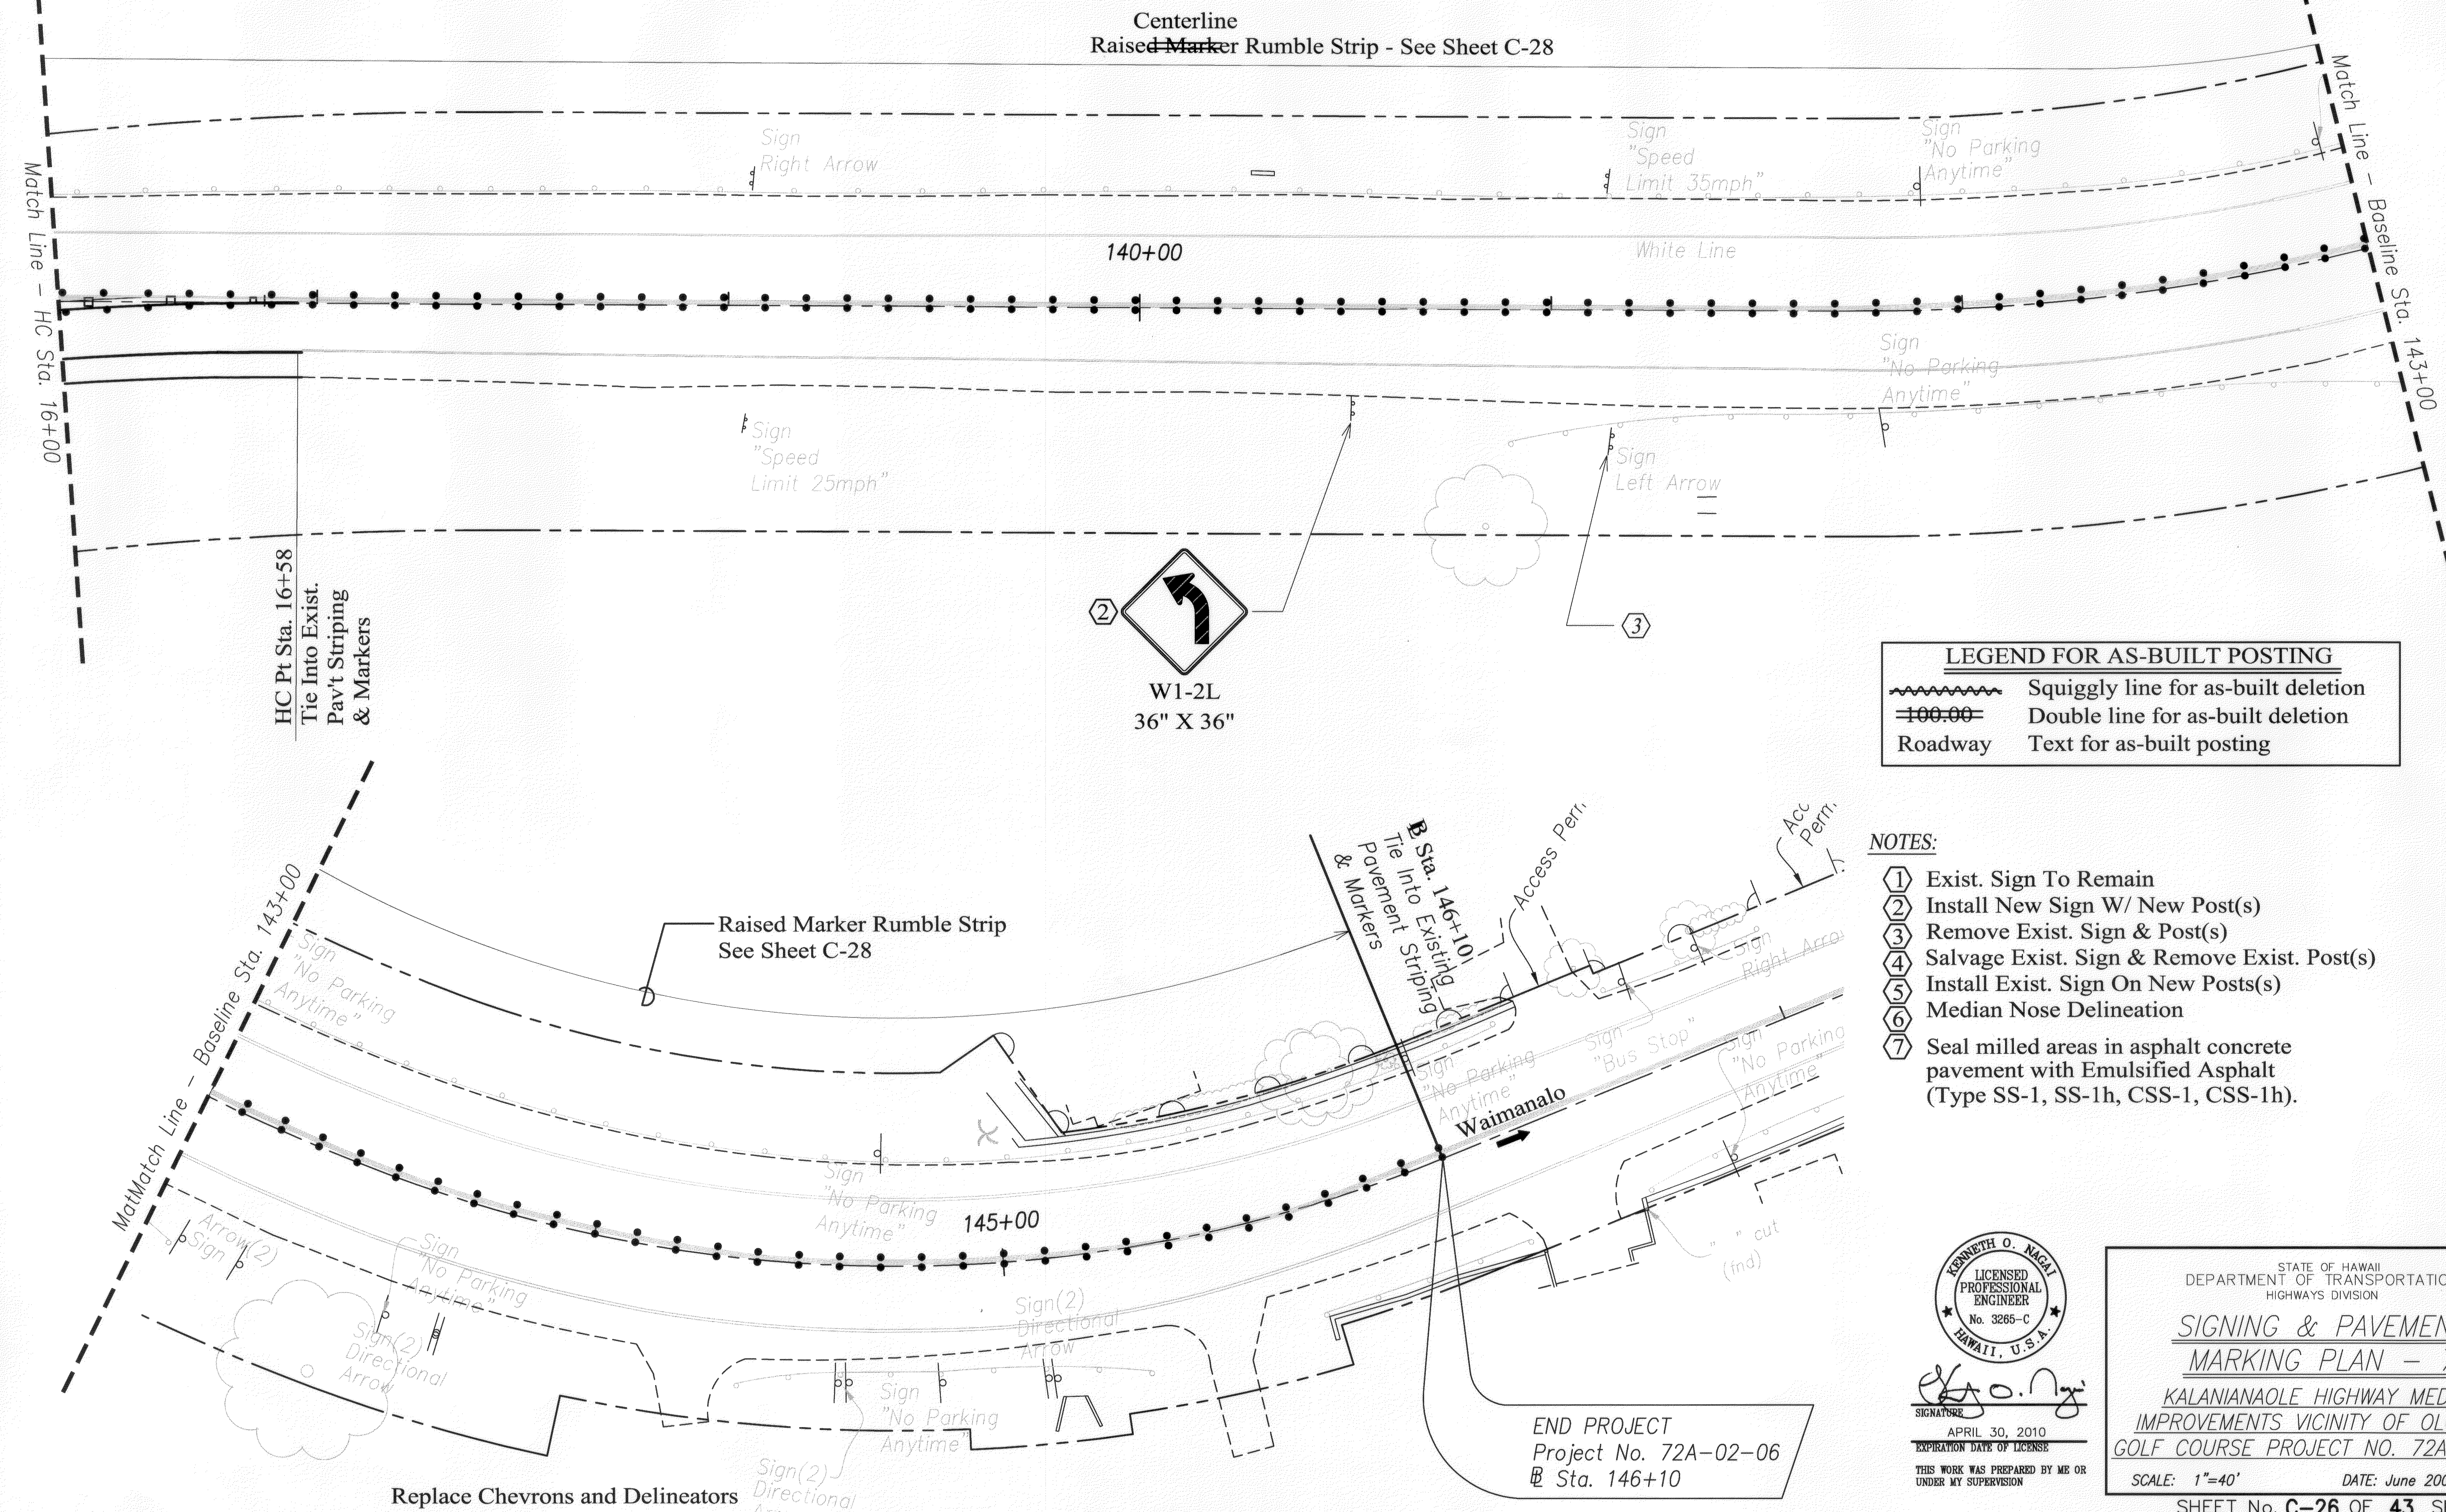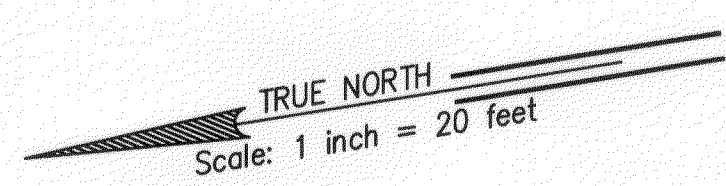

LEGEND FOR AS-BUILT POSTING

	Squiggly line for as-built deletion
	Double line for as-built deletion
	Roadway Text for as-built posting

- NOTES:**
- ① Exist. Sign To Remain
 - ② Install New Sign W/ New Post(s)
 - ③ Remove Exist. Sign & Post(s)
 - ④ Salvage Exist. Sign & Remove Exist. Post(s)
 - ⑤ Install Exist. Sign On New Posts(s)
 - ⑥ Median Nose Delineation
 - ⑦ Seal milled areas in asphalt concrete pavement with Emulsified Asphalt (Type SS-1, SS-1h, CSS-1, CSS-1h).

DESIGNED BY	DATE
DESIGNED BY	DATE
KENNETH O. MAGUI
 LICENSED PROFESSIONAL ENGINEER
 No. 3265-C
 HAWAII, U.S.A.

[Signature]
 SIGNATURE
 APRIL 30, 2010
 EXPIRATION DATE OF LICENSE
 THIS WORK WAS PREPARED BY ME OR UNDER MY SUPERVISION

STATE OF HAWAII
 DEPARTMENT OF TRANSPORTATION
 HIGHWAYS DIVISION

SIGNING & PAVEMENT MARKING PLAN - 7

KALANIANA'OLE HIGHWAY MEDIAN
 IMPROVEMENTS VICINITY OF OLOMANA
 GOLF COURSE PROJECT NO. 72A-02-06

SCALE: 1"=40' DATE: June 2008

SHEET No. C-26 OF 43 SHEETS

END PROJECT
 Project No. 72A-02-06
 Sta. 146+10

"AS-BUILT"