



INDEX TO DRAWINGS	
SHEET NO.	DESCRIPTION
1	TITLE SHEET
2	STANDARD PLANS SUMMARY
3	GENERAL NOTES AND LEGEND
4 - 5	WATER POLLUTION AND EROSION CONTROL NOTES
6 - 7	HAWAIIAN ELECTRIC COMPANY (HECO) NOTES
8	GENERAL SITE PLAN
9 - 10	TYPICAL SECTIONS
11 - 14	ROADWAY PLANS
15 - 17	DRAINAGE PLANS
18	INTERSECTION DETAIL PLAN
19	DRAIN LINE PROFILES
20	GUARDRAIL DETAILS
21	SIGNING & PAVEMENT MARKING LEGEND AND NOTES
22 - 28	SIGNING & PAVEMENT MARKING PLANS
29	SIGNING & PAVEMENT MARKING DETAILS
30	RUMBLE STRIP DETAILS AND NOTES
31	WORK ZONE SIGNING PLAN, NOTES, AND DETAILS
32	PORTABLE CONCRETE BARRIER INSTALLATION PLAN
33 - 34	PORTABLE CONC. BARRIER DETAILS
35 - 37	BORING LOGS AND LOCATION PLAN
38 - 43	ROAD CROSS SECTIONS
44 - 51	STRUCTURAL PLANS
52 - 66	ELECTRICAL PLANS

FED. ROAD DIST. NO.	STATE	PROJECT NO.	FISCAL YEAR	SHEET NO.	TOTAL SHEETS
HAWAII	HAW.	72A-02-06	2008	1	66

STATE OF HAWAII
DEPARTMENT OF TRANSPORTATION
HIGHWAYS DIVISION
HONOLULU, HAWAII

"AS-BUILT" PLANS FOR
**KALANIANA'OLE HIGHWAY
MEDIAN IMPROVEMENTS
VICINITY OF OLOMANA GOLF COURSE**
PROJECT NO. 72A-02-06

DISTRICT OF KO'OLAUPOKO
ISLAND OF OAHU

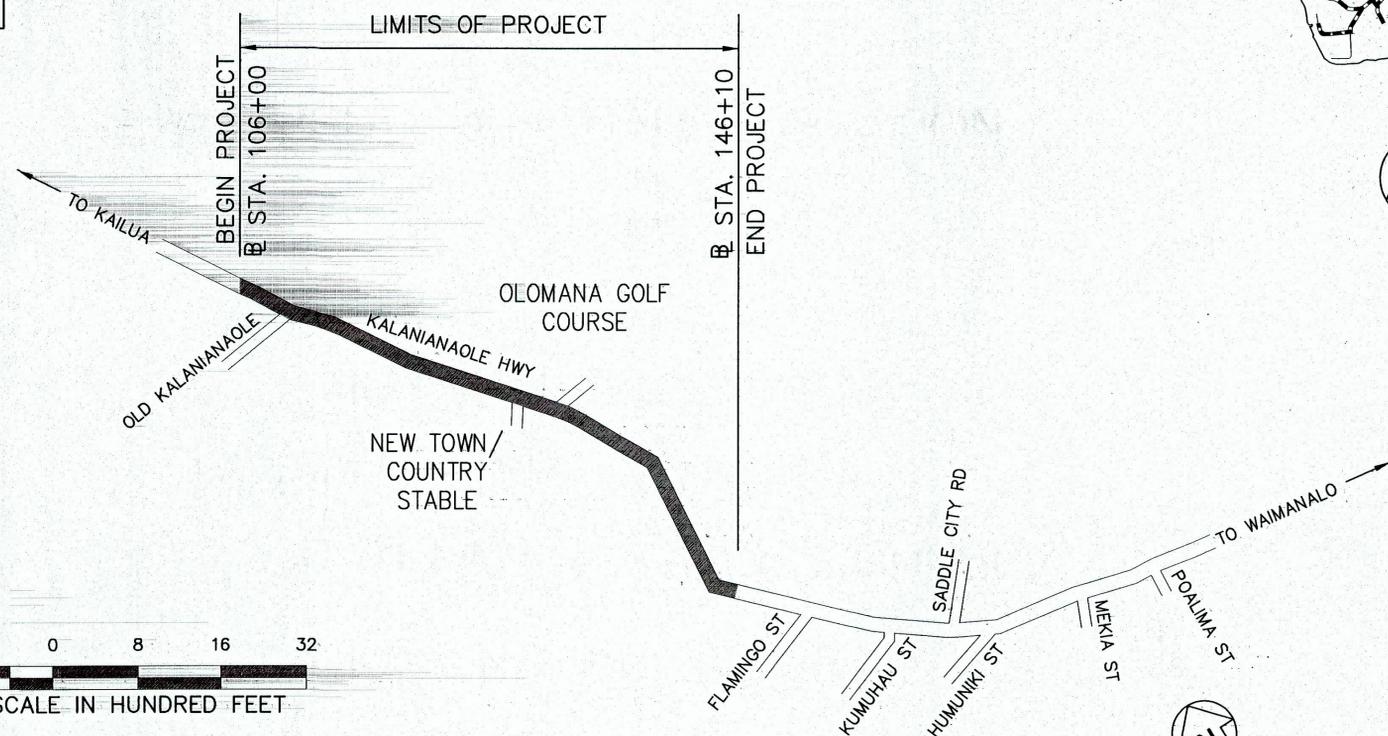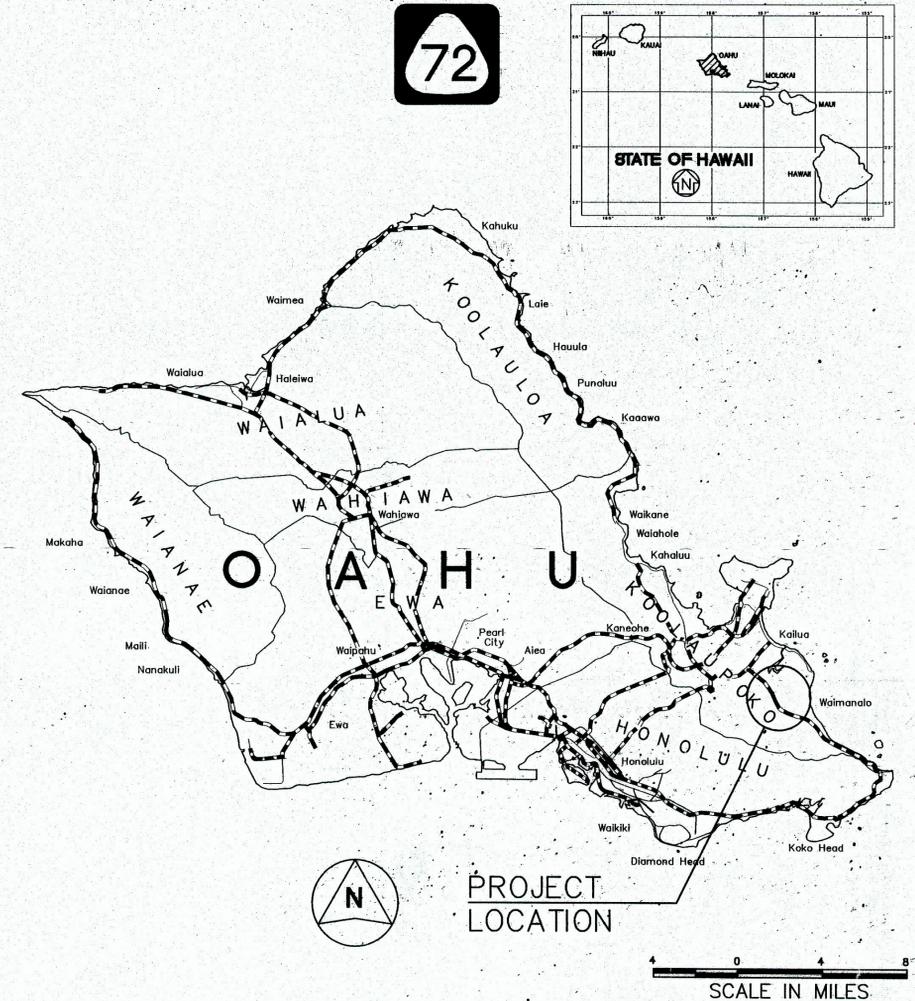

LAYOUT PLAN
LENGTH OF PROJECT 0.76 MI.

DESIGNED BY _____
MANAGED BY _____
HWY-DS _____
692-7544 PHONE _____
JUNE 2008 DATE _____

CHANGES MADE DURING CONSTRUCTION HAVE BEEN INCORPORATED ON THESE PLANS EXCEPT CHANGES IN THE ORIGINAL THEORETICAL QUANTITIES. FOR ACTUAL QUANTITIES, REFER TO PROJECT LEDGER AND/OR COMPUTATION BOOK.
M. Ben 10/2/08
RESIDENT ENGINEER DATE

DEPARTMENT OF TRANSPORTATION
STATE OF HAWAII

APPROVED:
[Signature] 6.6.08
DIR. OF TRANSPORTATION DATE