

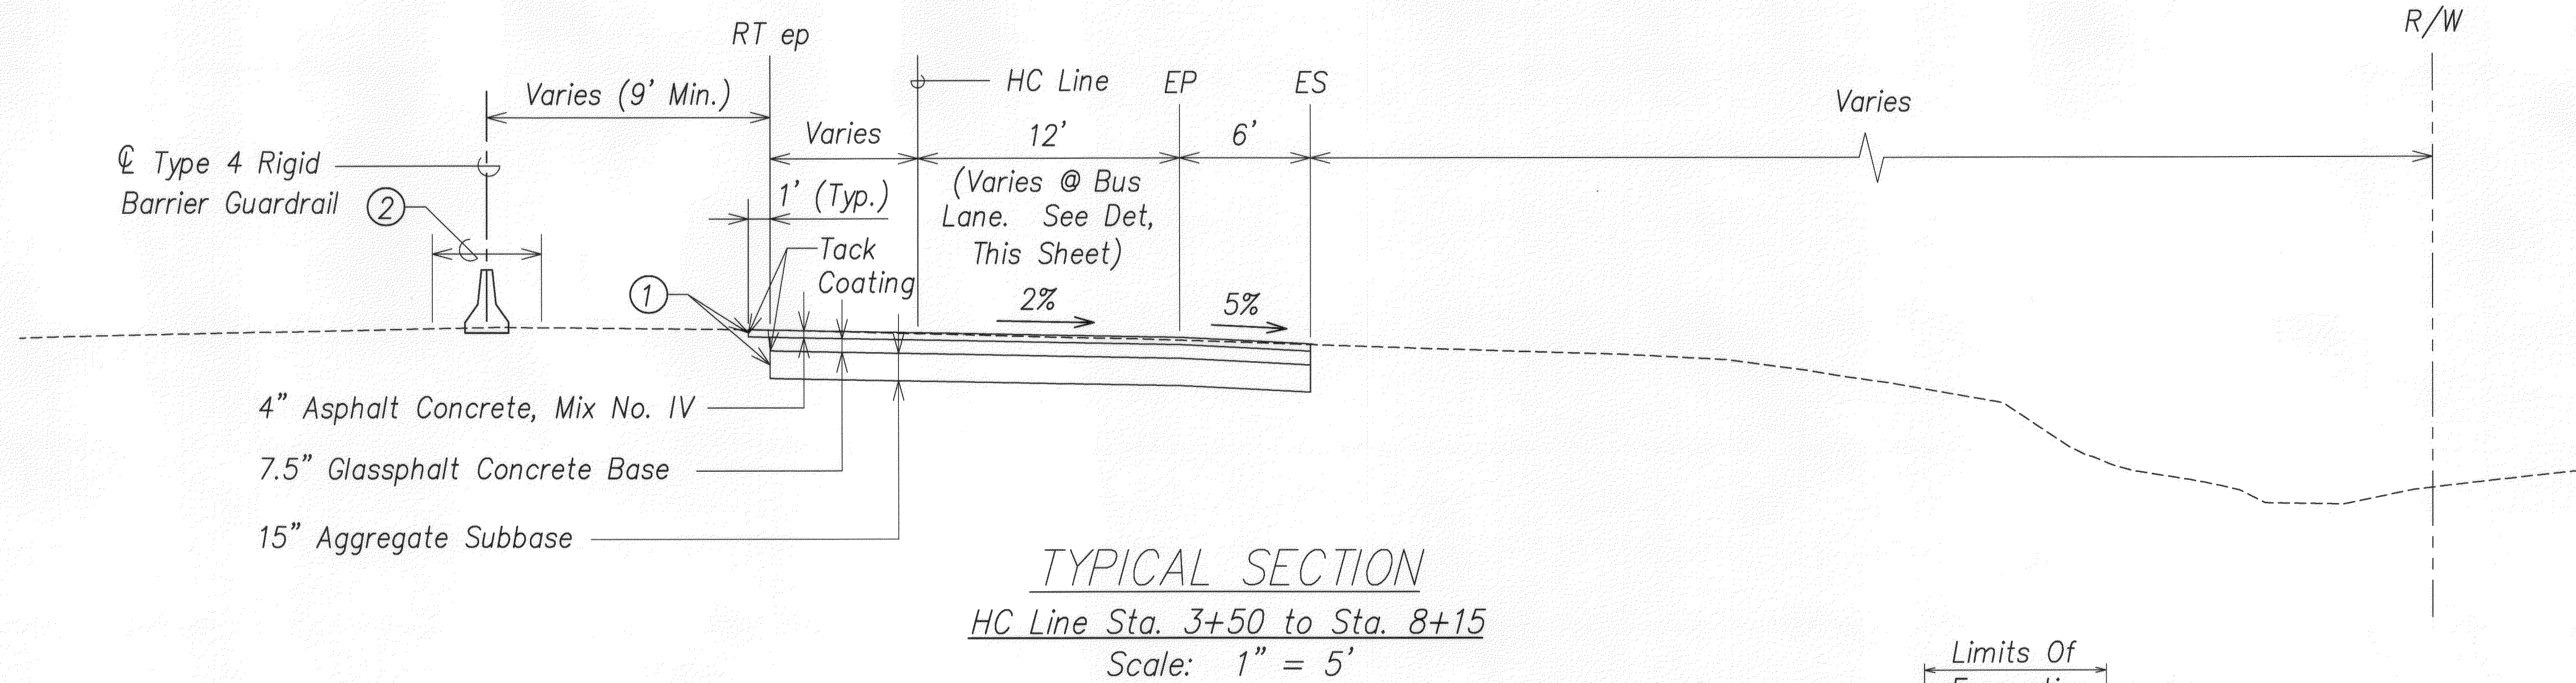
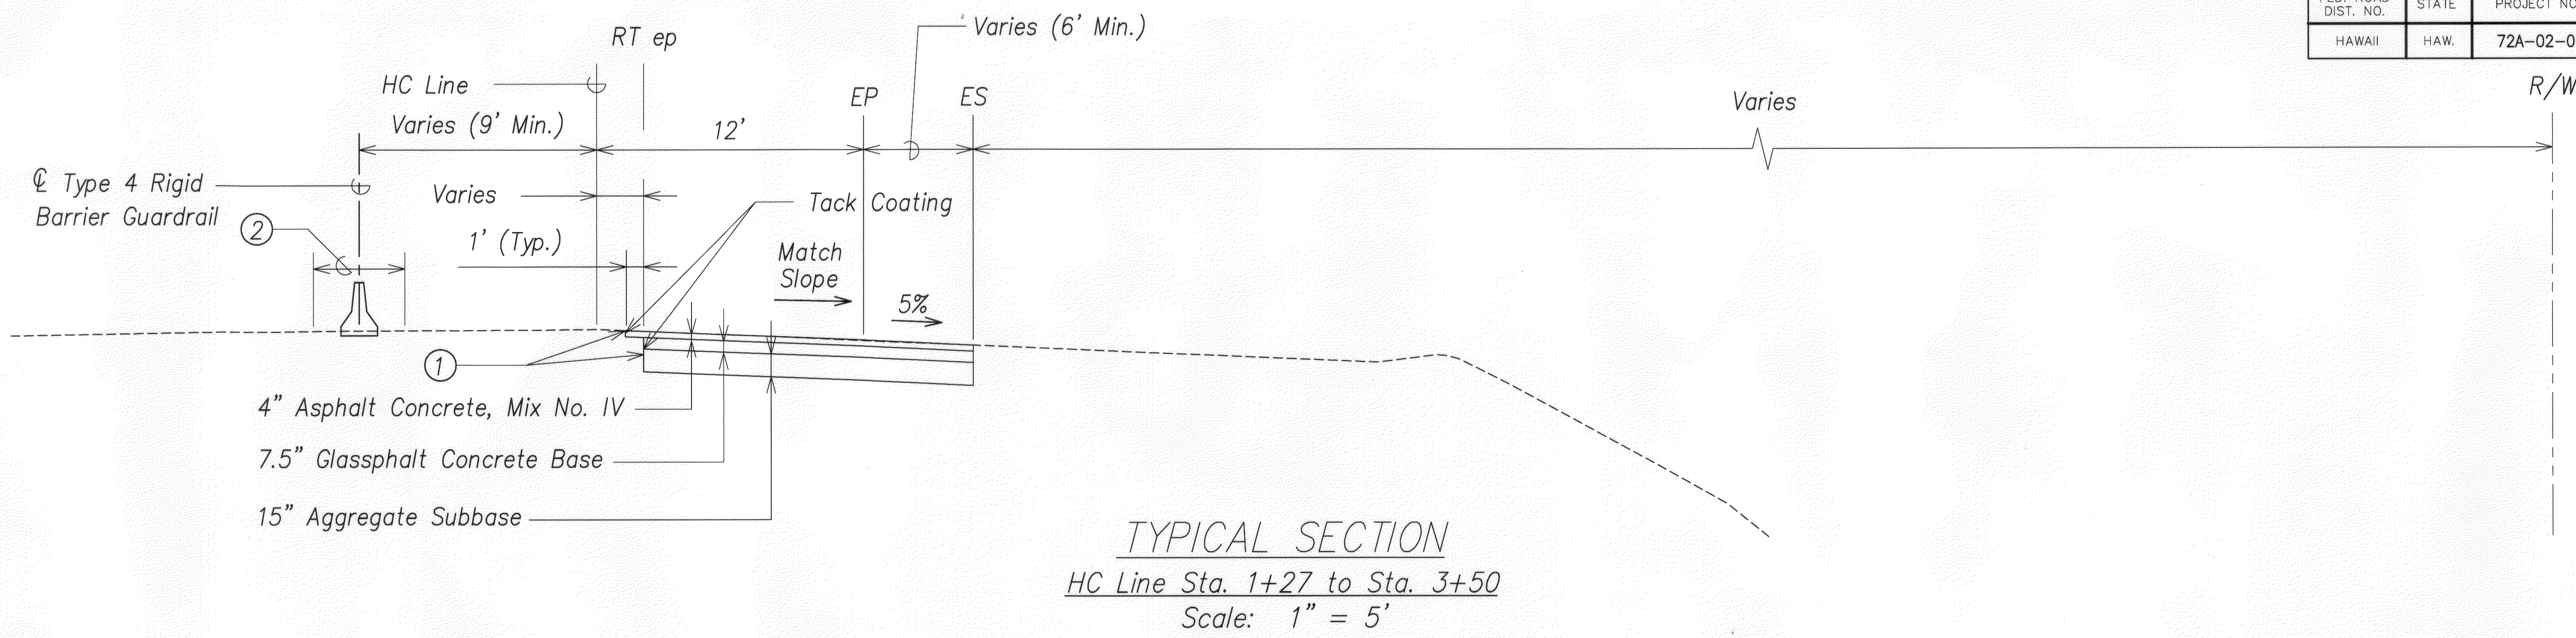


| FED. ROAD DIST. NO. | STATE | PROJECT NO. | FISCAL YEAR | SHEET NO. | TOTAL SHEETS |
|---------------------|-------|-------------|-------------|-----------|--------------|
| HAWAII              | HAW.  | 72A-02-06   | 2008        | 9         | 66           |

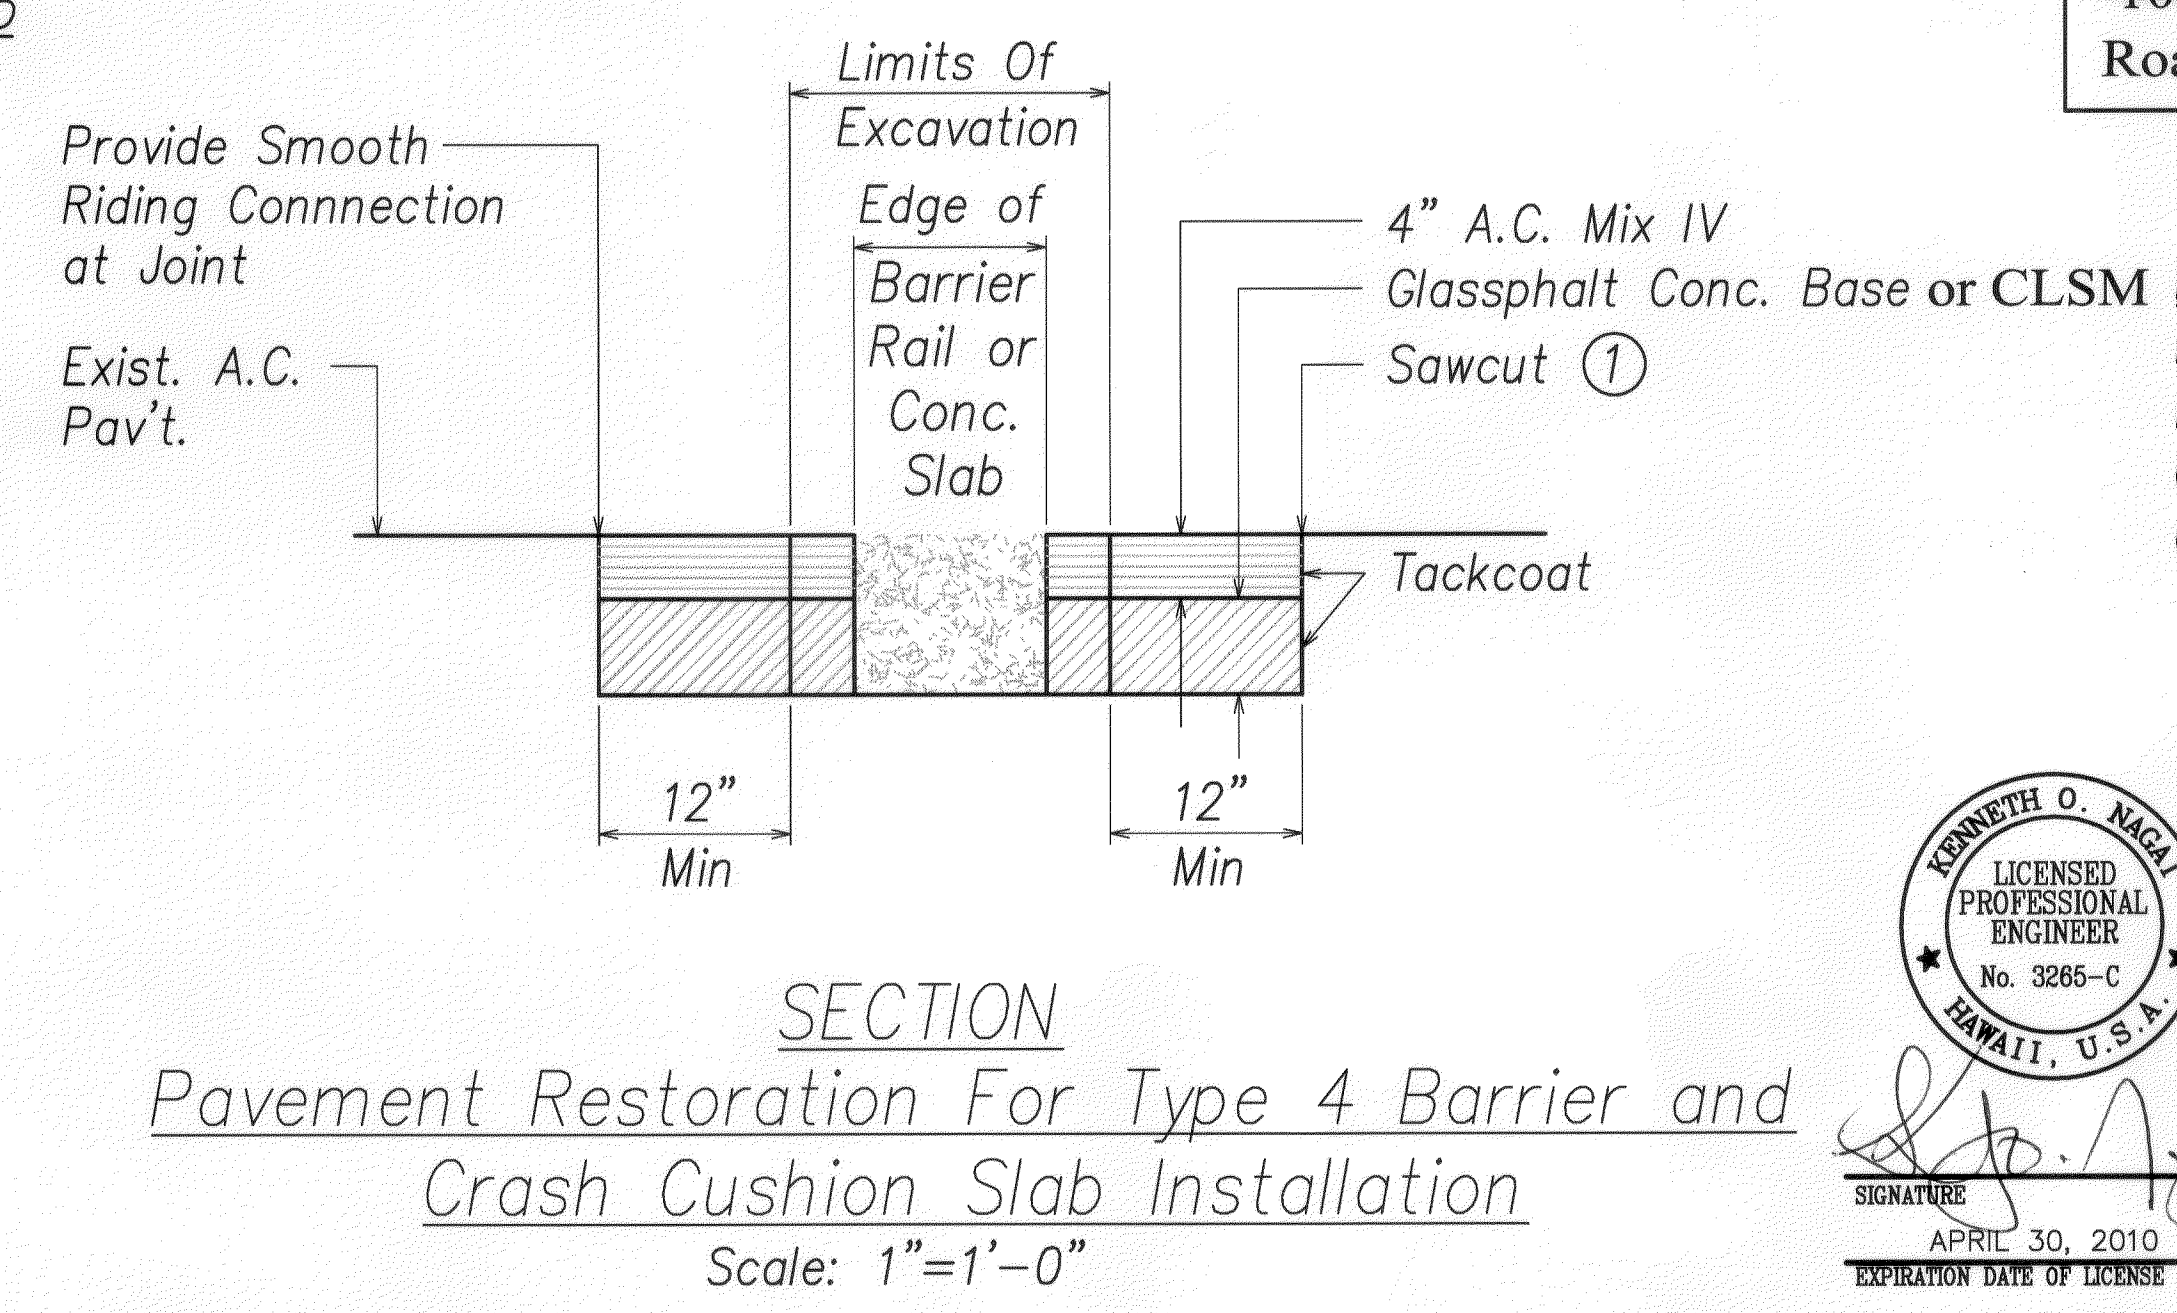

| LEGEND FOR AS-BUILT POSTING |                                     |
|-----------------------------|-------------------------------------|
|                             | Squiggly line for as-built deletion |
|                             | Double line for as-built deletion   |
|                             | Text for as-built posting           |

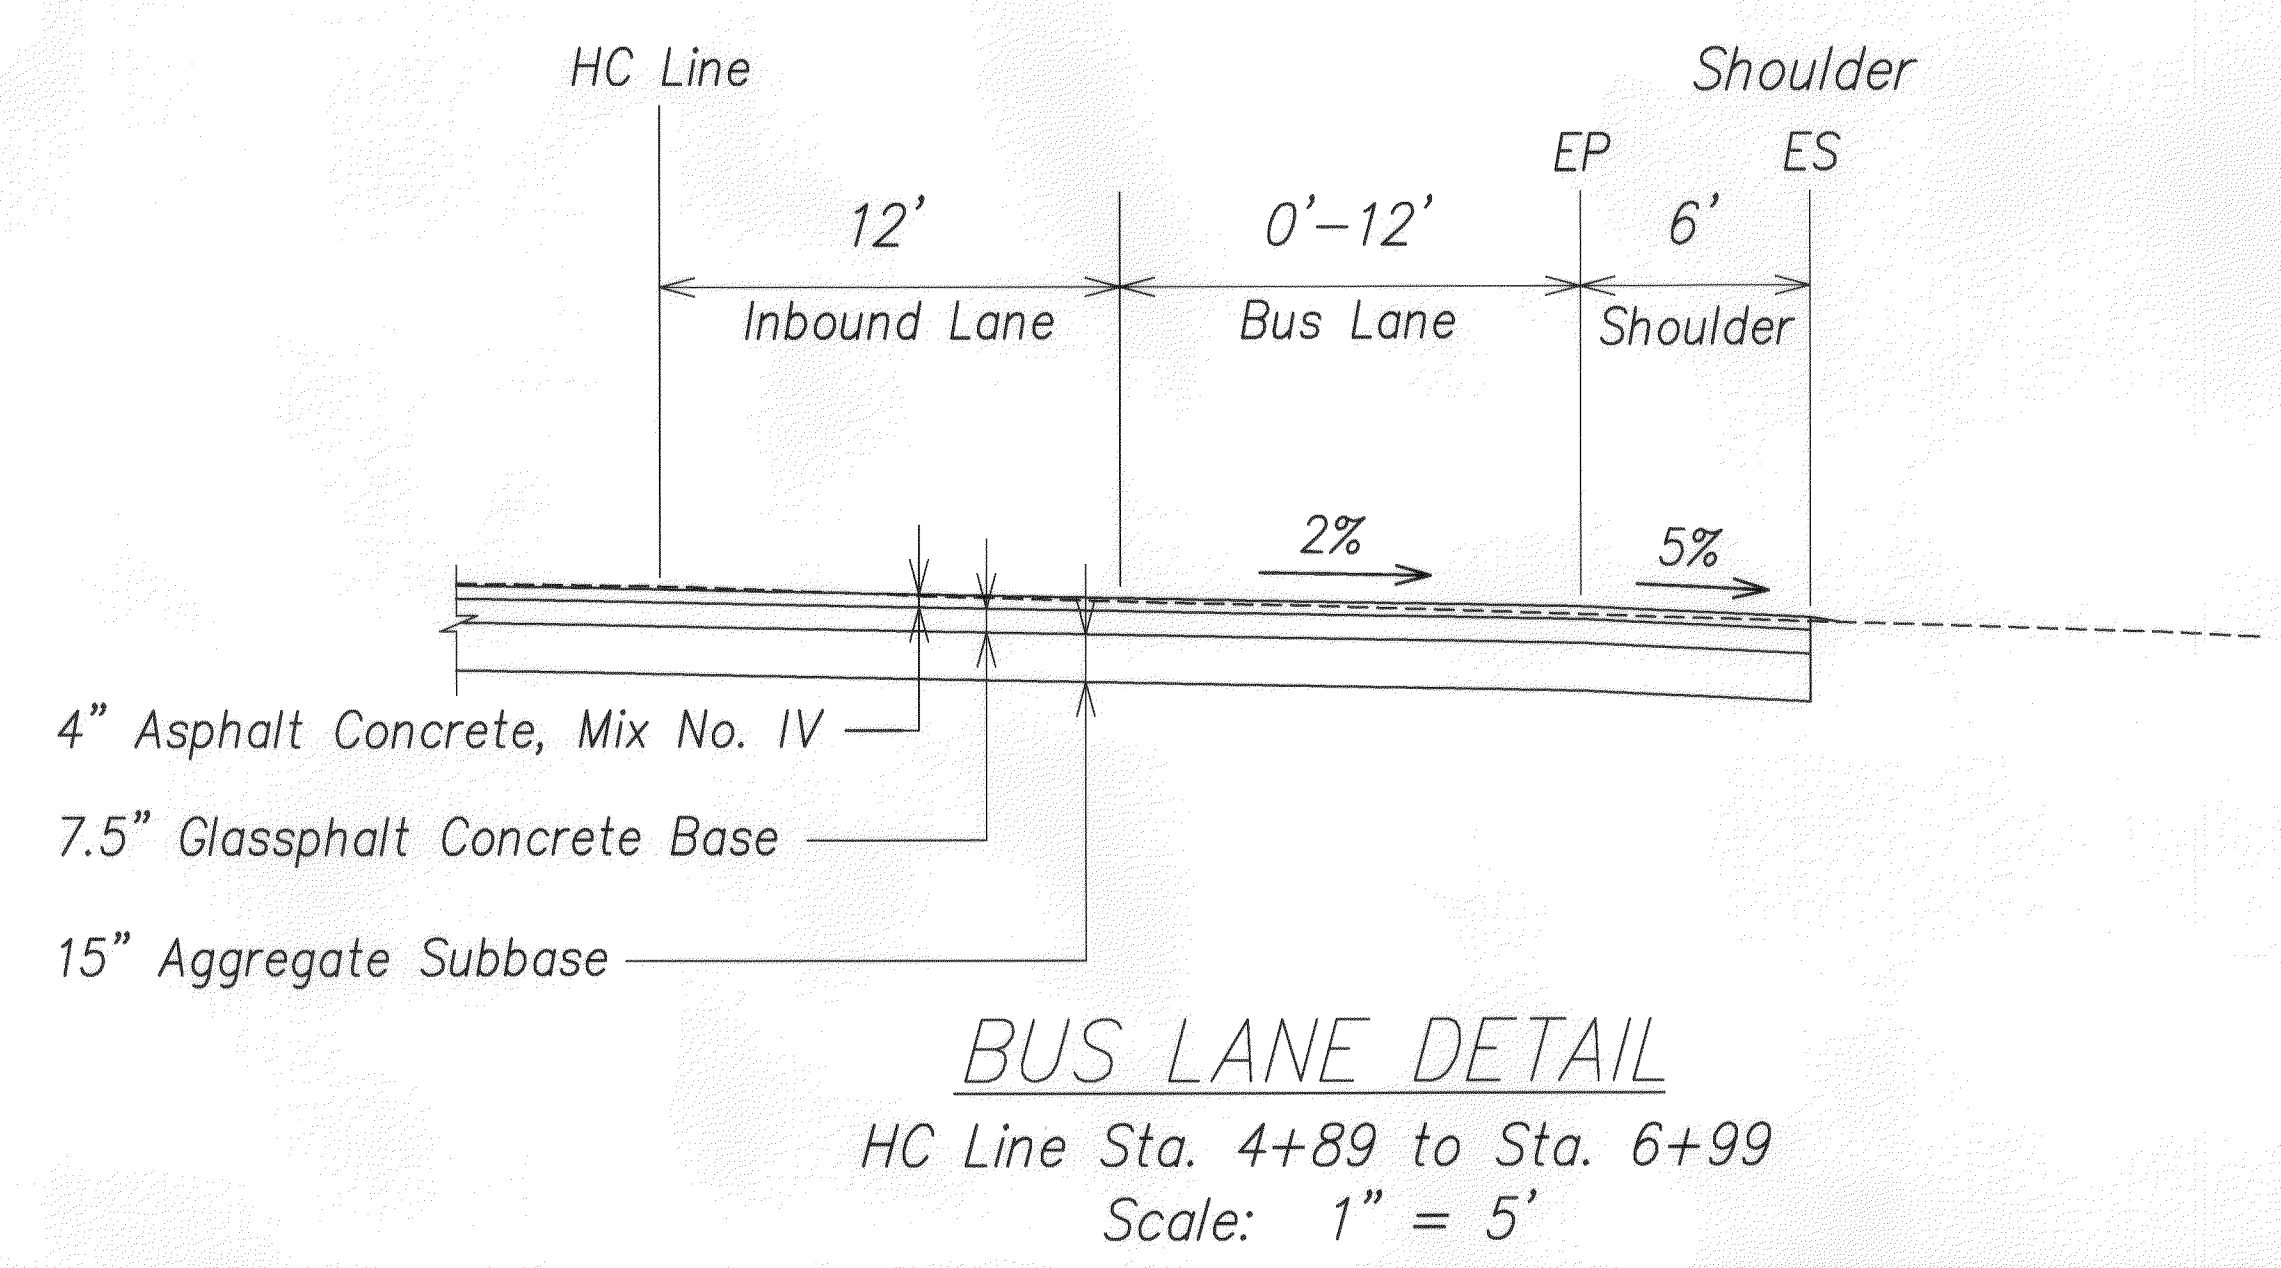

**NOTE:**  
 Excavation and Pavement Restoration Will Not Be Paid For Separately And Will Be Considered Incidental to Type 4 Barrier or Crash Cushion

**KENNETH O. NAGA**  
 LICENSED PROFESSIONAL ENGINEER  
 No. 3265-C  
 HAWAII, U.S.A.  
 SIGNATURE  
 APRIL 30, 2010  
 EXPIRATION DATE OF LICENSE  
 THIS WORK WAS PREPARED BY ME OR UNDER MY SUPERVISION

STATE OF HAWAII  
 DEPARTMENT OF TRANSPORTATION  
 HIGHWAYS DIVISION  
**TYPICAL SECTIONS**  
 KALANIANA'OLE HIGHWAY MEDIAN  
 IMPROVEMENTS VICINITY OF OLOMANA  
 GOLF COURSE PROJECT NO. 72A-02-06  
 SCALE: 1"=5' DATE: June 2008  
 SHEET No. C-7 OF 43 SHEETS

|                   |      |
|-------------------|------|
| SURVEY PLANNED BY | DATE |
| DRAWN BY          |      |
| CHECKED BY        |      |
| NOTED BY          |      |
| ORIGINAL PLAN     |      |
| NOTE BOOK         |      |
| No.               |      |

"AS-BUILT"



