



FED. ROAD DIST. NO.	STATE	PROJ. NO.	FISCAL YEAR	SHEET NO.	TOTAL SHEETS
HAWAII	HAW.	72A-01-06	2006	7	14

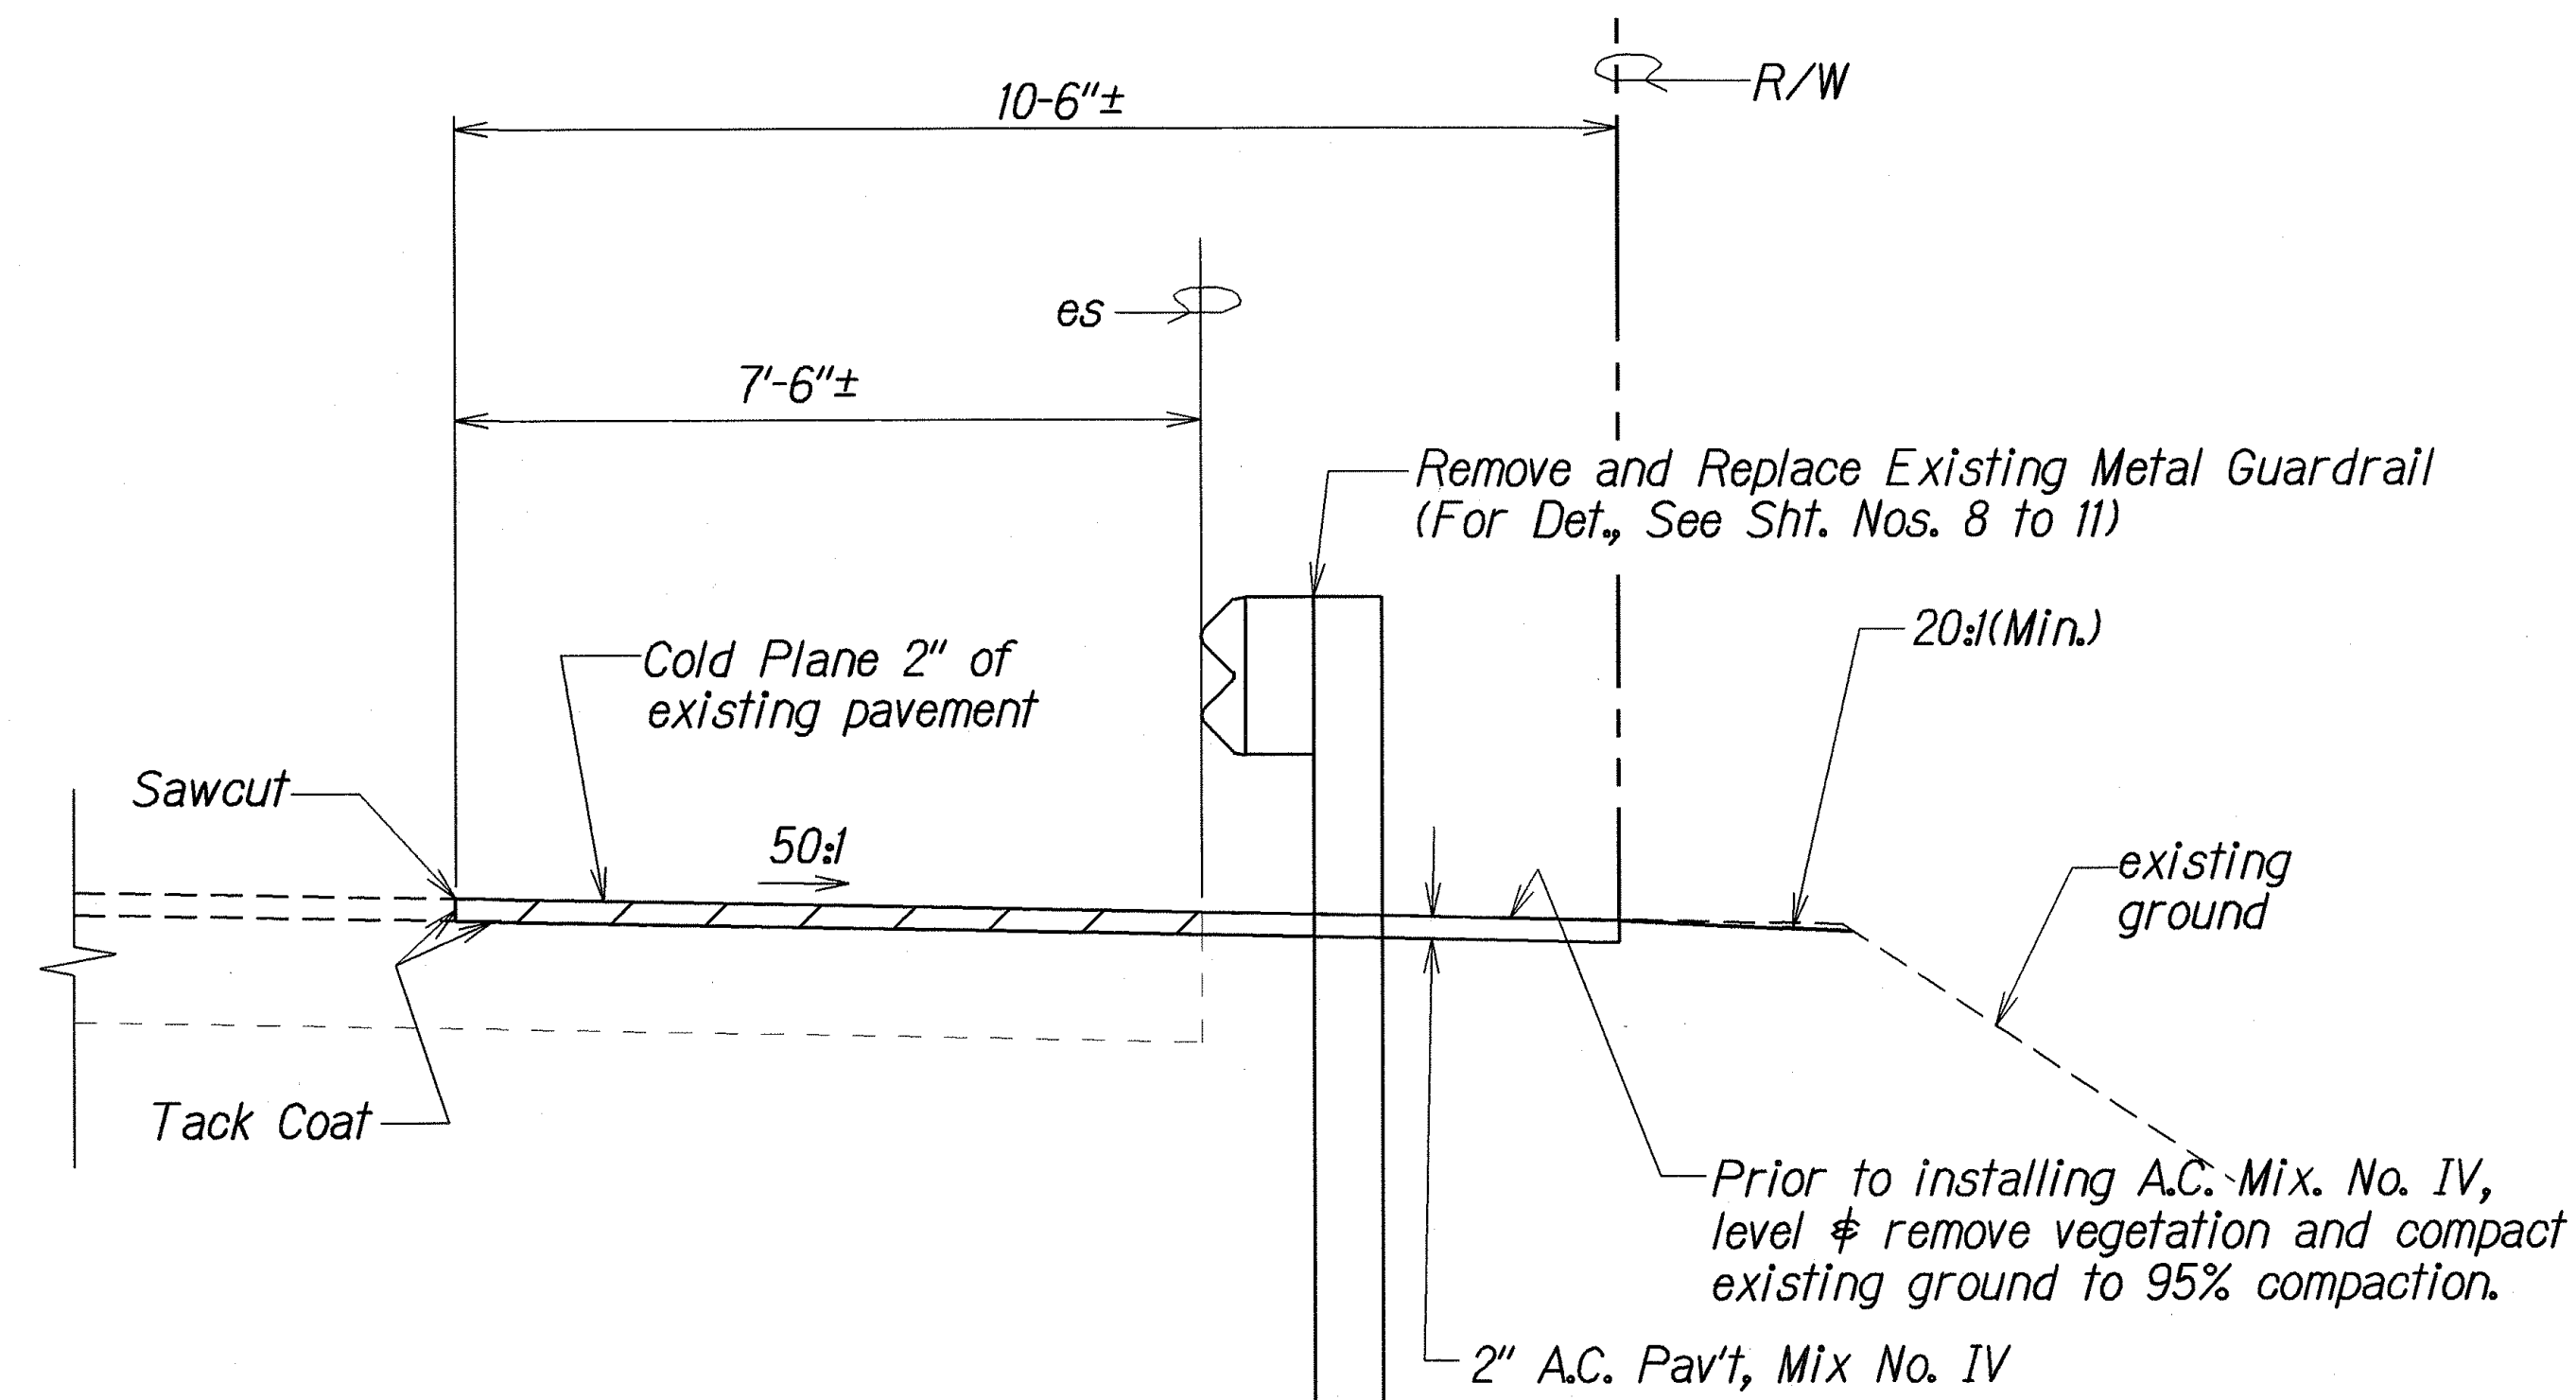


TYPICAL SECTION

Sta. 31+93± to Sta. 32+65± Rt. and
Sta. 33+26± to Sta. 33+59 Rt.

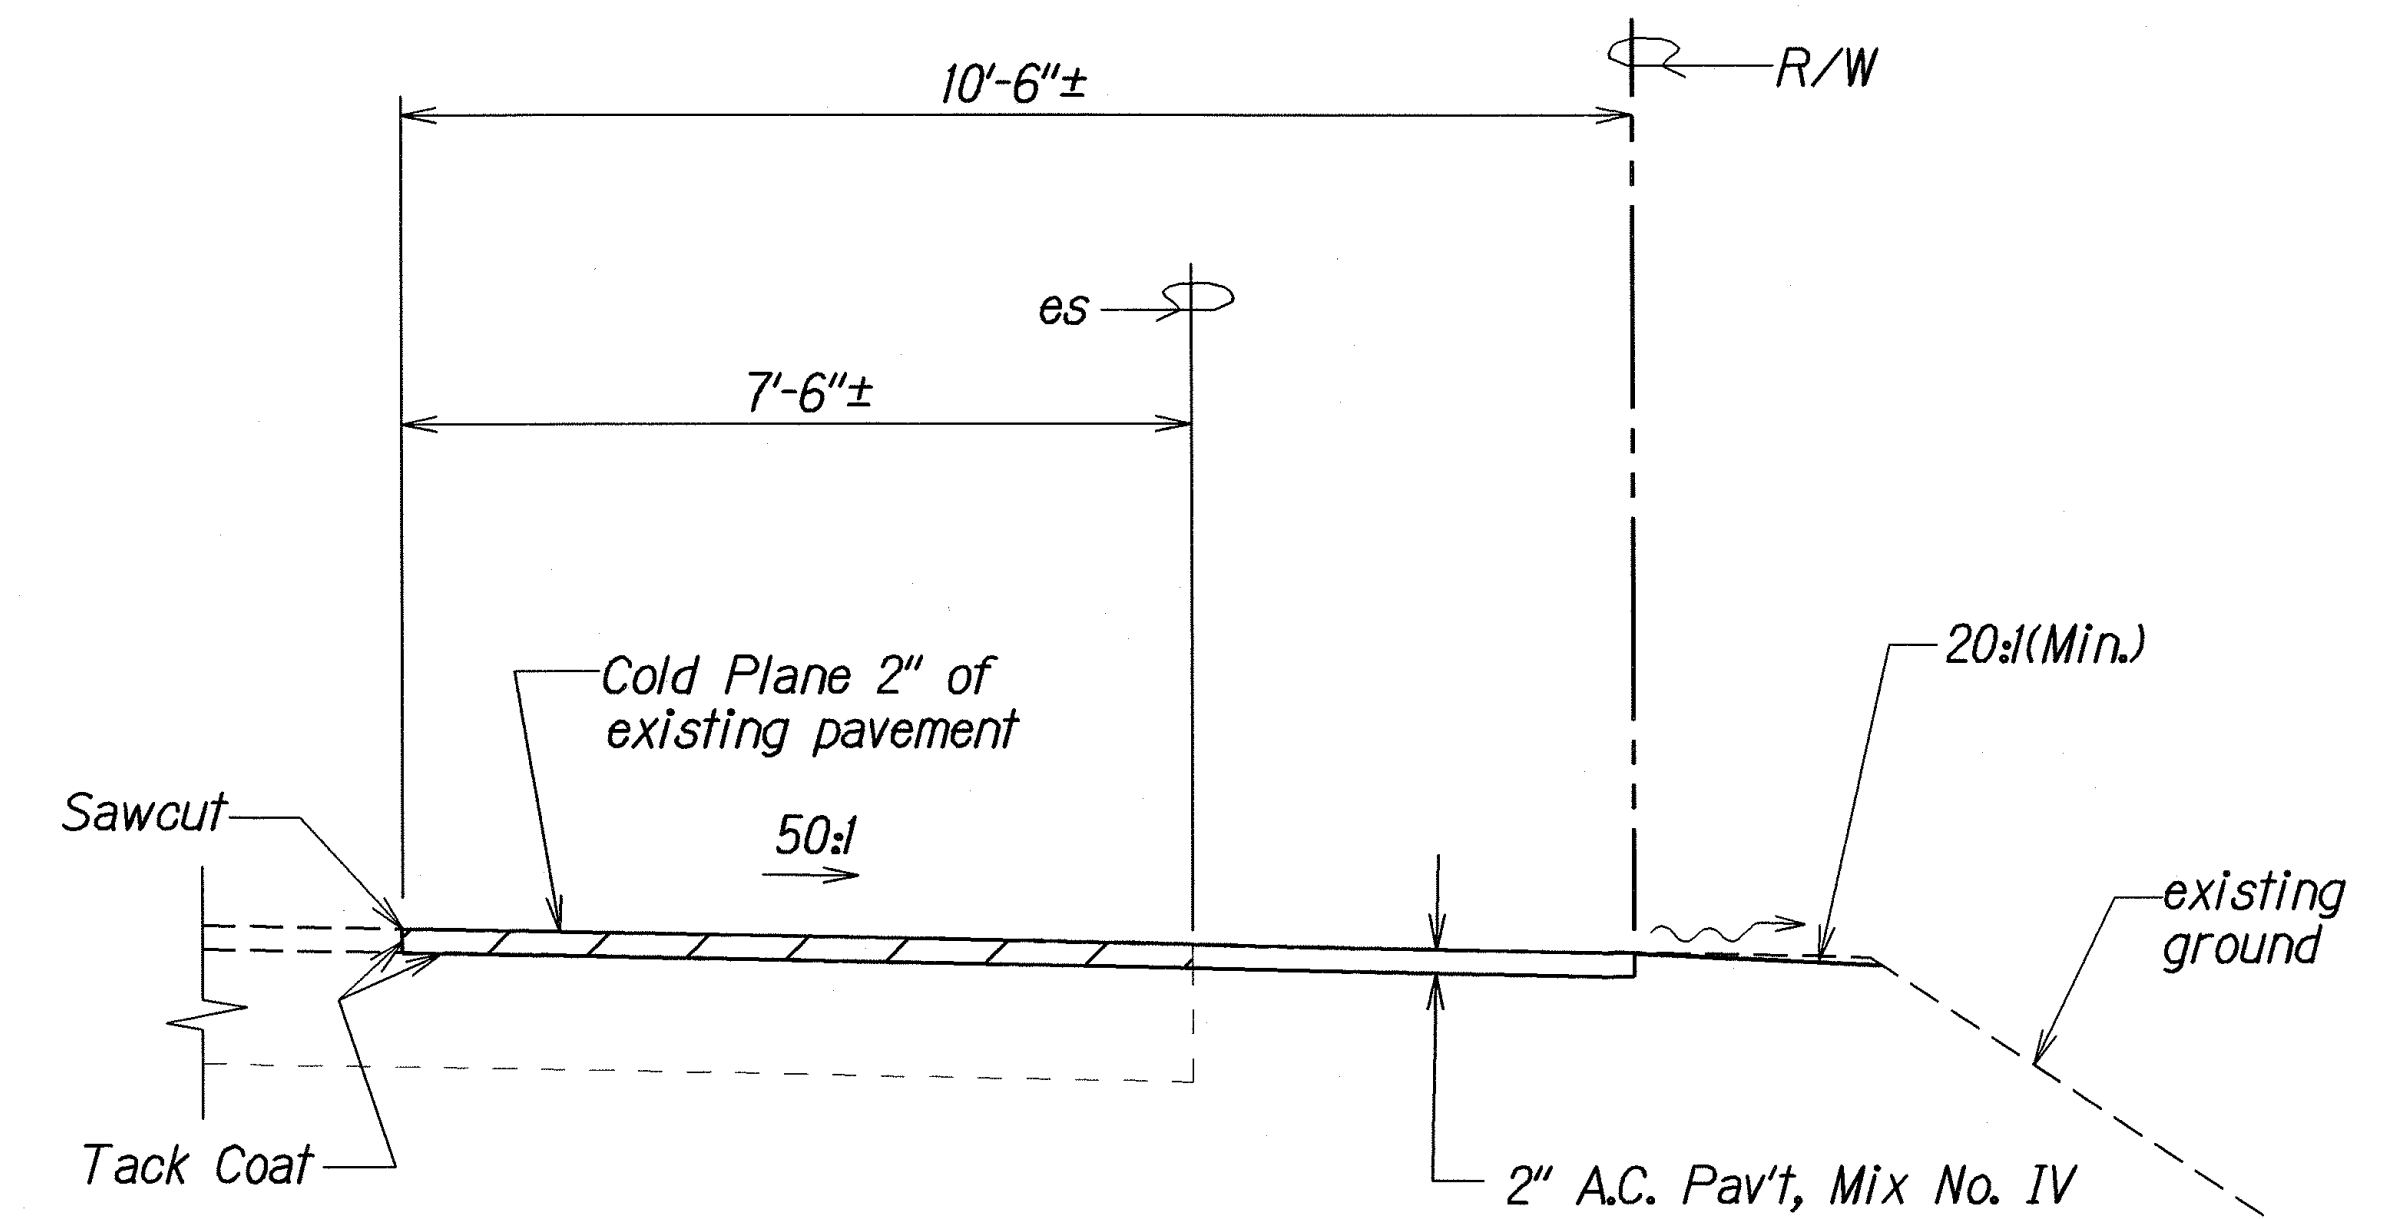

TYPICAL SECTION

Sta. 33+59 to Sta. 33+70± Rt.

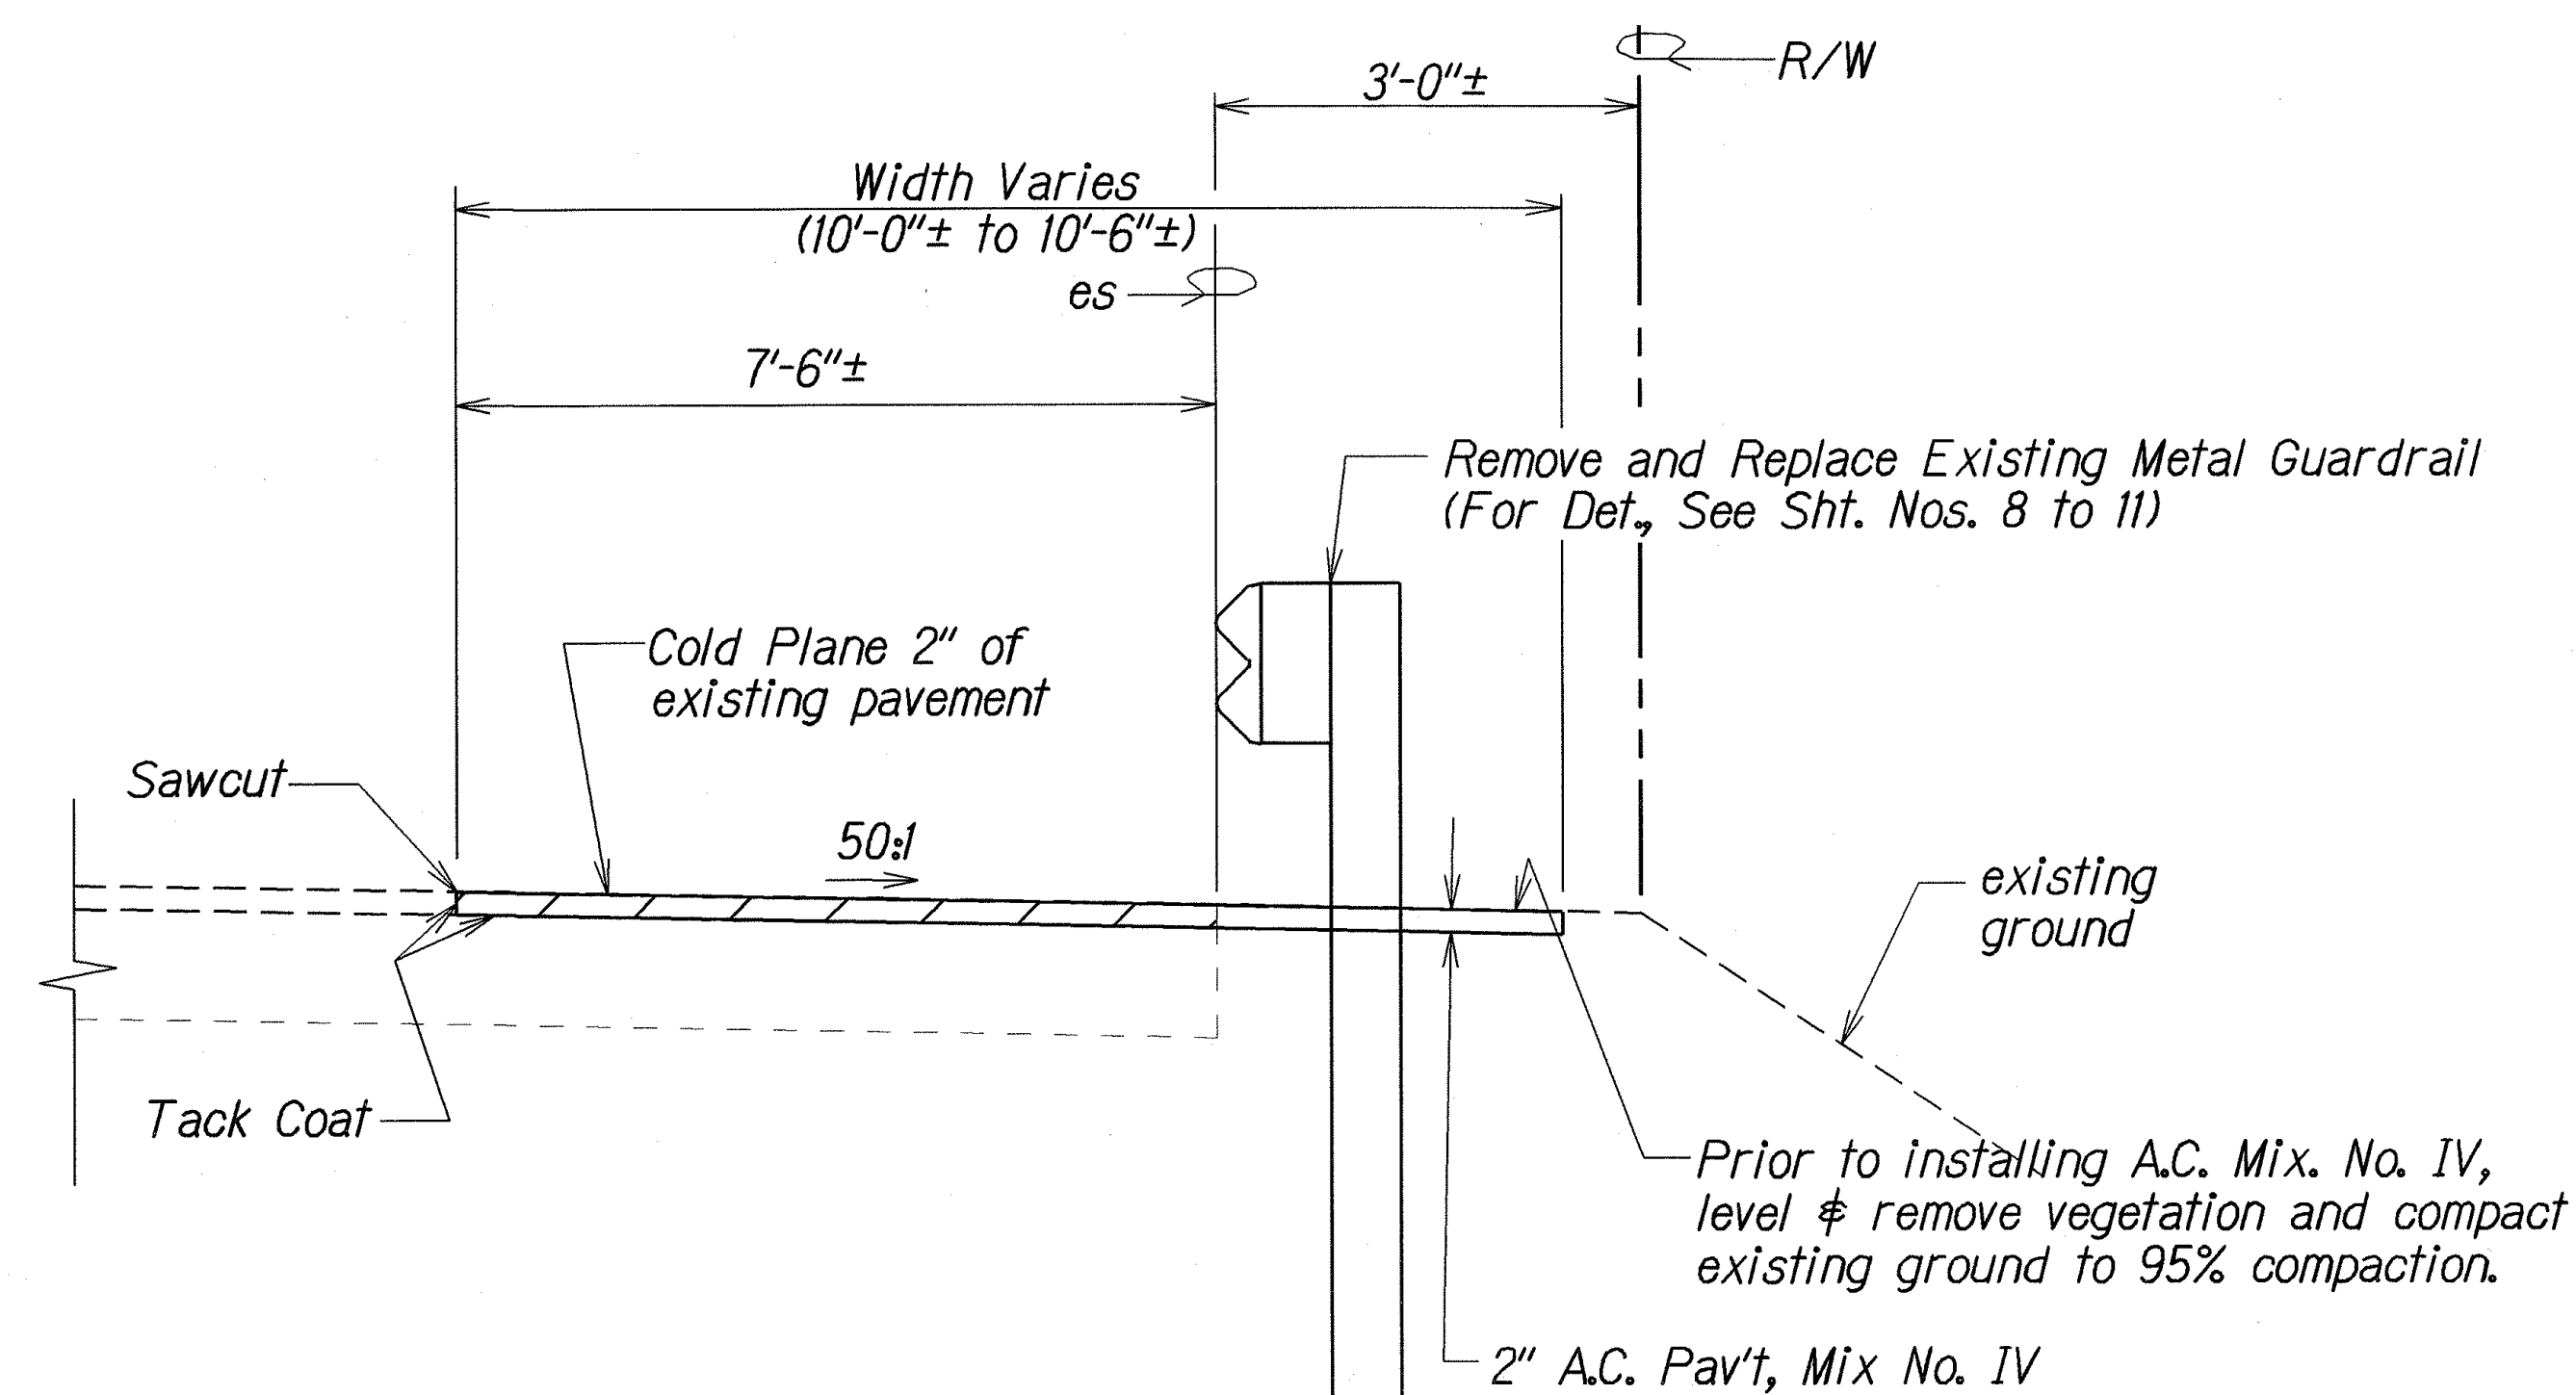

TYPICAL SECTION

Sta. 32+65± to Sta. 33+26± Rt.

DESIGNED BY	DATE
TRACED BY	
DESIGNED BY	
QUANTITIES BY	
CHECKED BY	
ORIGINAL PLAN	
NOTE BOOK	
01/3/06/00/07	
No. 21100001	

9/06	Revised Limits of Cold Planing Removed Reference to EP
DATE	REVISION
STATE OF HAWAII DEPARTMENT OF TRANSPORTATION HIGHWAYS DIVISION DETAIL KALANIANA'OLE HIGHWAY DRAINAGE IMPROVEMENTS Vicinity of Poalima Street Project No. 72A-01-06 Scale: 3/4" = 1'-0" Date: May 2005	
SHEET No. 1 OF 1 SHEETS	

C.O. 7