	INDEX TO DRAWINGS
SHEET NO.	DESCRIPTION
1	TITLE SHEET
2	STANDARD PLANS SUMMARY
3	GENERAL NOTES & LEGEND
4–5	NPDES NOTES
6	PLANS
7	DETAILS
8–11	GUARDRAIL DETAILS 10
12	SKT-350 DETAILS
13	ET-2000 PLUS DETAILS
14	TYPE "G" FLARE DETAILS
,,	

^①Plan Sht. Nos. C.O. 10S-1 and C.O. 11S-1 are supplementary sheets to this project. Total Sheet Count after "As-Built" postings <u>16</u> sheets.

STATE OF HAWAII

DEPARTMENT OF TRANSPORTATION


HIGHWAYS DIVISION HONOLULU, HAWAII

PLANS FOR

KALANIANAOLE HIGHWAY DRAINAGE IMPROVEMENTS

VICINITY OF POALIMA STREET PROJECT NO. 72A-01-06

DISTRICT OF KOOLAUPOKO
ISLAND OF OAHU

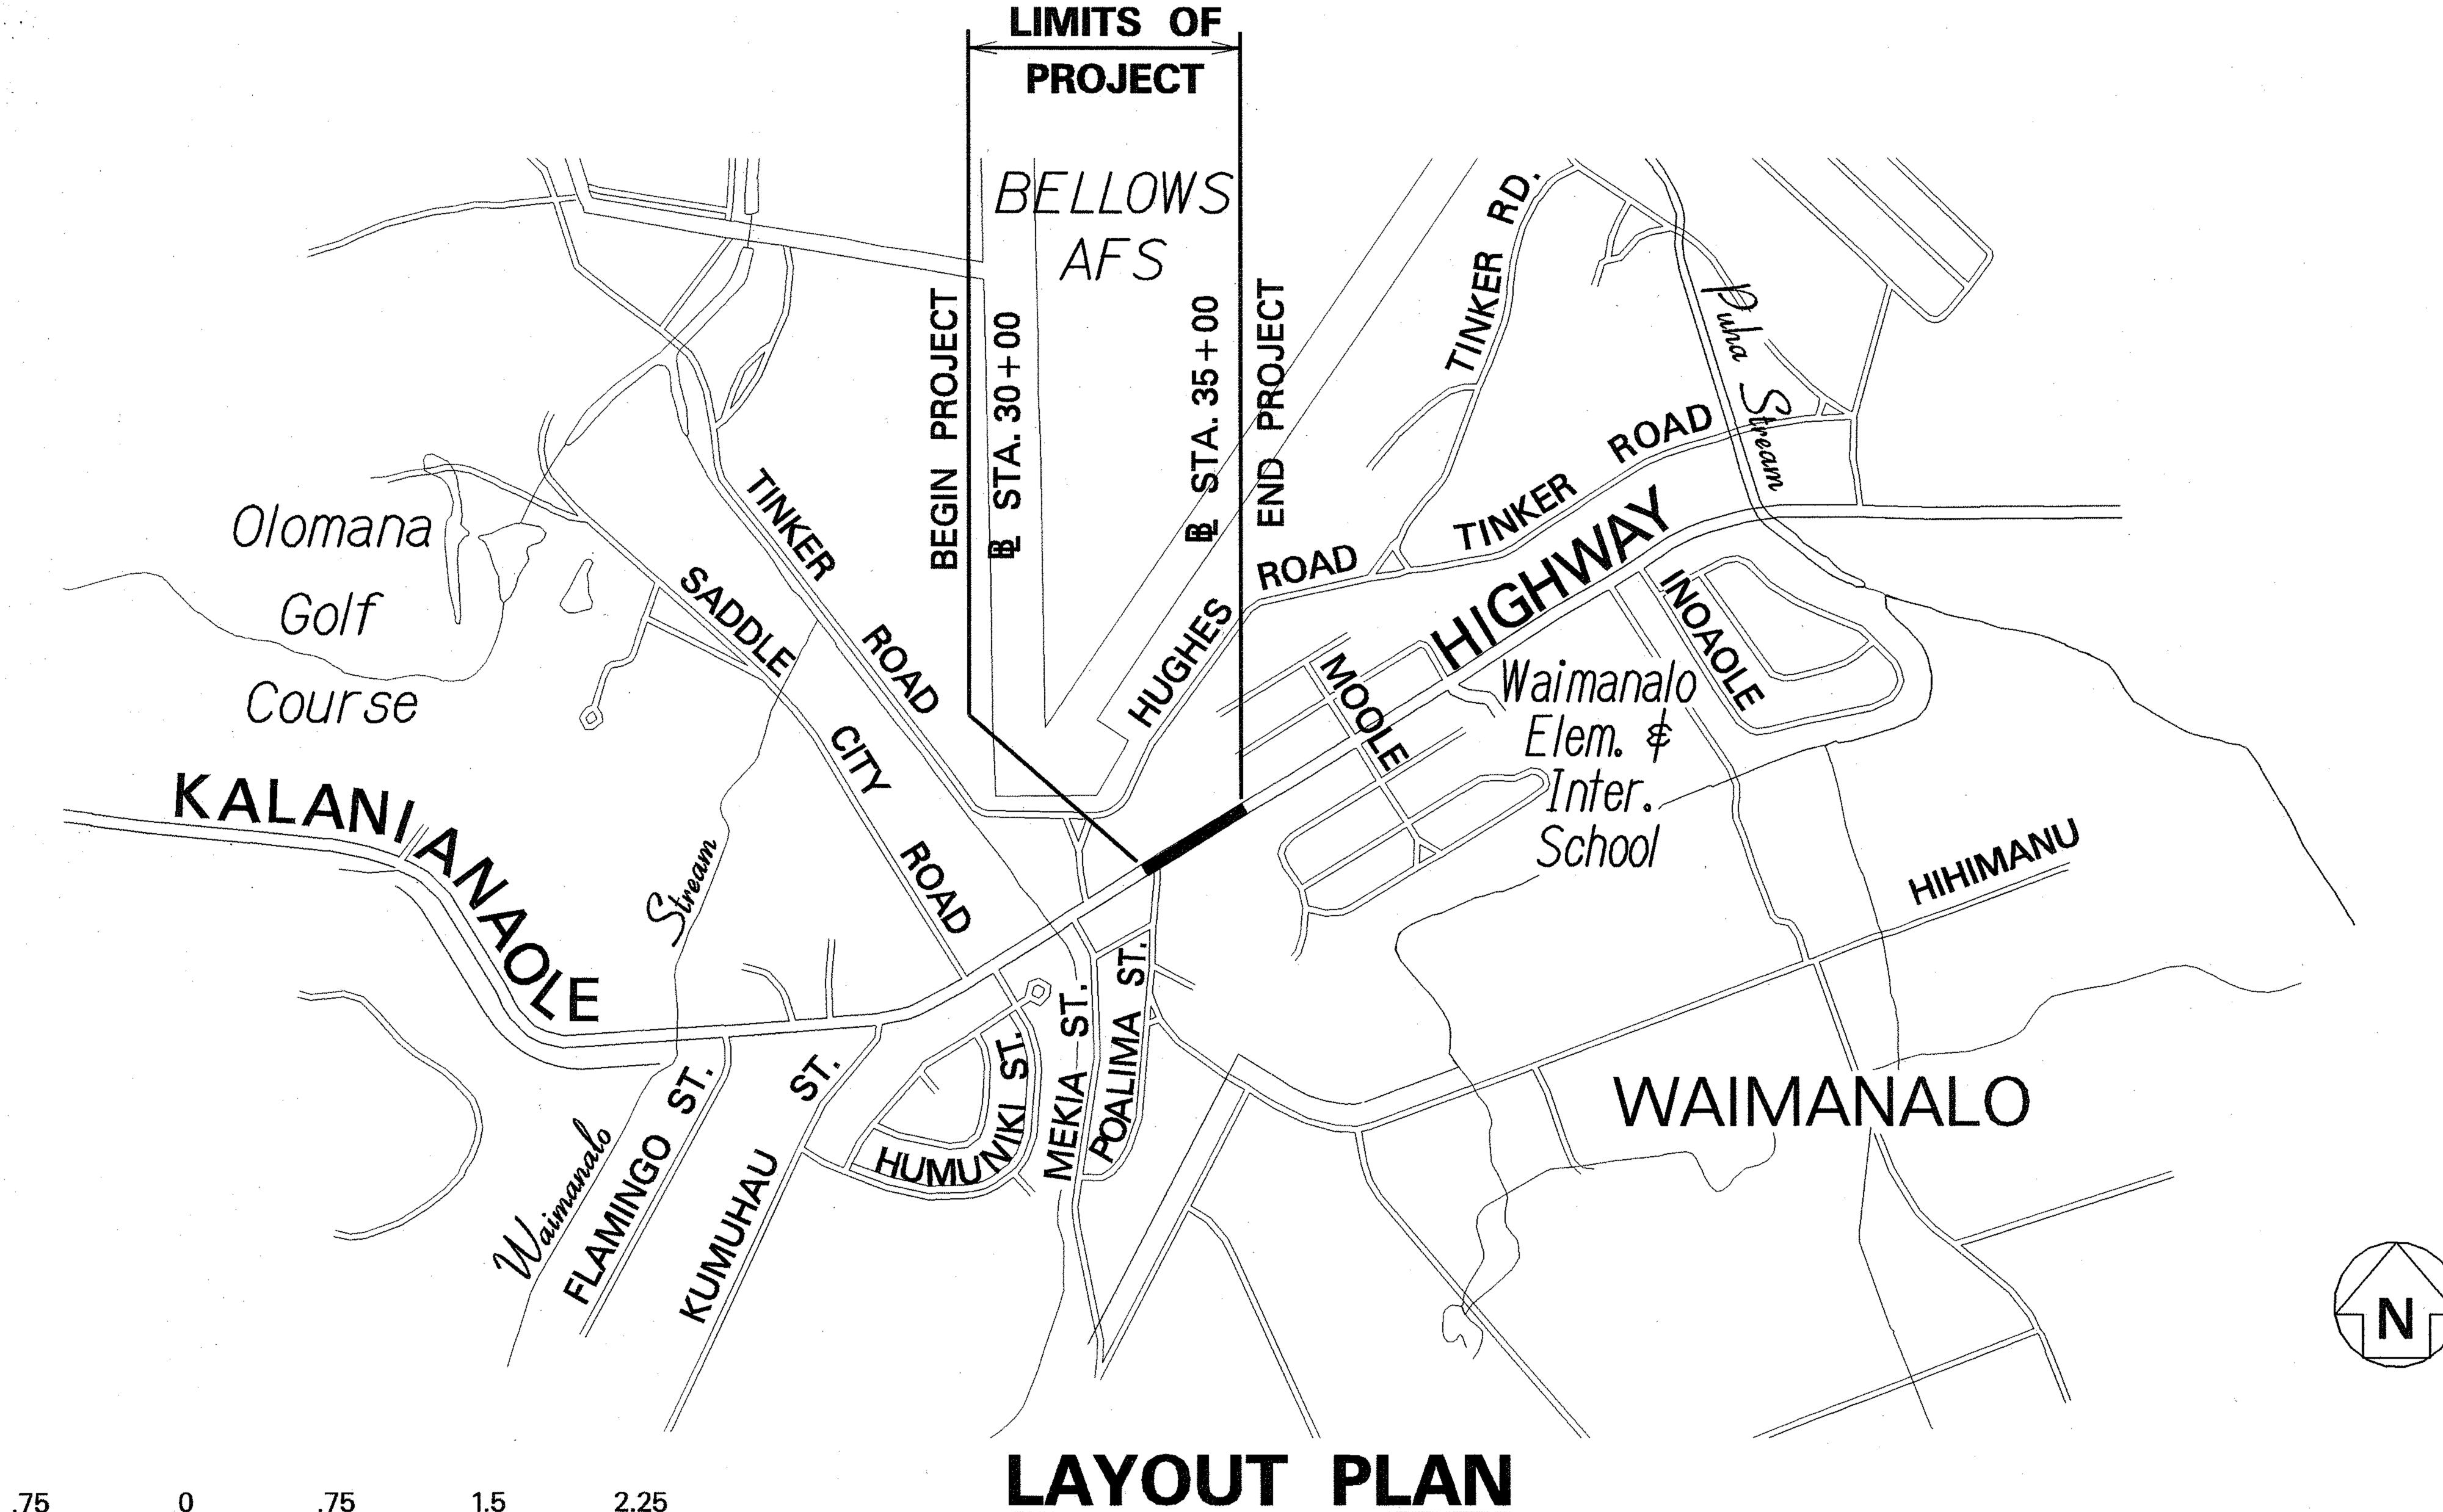

LENGTH OF PROJECT....0.09 MILE

SCALE IN THOUSAND FEET

Walter Working Walter Working Walter Working Walter Working Walter Walte

FEDERAL AID PROJECTS PREVIOUSLY CONSTRUCTED
OR UNDER CONSTRUCTION

72A-01-06

MILE POST 3.36 TO MILE POST 3.45

CHANGES MADE DURING CONSTRUCTION HAVE BEEN MOORPORATED ON THESE PLANS EXCEPT CHANGES IN THE ORIGINAL THEORETICAL QUANTITIES. FOR ACTUAL QUANTITIES, REFER TO PROJECT LEDGER AND/OR COMPUTATION BOOK.

AND/OR COMPUTATION BOOK.

7/28/08

MESIDENT ENGINEEN THE THE

DEPARTMENT OF TRANSPORTATION
STATE OF HAWAII
APPROVED:

MDIR. OF TRANSPORTATION DA

with the growing the second